


Portland Street
Showing Fence lines
and present Curb.
Scale 1" = 40'

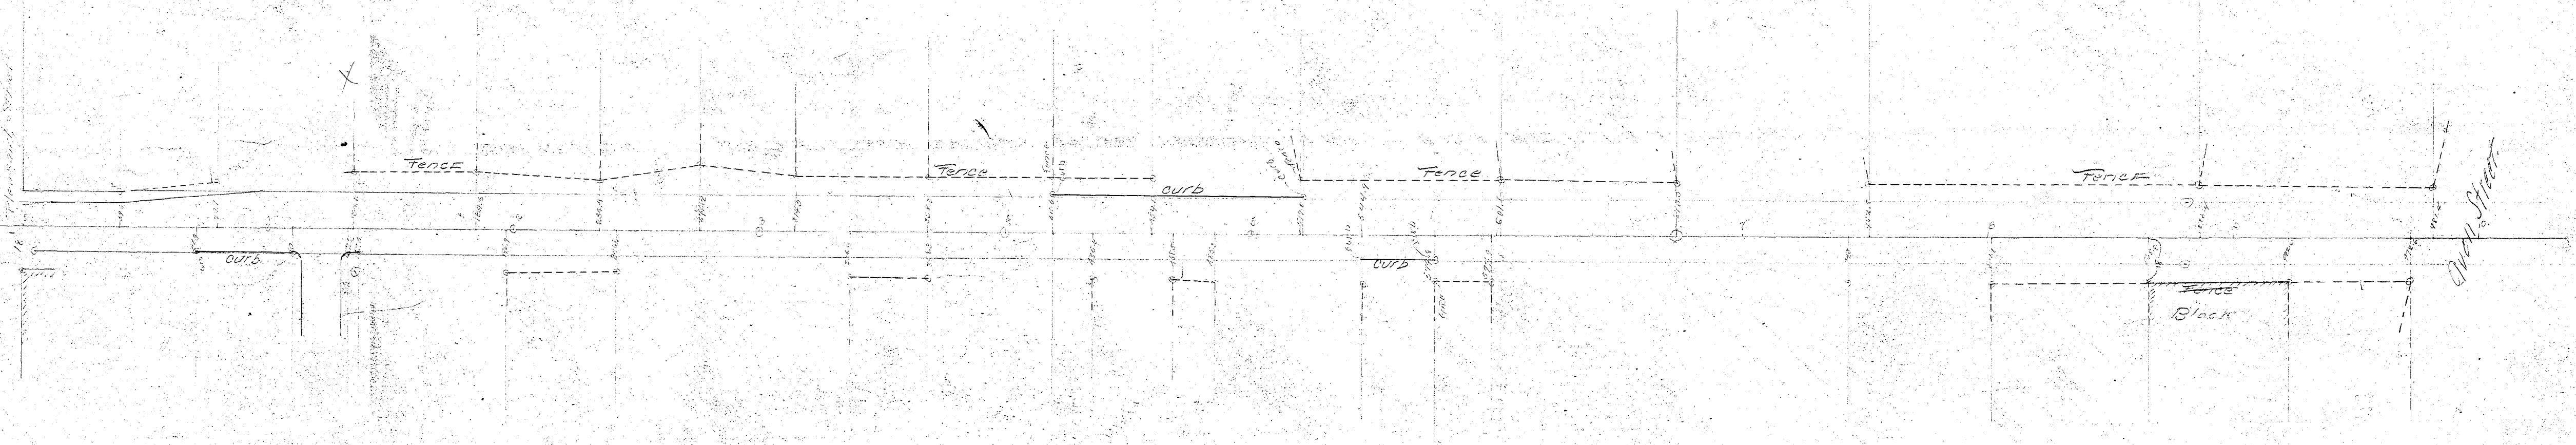

OFFICE OF CITY ENGINEER

HARTFORD, CO

Date Oct. 05 Day Book 01735

Notes: 230

City