


See "Revised Plan No. 2 of Pleasant View" cut-up of property of Minkoff, dated Feb. 1, 1927, - 244-7, recorded on Board 80 at Town Clerk's office.

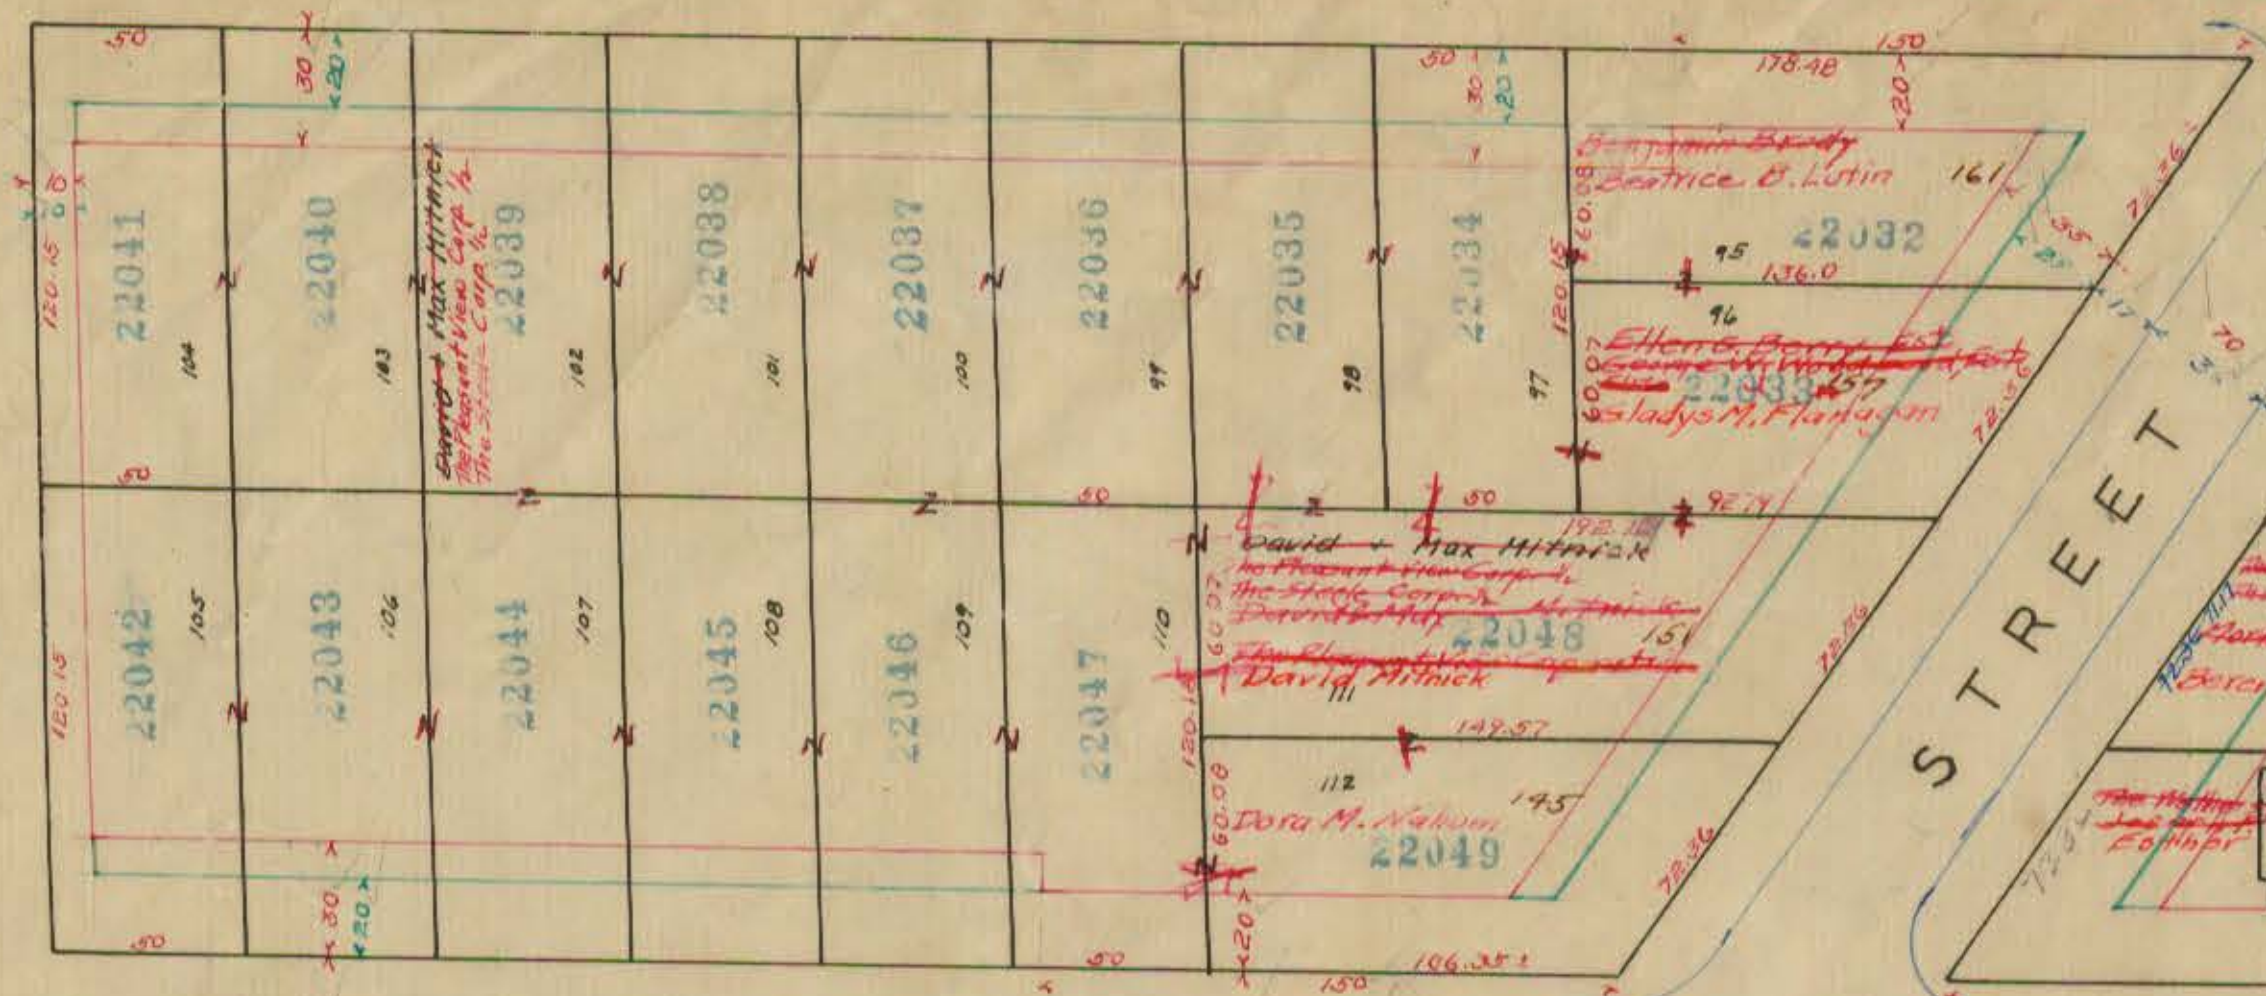

STREET




THOMASTON Street, building and veranda lines of Nov. 24, 1913, Vol. 6 p. 75

STREET

Lots on Thomaston St. between Cornwall St. and Blue Hills Ave. see "Minkoff" cut-up, May 1927 plan 256-30.


PLAINFIELD Street, building and veranda lines of Nov. 24, 1913, Vol. 6 p. 74

STREET

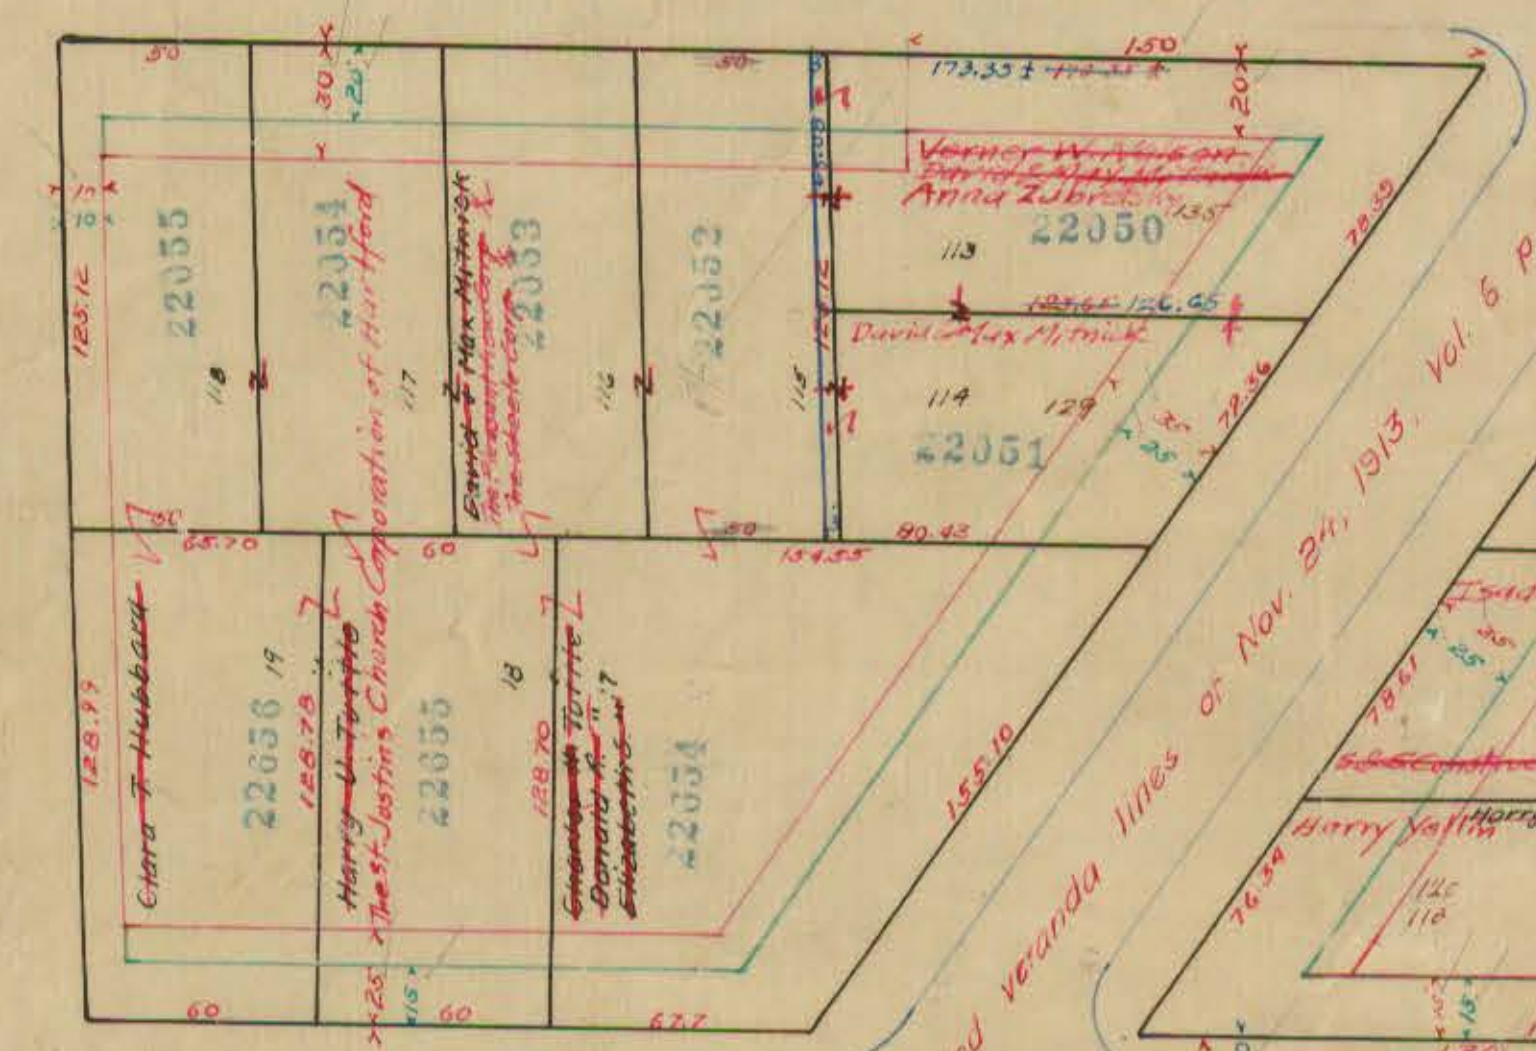

CHATHAM Street, building and veranda lines of Nov. 24, 1913, Vol. 6 p. 72


STREET

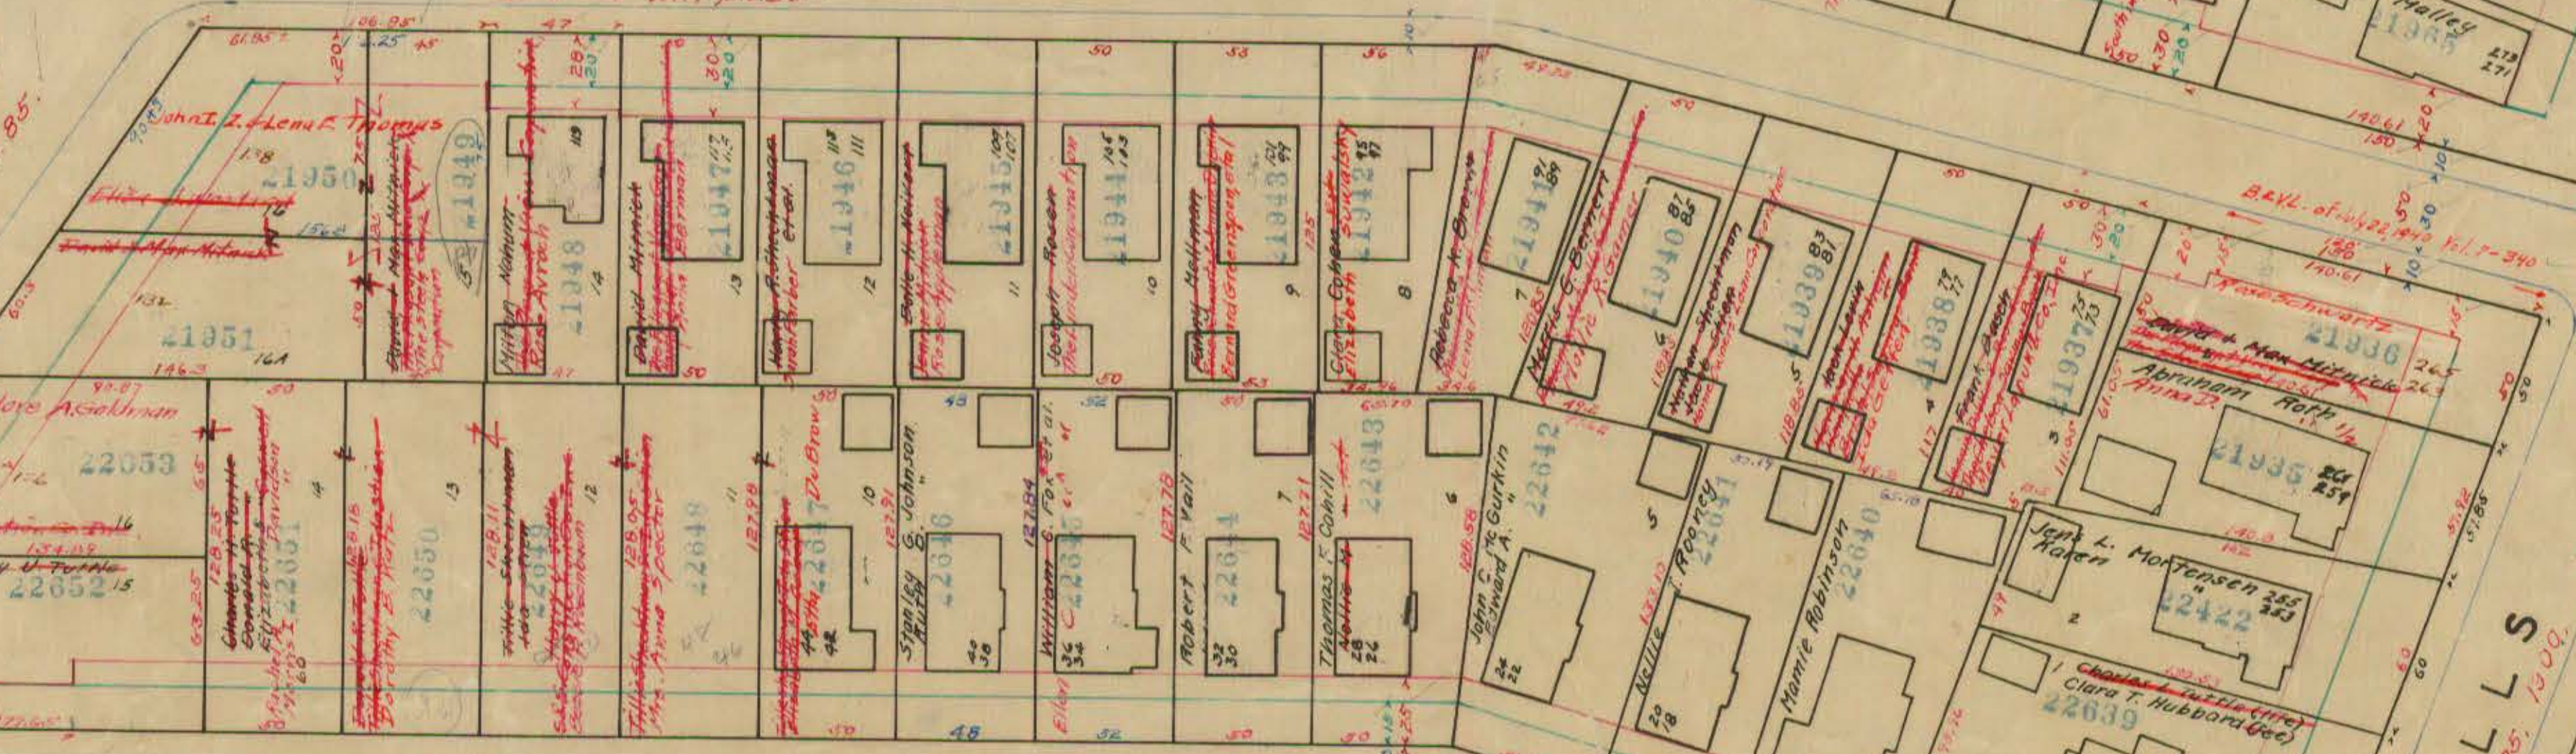

HEBRON Street, building and veranda lines of Nov. 24, 1913, Vol. 6 p. 73


STREET

LYME

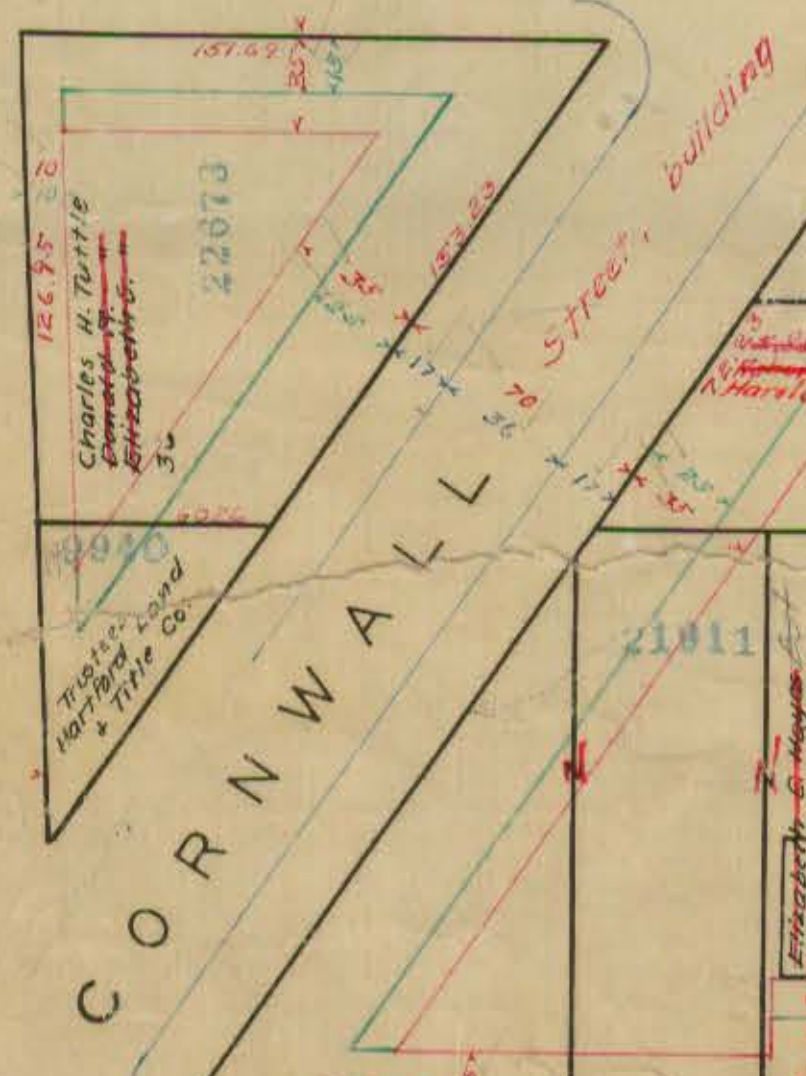

SHARON Street, building and veranda lines of Nov. 24, 1913, Vol. 6 p. 76

STREET

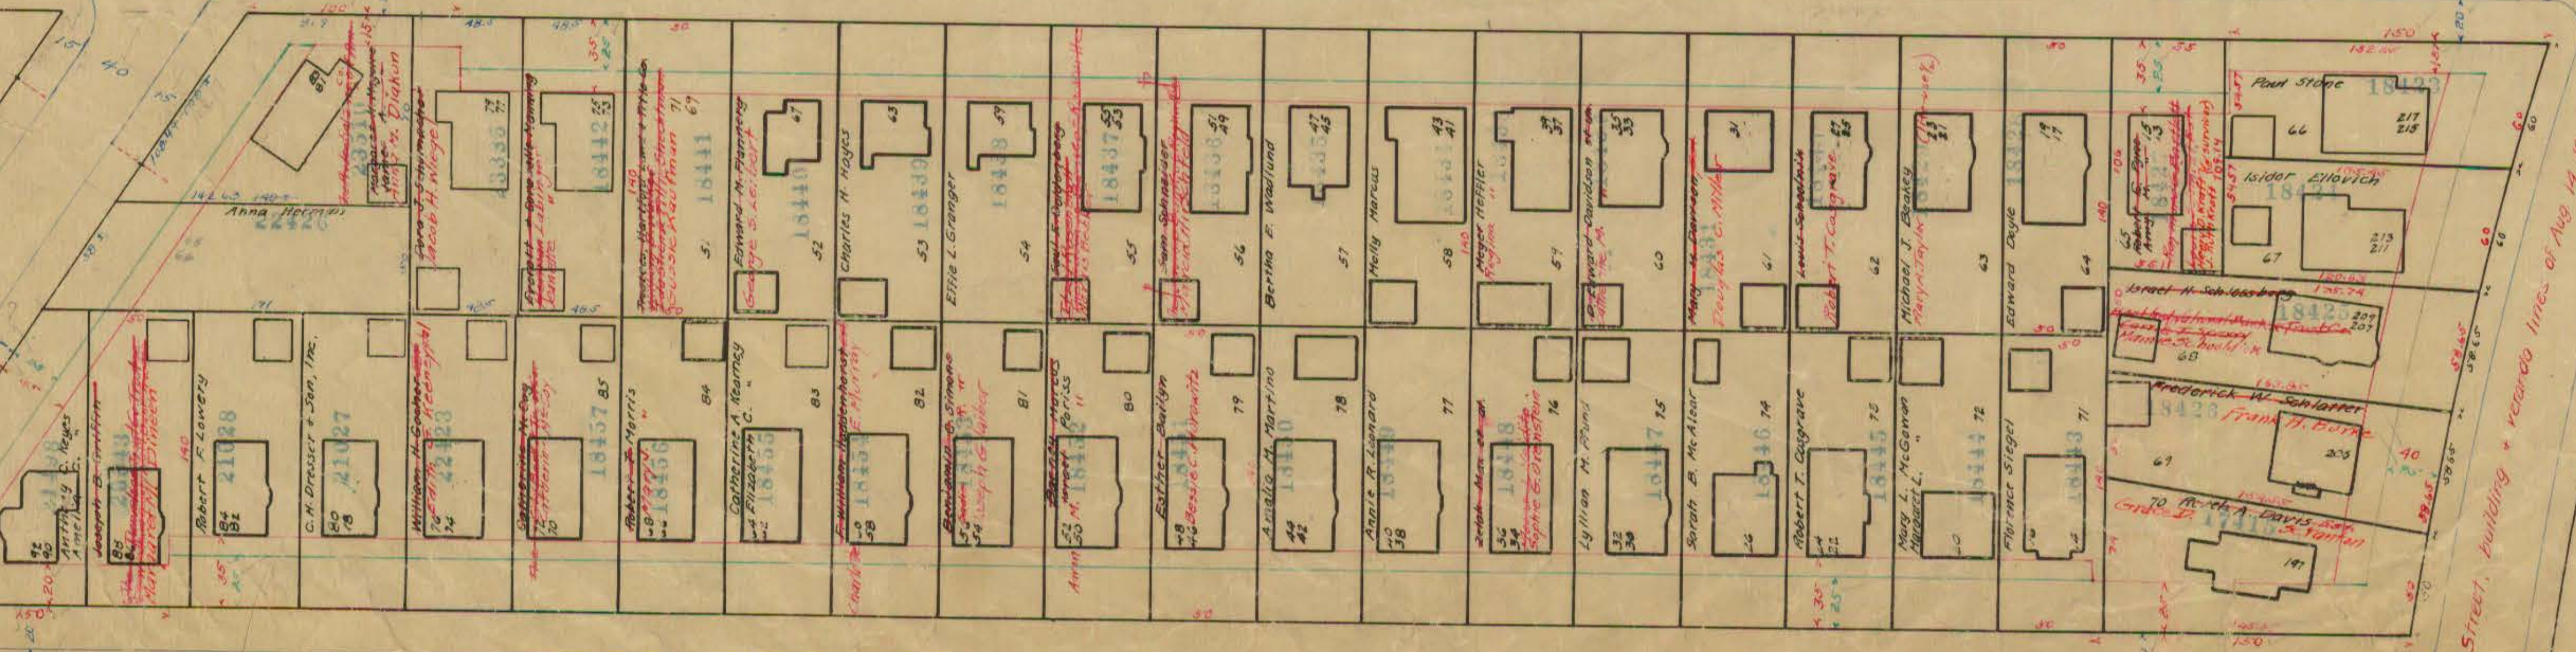

BLUE HILLS AVENUE

For lots on Chatham St. see "Minkoff" cut-up, May 1927 plan 256-30.

For lots on Plainfield St. see "Minkoff" cut-up, May 1927 plan 256-30.