


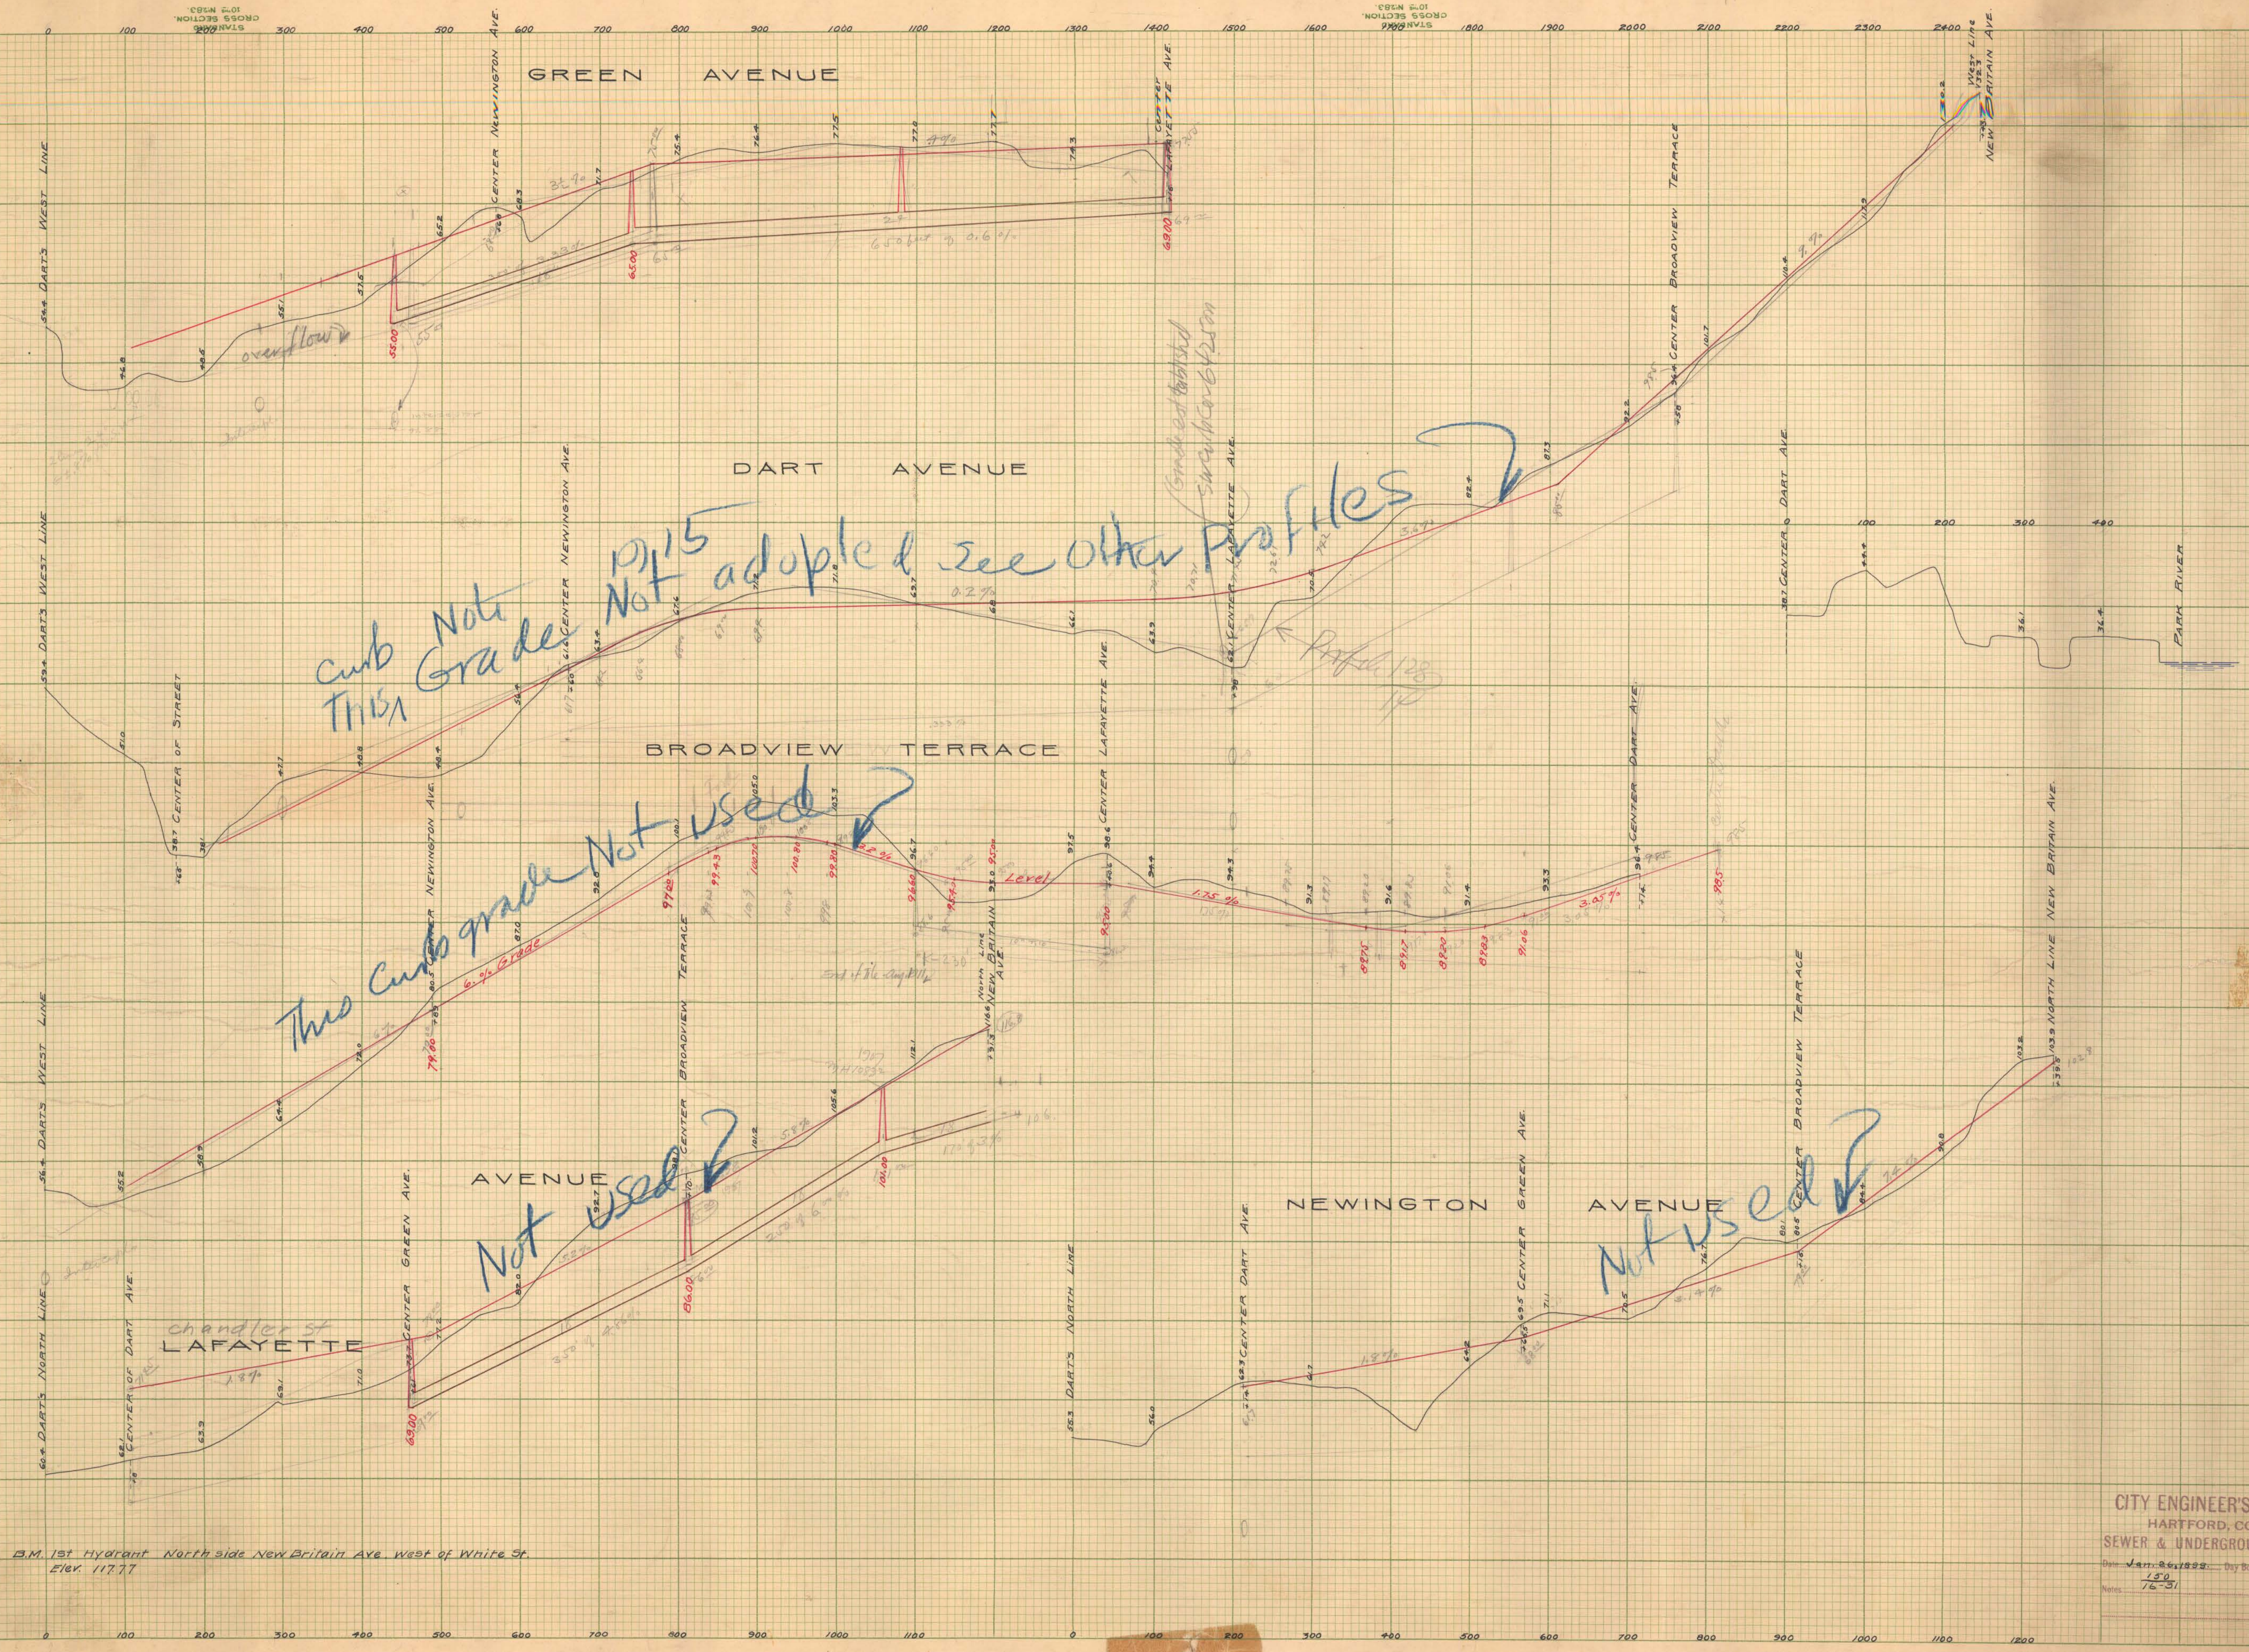

B.M. 1st Hydrant North side New Britain Ave. West of White St.
Elev. 117.77