


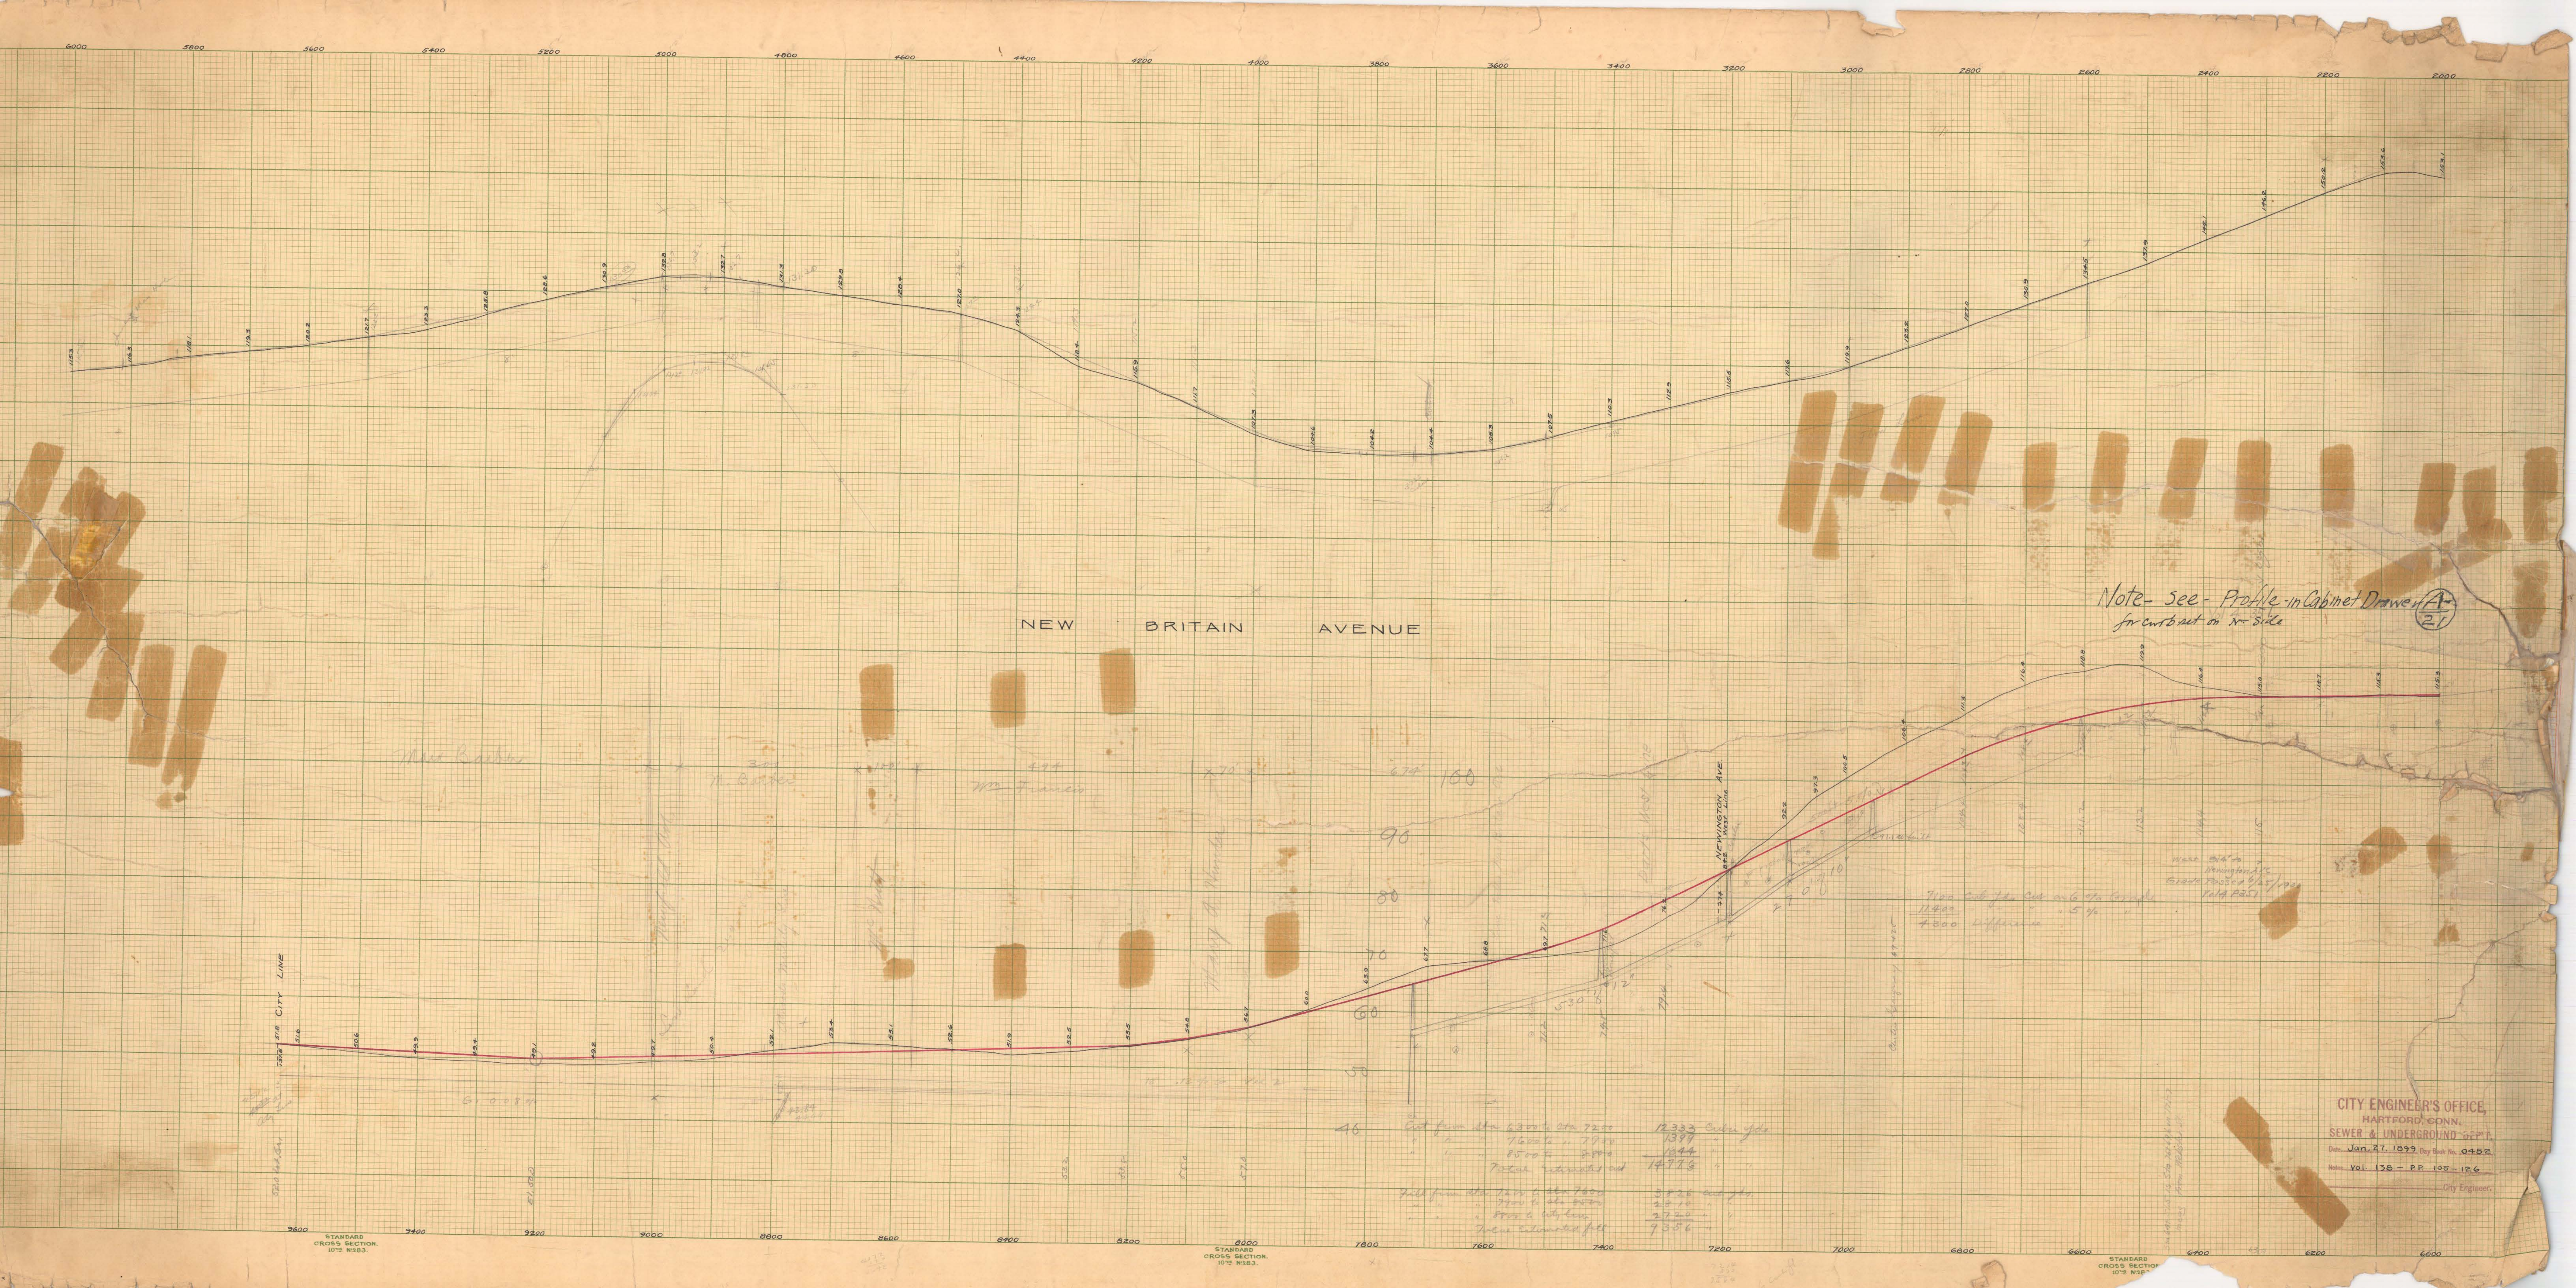

Note - see - Profile in Cabinet Drawer A-21
for contract on N. side

CITY ENGINEER'S OFFICE,
HARTFORD, CONN.
SEWER & UNDERGROUND DEPT.
Date, Jan. 27, 1892, Day Book No. 0452
Notes, Vol. 138 - Pp. 105-126
City Engineer,