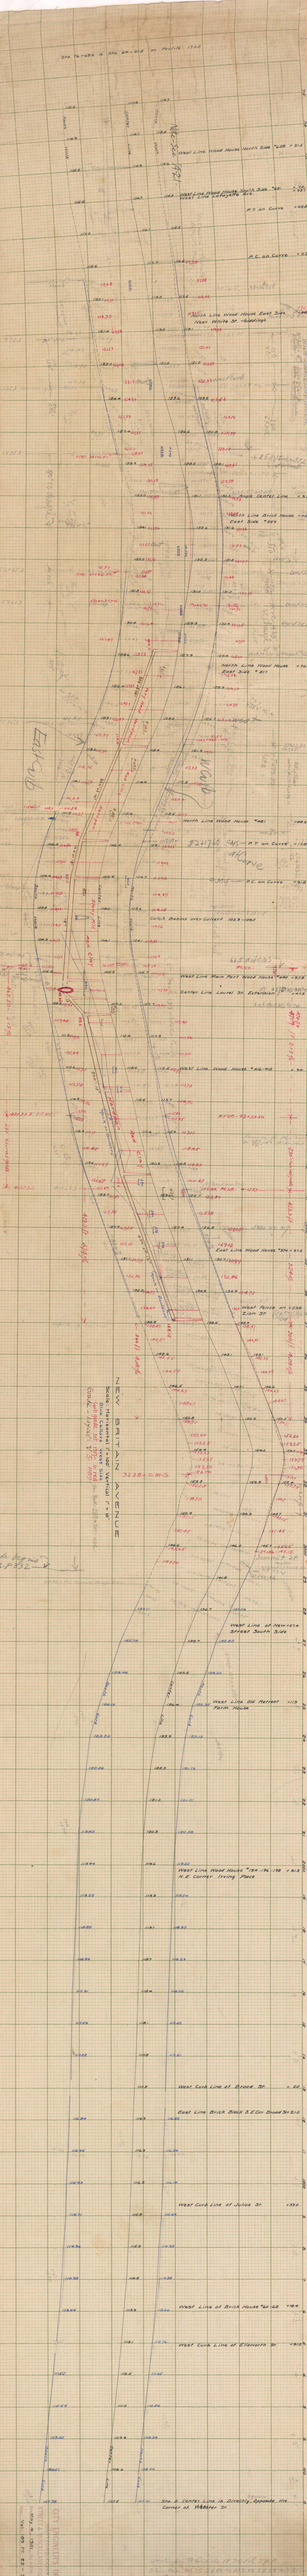
NEW BRITAIN AVENUE
Scale: 1 inch = 50 feet
Vertical 1" = 8'
Grade Elevations Vertical 1" = 8'
East Curb
West Curb
West Line Wood House "40-42"
East Line Wood House "39"
West Line of Property
Point House
West Line Wood House "38-36-34"
N.E. Corner Irving Place
