
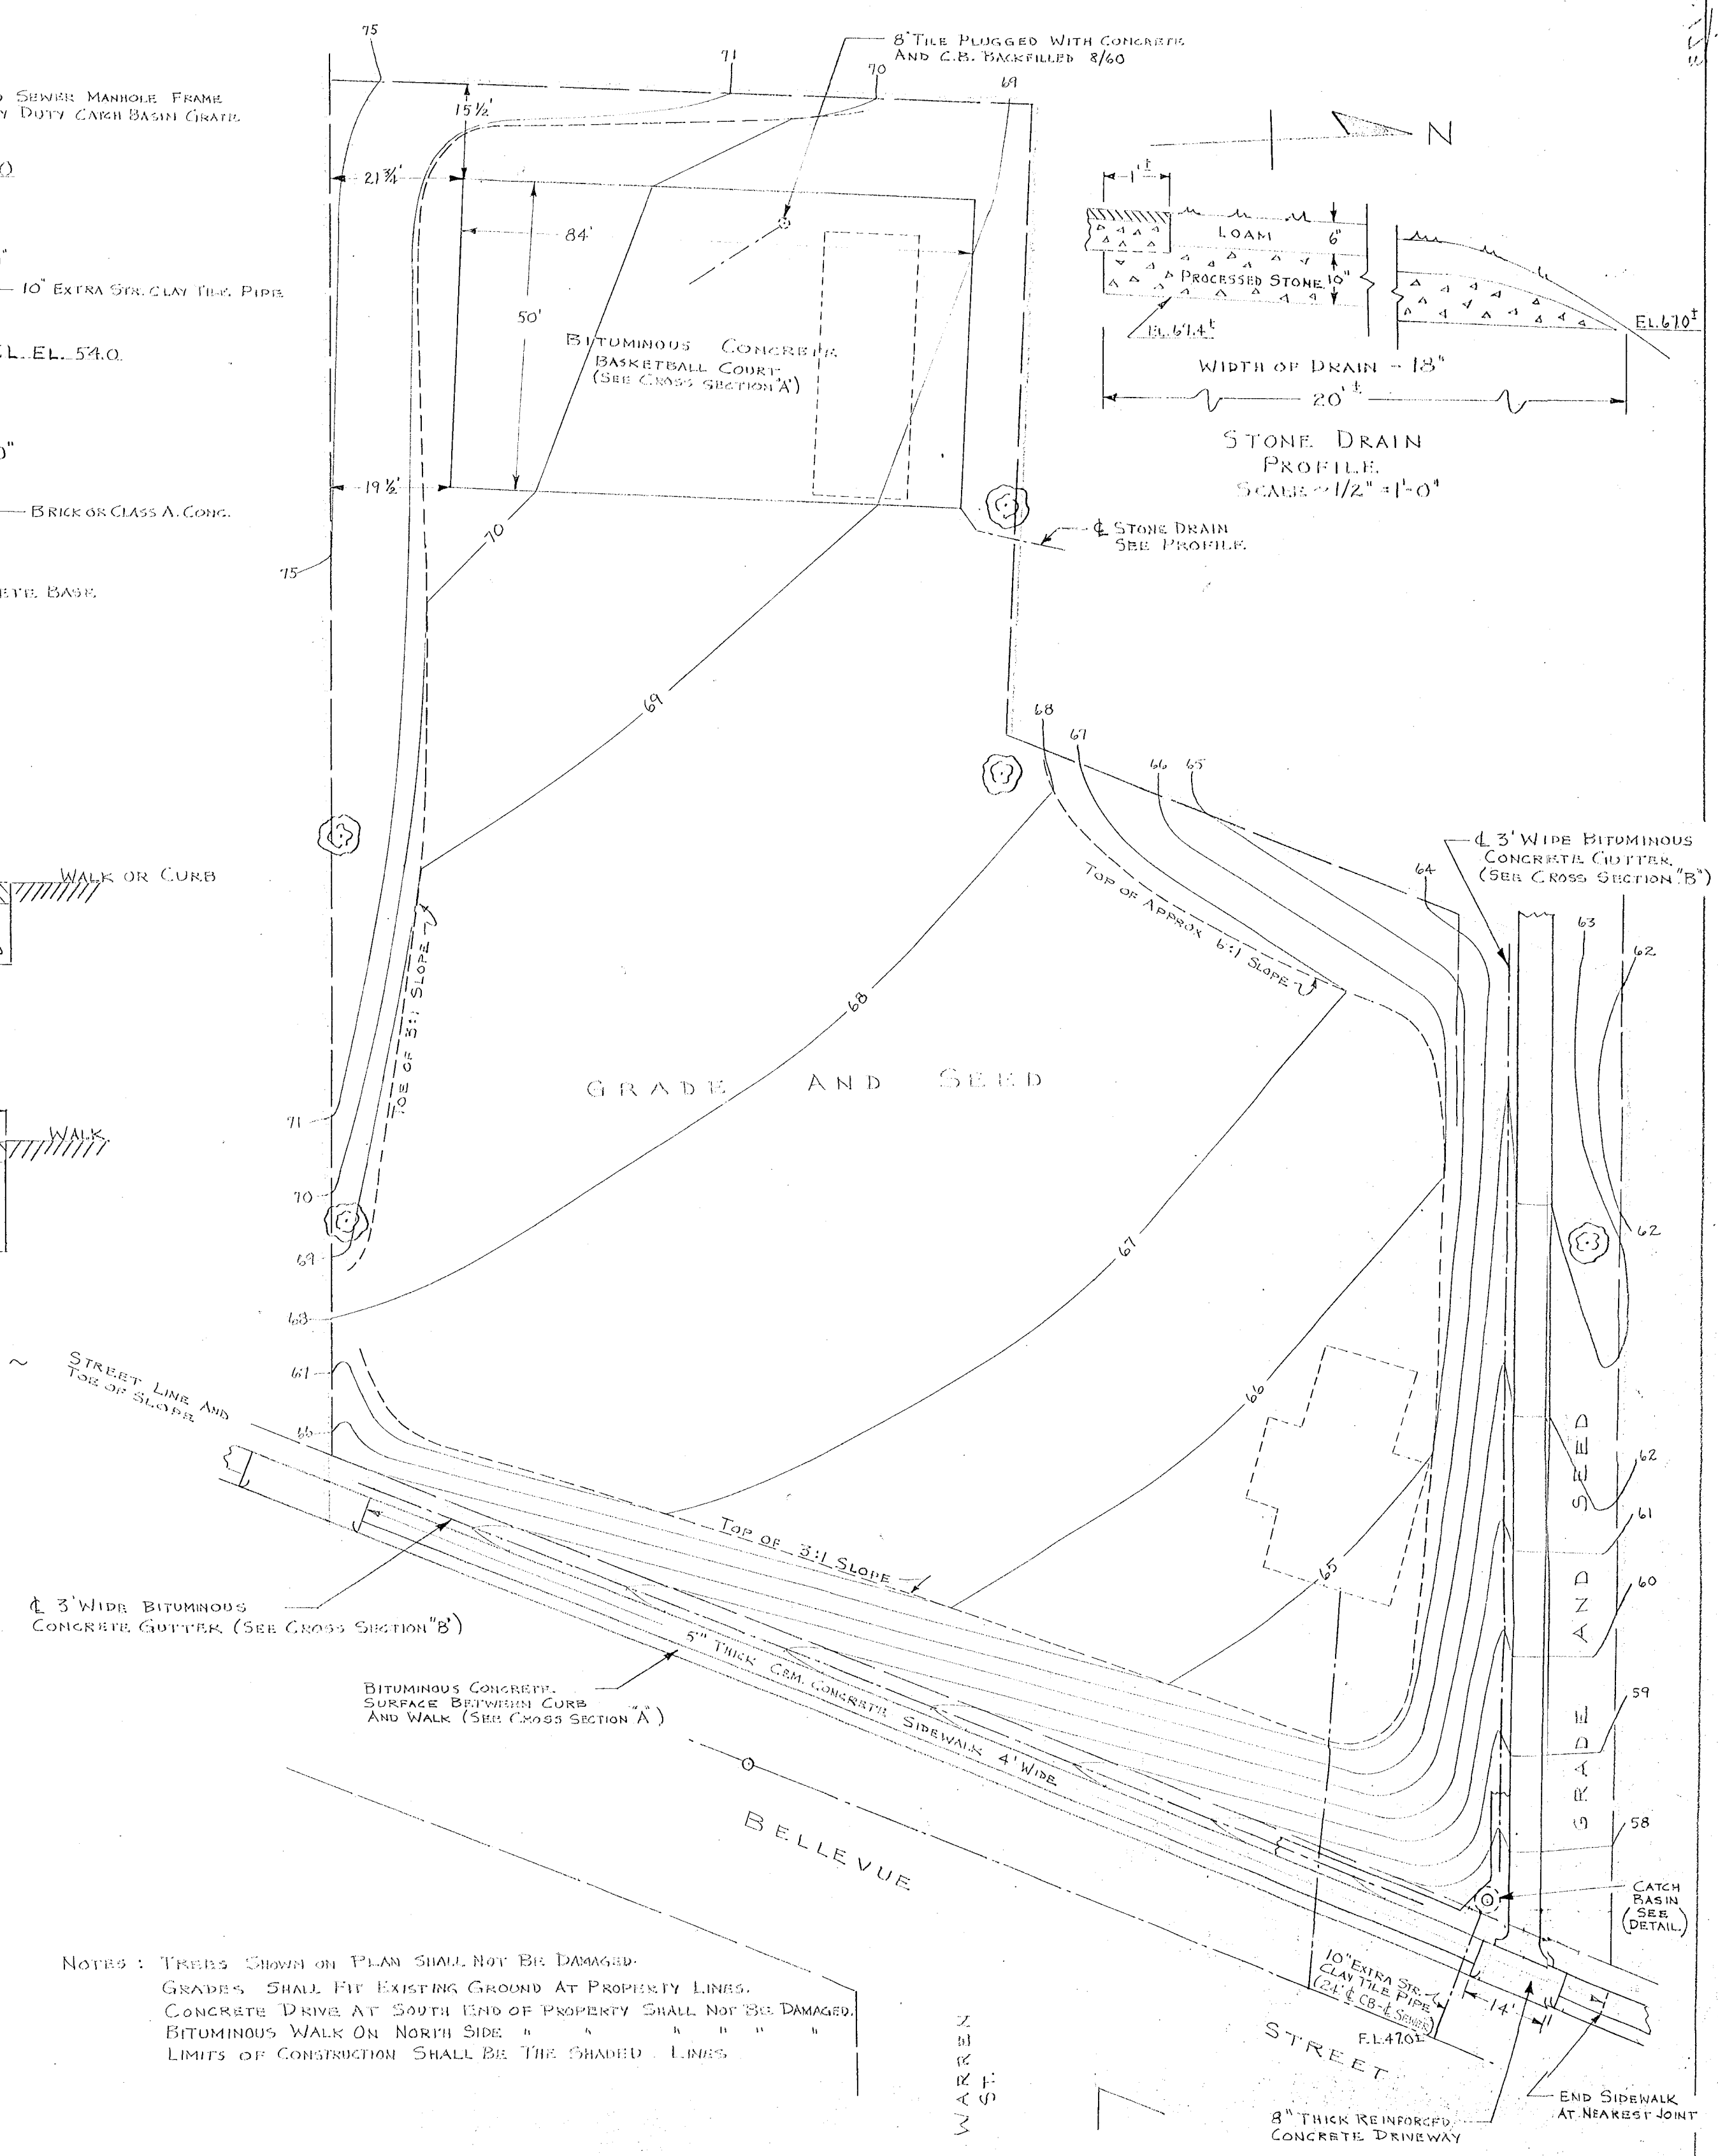
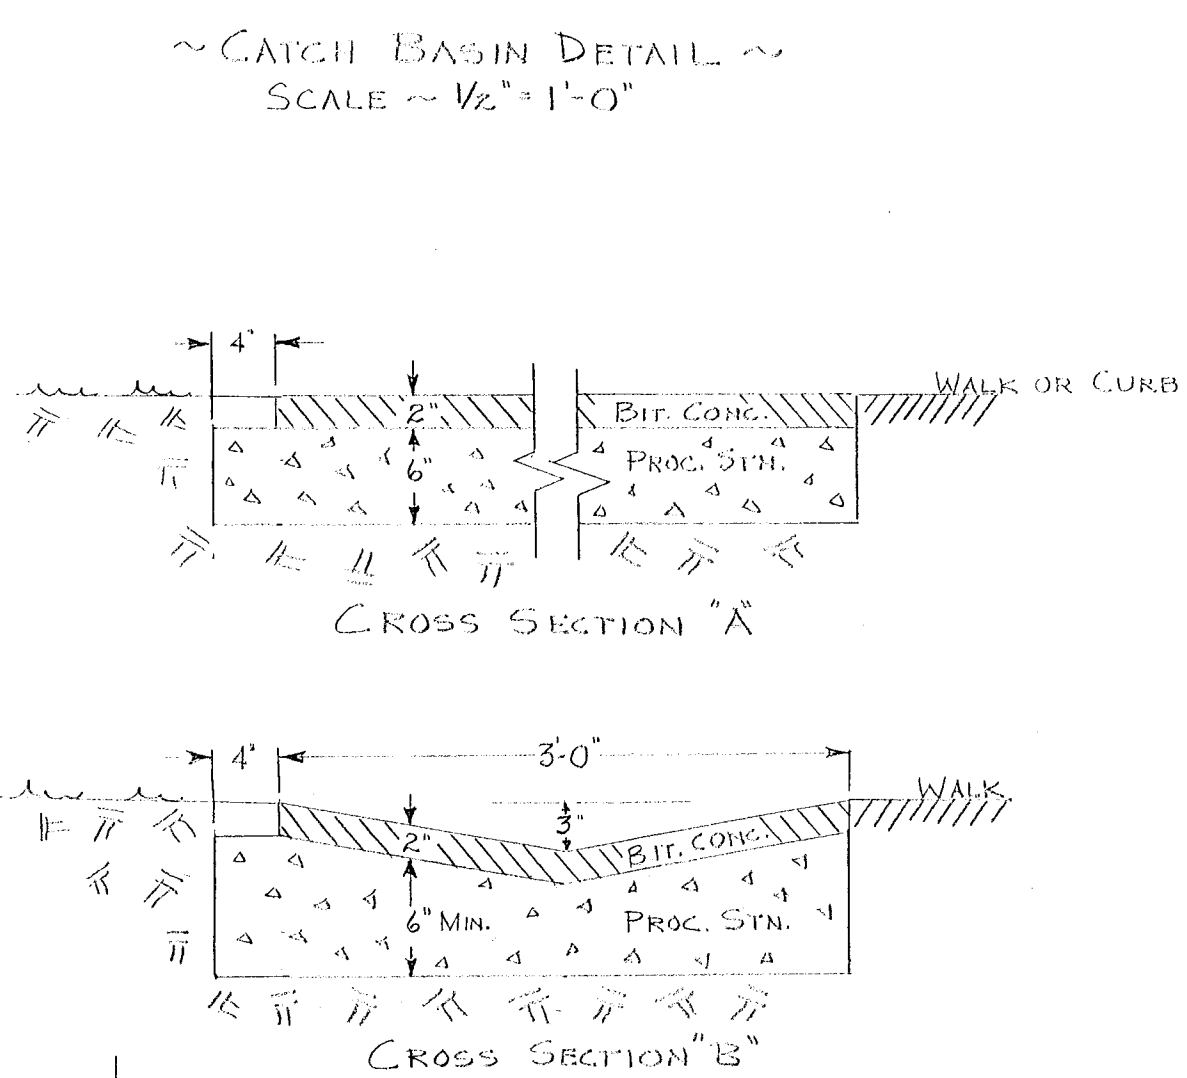
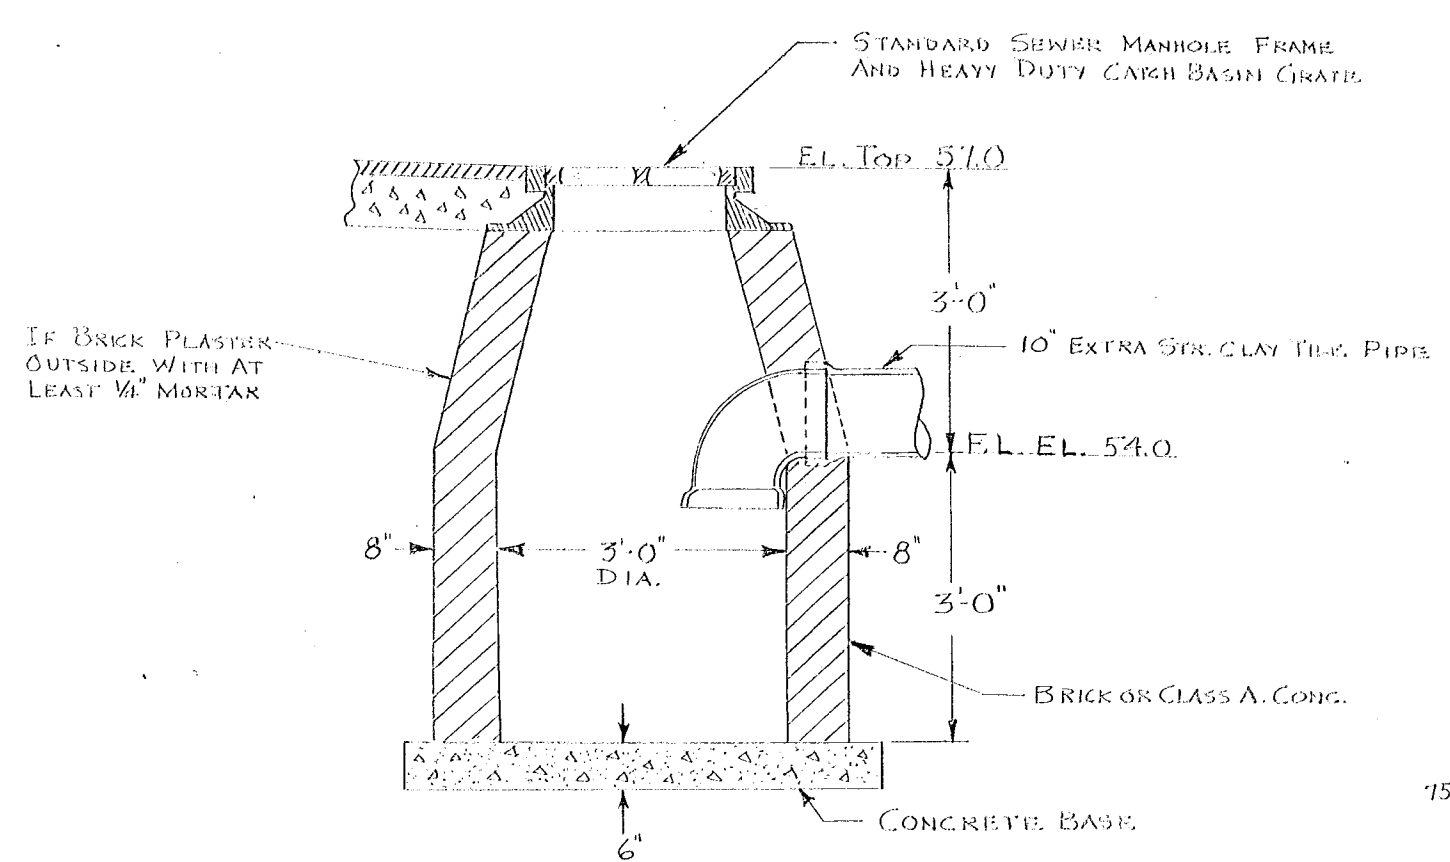


ST. BENEDICT'S CENTER
(THE HARTFORD ROMAN CATHOLIC DIOCESEAN CORPORATION)

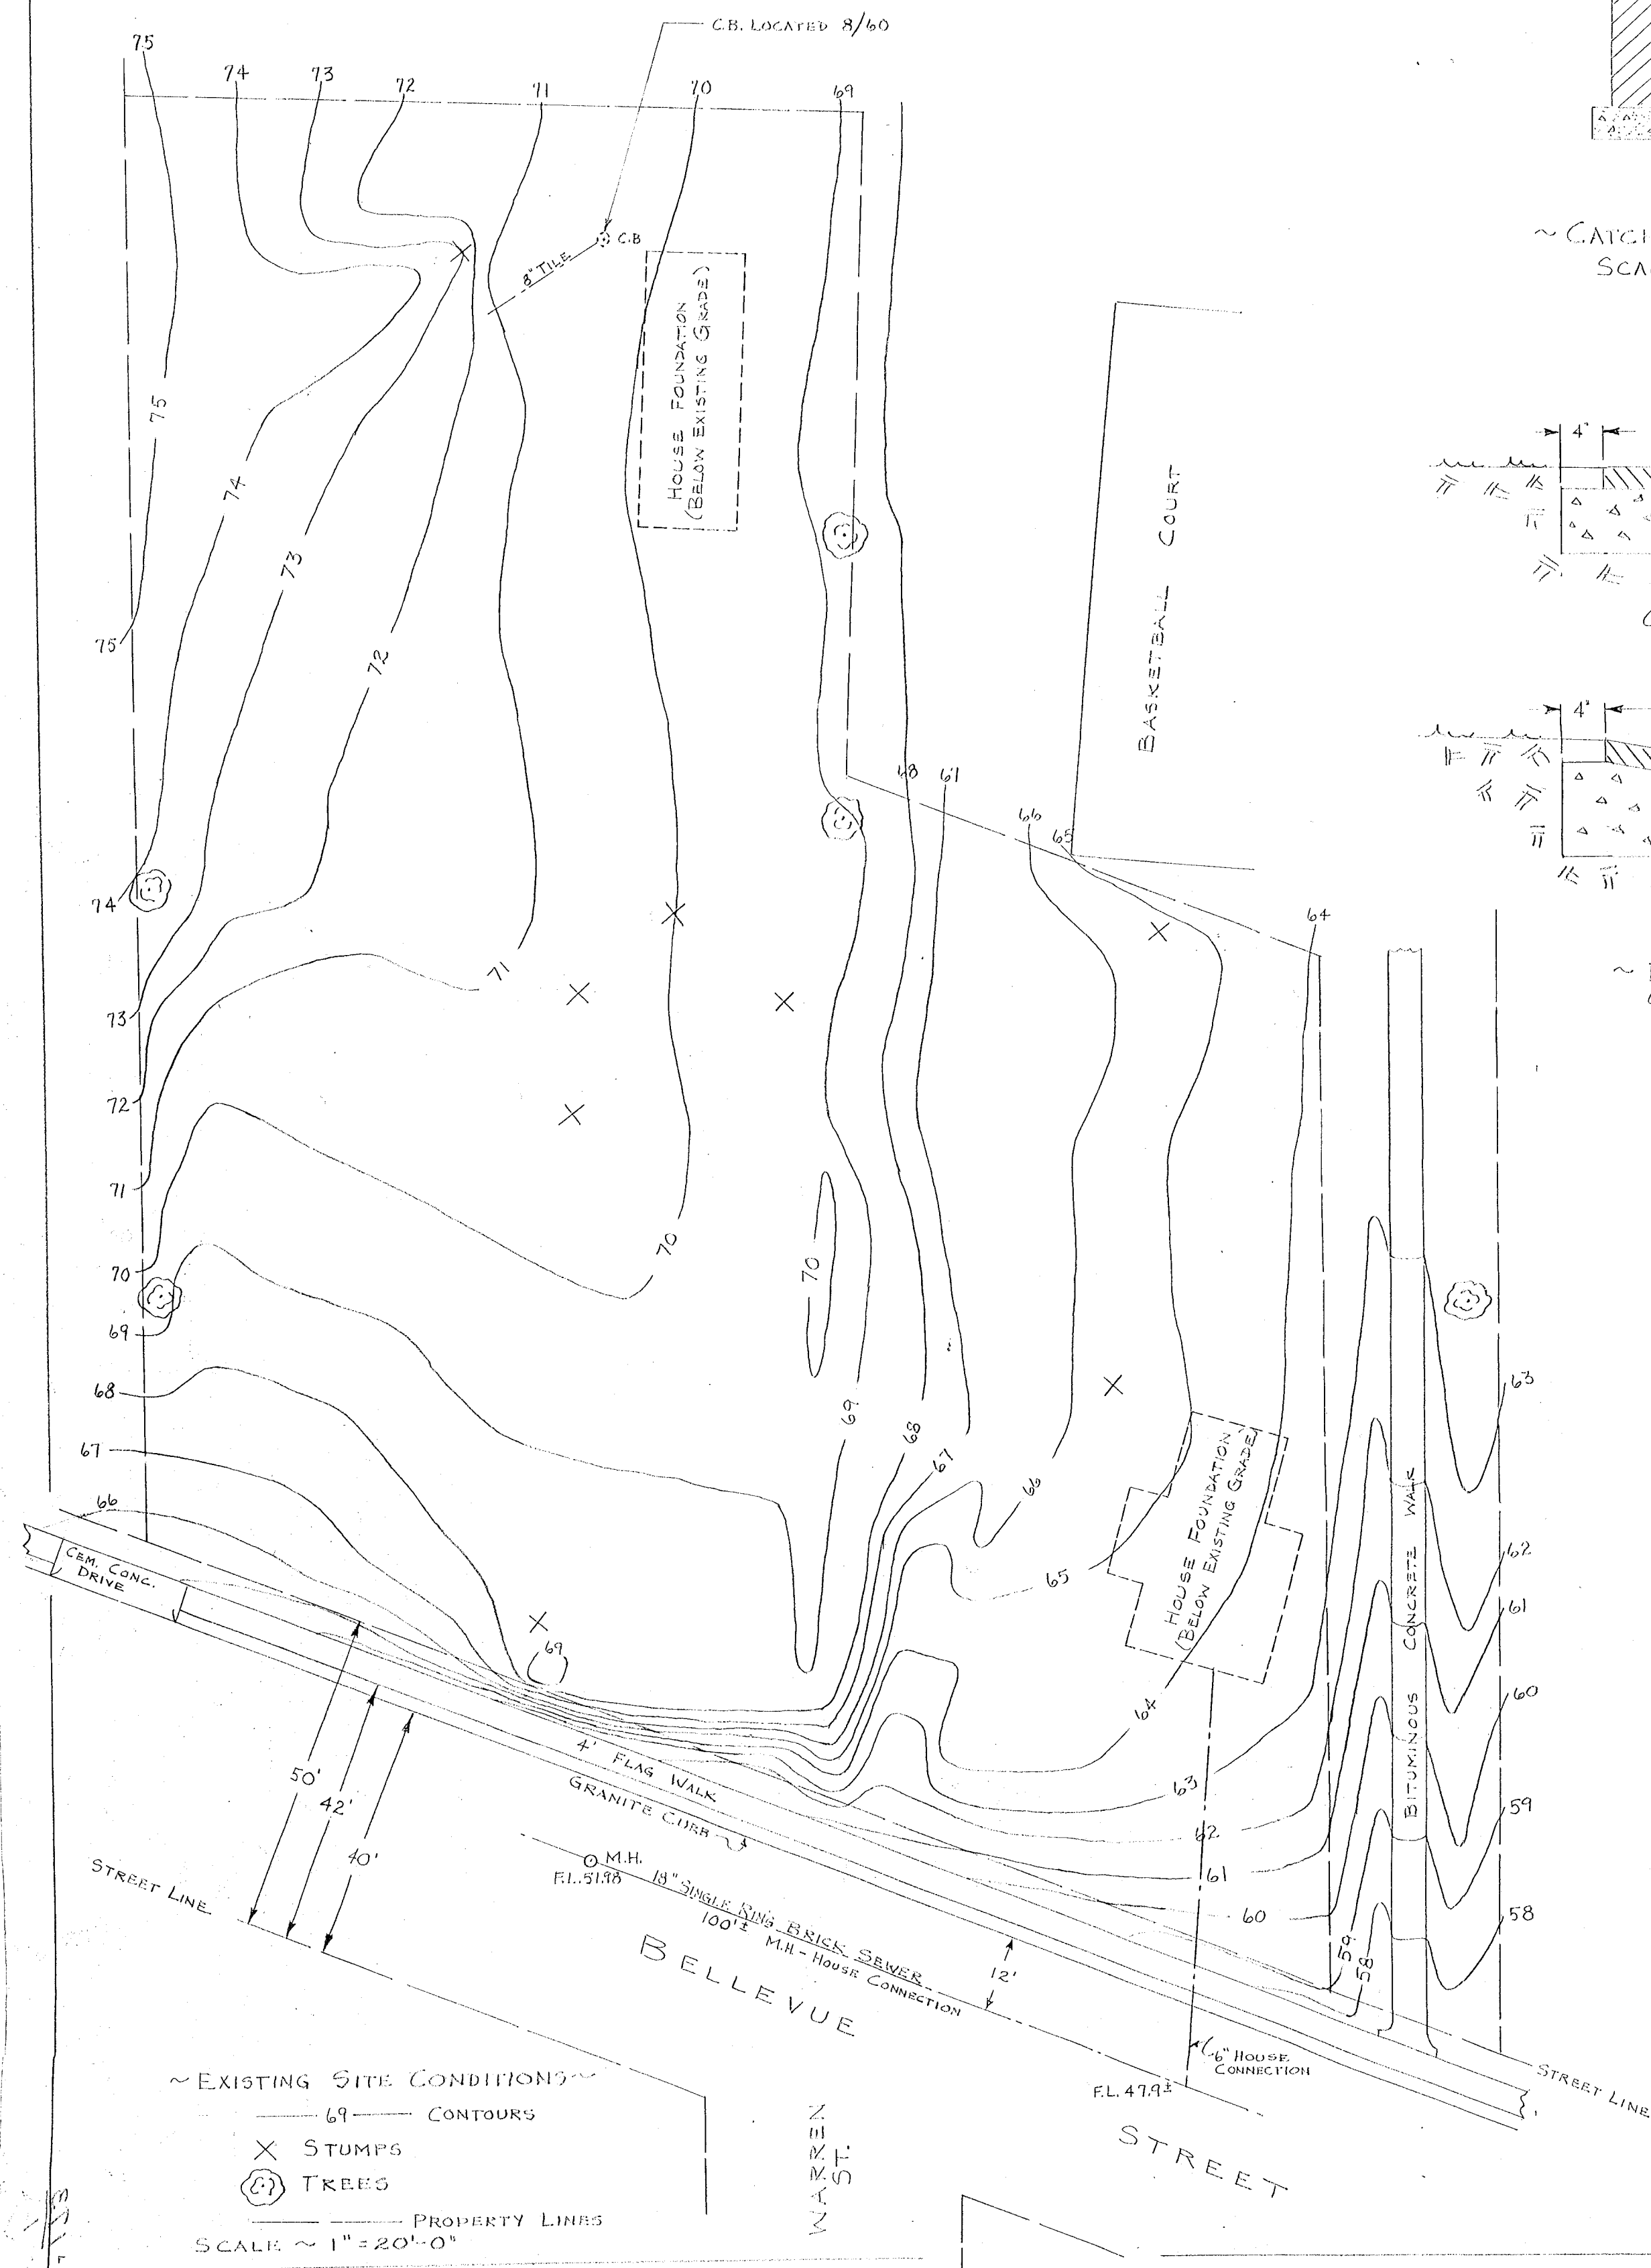

NOTES: TREES SHOWN ON PLAN SHALL NOT BE DAMAGED.
GRADES SHALL FIT EXISTING GROUND AT PROPERTY LINES.
CONCRETE DRIVE AT SOUTH END OF PROPERTY SHALL NOT BE DAMAGED.
BITUMINOUS WALK ON NORTH SIDE " " " " " "
LIMITS OF CONSTRUCTION SHALL BE THE SHADED LINES

~ PLAN ~
SCALE ~ 1" = 20'-0"

CITY OF HARTFORD, CONNECTICUT DEPARTMENT OF ENGINEERING	
BELLEVUE STREET PLAY AREA GRADING SEEDING PAVING DRAINAGE	
SCALE AS NOTED	
SUBMITTED BY George E. Hoffman	DESIGNED BY Richard H. Barrows
CHECKED BY E. J. P.	APPROVED BY [Signature]
DATE JUNE, 1960	DAYBOOK NO. 09617