


12/3/71

COVENTRY ST.


HOLCOMB STREET

~ PLAN ~
SCALE ~ 1" = 20'-0"
KENNEY

PARK

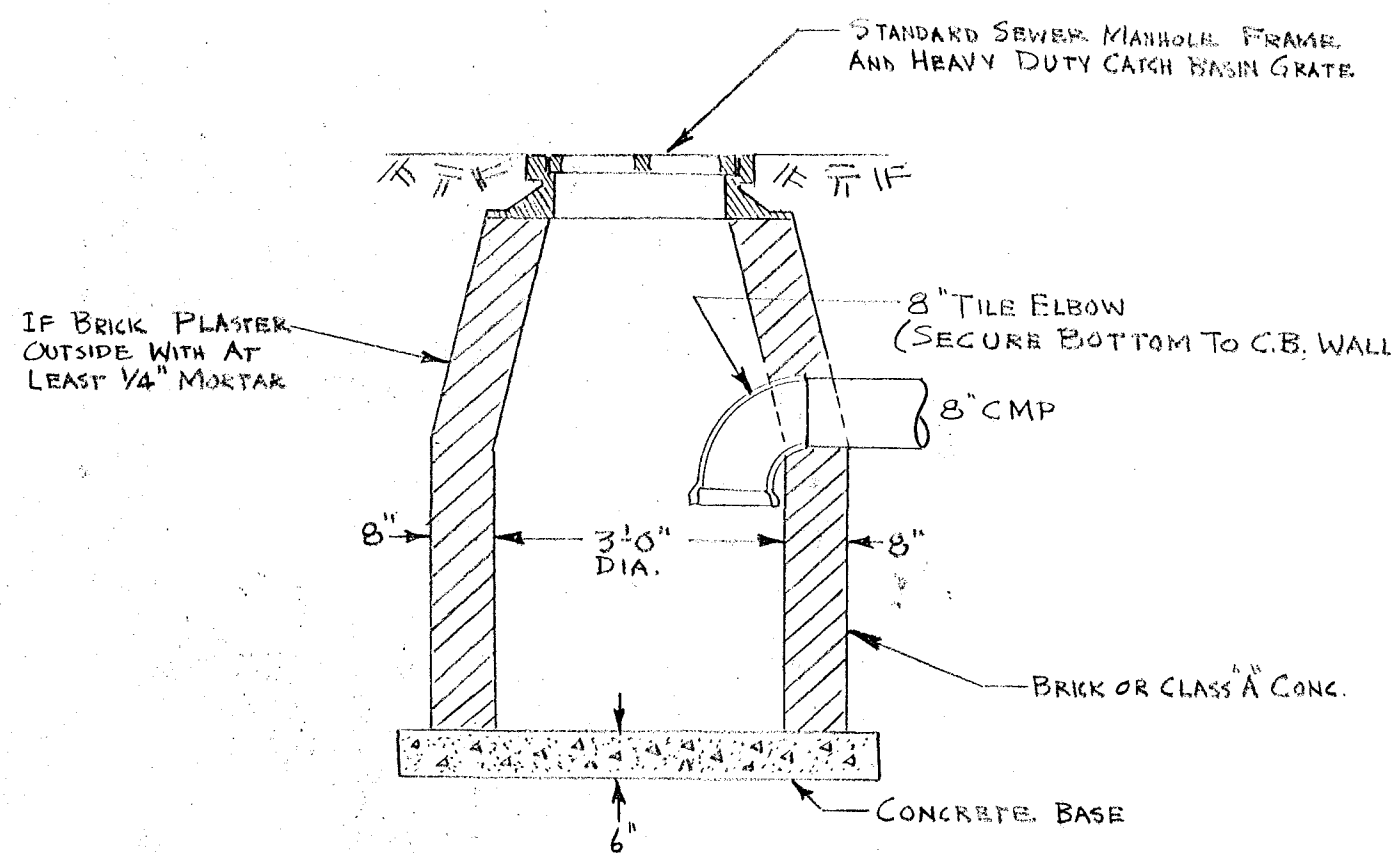


~ CATCH BASIN DETAIL A ~
SCALE ~ 1/2" = 1'-0"

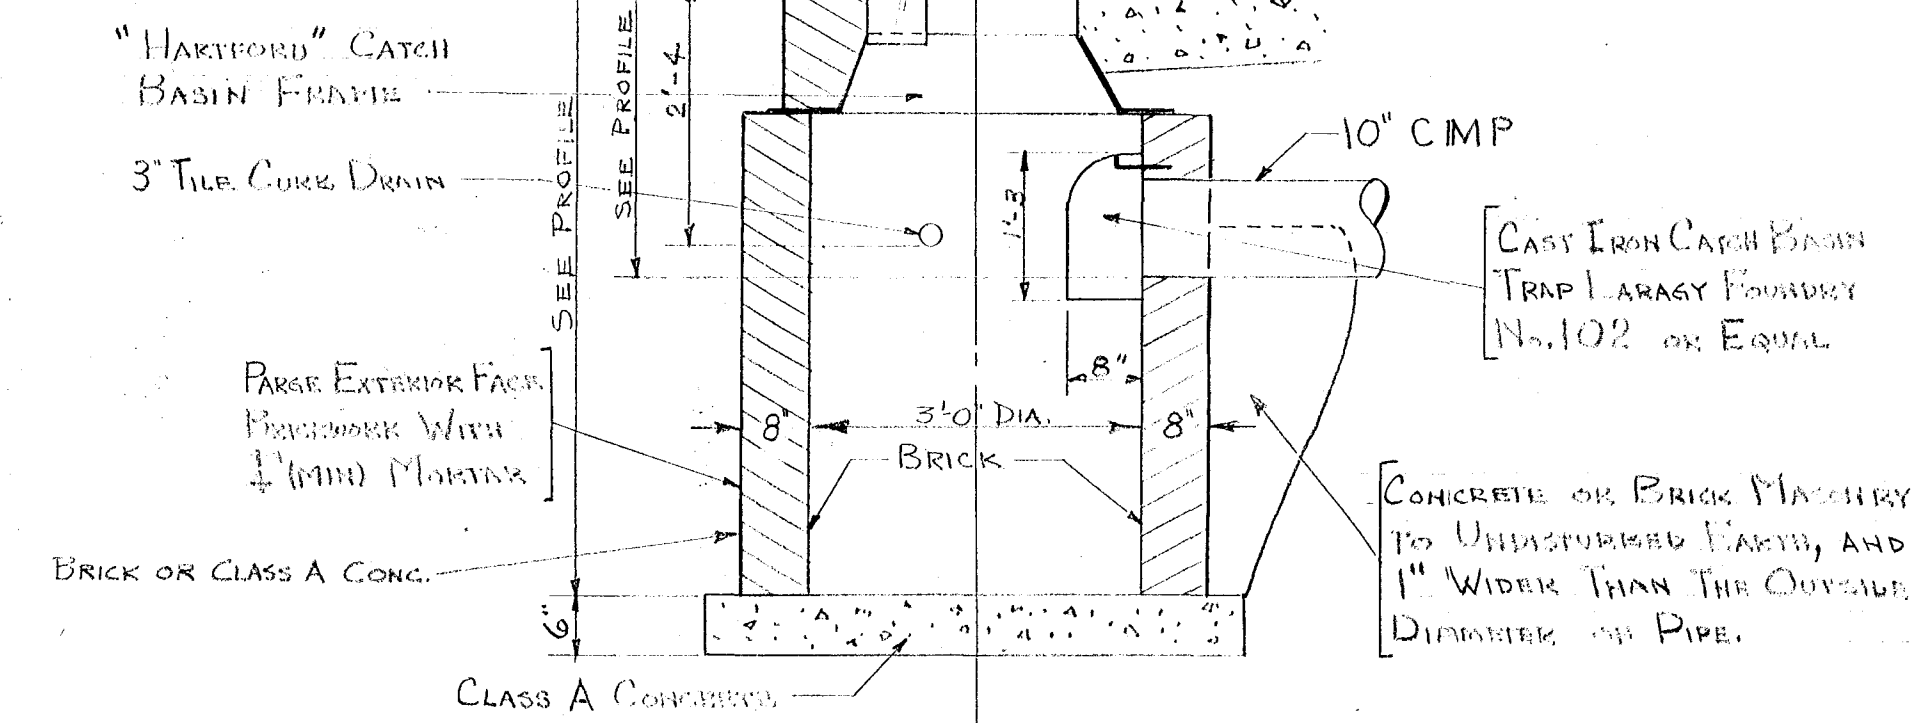

STANDARD CATCH BASIN DETAIL B
METROPOLITAN DISTRICT JAN 1951

HOLCOMB STREET CATCH BASIN AND KENNEY PARK DRAINAGE

CITY OF HARTFORD
DEPARTMENT OF ENGINEERING
SCALE ~ AS NOTED JULY 1960
DAYBOOK NO. 09638

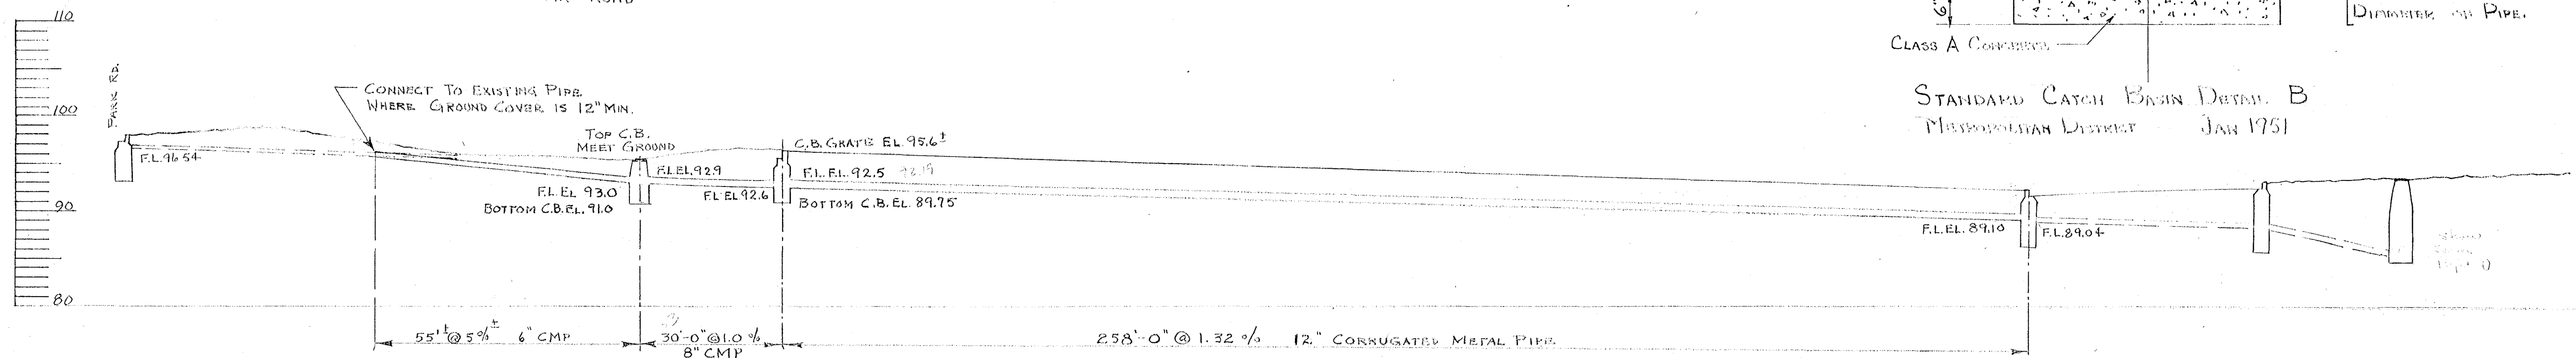

~ PROFILE ~
SCALE ~ HOR. 1" = 20'-0"
VER. 1" = 10'-0"