


Sta 0 100 200 300 400 500 600 700 800 900 1000 1100 1200 1300 1400 1500 1600 1700 1800

Profile on Sigourney Street Extension to Albany Ave.

Grade Line in blue Final Grade - ordered by R.R. Commissioners
Surface " " " is Profile on Sigourney St as laid out by Homestead Park Cor.

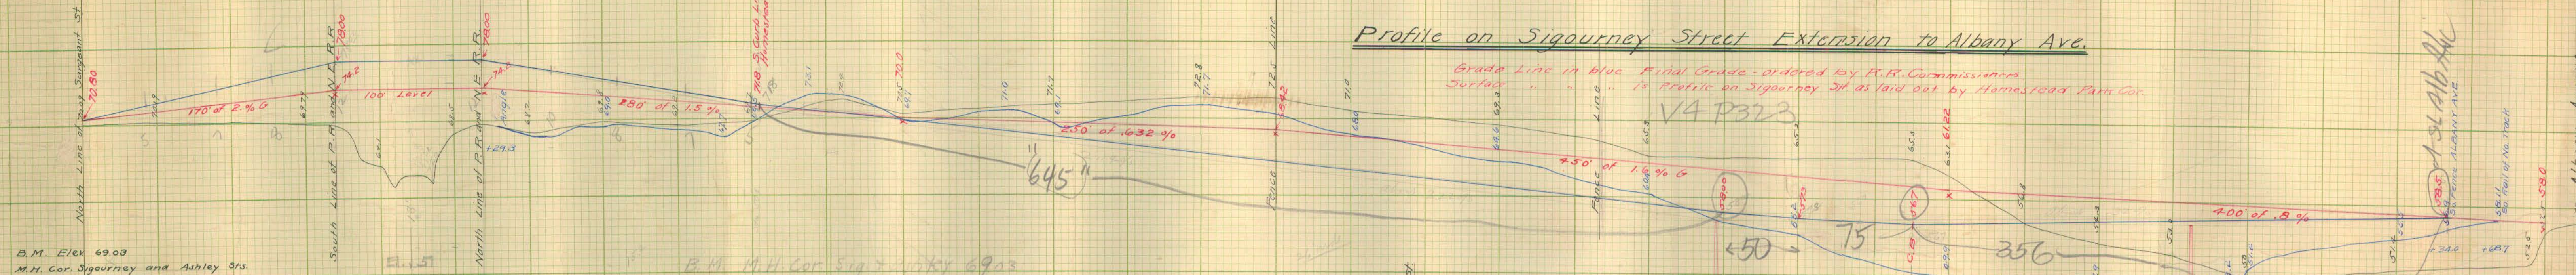

B.M. Elev 69.03
M.H. Cor. Sigourney and Ashley Sts.

B.M. M.H. Cor Sigourney and Ashley Sts 69.03

Temporary bench mark behind hill back of 69.03

Center of Proposed Sigourney St

Elev 57.00

Garden Street to Woodland St

Profile on track of Central New England R.R.

OFFICE NO.
DRAWER 173
SHEET 8