


Out

of

Service

Oct. 30 - 1941

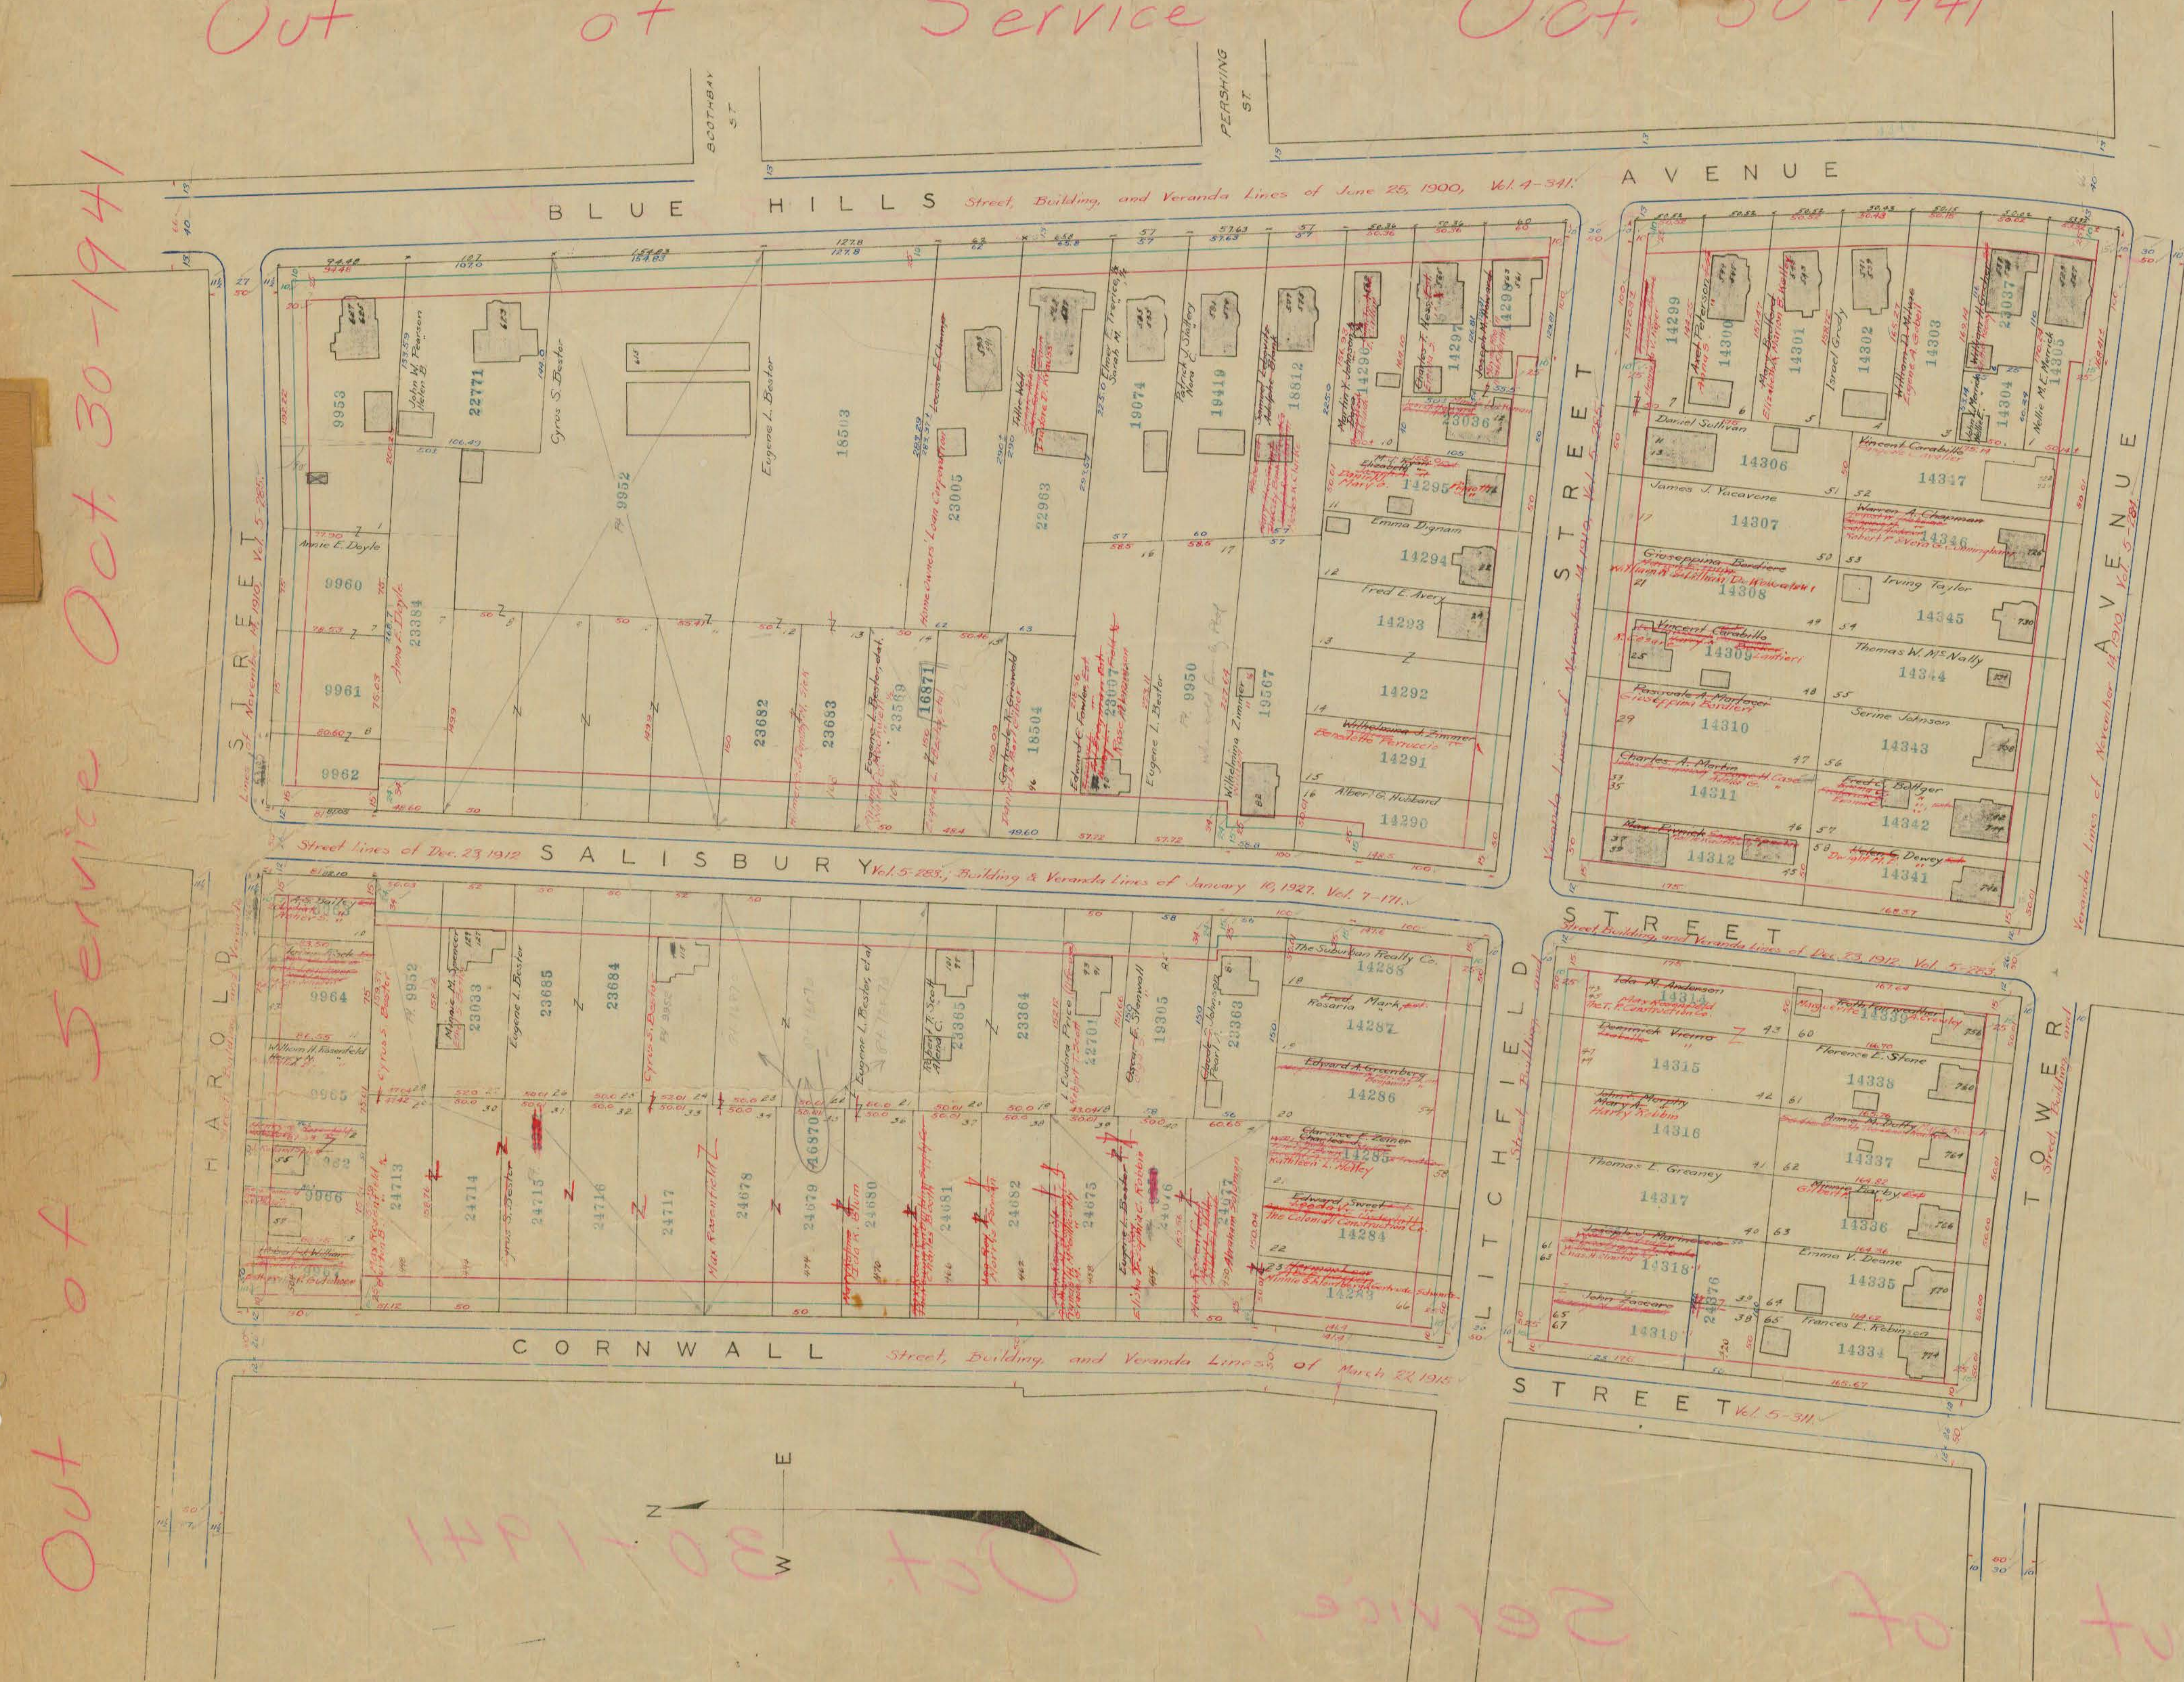

Oct 30 - 1941

Out of Service