


B.M. 103.33 Hy. 200.00 ft on Whitney opp. 1020 - 81

WHITNEY STREET (Center Line)

SCALE

1" Hori. = 50'

1" Ver. = 10'

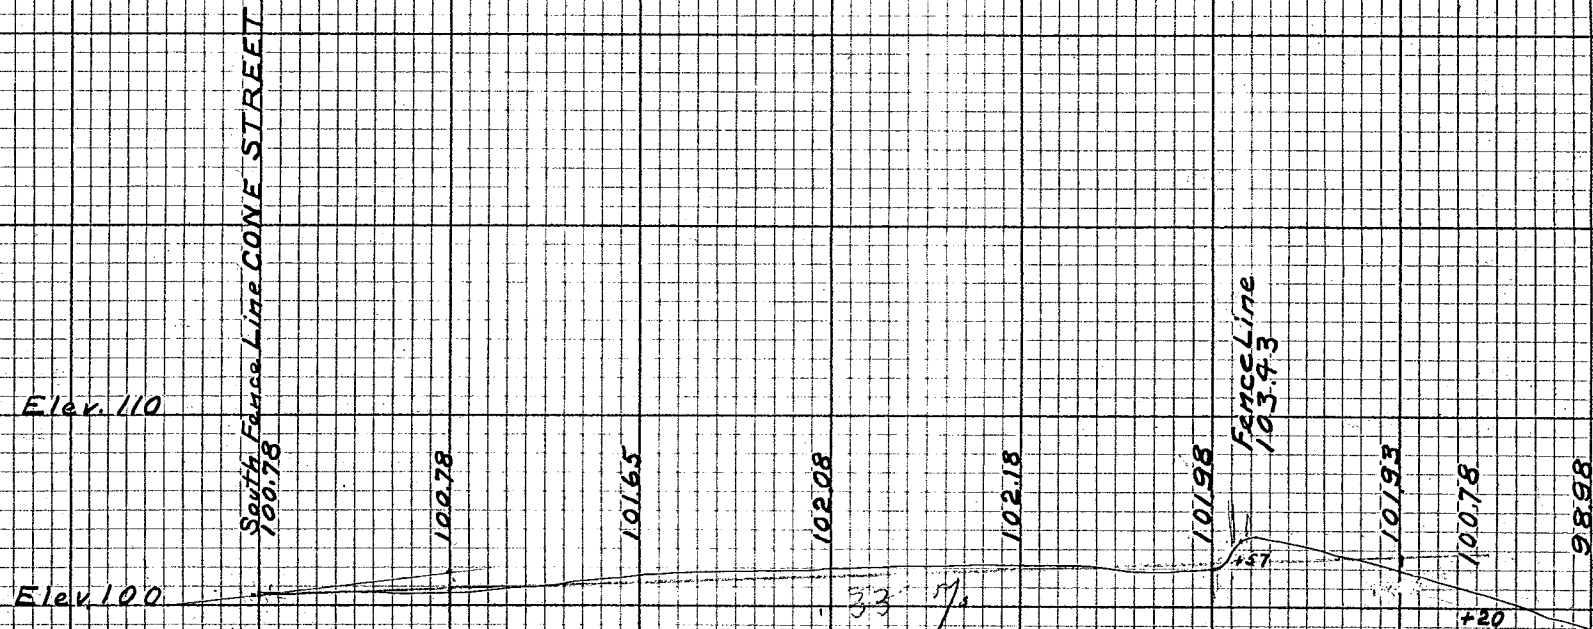

CITY SURVEYOR'S OFFICE,
HARTFORD, CONN.
STREET & MISCELLANEOUS DEPT.

Date Nov 1898 Notes _____ Day Book No. 0378

City Surveyor

132
100.5
101.32