


Out of Service Feb. 5-1935

TOWN

OF


BLOOMFIELD

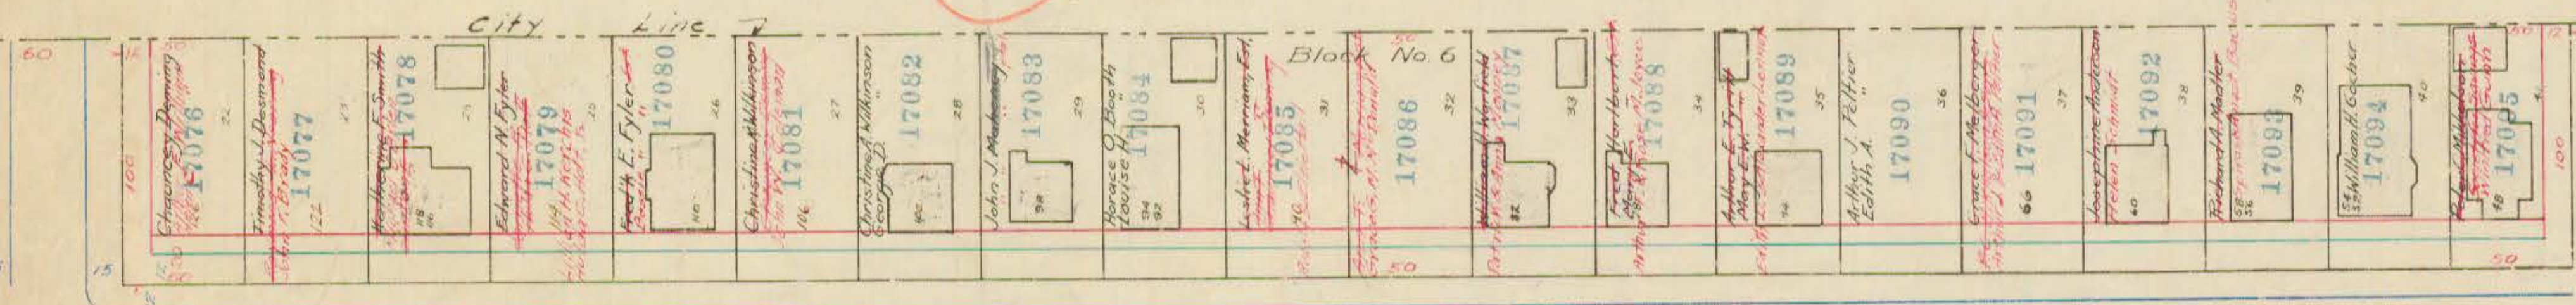

MORNING SIDE

Street, Building, and Veranda Lines of


STREET

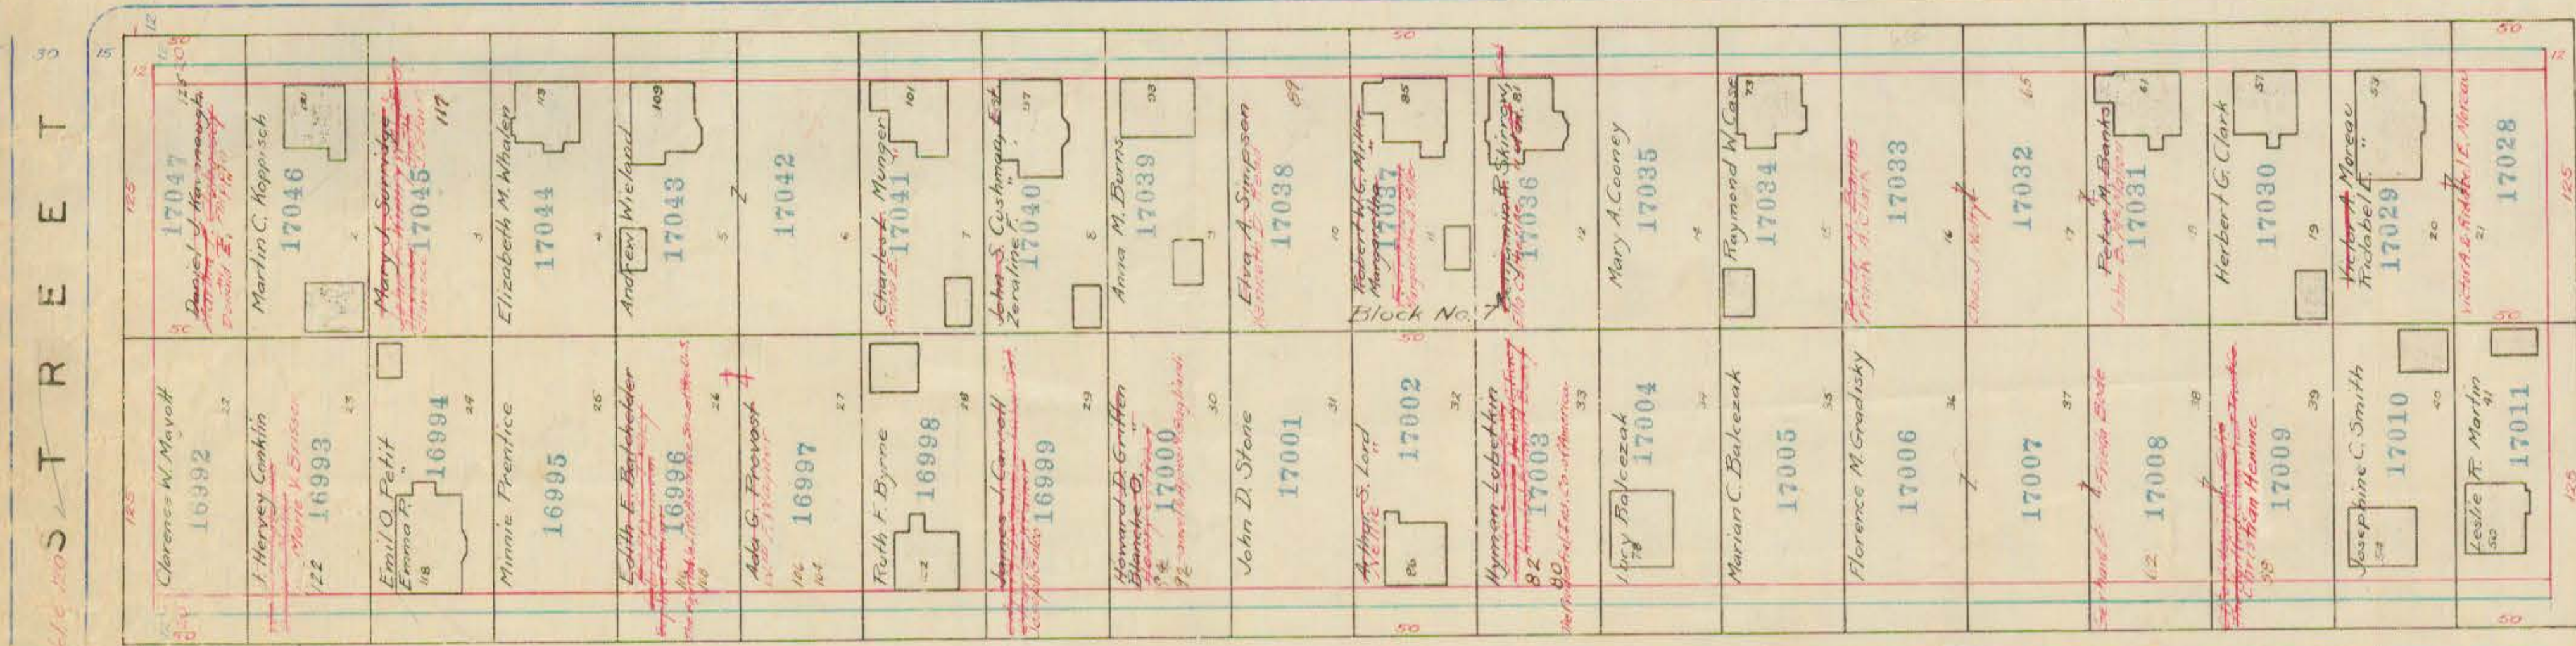

EUCLOUD


Street, Building, and Veranda Lines of

STREET

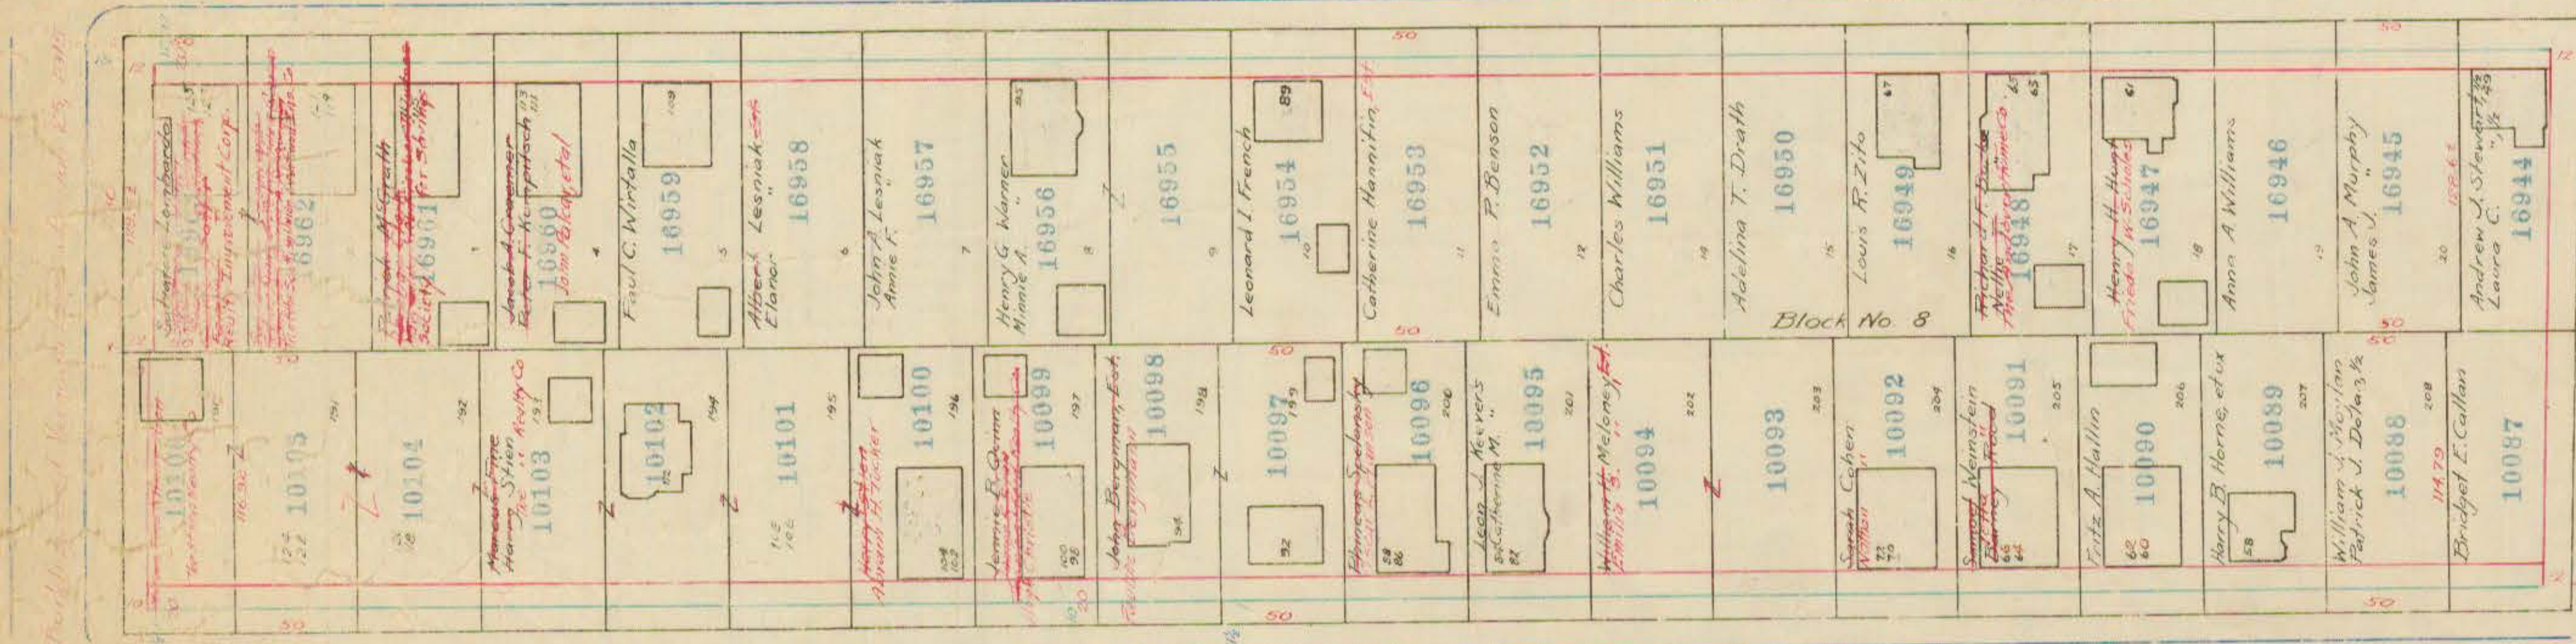

BURNHAM


Street Lines and Building and Veranda Lines (north side) of June 27, 1921, and Building and Veranda Lines (south side) of November 14, 1910, Vol. 5-284.

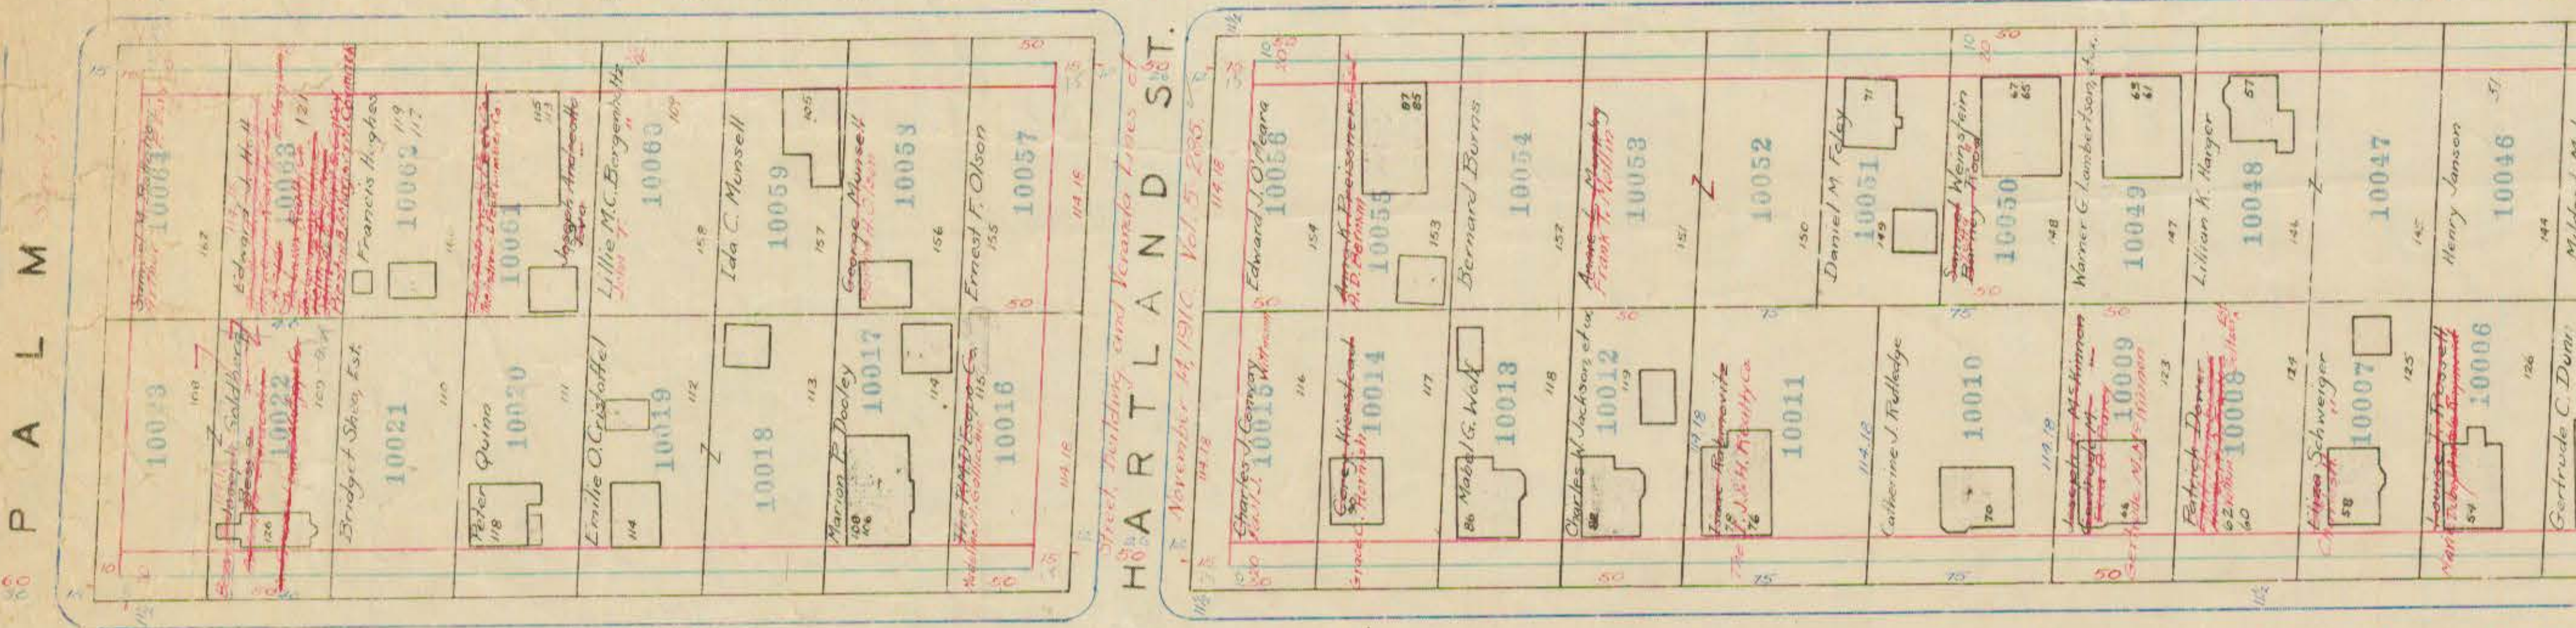


HAROLD

Street, Building, and Veranda Lines of


November 14, 1910, Vol. 5-285.

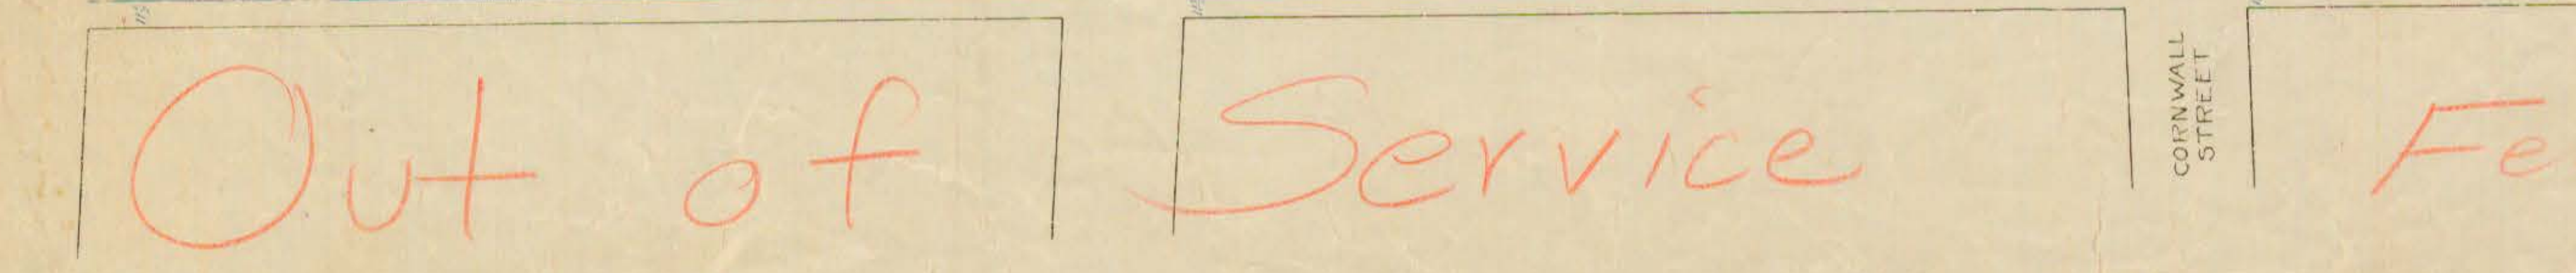


CORNWALL STREET

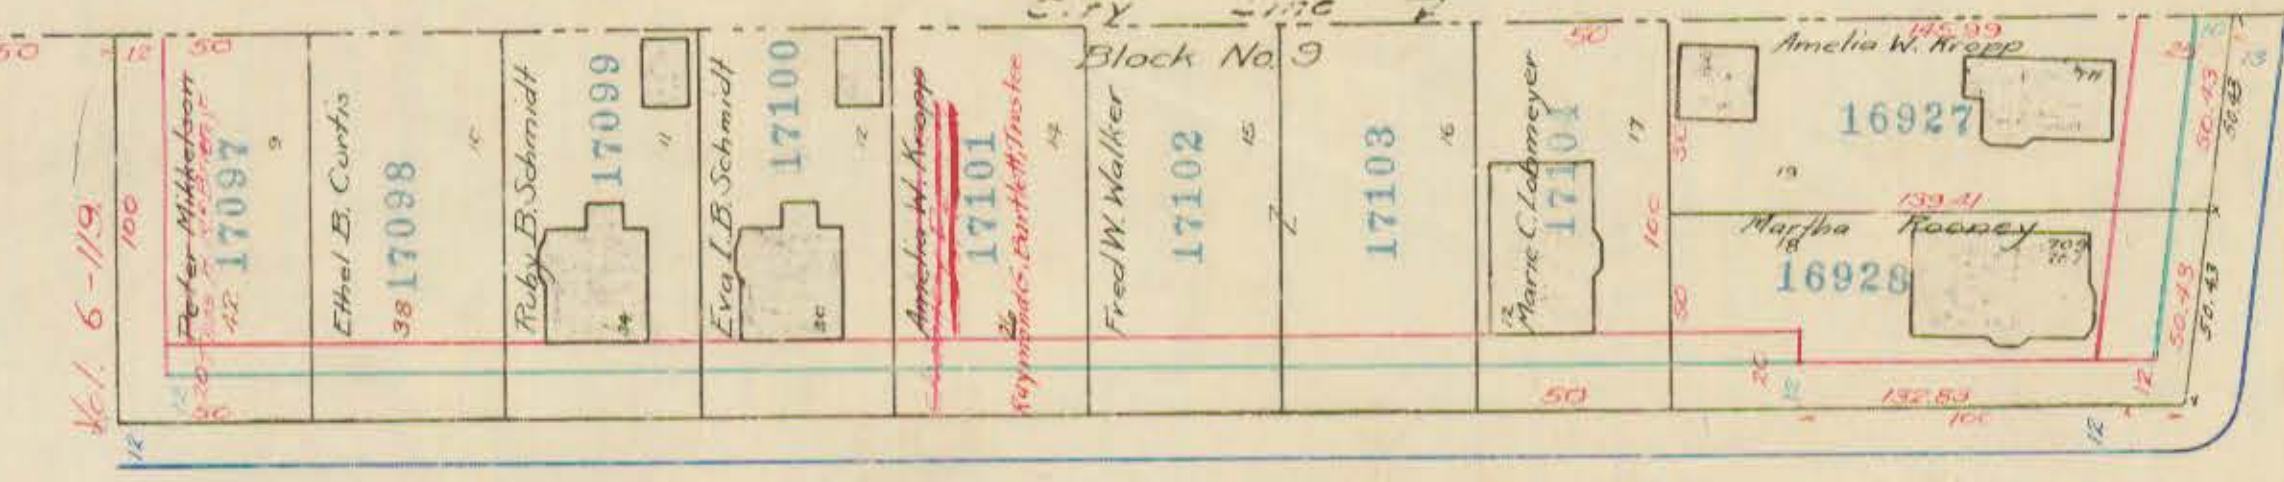


WEST

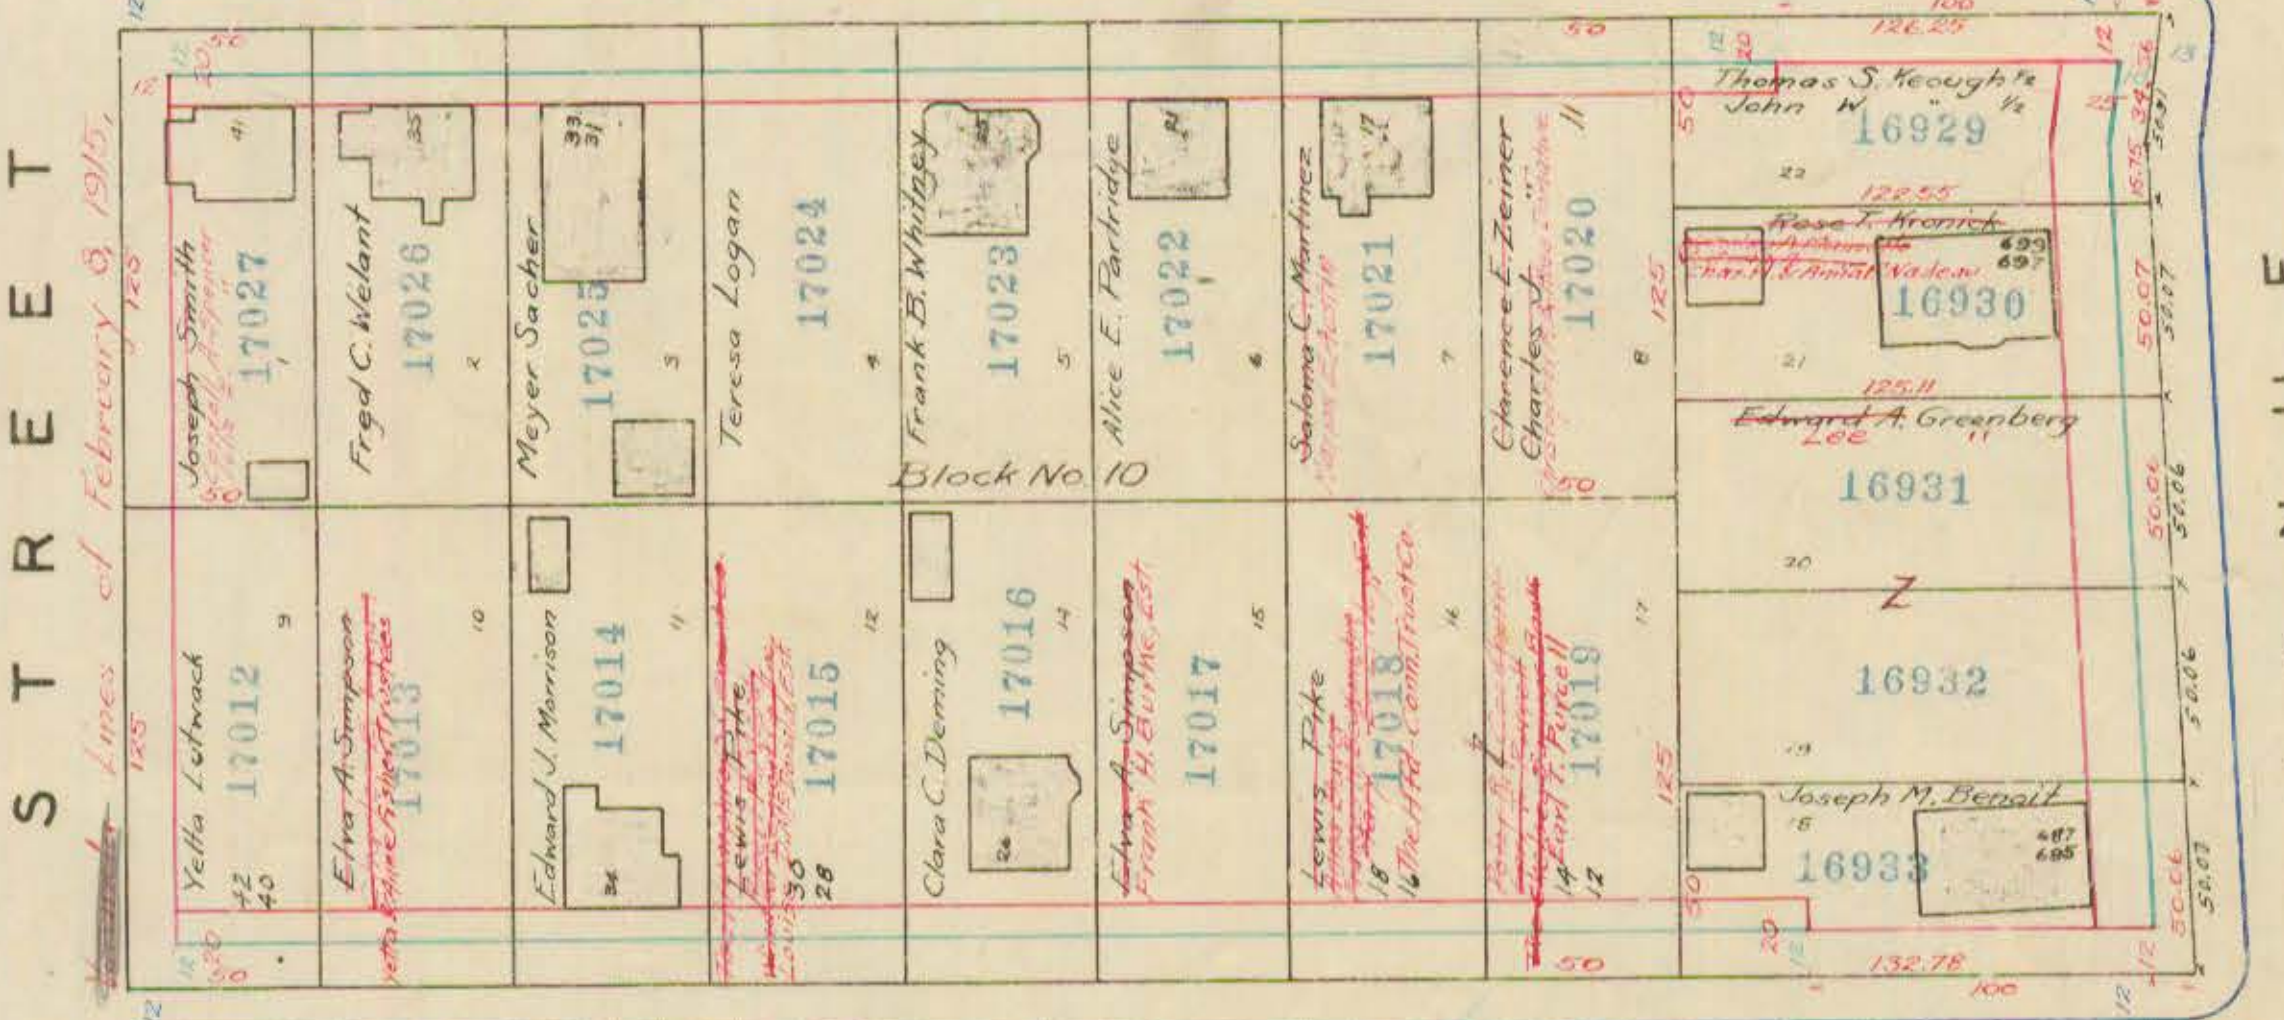

WEST

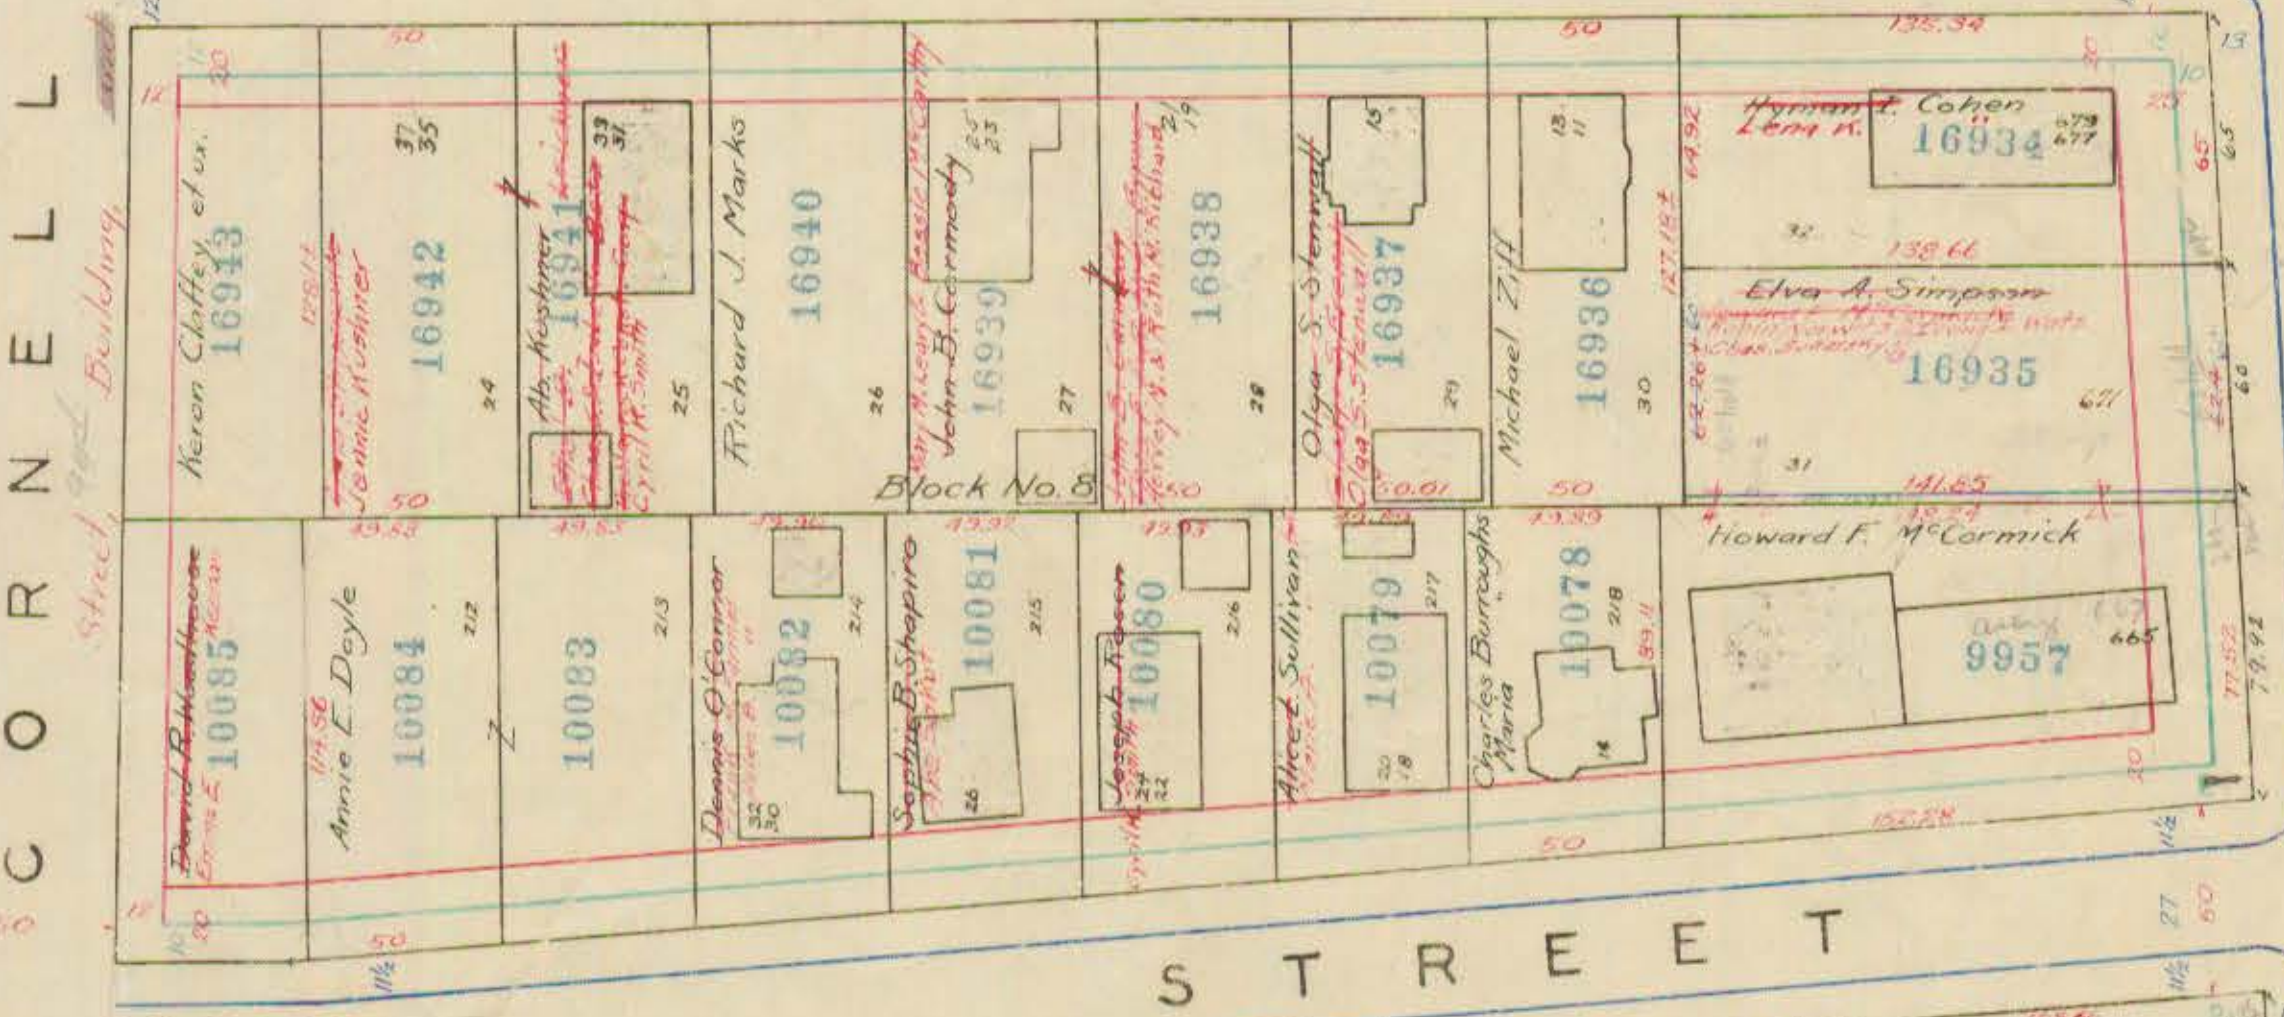


STREET

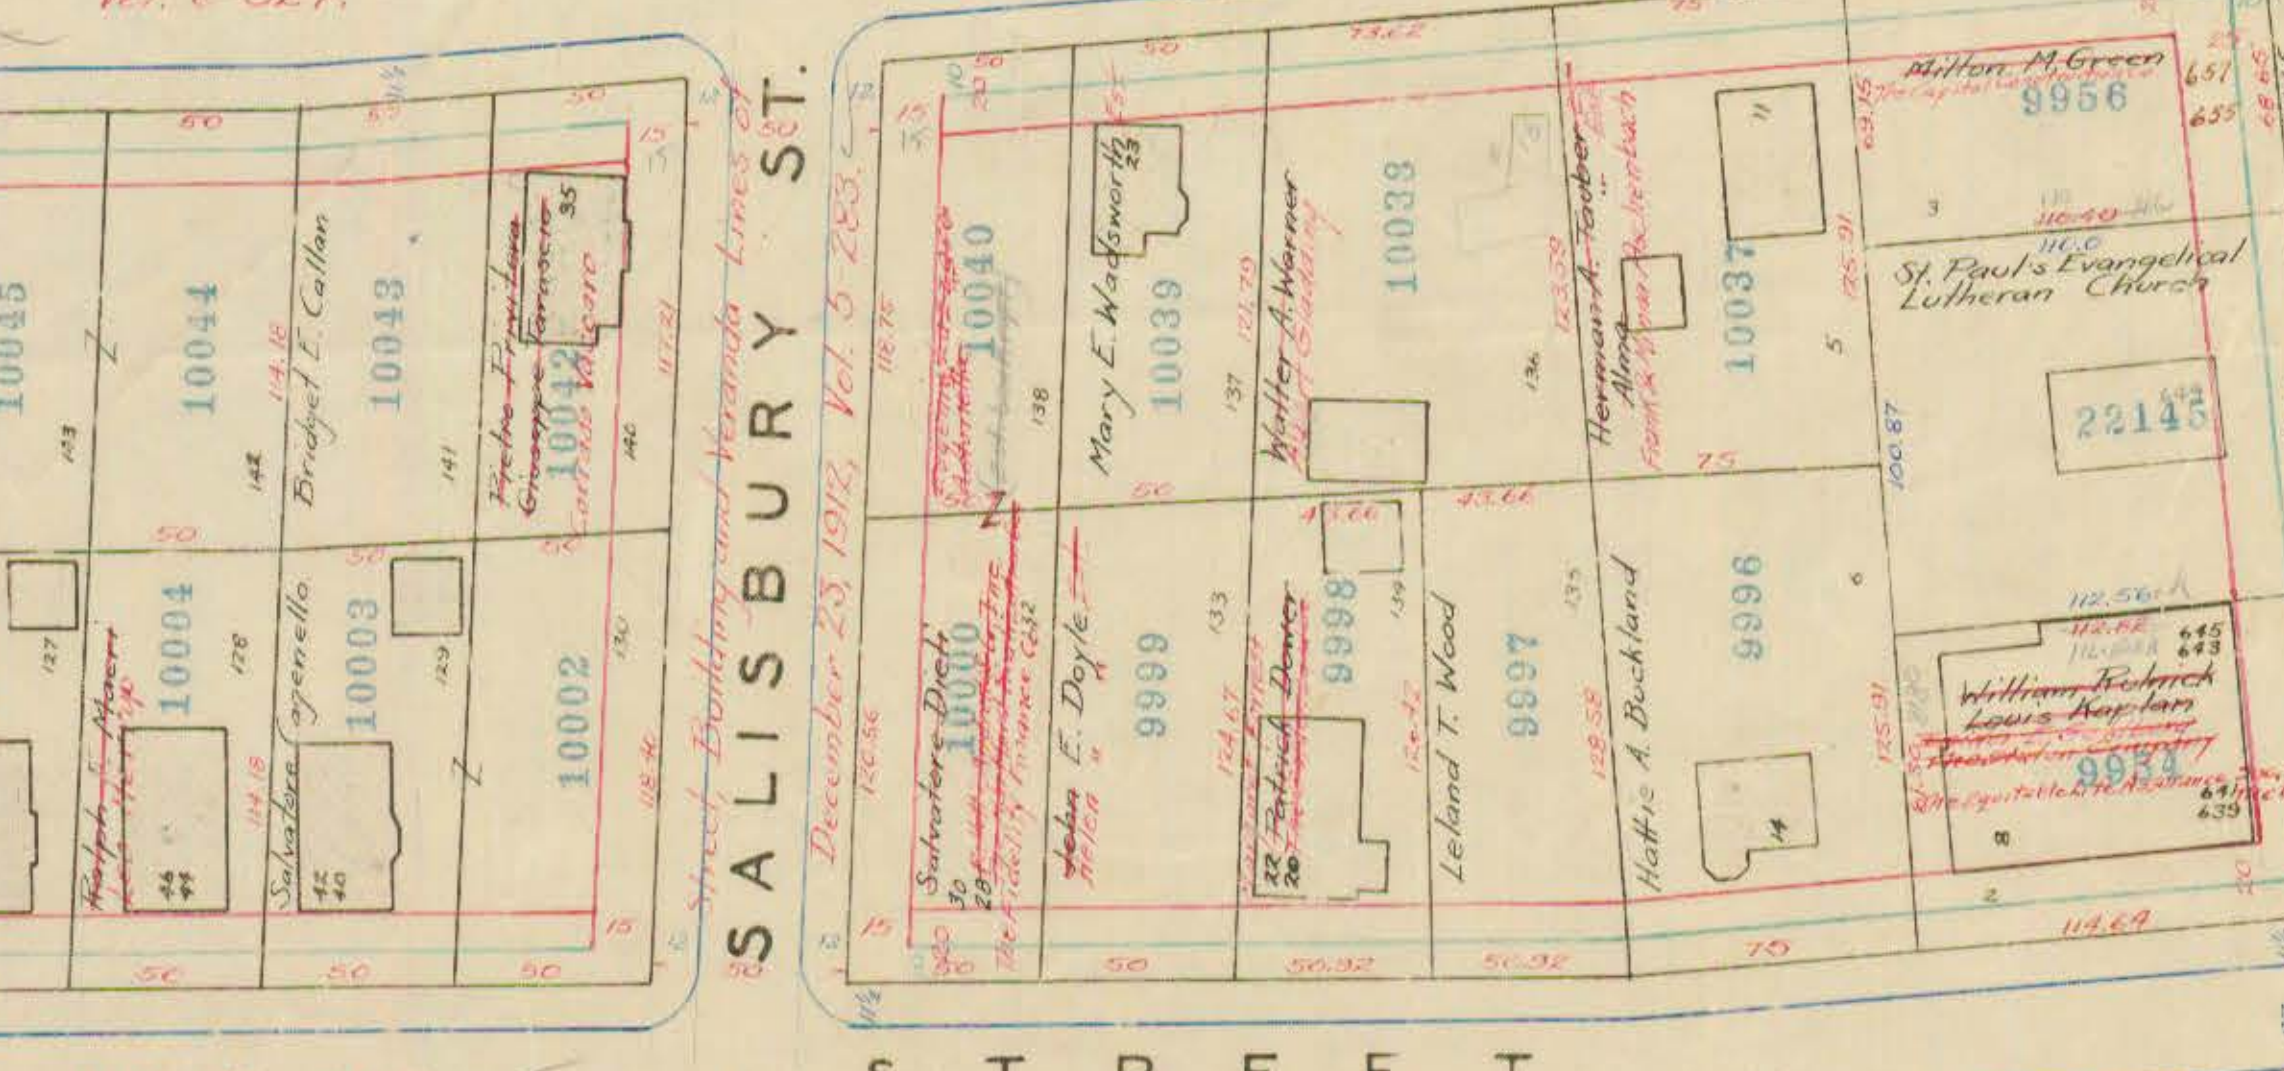

SALISBURY STREET

STREET

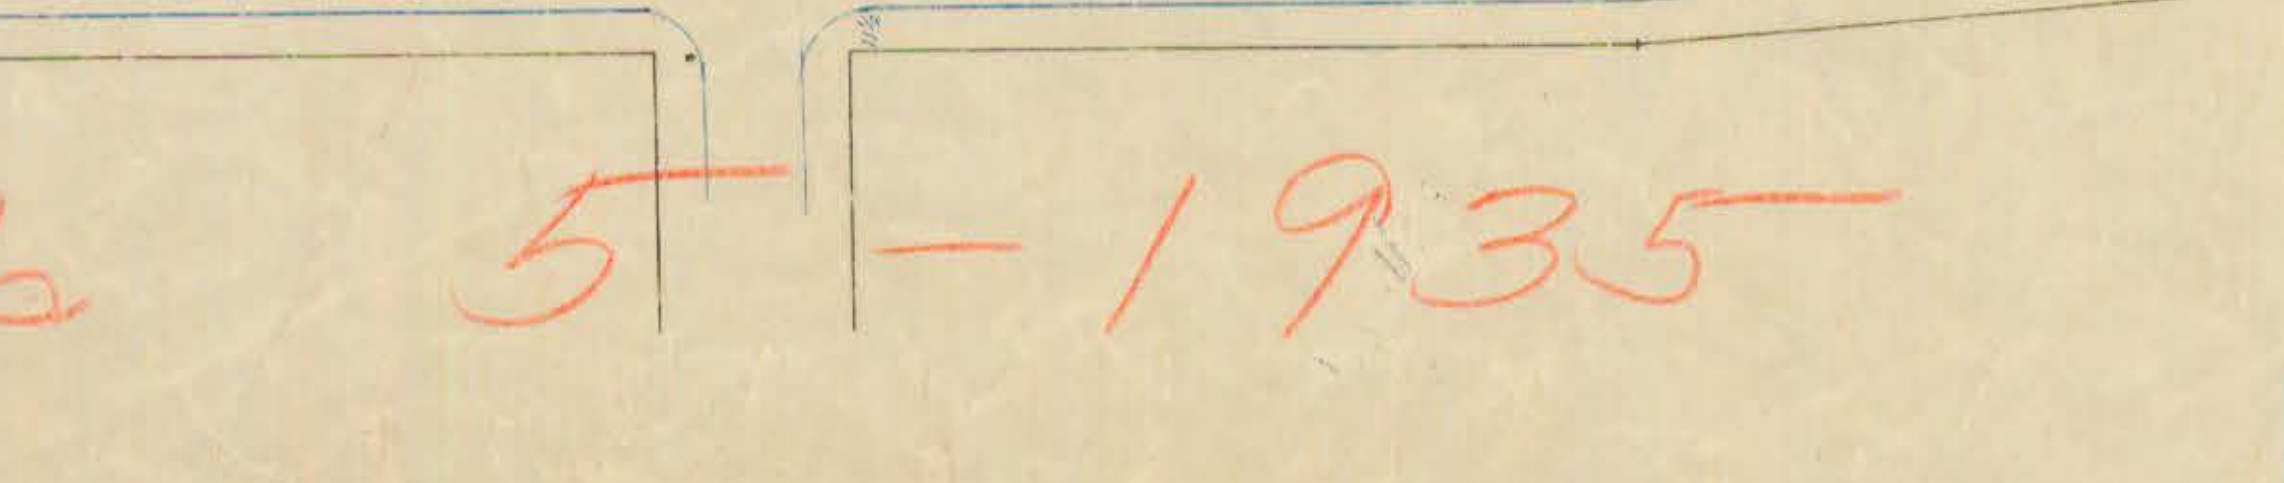

AVENUE

BLOOMFIELD

Out of Service

Feb 5-1935