


OUT of service

Dec 20, 1966

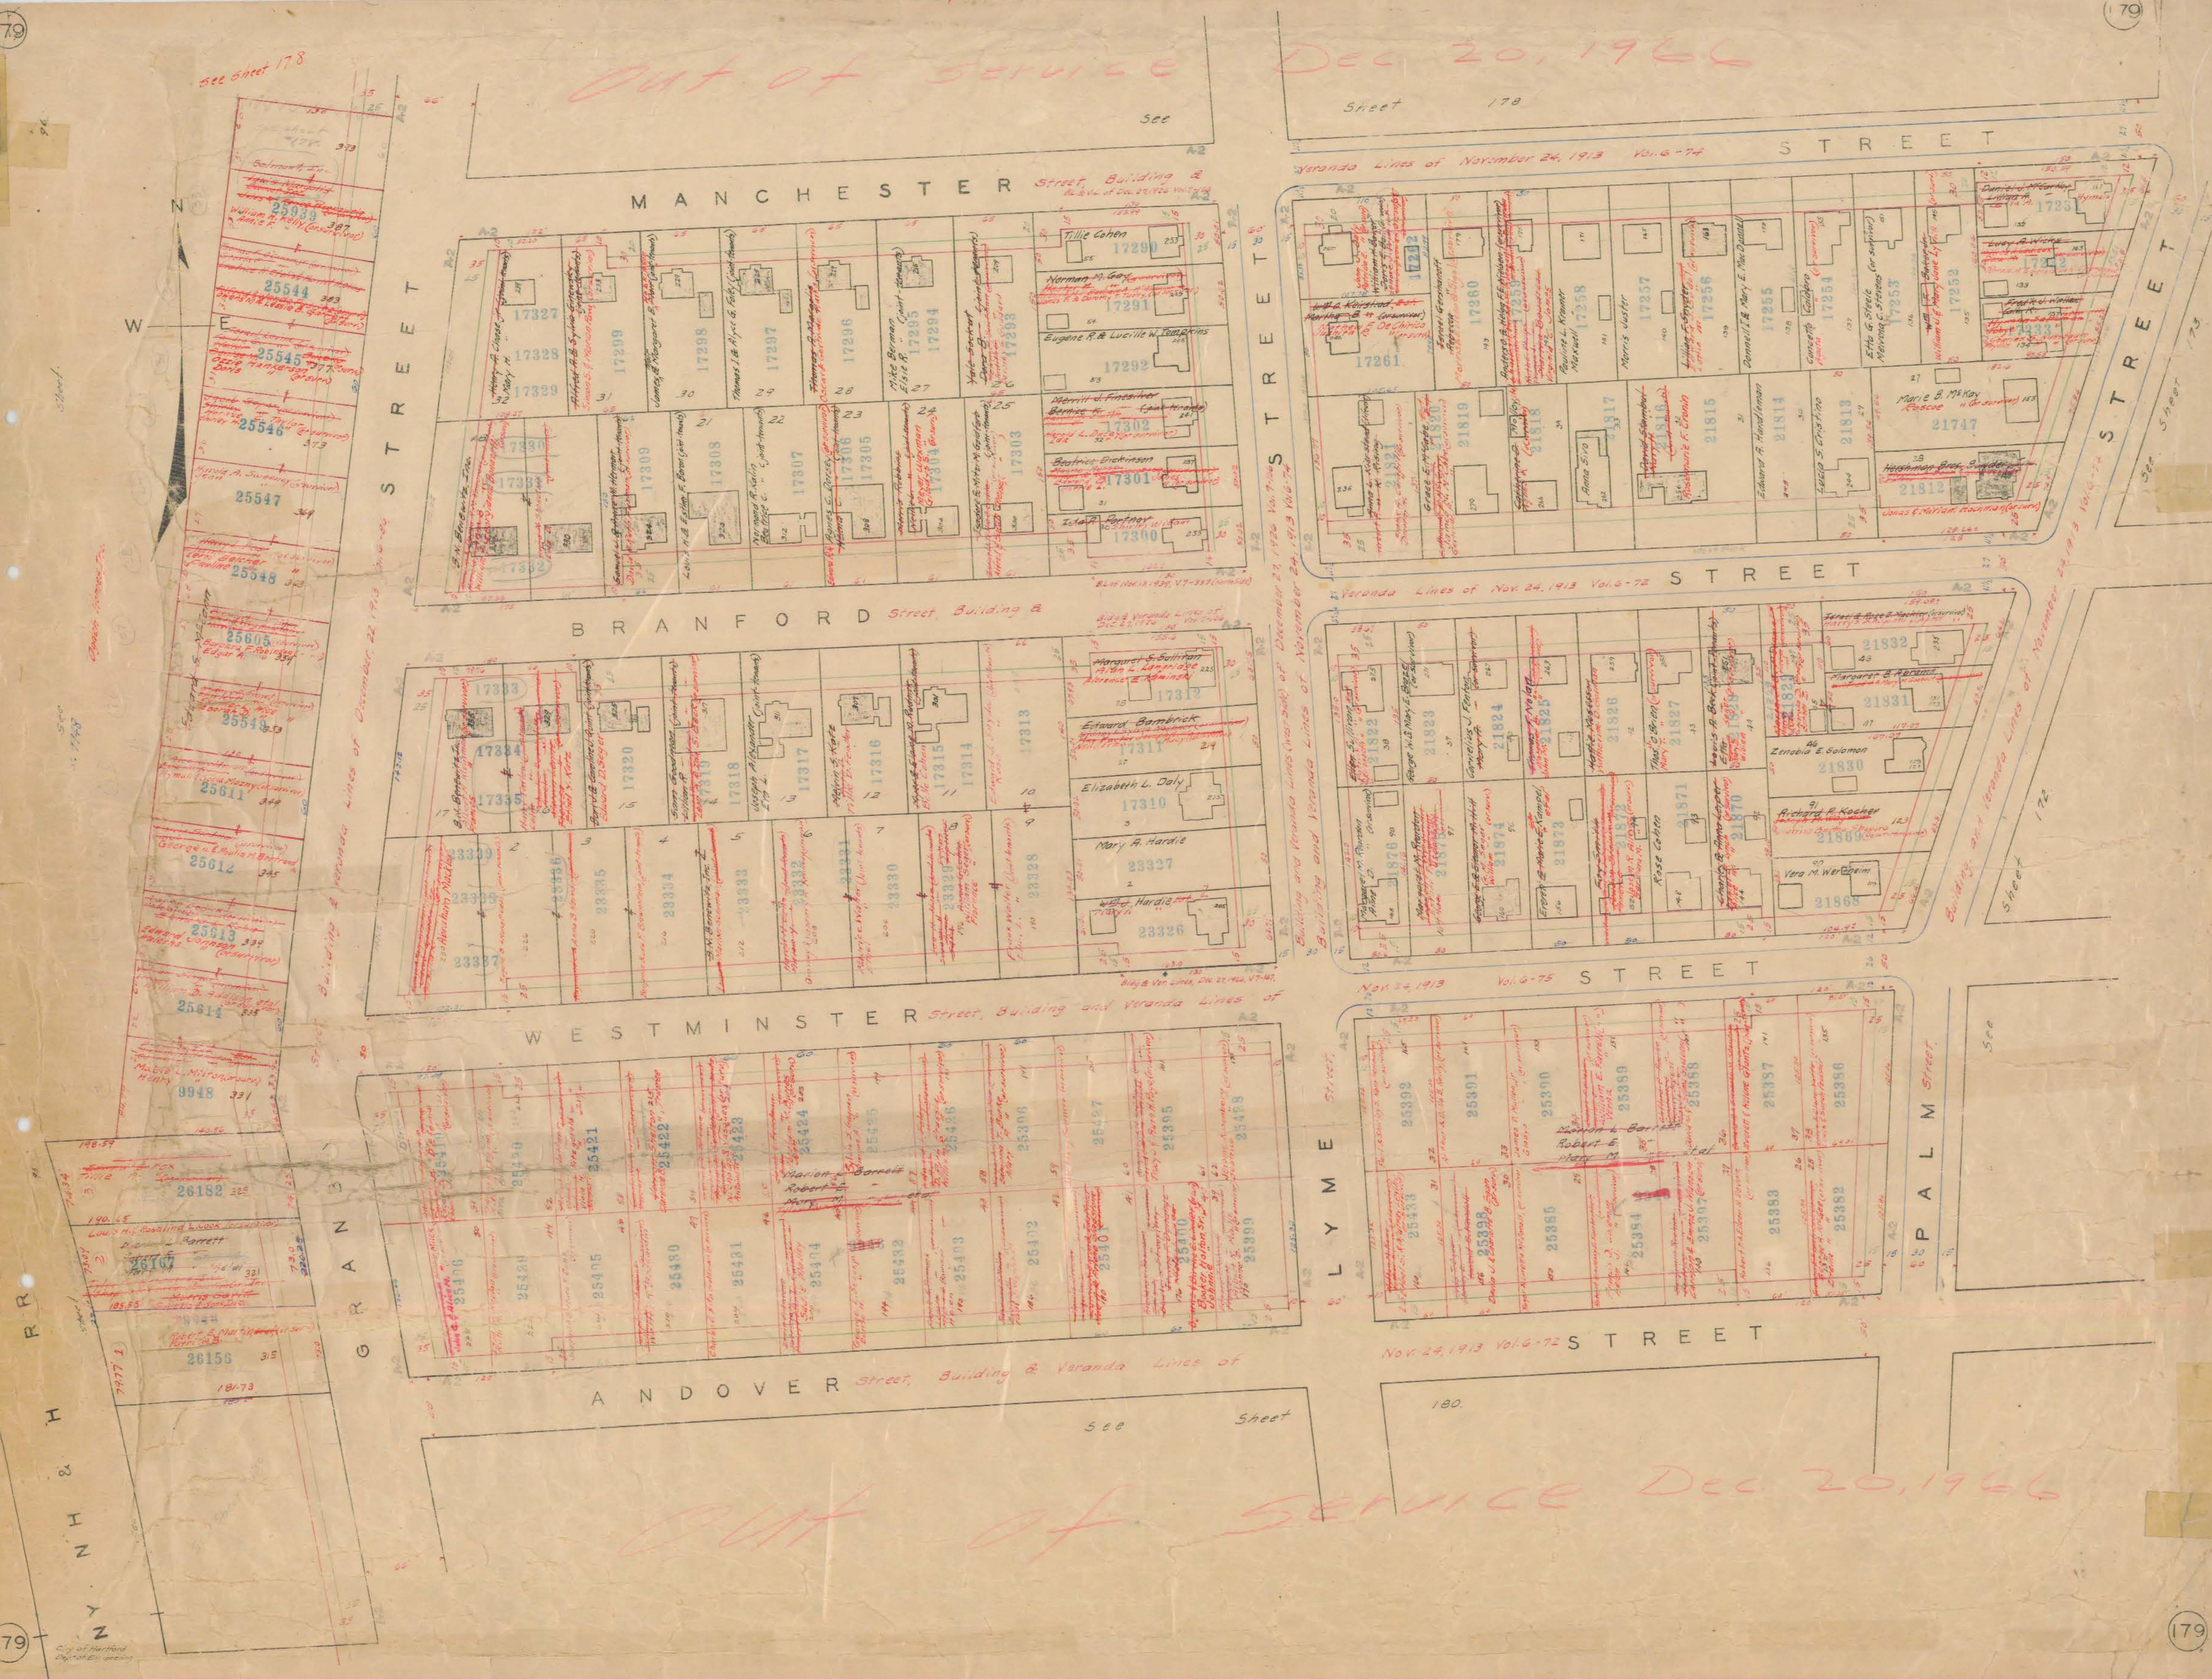

MANCHESTER Street Building & Veranda Lines of November 24, 1913 Vol. 6-74

BRANFORD Street Building & Veranda Lines of November 24, 1913 Vol. 6-72

WESTMINSTER Street Building and Veranda Lines of November 24, 1913 Vol. 6-75

ANDOVER Street Building & Veranda Lines of November 24, 1913 Vol. 6-72


OUT of service

Sheet

180.