



Out of service June 3 1938

All unmarked lots owned by Hartford Home Co.

All unmarked lots owned by The Greater Hartford Development Co.
General Investment Co.



MANCHESTER Street, Building and Veranda Lines
(Buildings) of Dec. 27, 1926, Vol. 7-166

Building and Veranda Lines of Nov. 24, 1913, Vol. 6-74

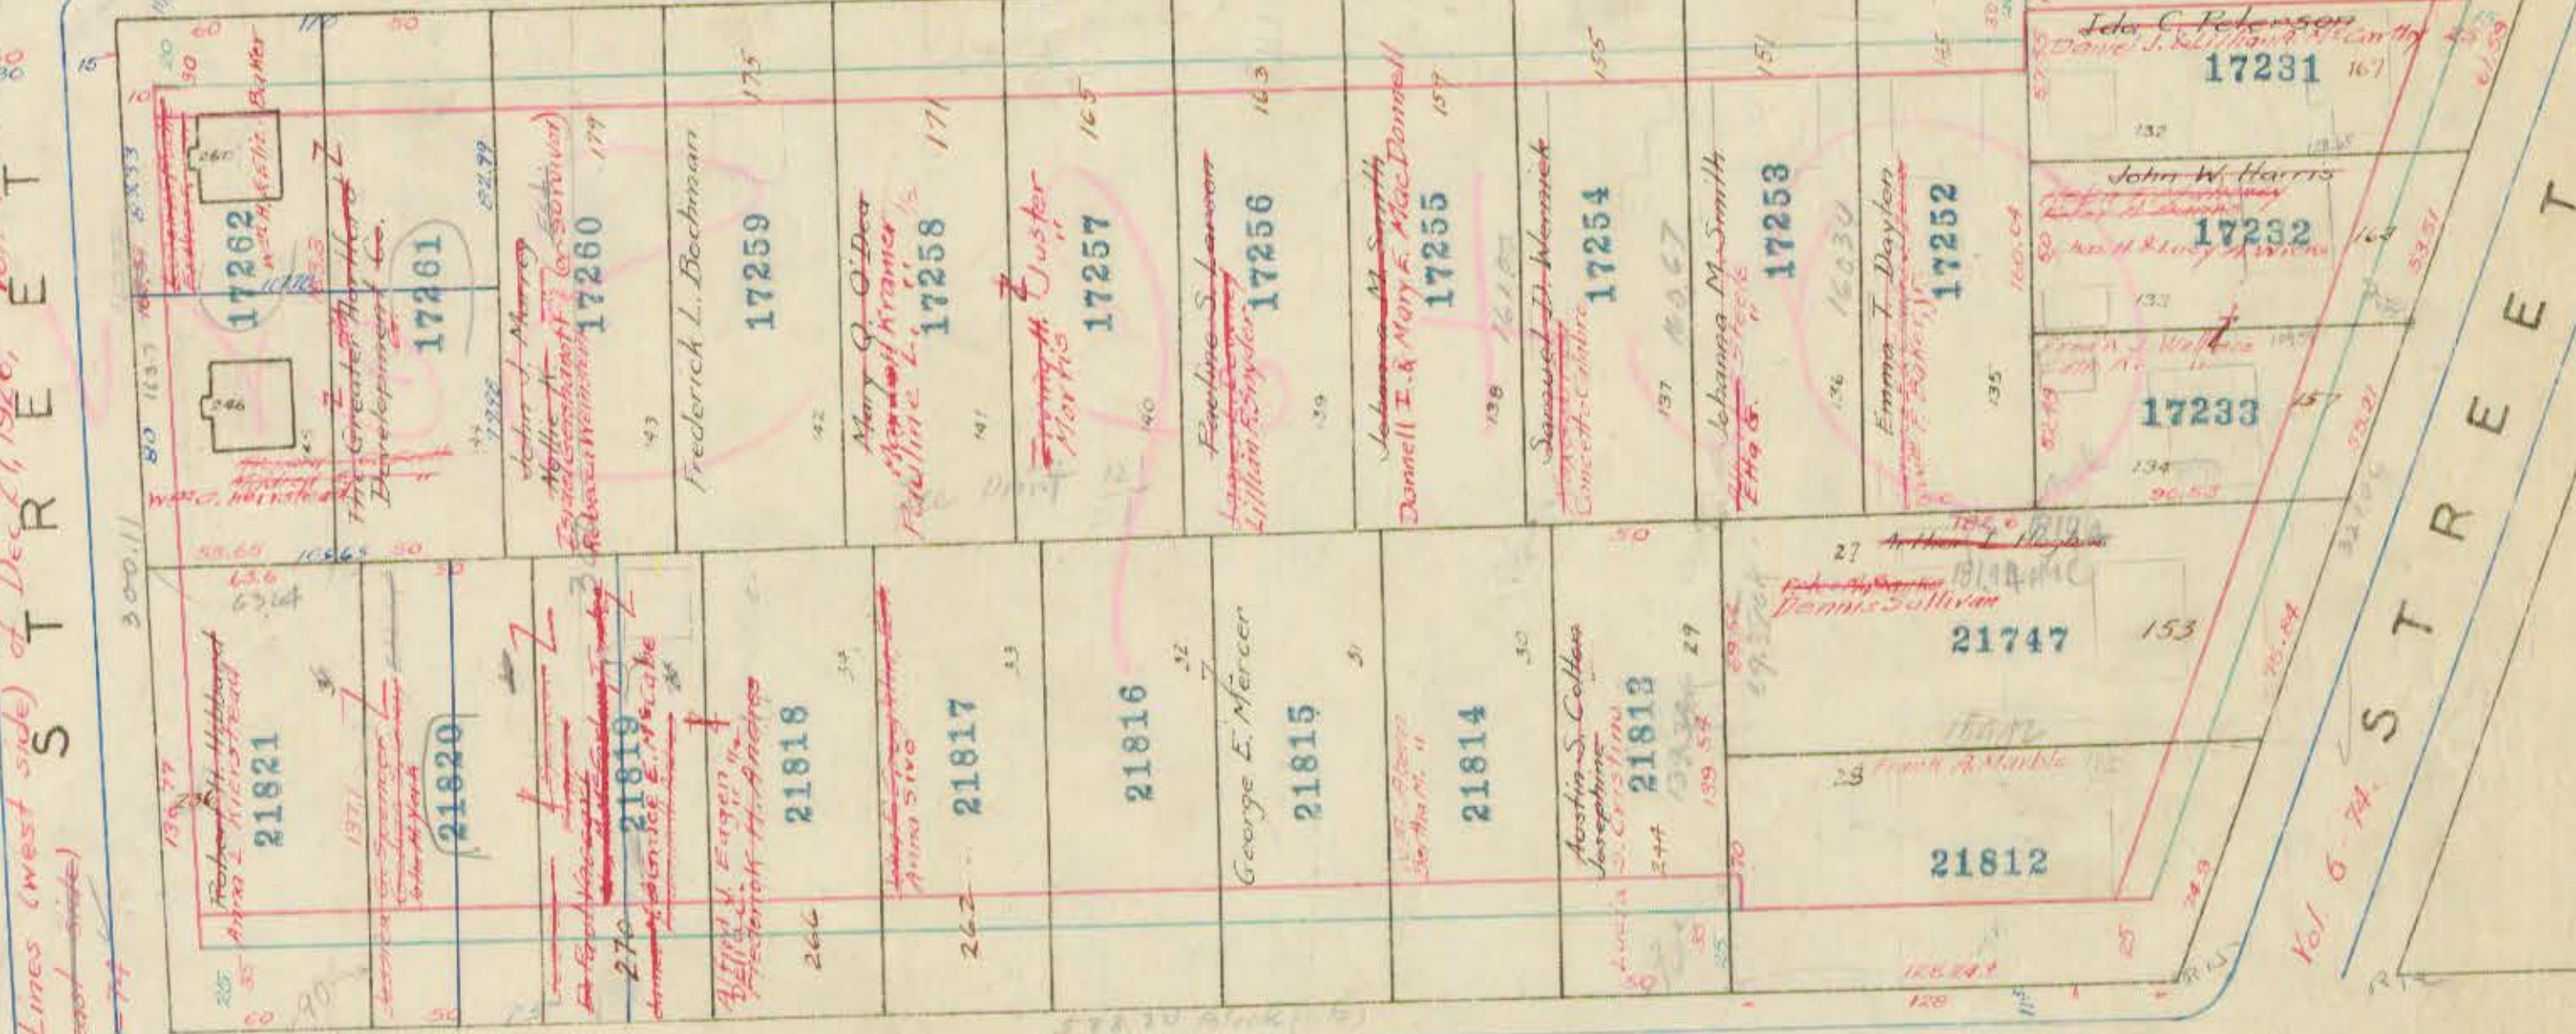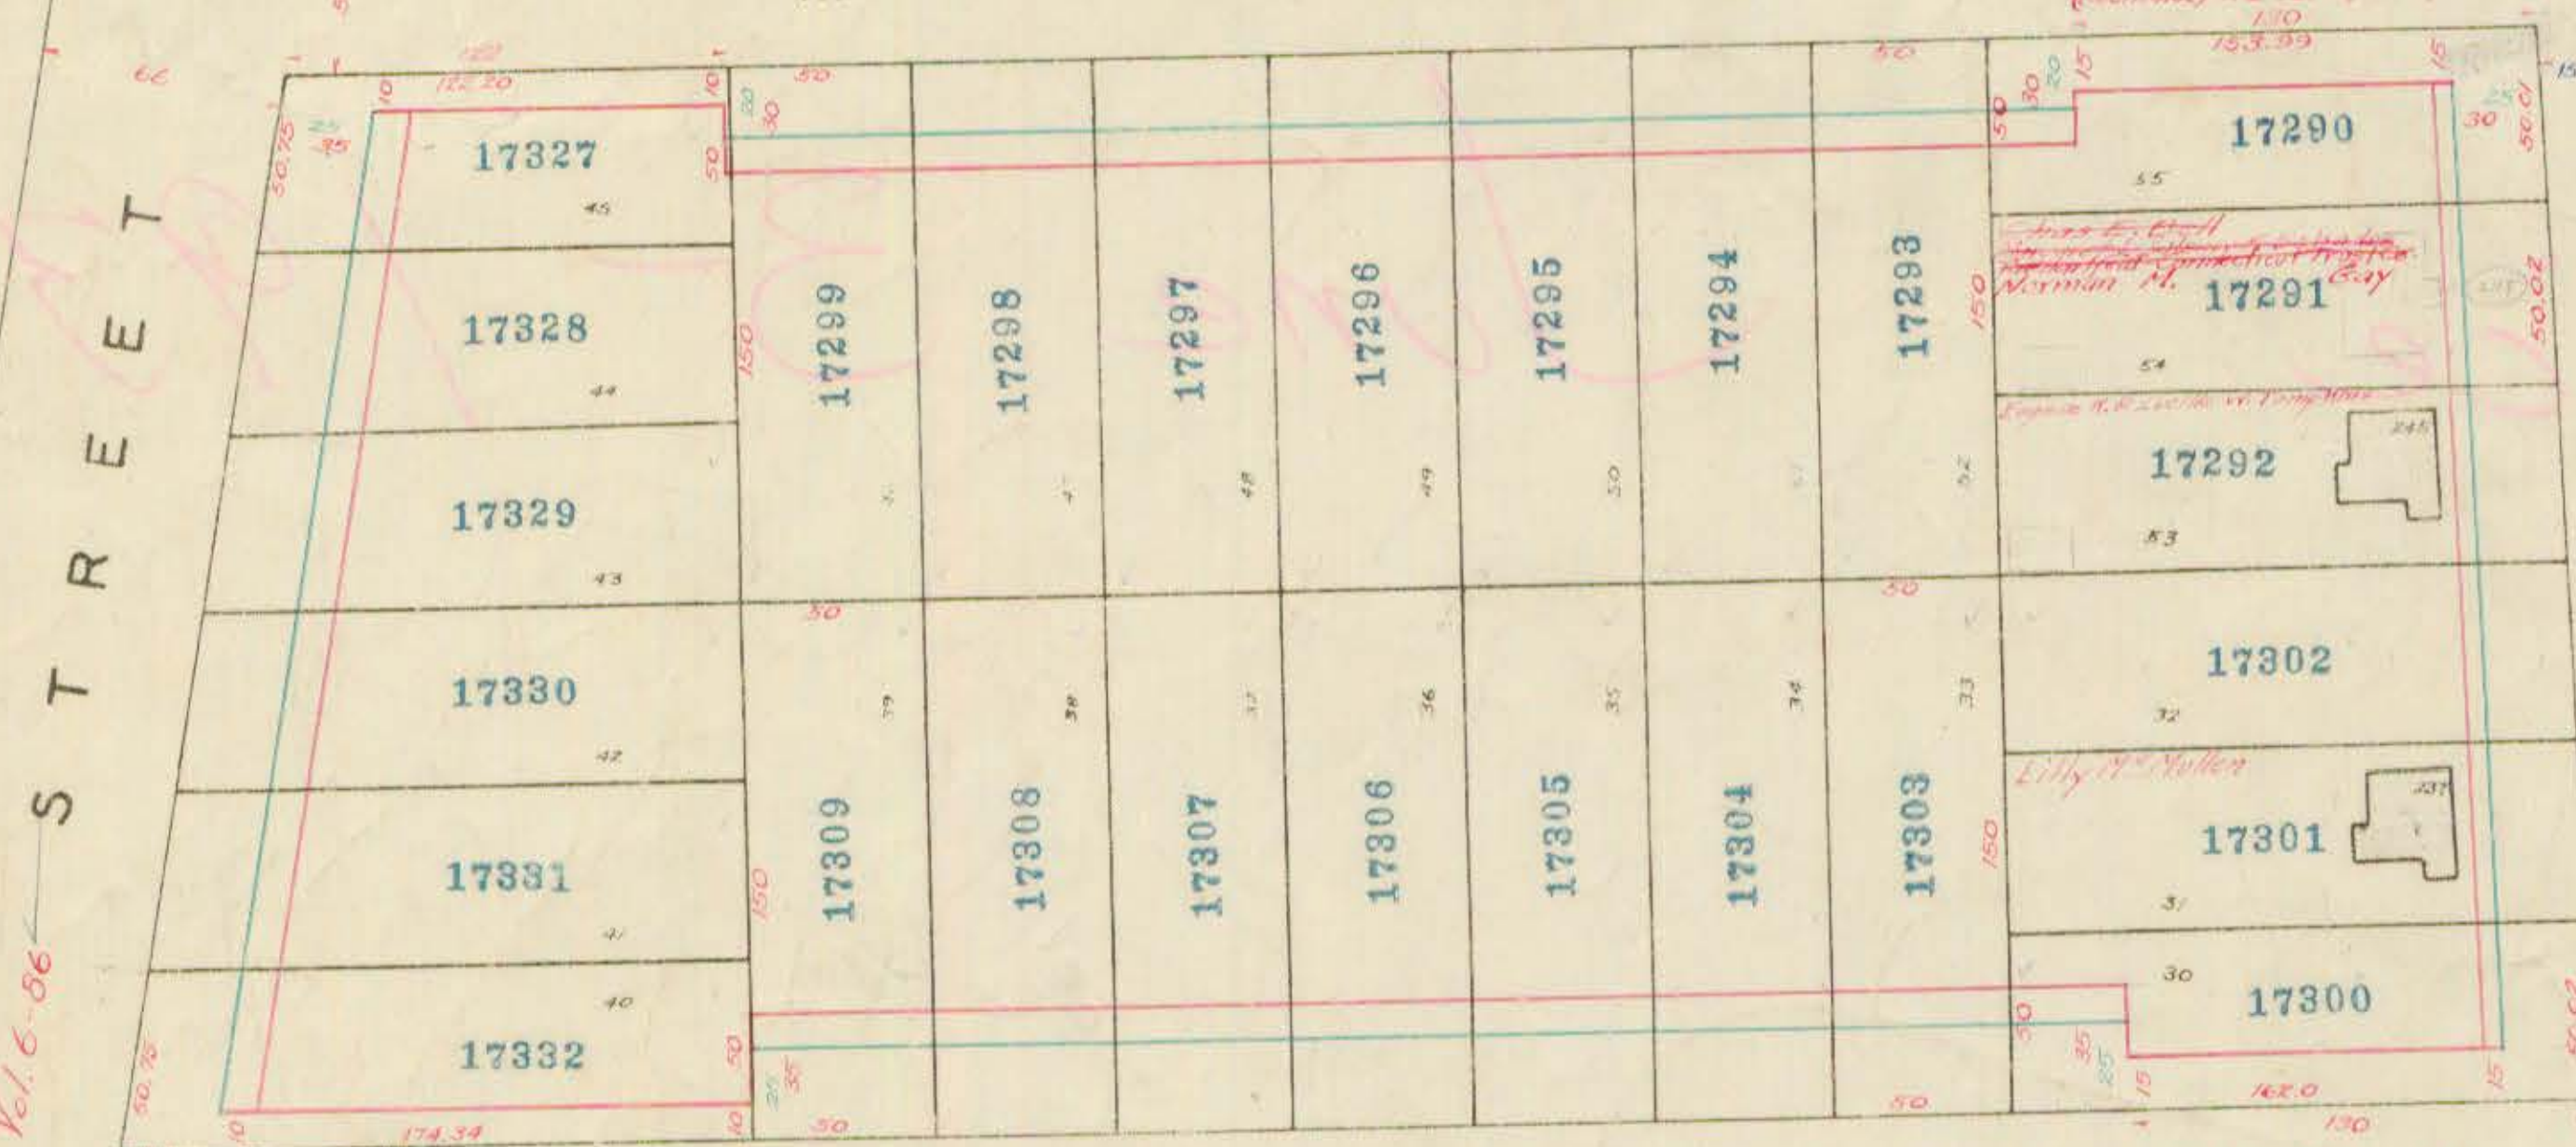



BRANFORD Street, Building and Veranda Lines
(Buildings) of Dec. 27, 1926, Vol. 7-166

Veranda Lines of Nov. 24, 1913, Vol. 6-72

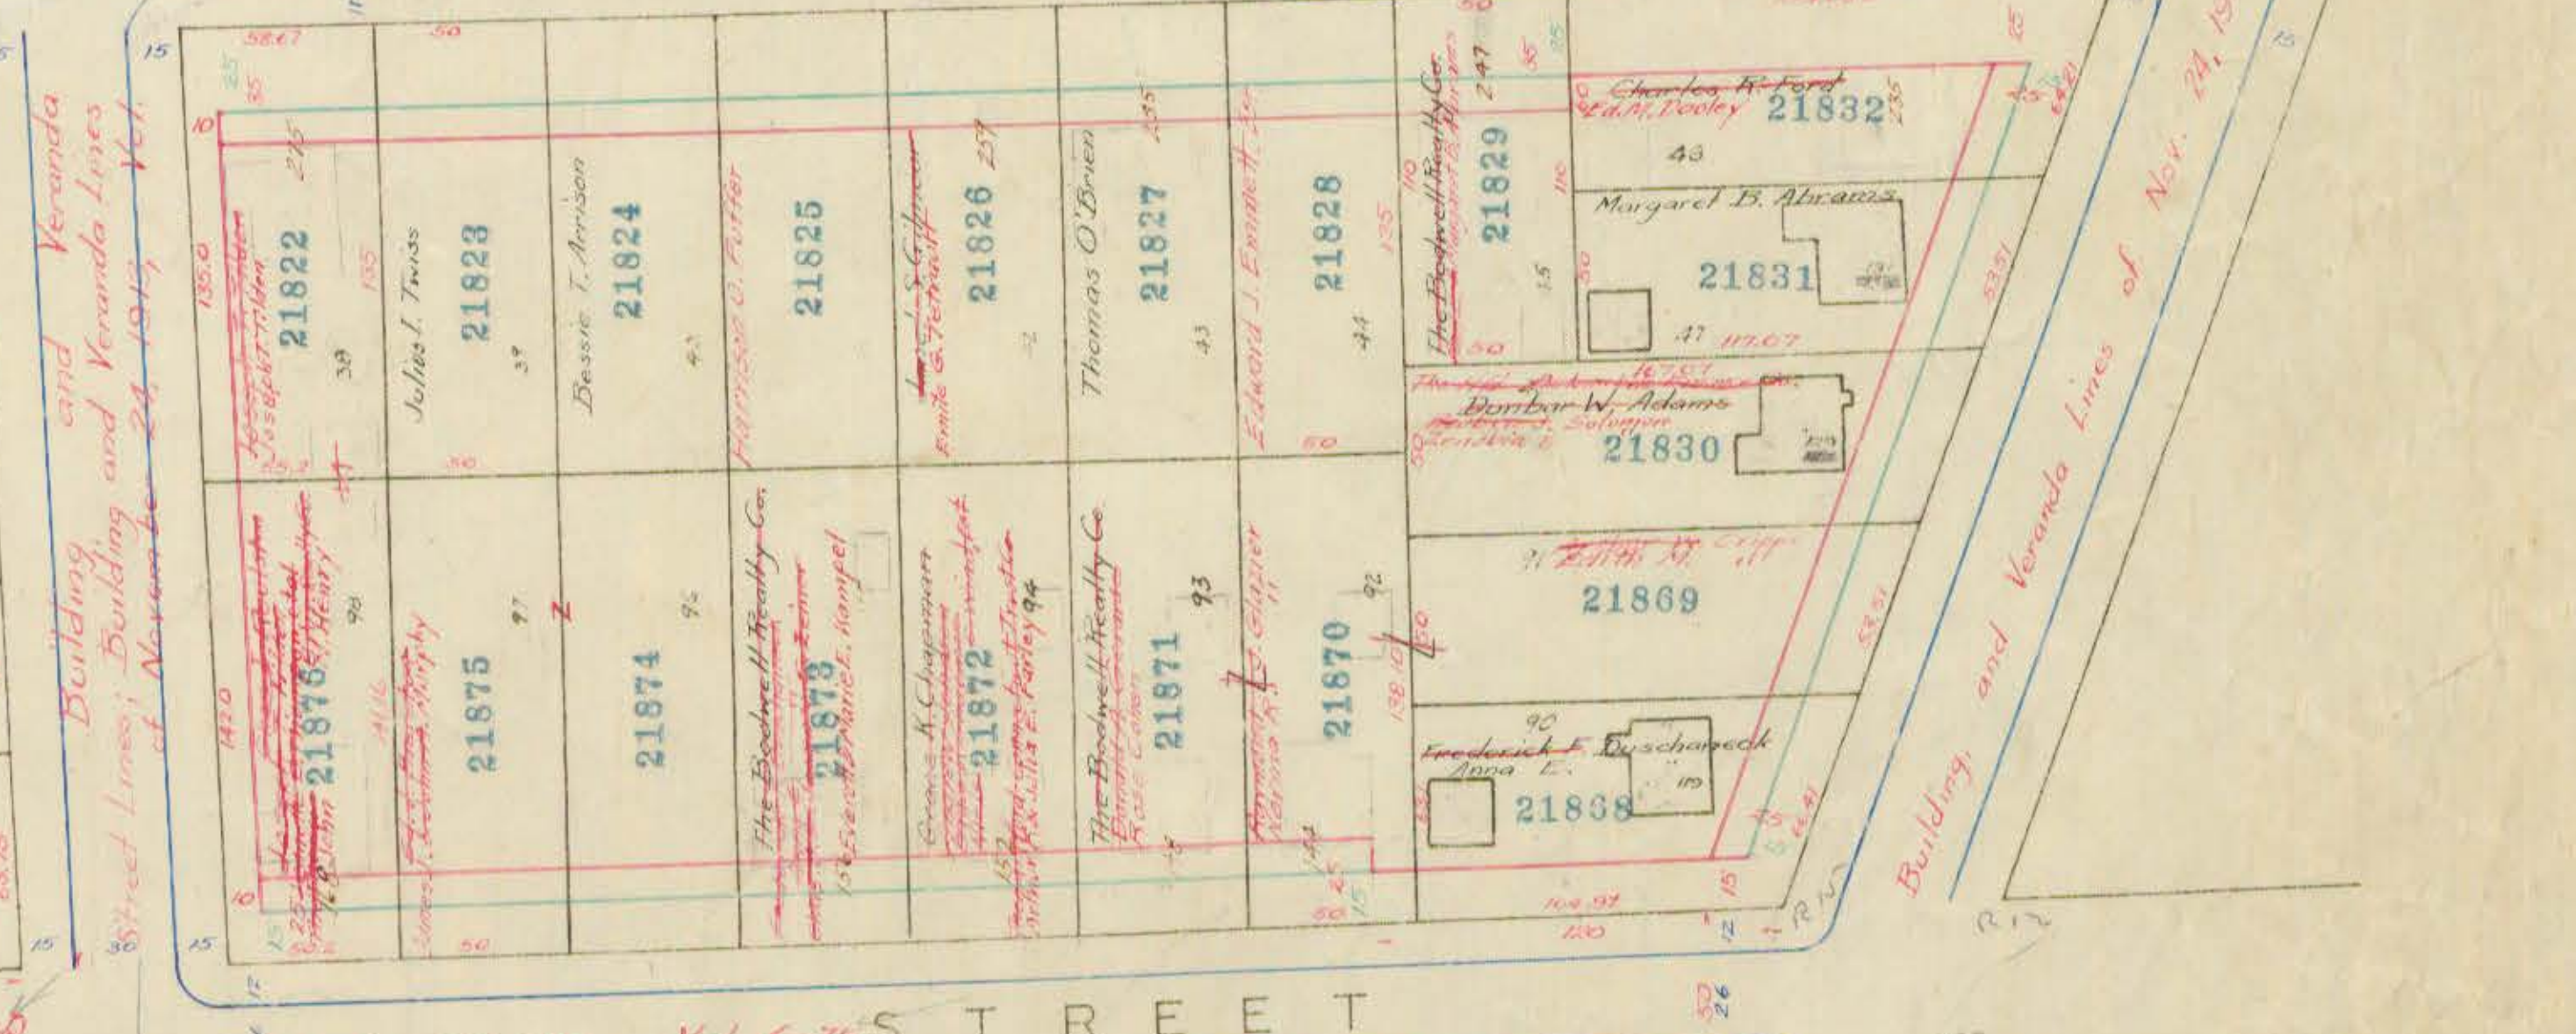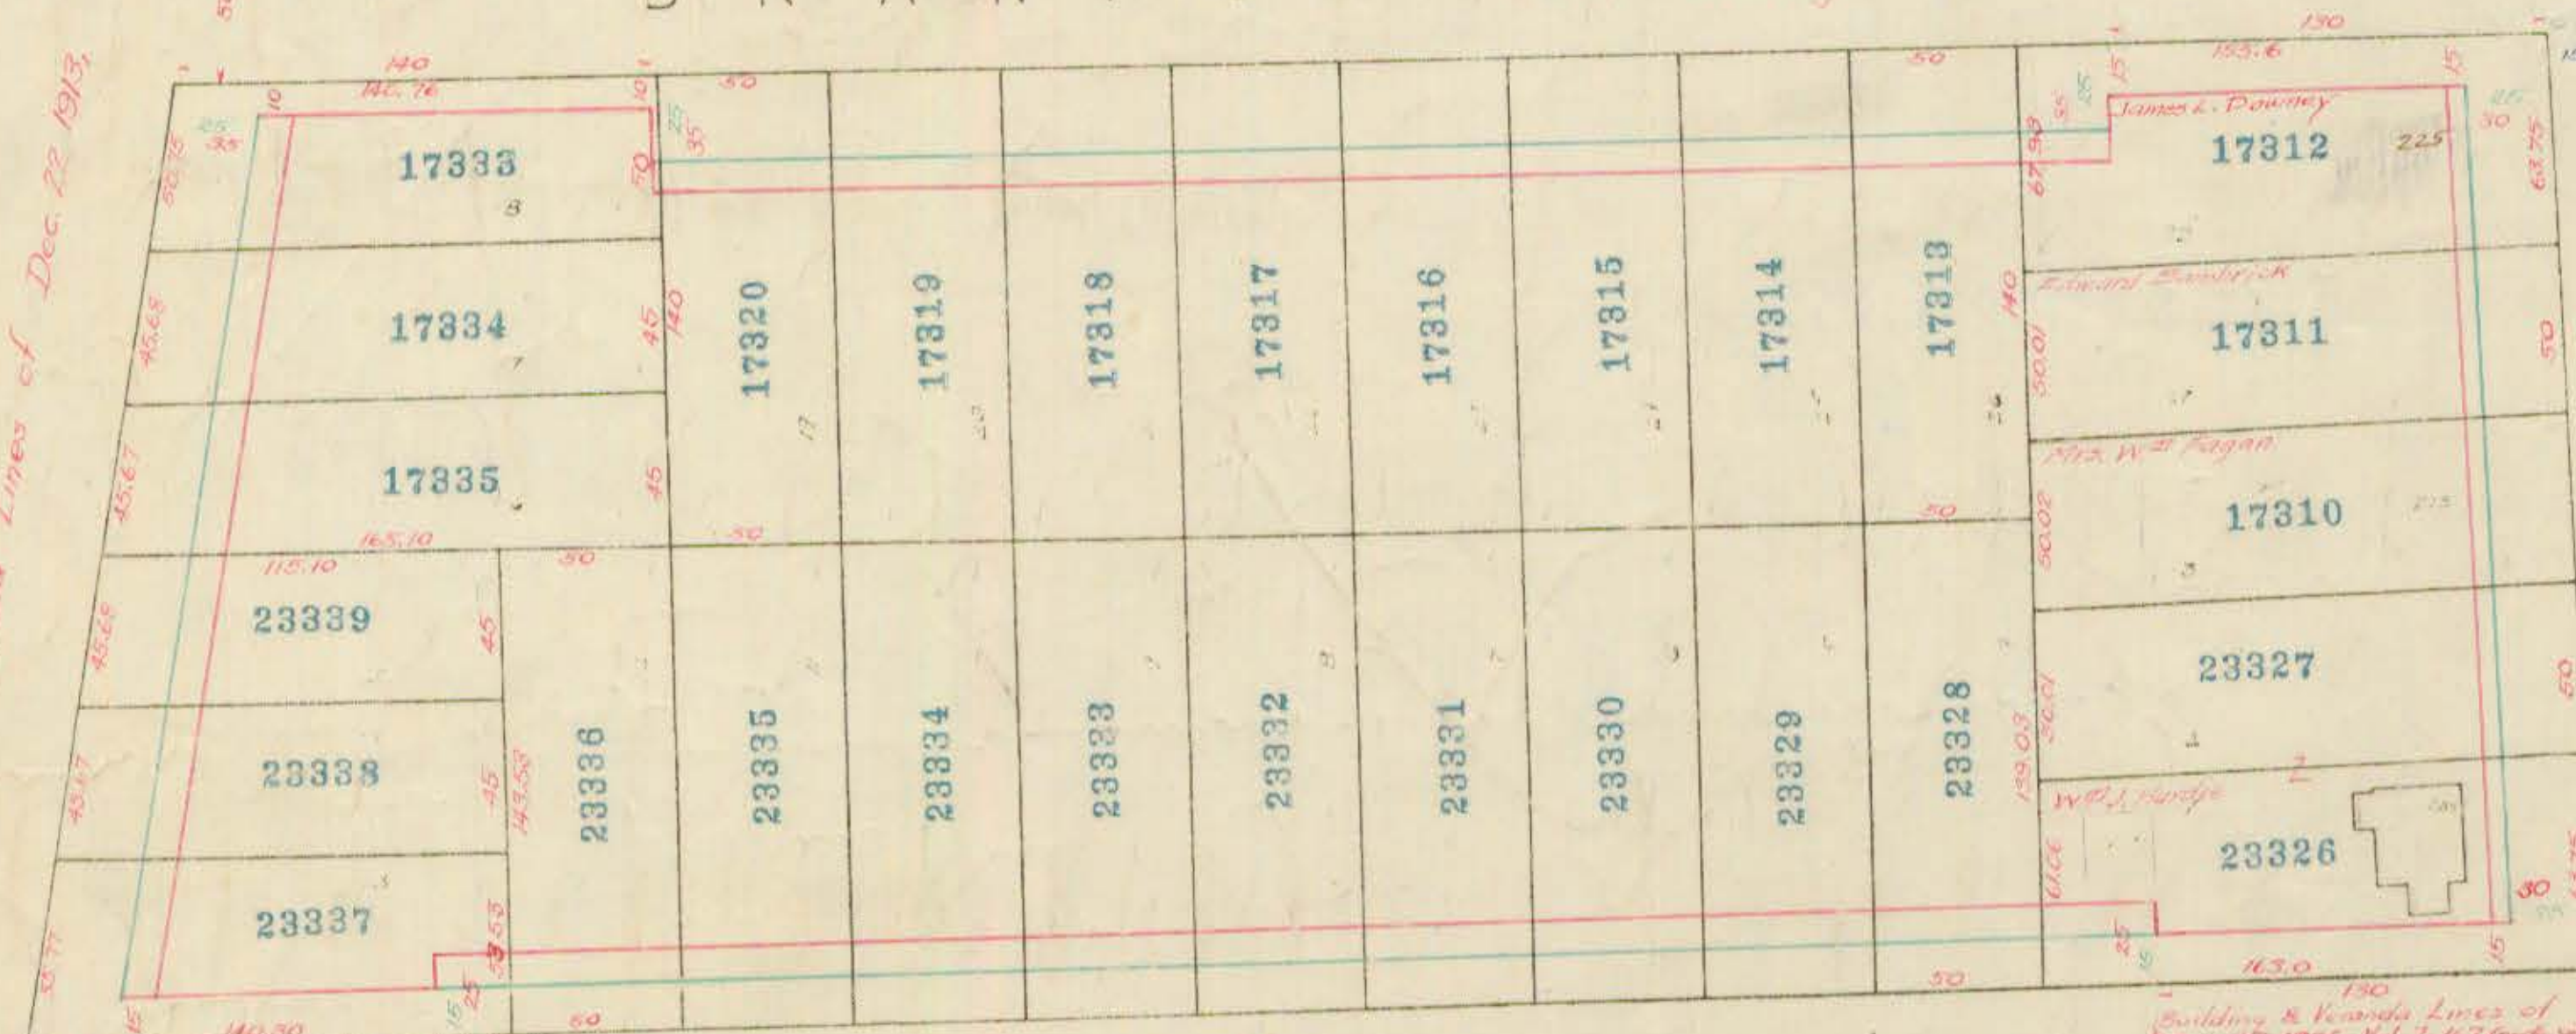



WESTMINSTER Street, Building and Veranda Lines
(Buildings) of Dec. 27, 1926, Vol. 7-166

November 24, 1913, Vol. 6-75

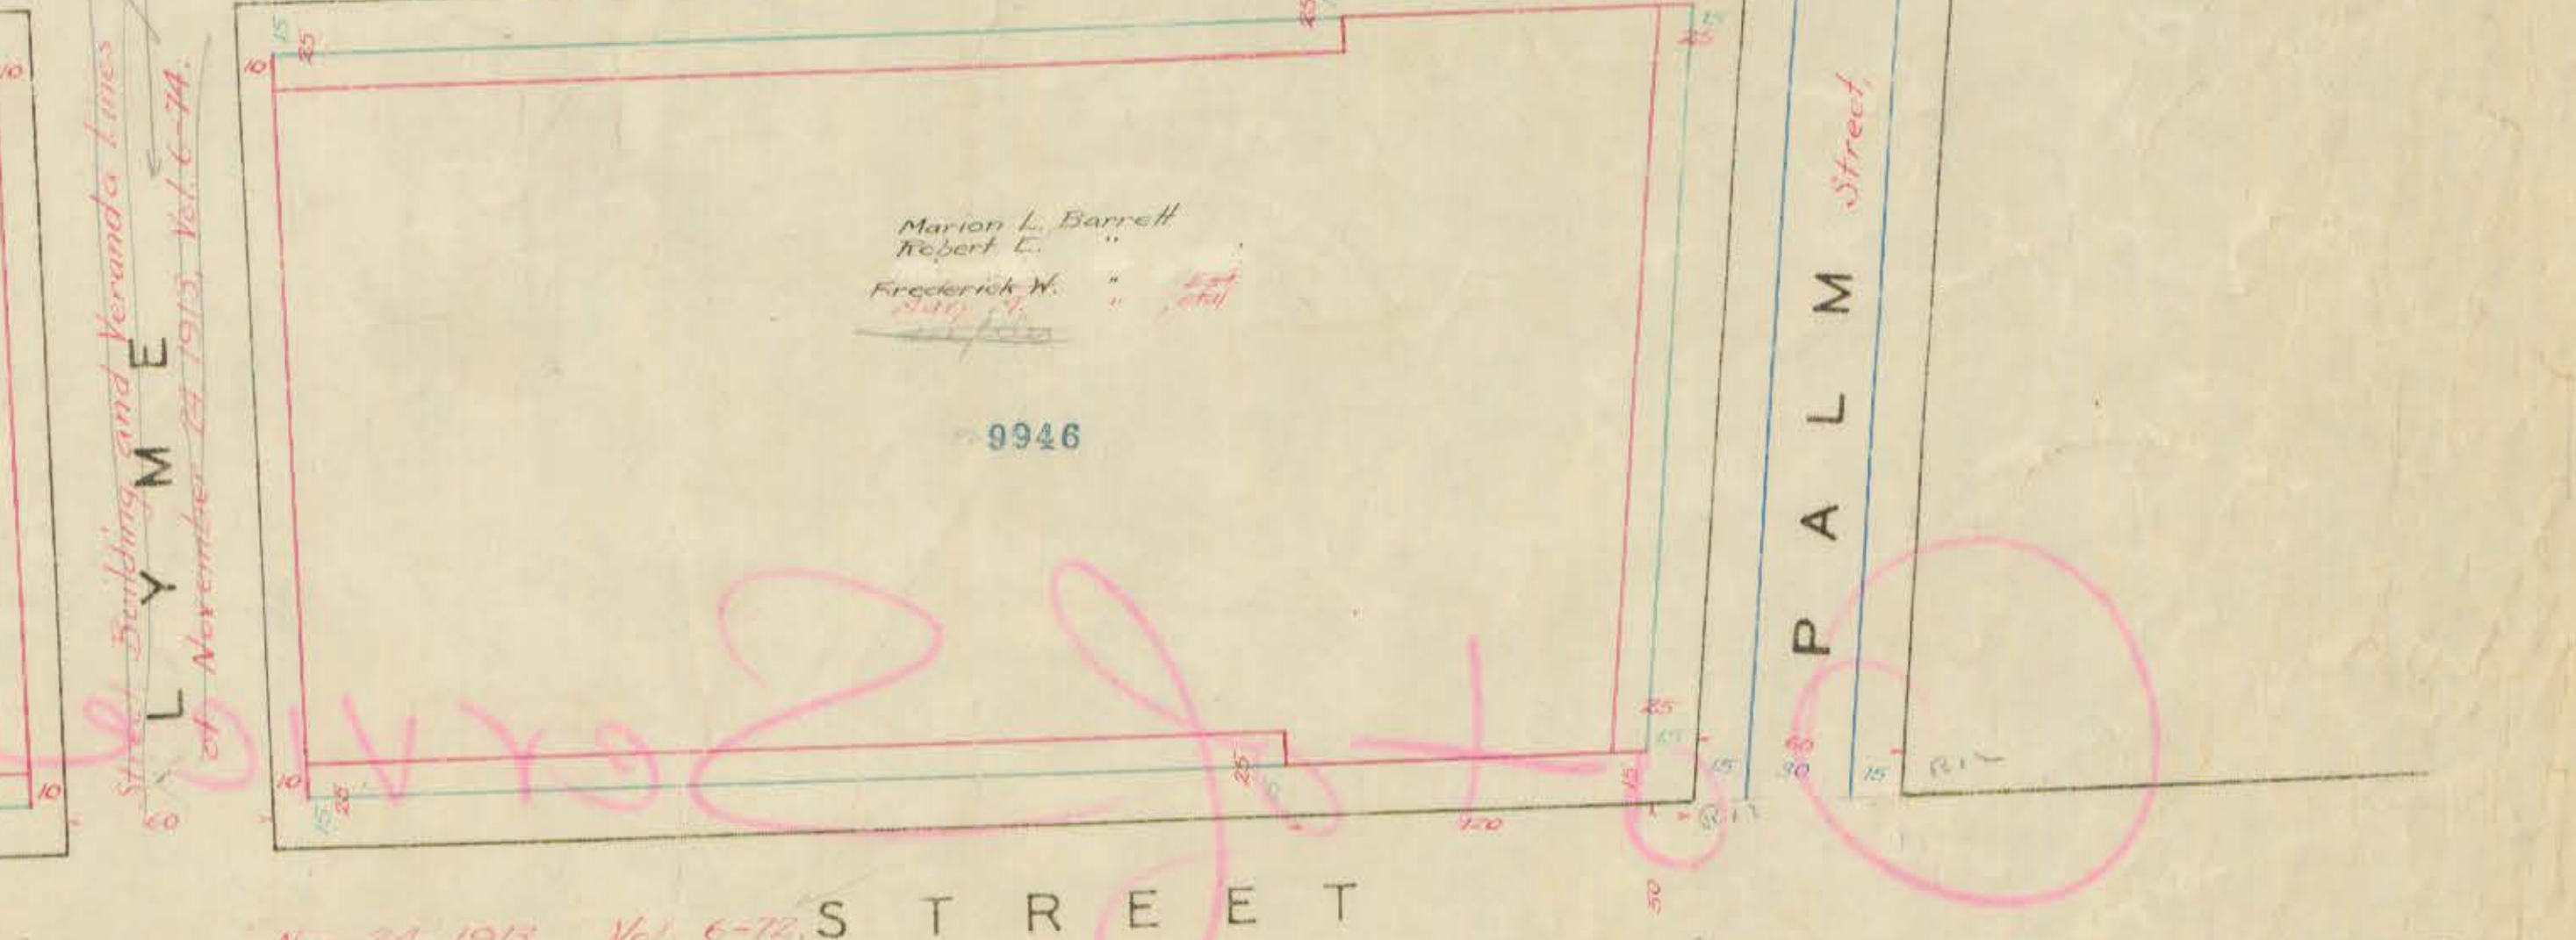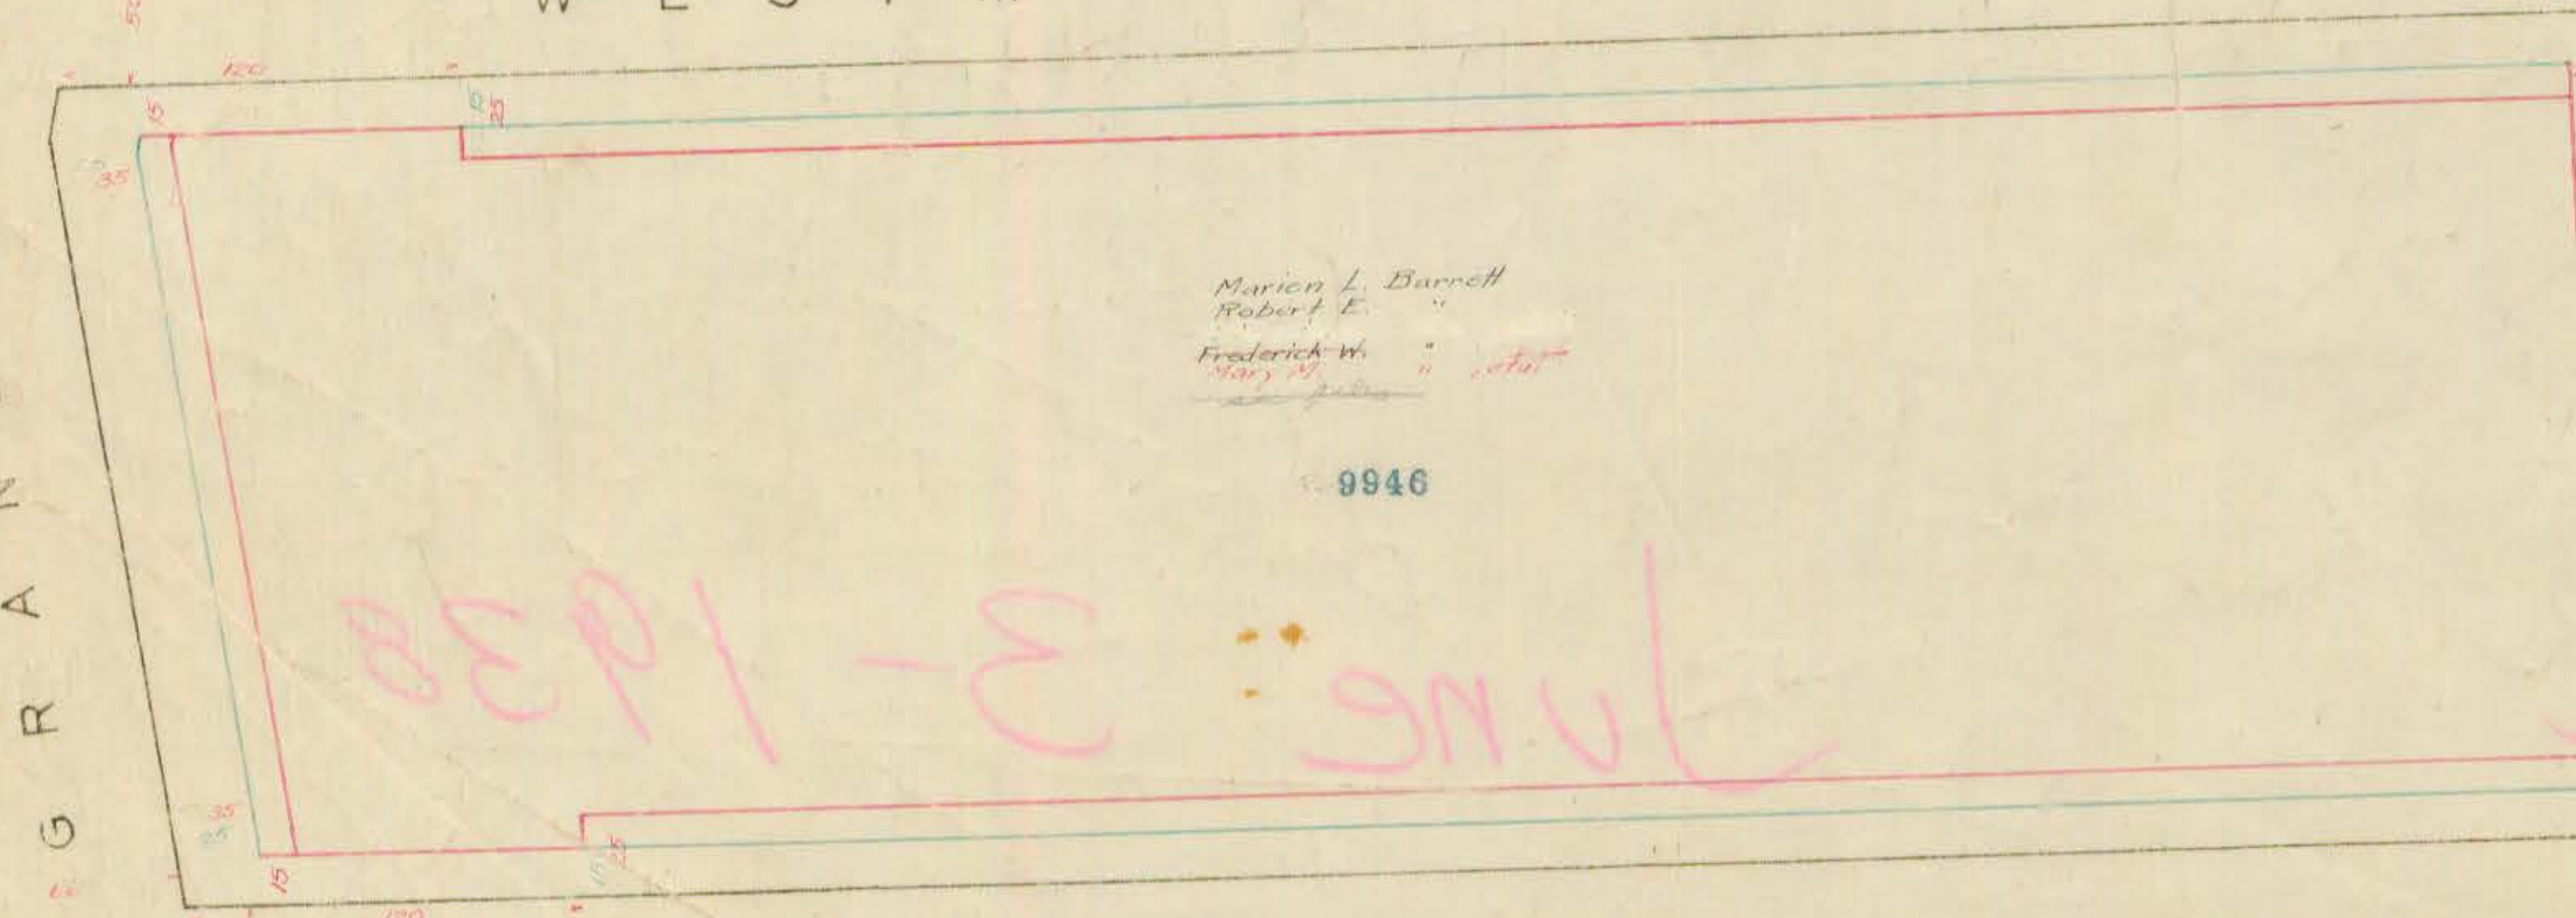

ANDOVER Street, Building and Veranda Lines
(Buildings) of Dec. 27, 1926, Vol. 7-166

Nov. 24, 1913, Vol. 6-72

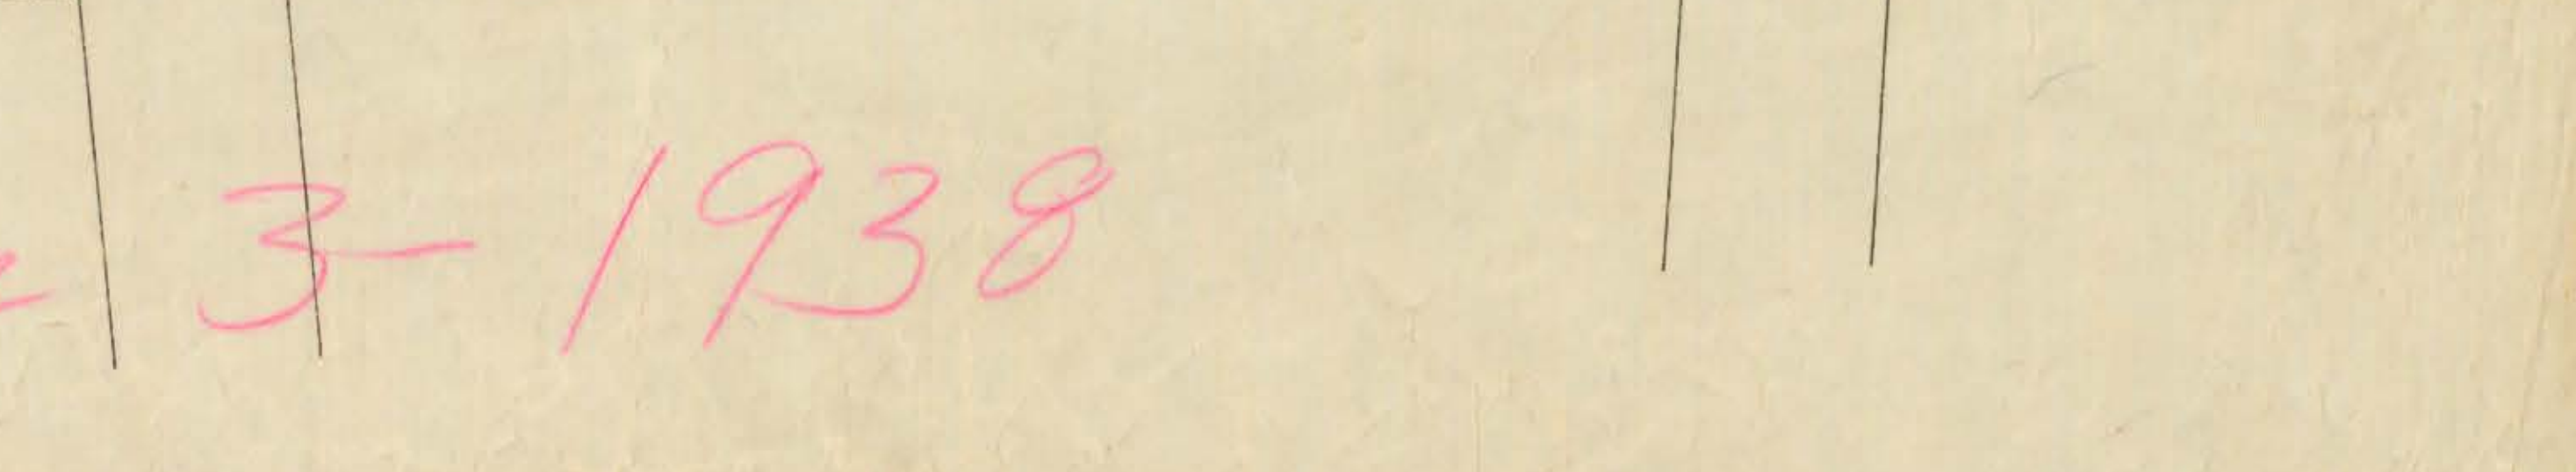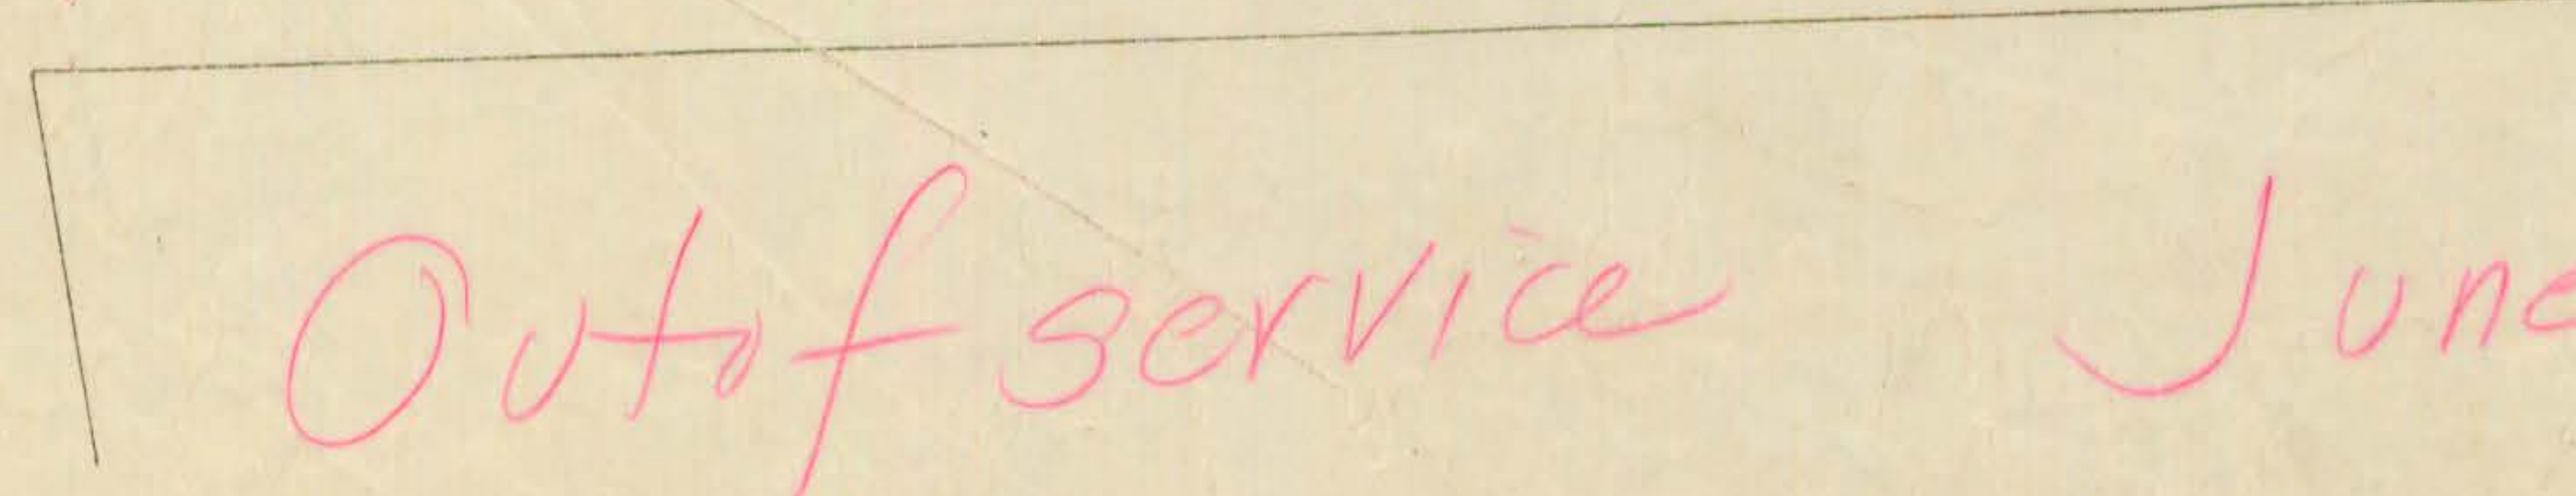

Out of service June 3 1938

Out of service, June 3-1938

Supersedes parts of 93 and 94