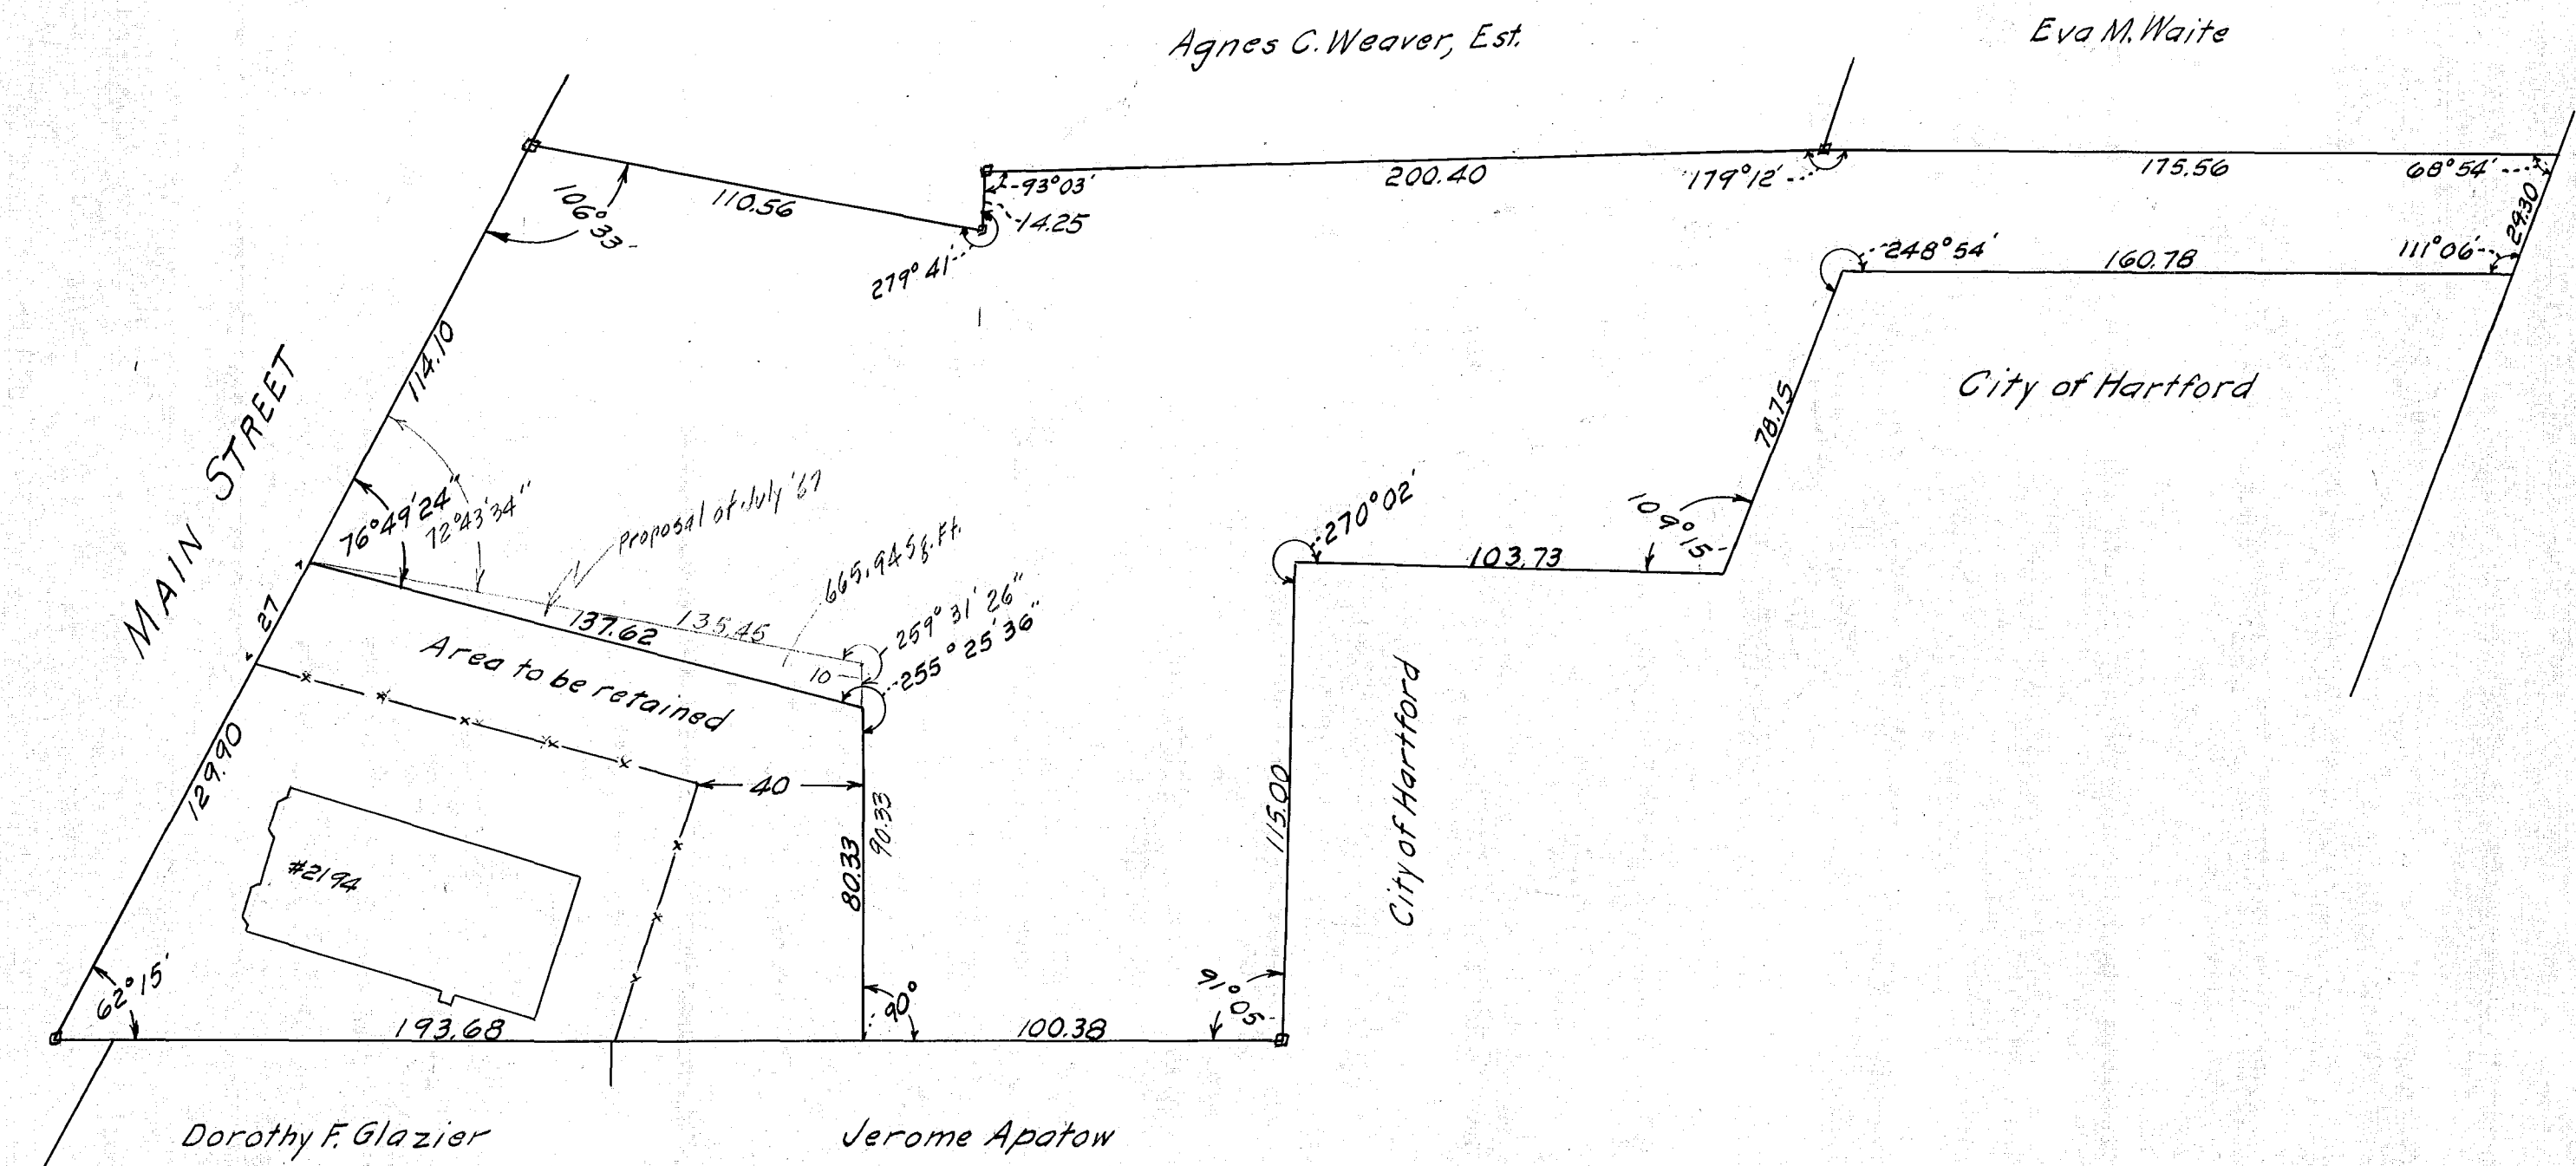


PLAN OF LAND TO BE CONVEYED
 BY
 THE HARTFORD ROMAN CATHOLIC DIOCESAN CORPORATION
 TO
 CITY OF HARTFORD

CITY OF HARTFORD
 DEPARTMENT OF ENGINEERING
 SCALE 1"=40' JANUARY 1963
 DAYBOOK No. 09755