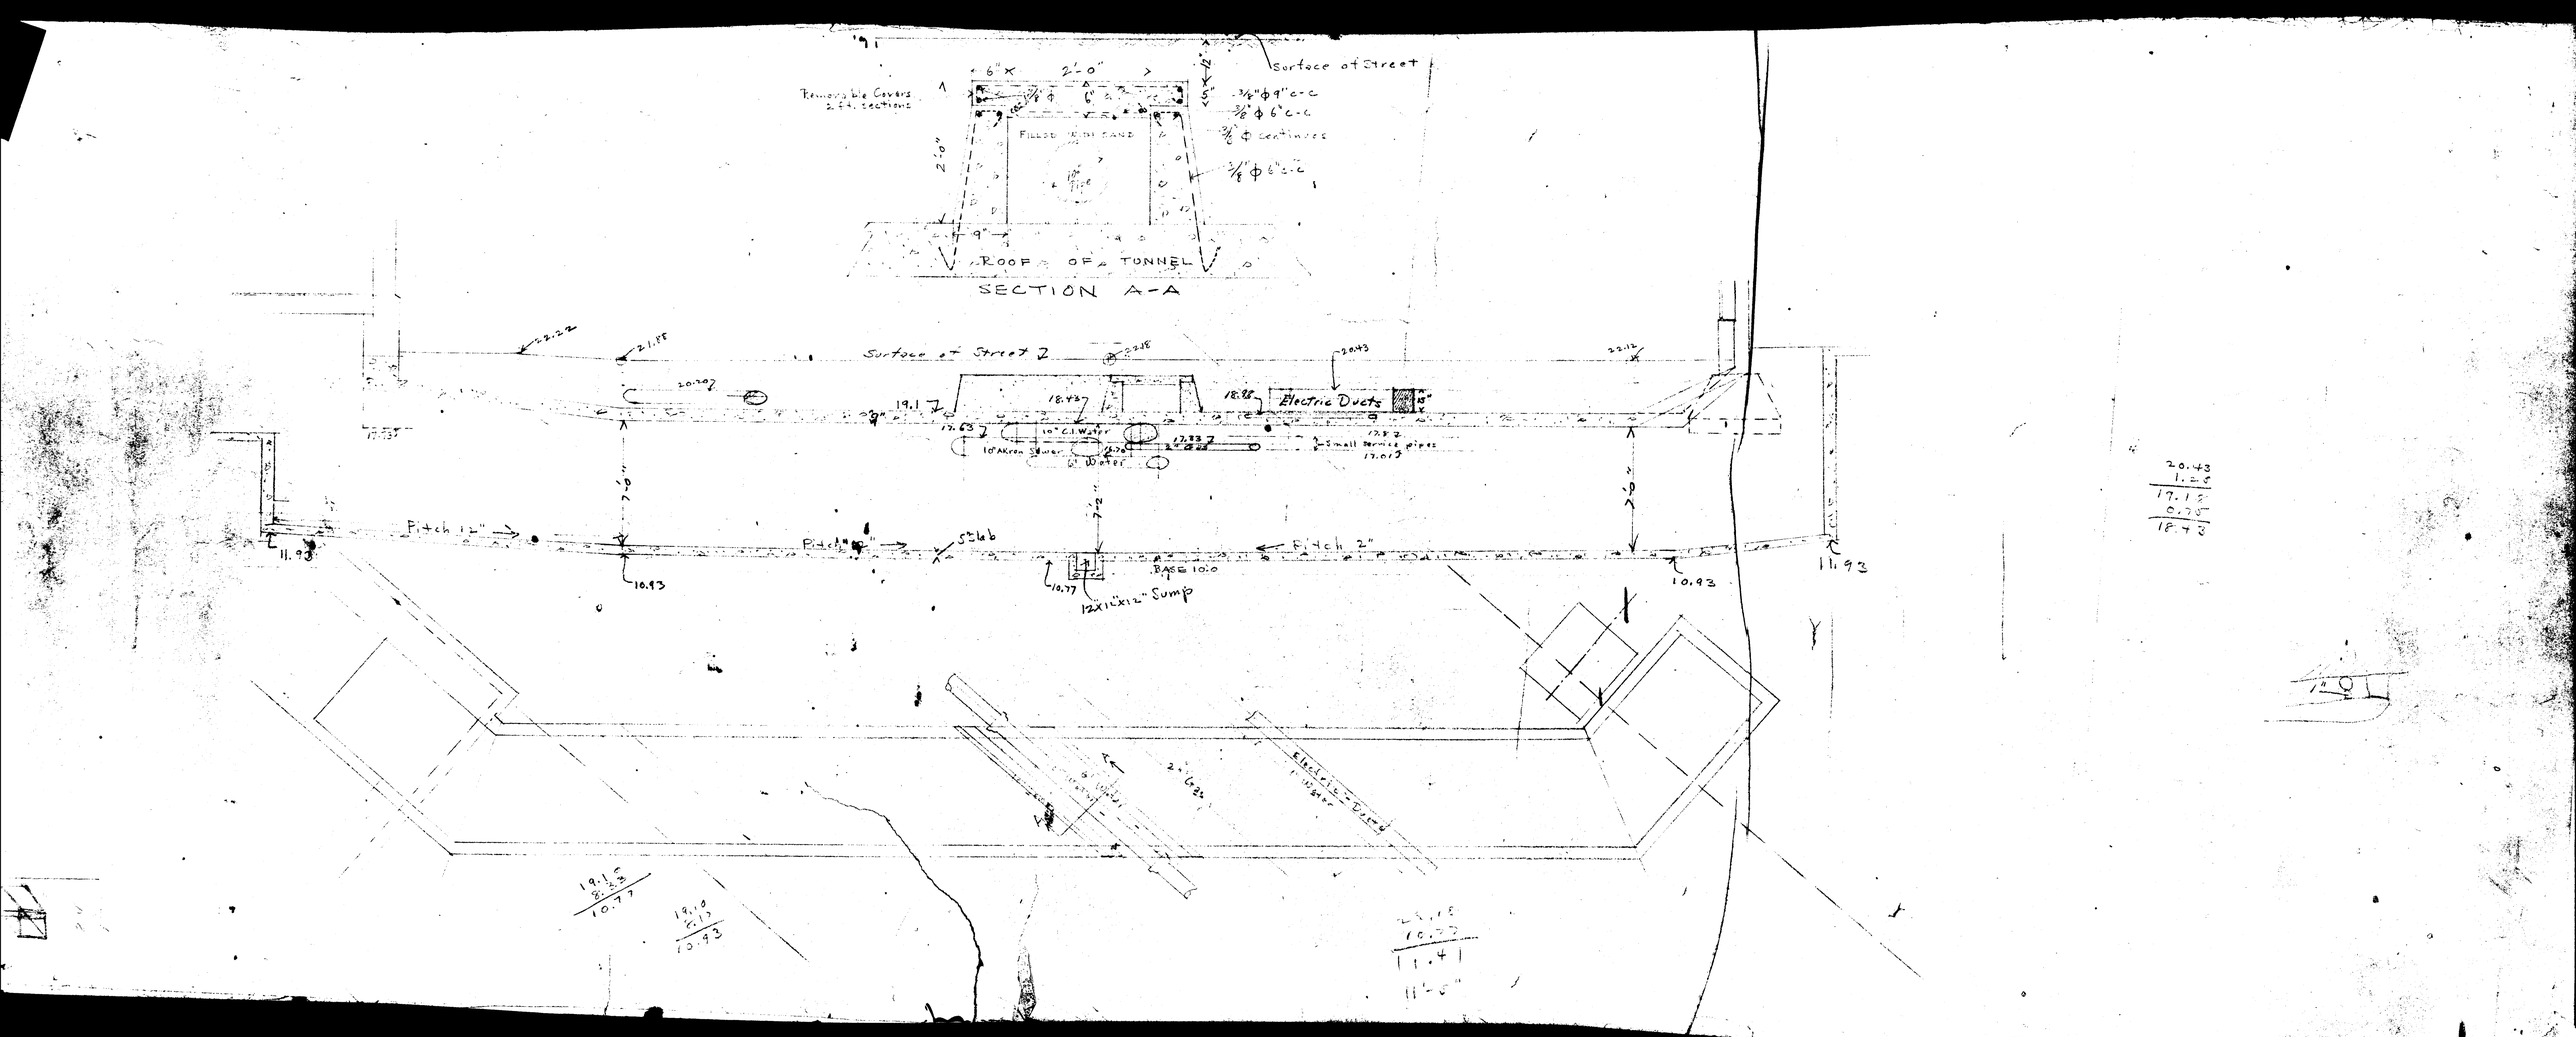
Removable Covers 2-24" sections
6" x 2'-0"
Surface of Street
3/8" ϕ 9" c-c
3/8" ϕ 6" c-c
3/8" ϕ continuous
3/8" ϕ 6" c-c
FILLED WITH SAND
ROOF OF TUNNEL
SECTION A-A
Surface of Street
Electric Ducts
10" C.I. Water
10" Akron Sewer
10" Water
2-Small Service pipes
Pitch 1:2"
Pitch 1:2"
Pitch 2"
BASE 10.0
12"x12"x12" Sump
Electric Ducts
11'-6"