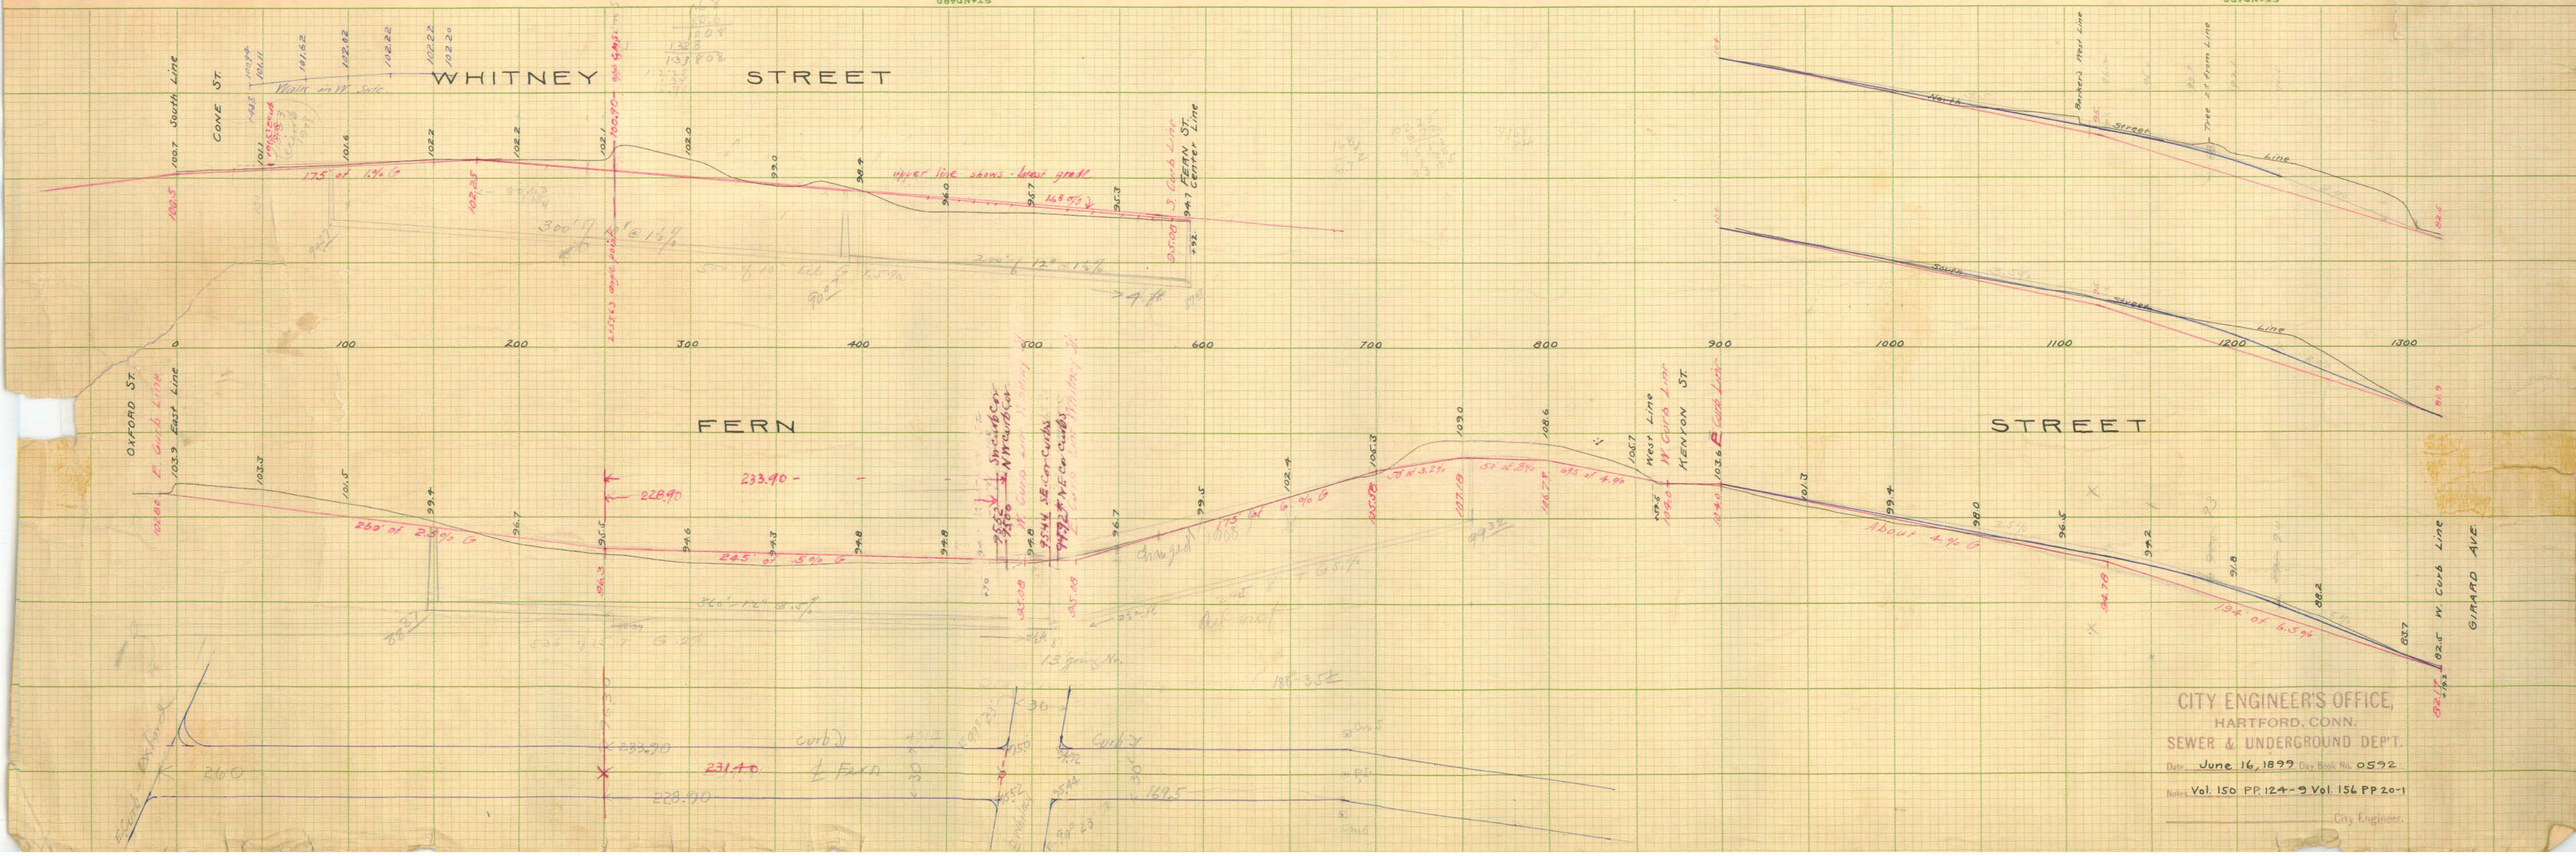
WHITNEY STREET
CONE ST.
South Line
FERN STREET
OXFORD ST.
East Line
E. Curb Line
West Line
W. Curb Line
S. Curb Line
FERN ST. CENTER Line
GIRARD AVE.
W. Curb Line
Tree at Curb Line
Bricker's West Line
0
100
200
300
400
500
600
700
800
900
1000
1100
1200
1300
CITY ENGINEER'S OFFICE,
HARTFORD, CONN.
SEWER & UNDERGROUND DEP'T.
Date June 16, 1899 Day Book No. 0592
Notes Vol. 150 PP. 124-9 Vol. 156 PP 20-1
City Engineer.