



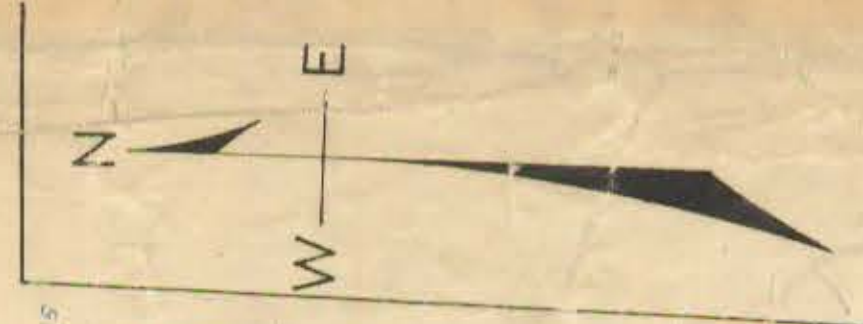


TOWN OF BLOOMFIELD


WEST Dec 10, 1917 Vol 6-240

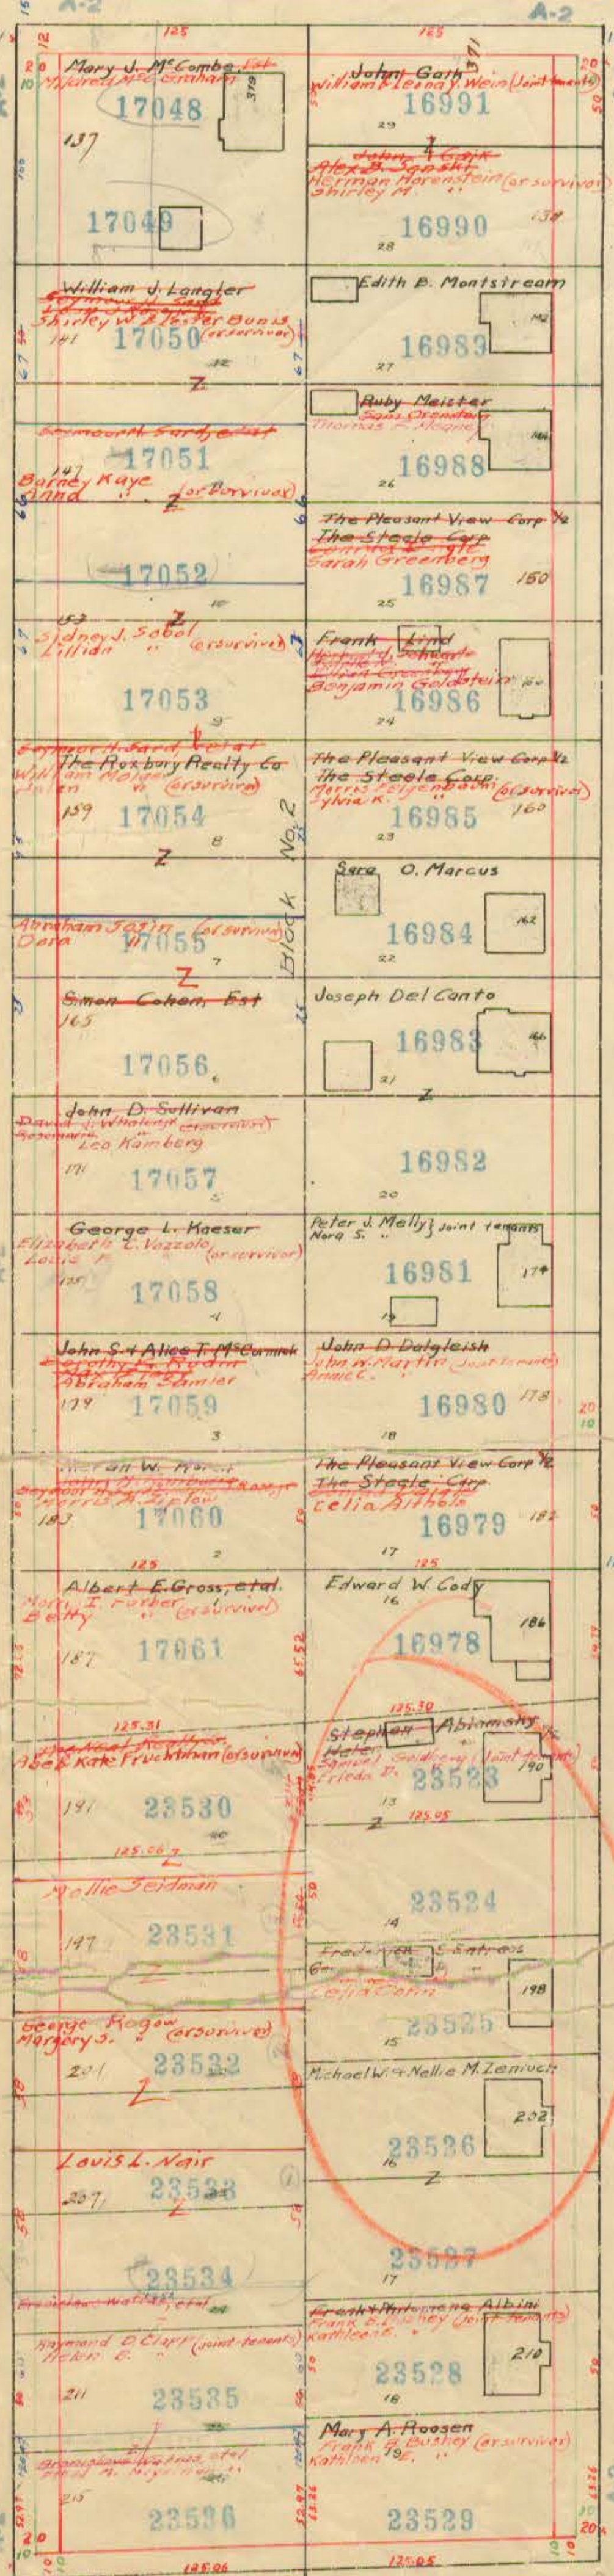


WEST Dec 10, 1917 Vol 6-239

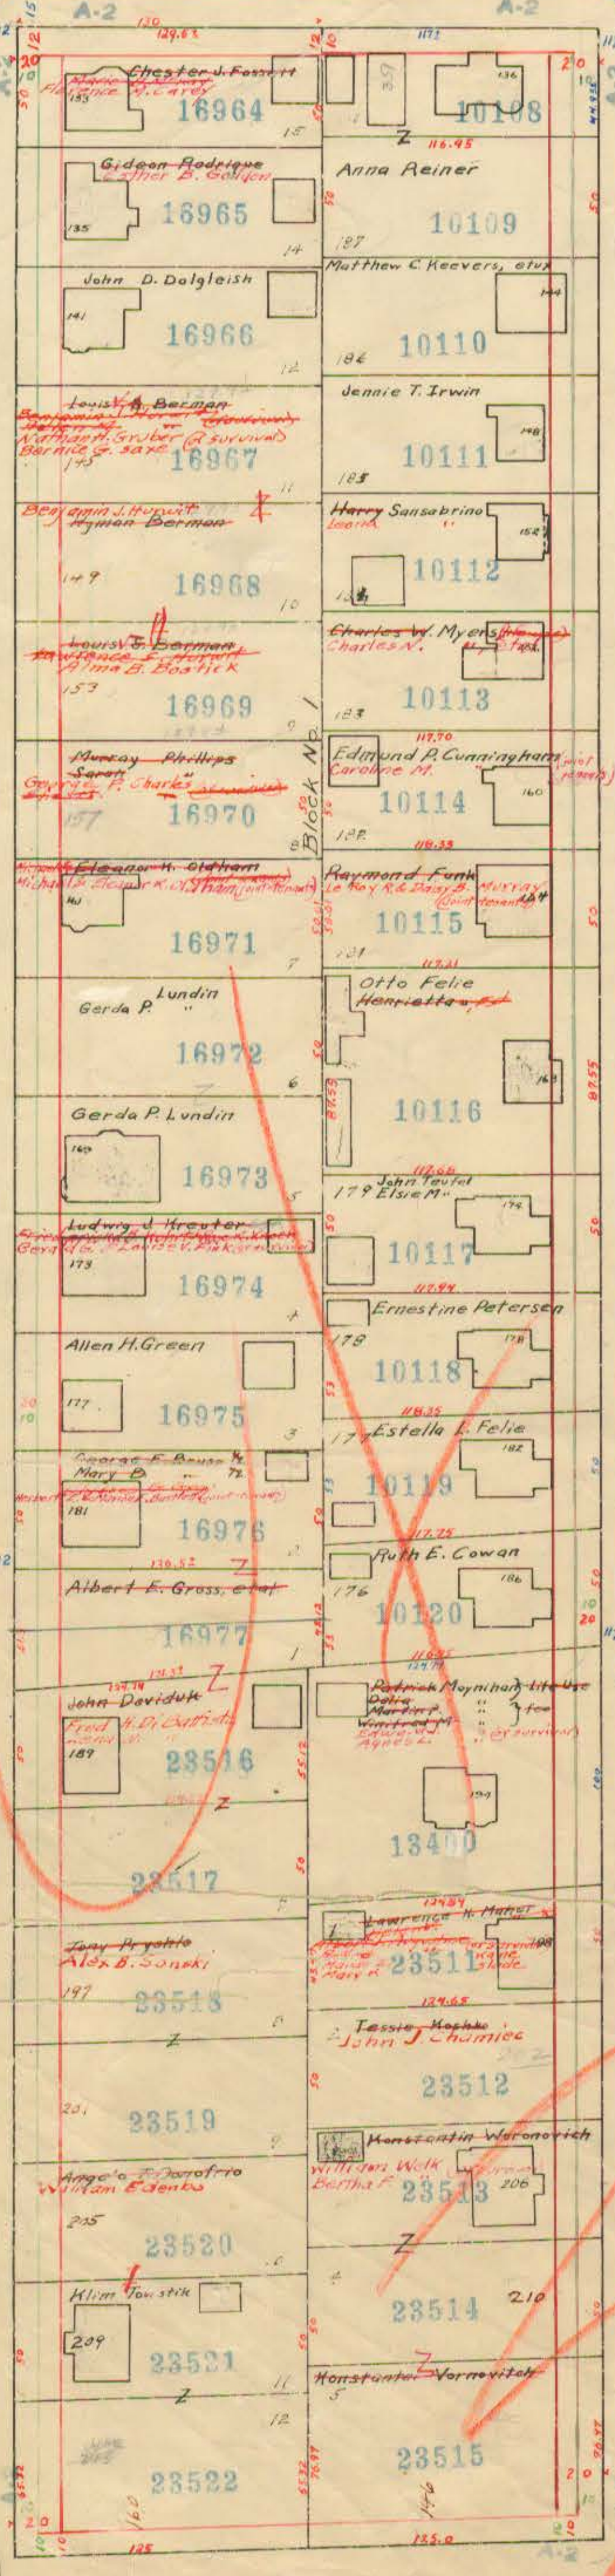



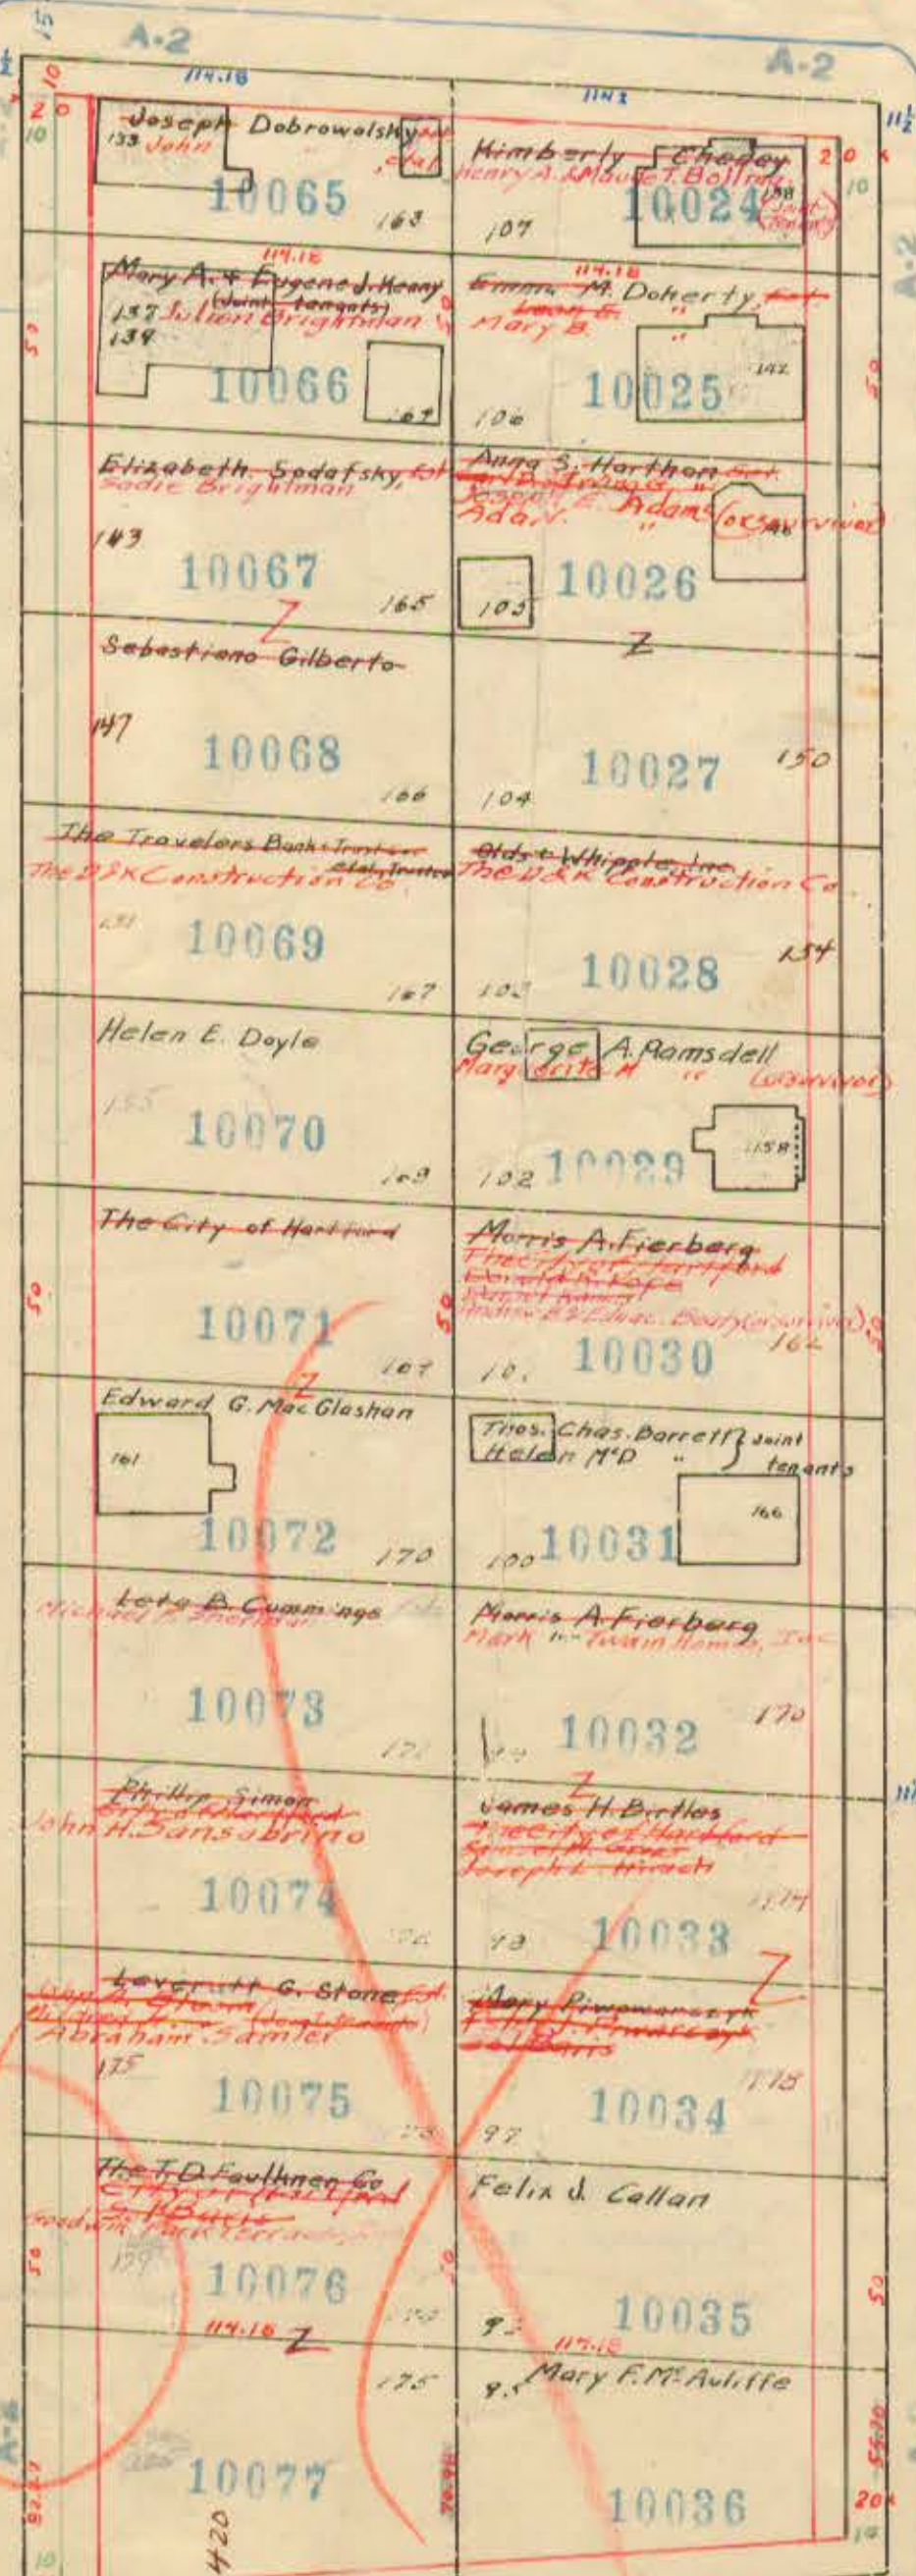


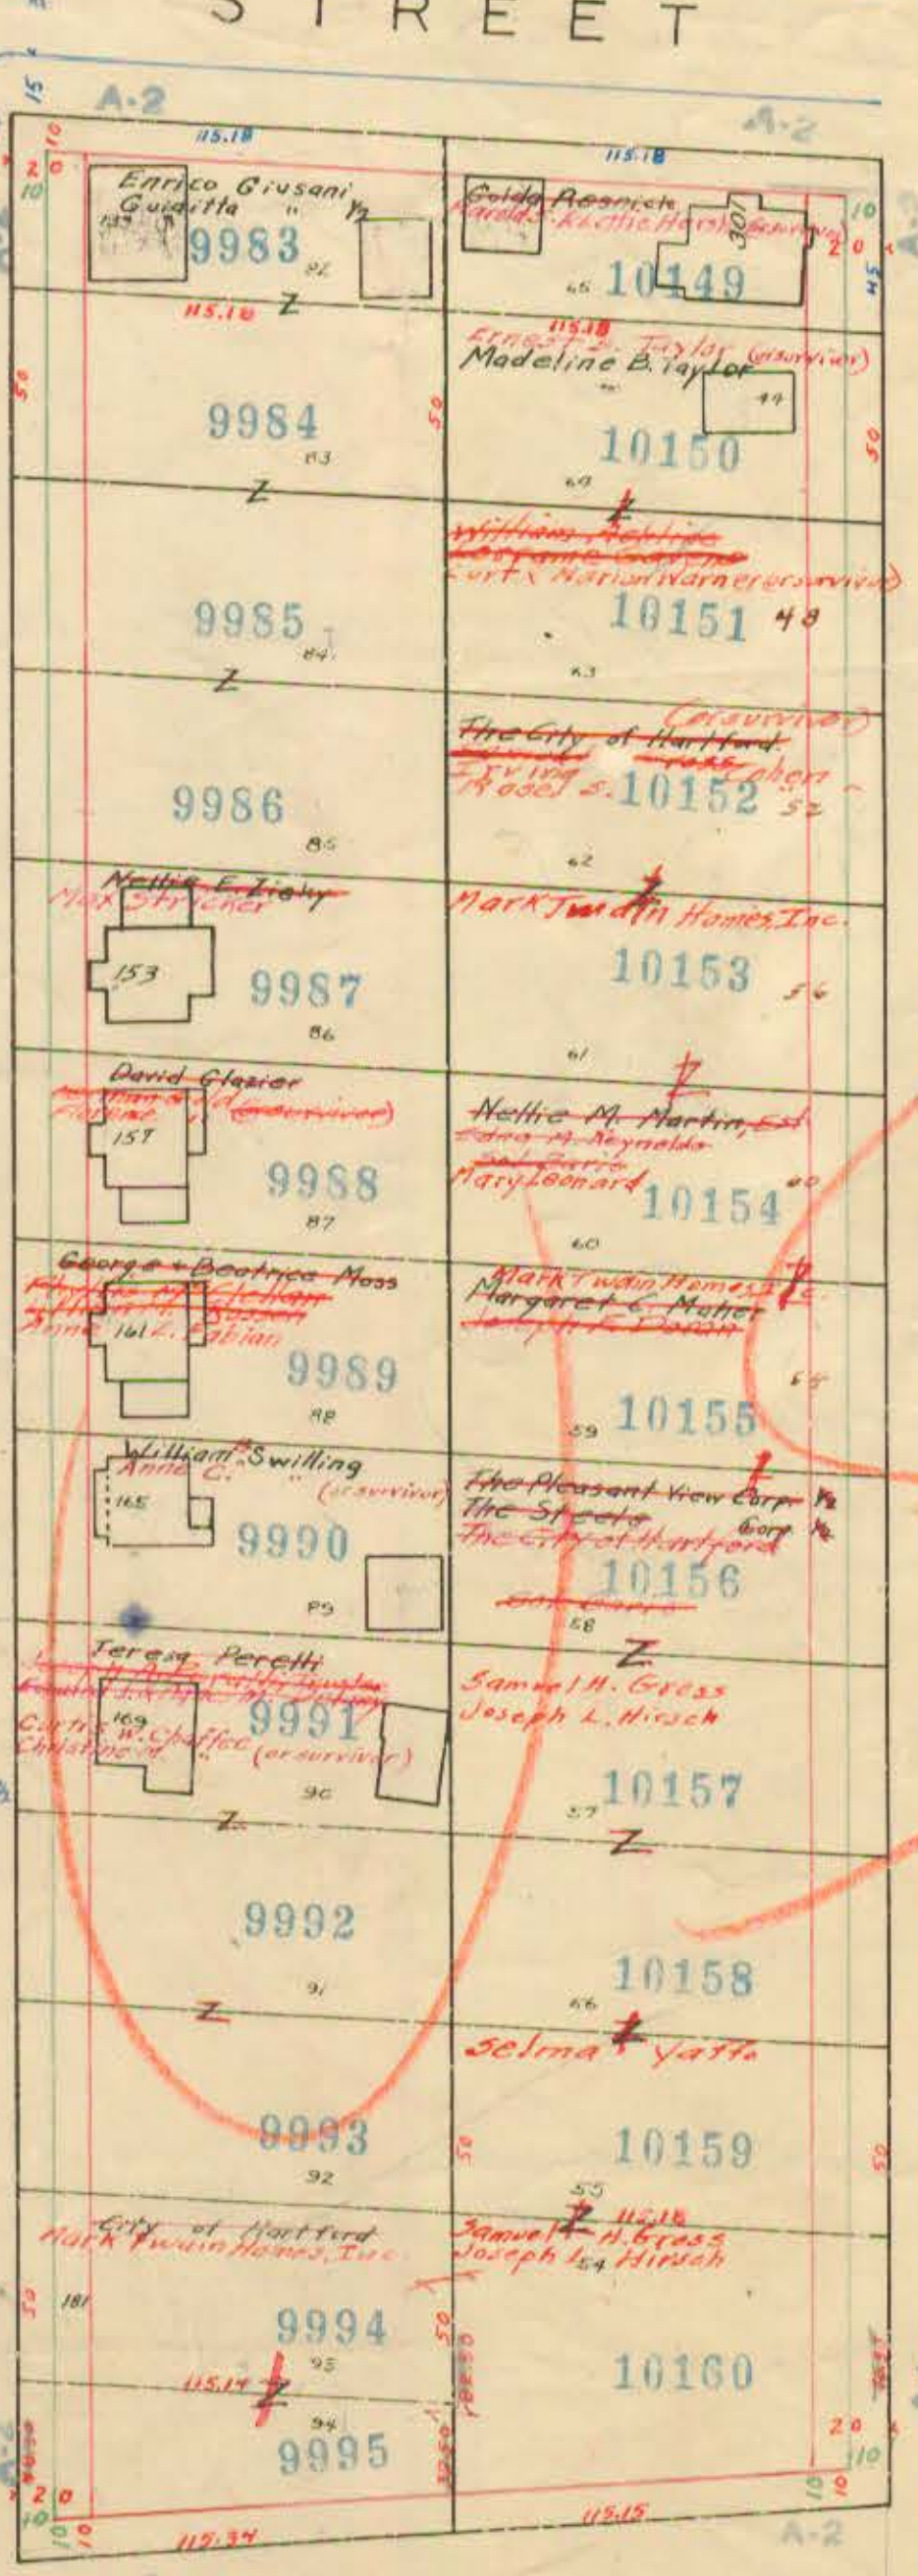



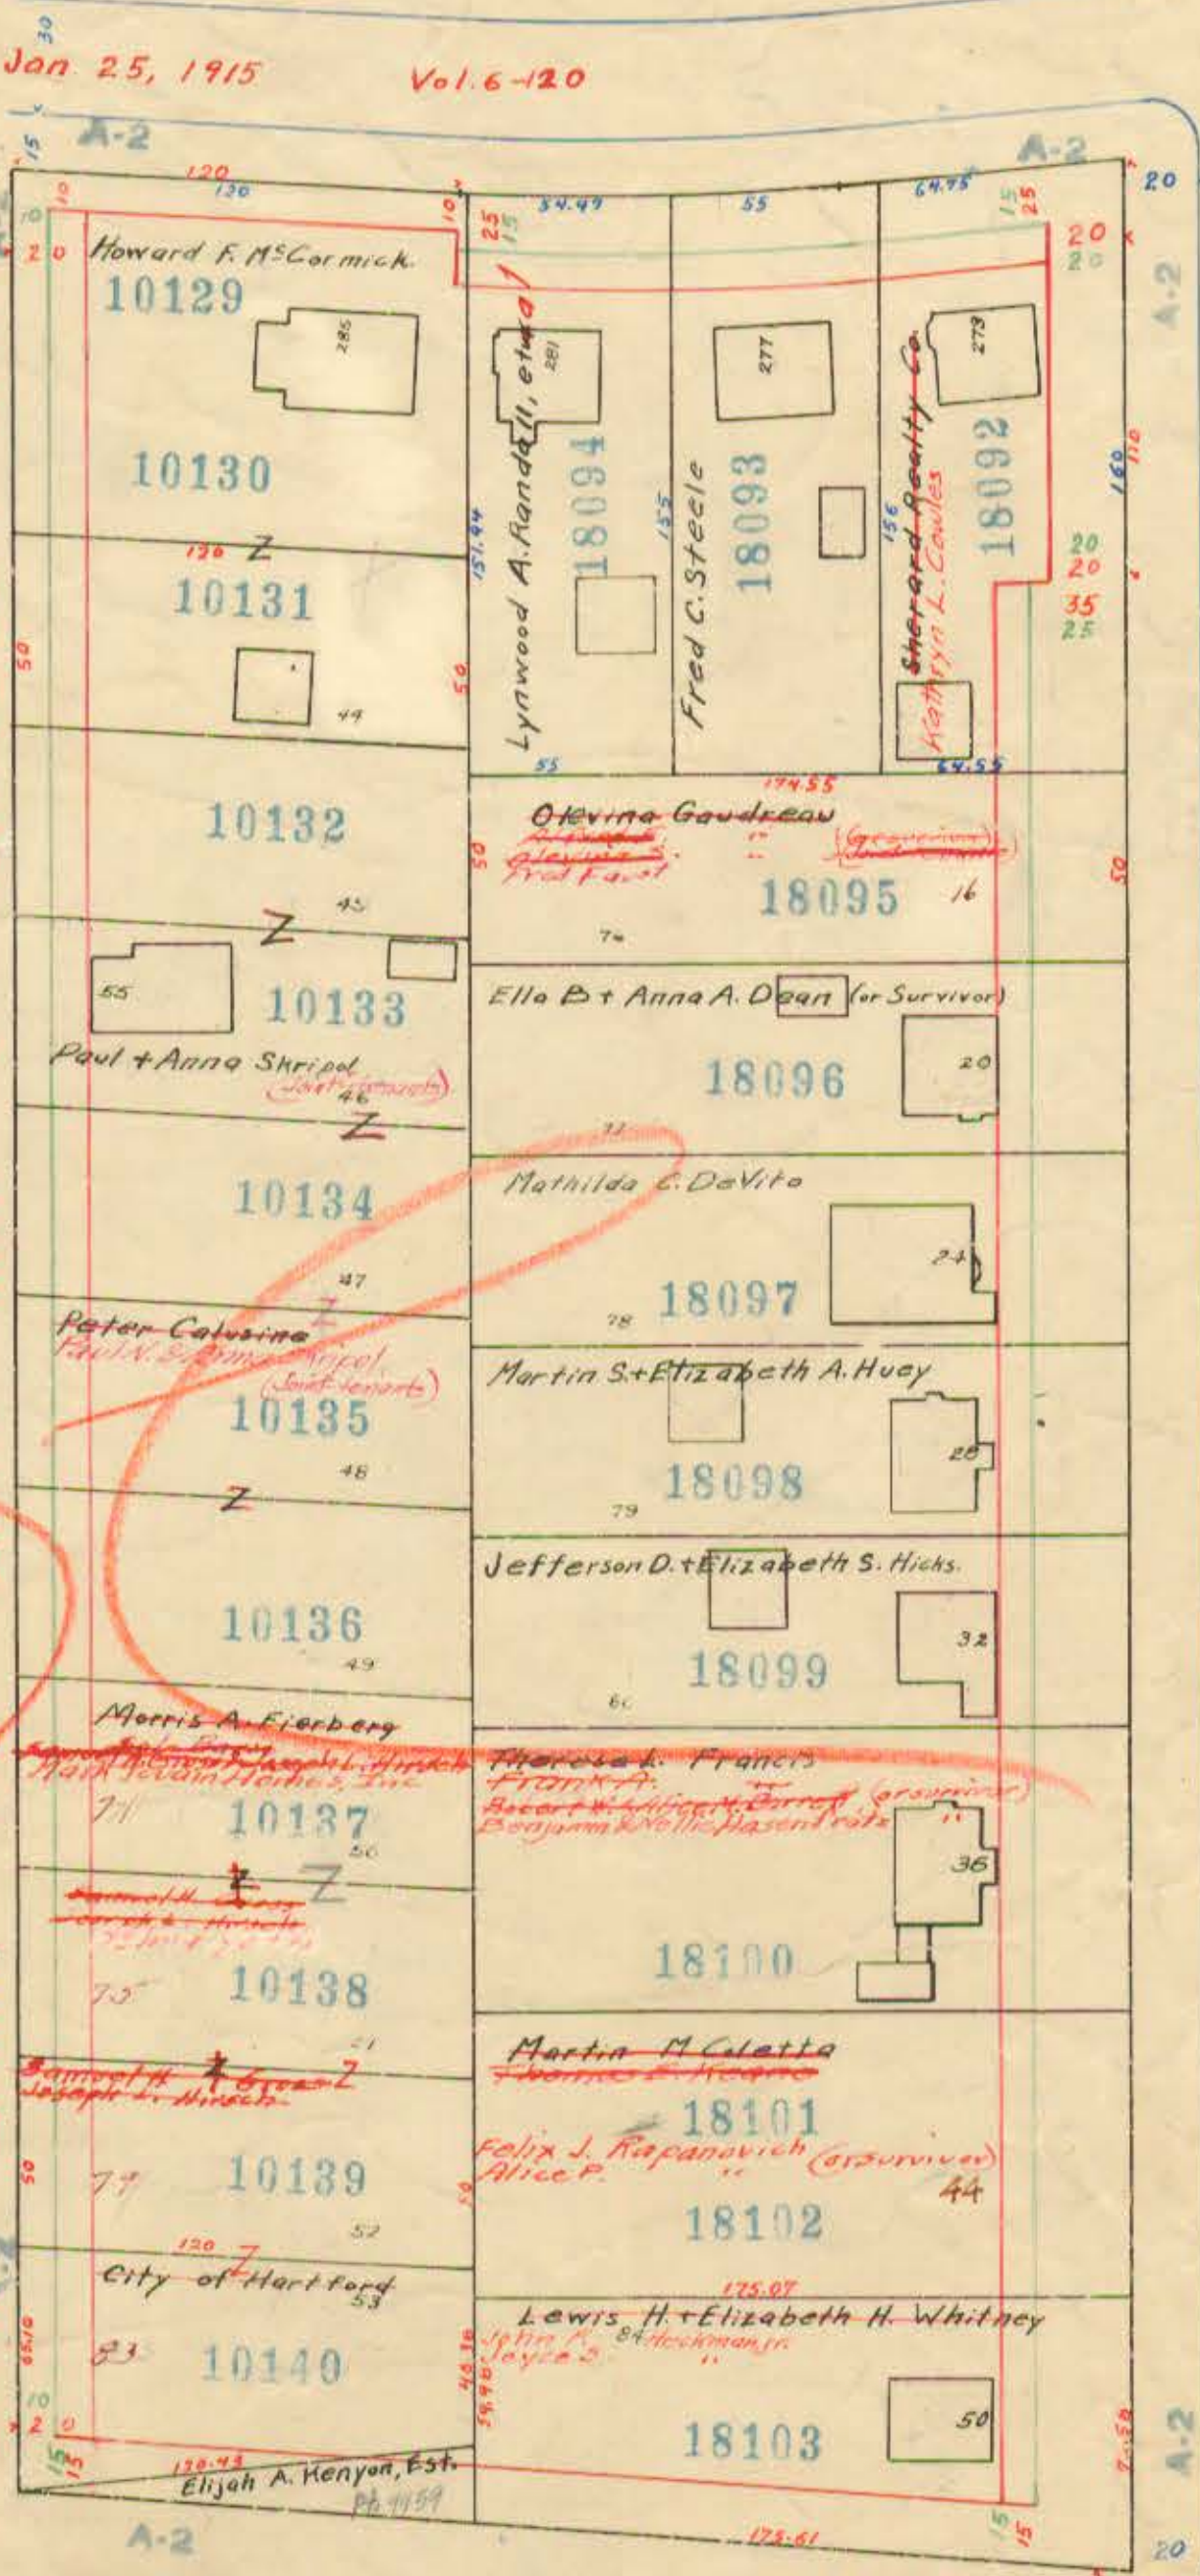


LYME Street, Building and Veranda Lines of Sept. 10, 1917 Vol 6-240

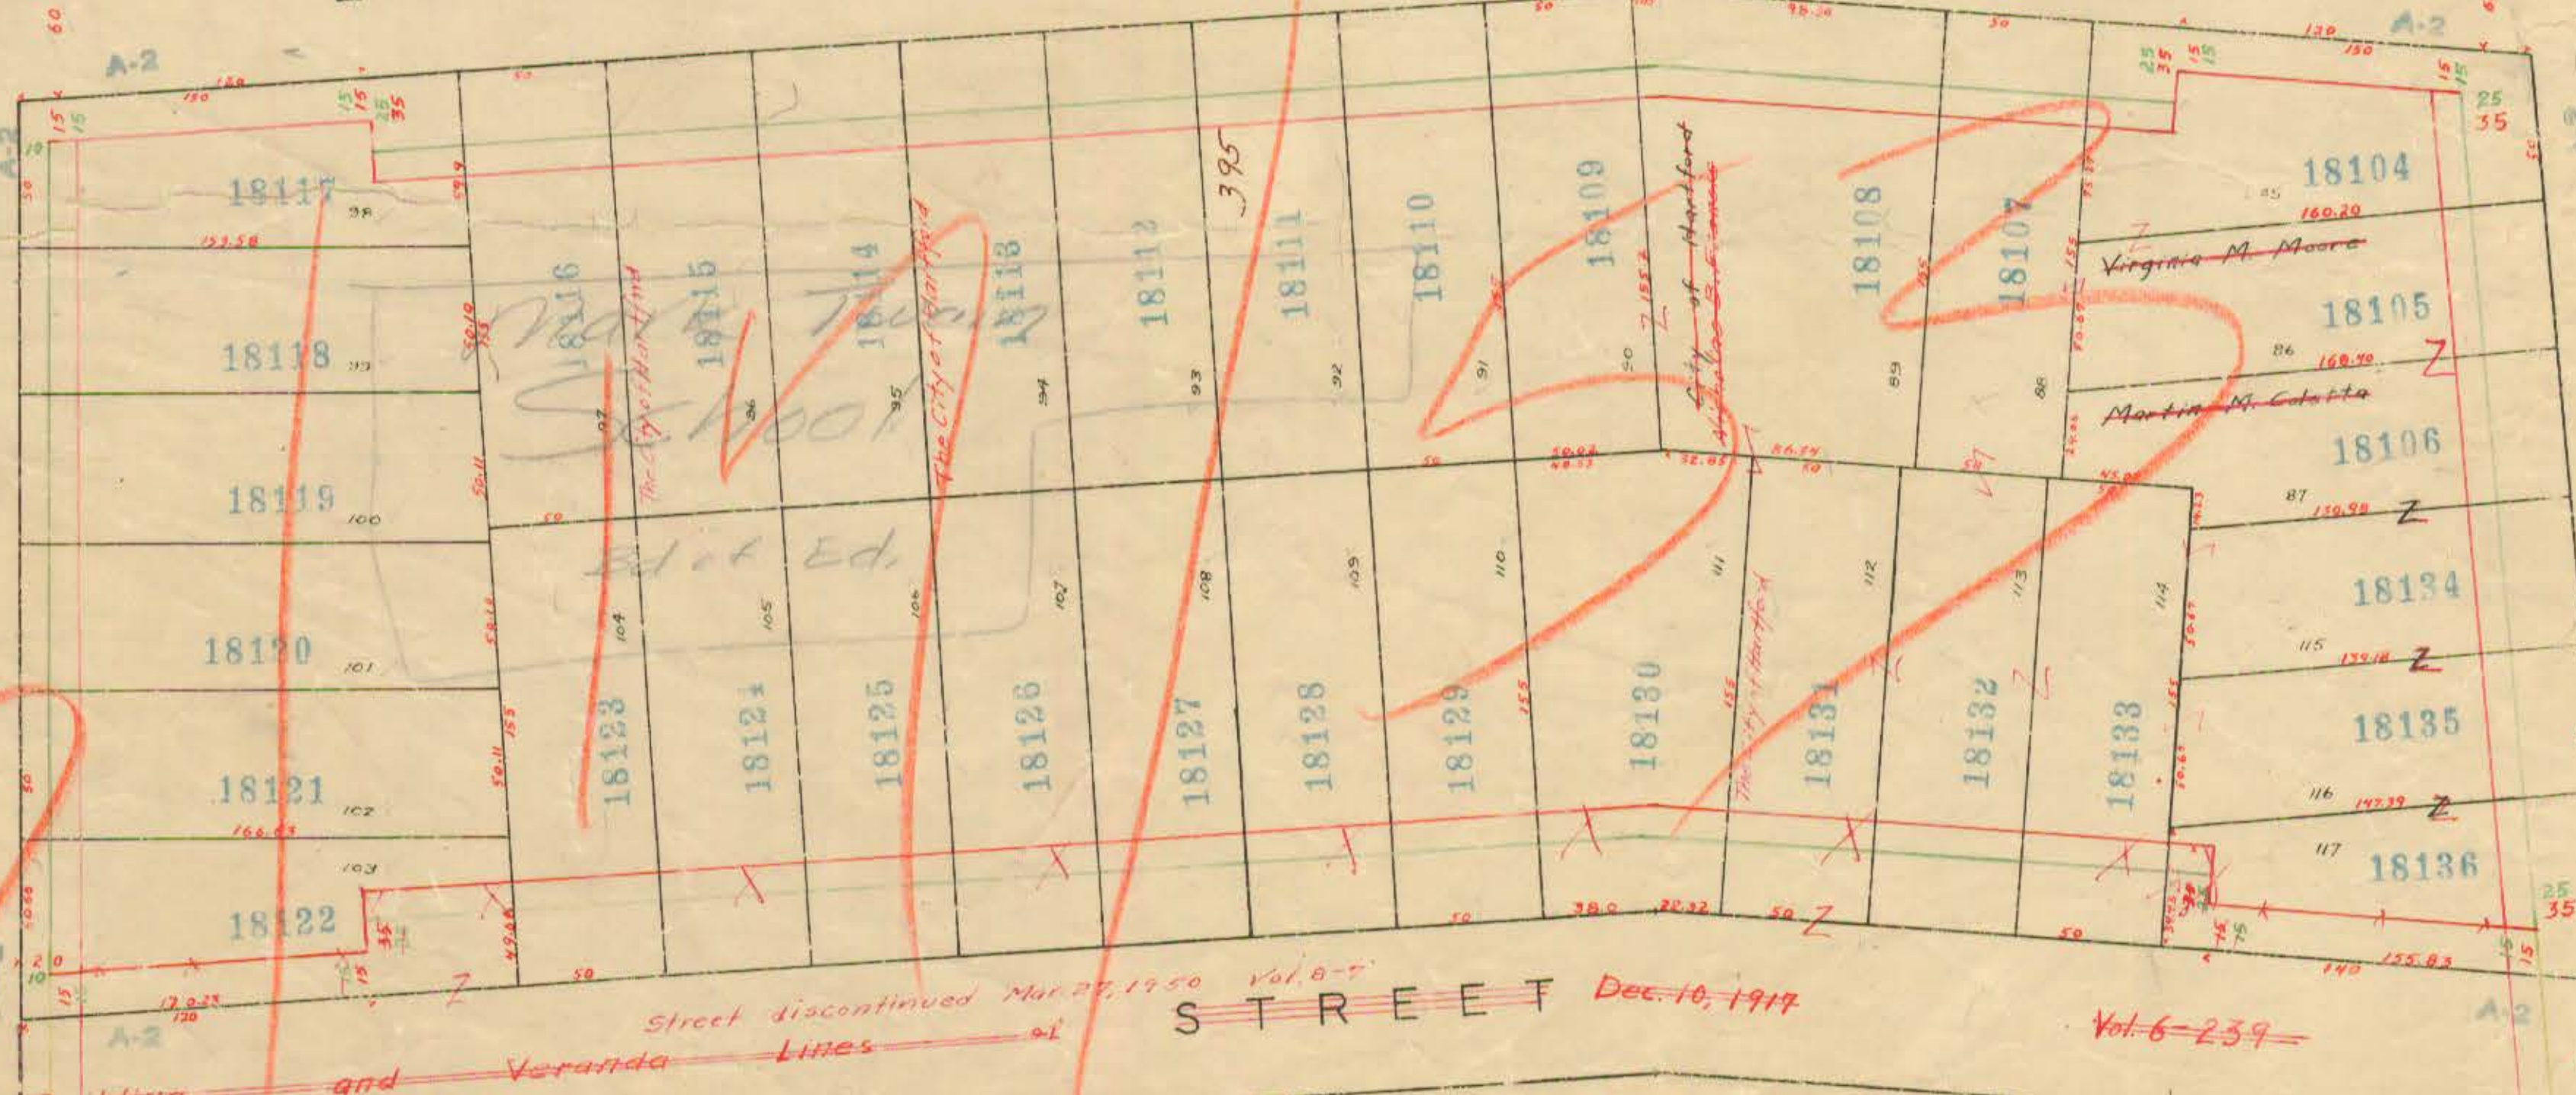

LYME Street, Building and Veranda Lines of Sept. 10, 1917 Vol 6-239

See Sheet 182