


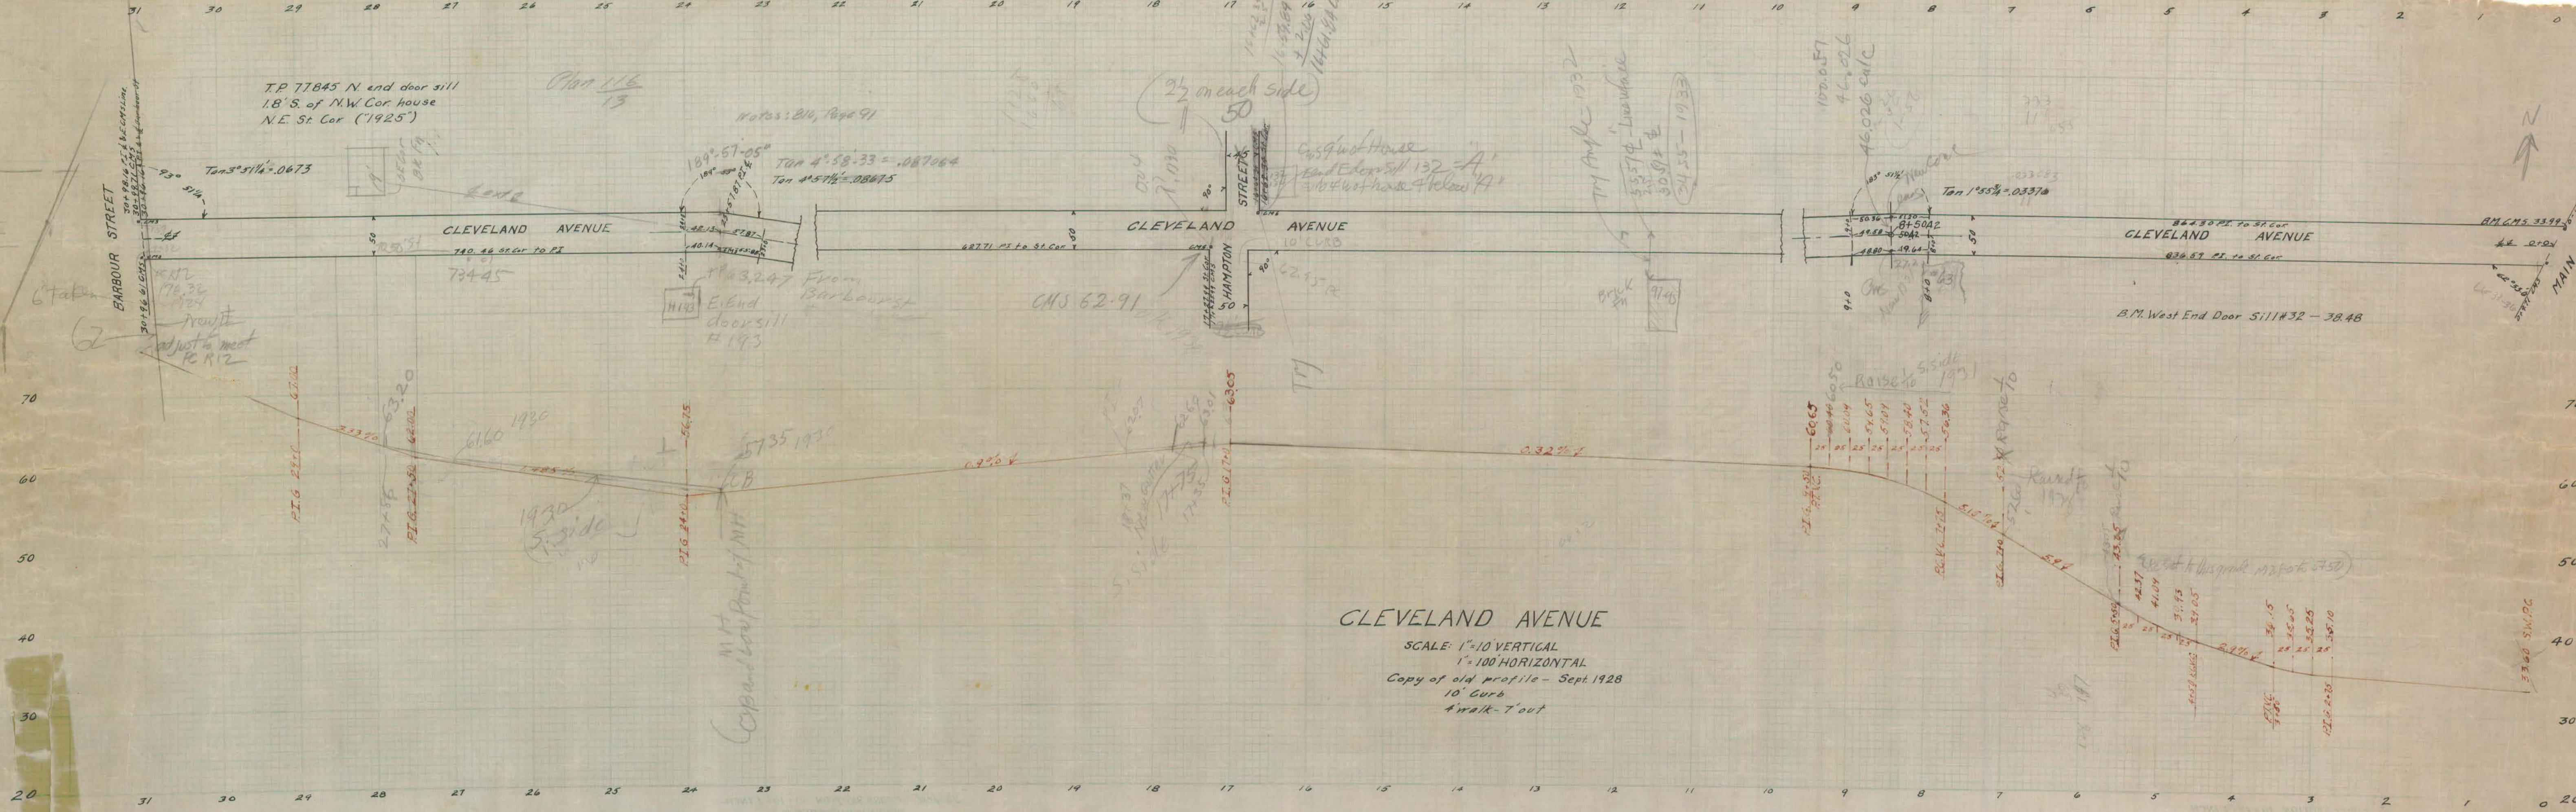

CLEVELAND AVENUE
SCALE: 1"=10' VERTICAL
1"=100' HORIZONTAL
Copy of old profile - Sept. 1928
10' Curb
4' walk - 7' out