


Cross Sections on Garden Street

to accompany profile 02553-¹⁷⁷/_{4A}

Horizontal Scale 1" = 40'

Vertical " 1" = 4' Jan. 1911

Sh 8 1/3 250 curbs to auto grade }
1670 sq-yards macadam - } Jan 12 1911

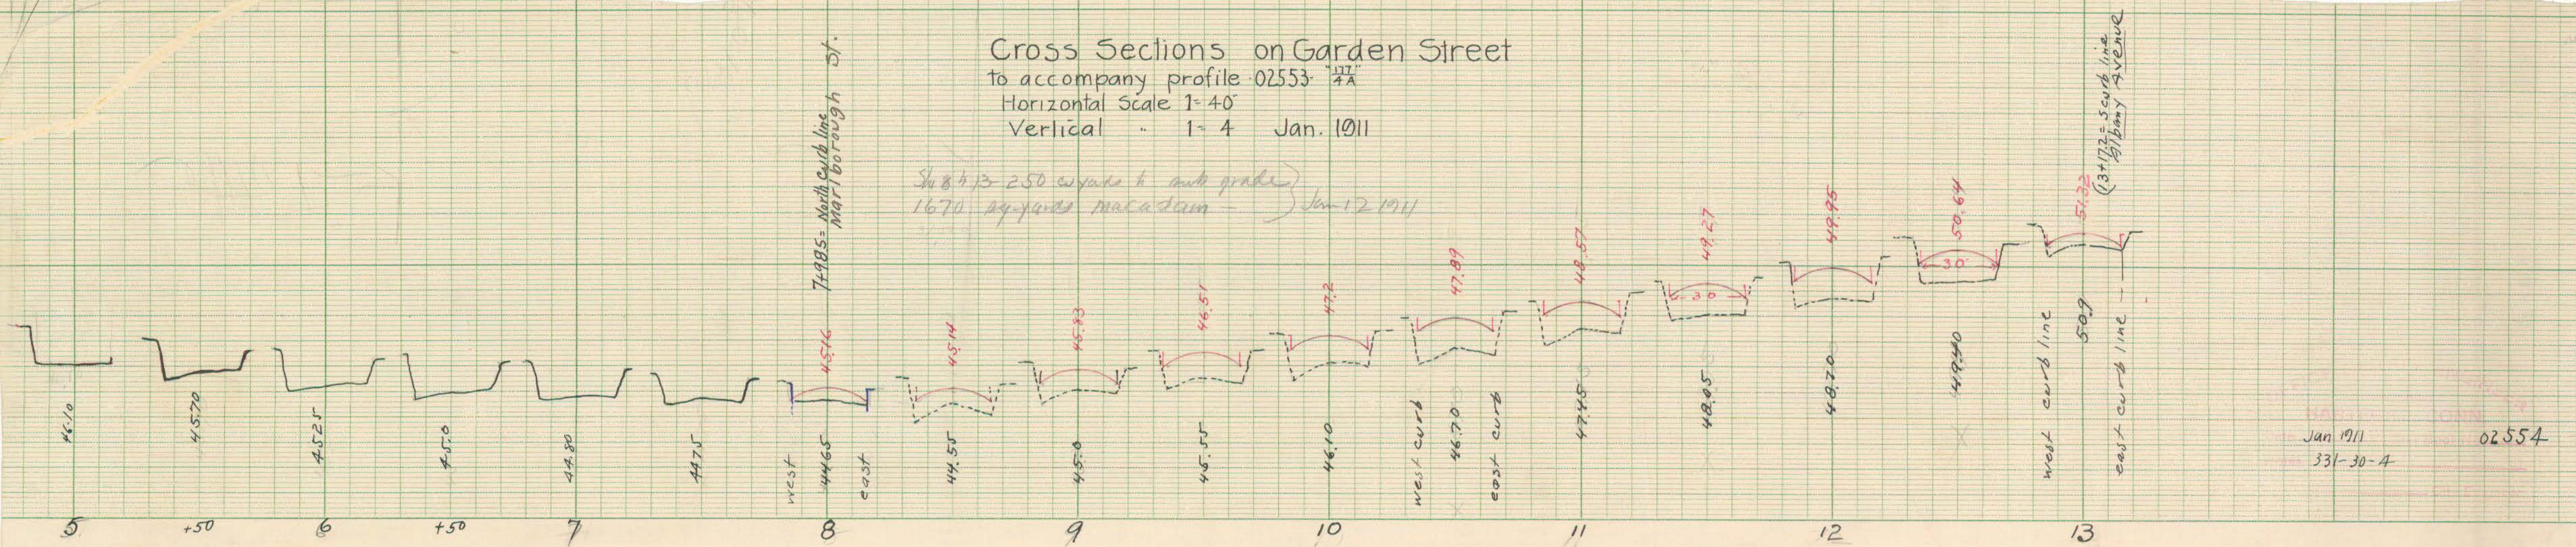

Jan 1911
331-30-4

02554