


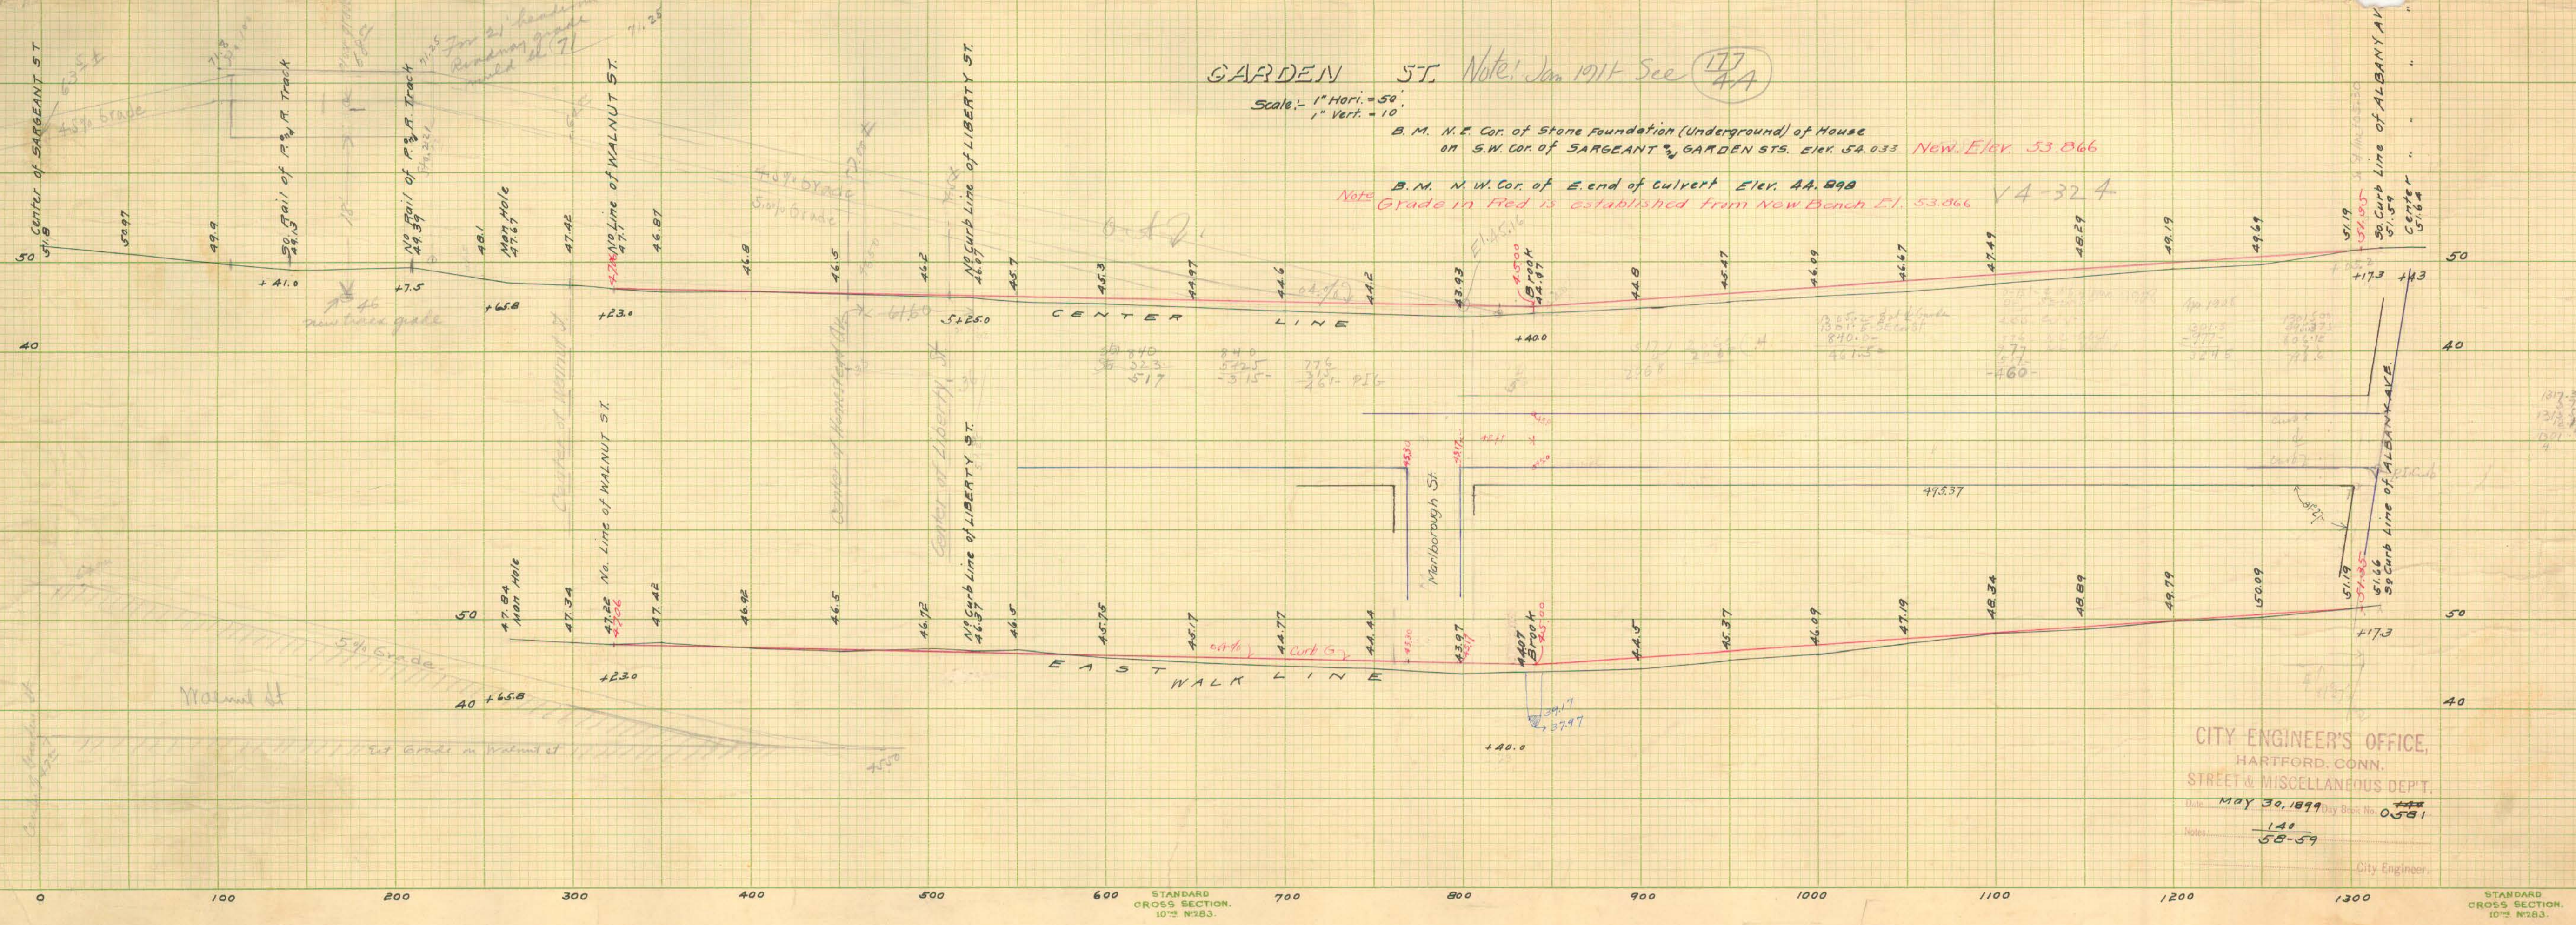

GARDEN ST Note! Jan 1911 See 177 4A
Scale: 1" Hori. = 50'
1" Vert. = 10'

B.M. N.E. Cor. of Stone Foundation (Underground) of House
on S.W. Cor. of SARGEANT & GARDEN STS. Elev. 54.033 New Elev. 53.866

Note B.M. N.W. Cor. of E. end of Culvert Elev. AA. 898
Grade in Red is established from New Bench E. 53.866 V4-324

CITY ENGINEER'S OFFICE,
HARTFORD, CONN.
STREET & MISCELLANEOUS DEPT.
Date May 30, 1899 Day Book No. 0581
Notes 140
58-59
City Engineer

STANDARD
CROSS SECTION.
10" N283.

STANDARD
CROSS SECTION.
10" N283.