



Scale 1" = 20'

JUNE 22 1899.
ANC

THEODORE W. RICH
Supt PUBLIC PARKS

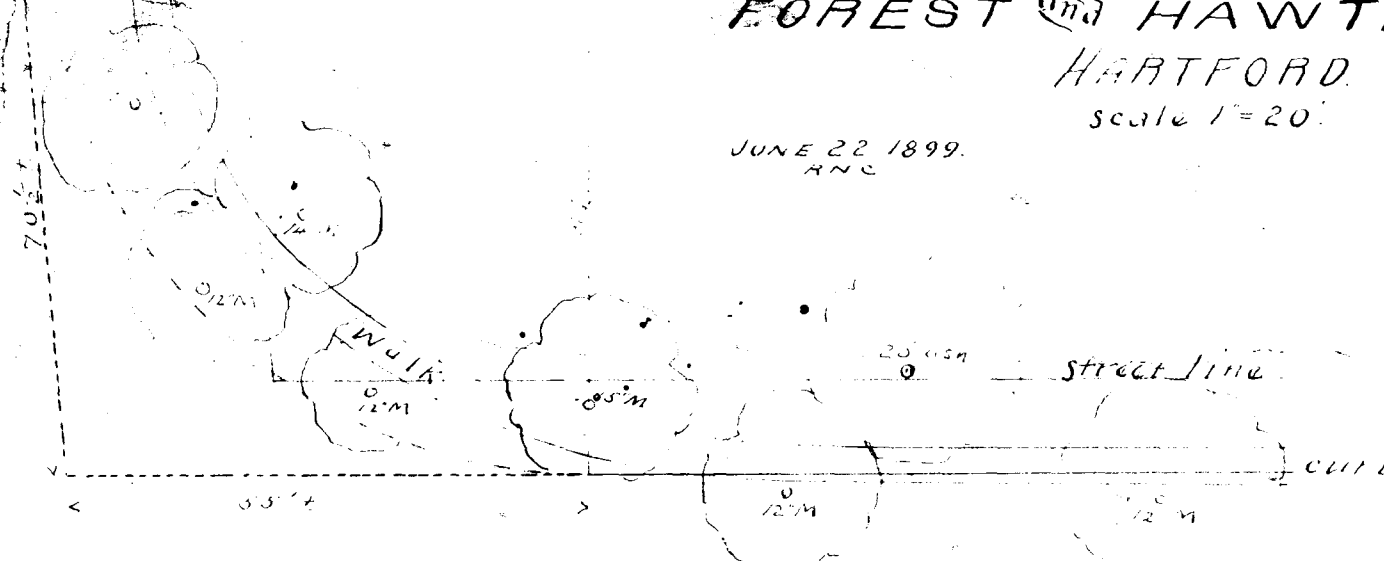

HAWTHORN STREET