



FENWICK STREET


SCALE 1" = 40'
NUMBERS 25' APART

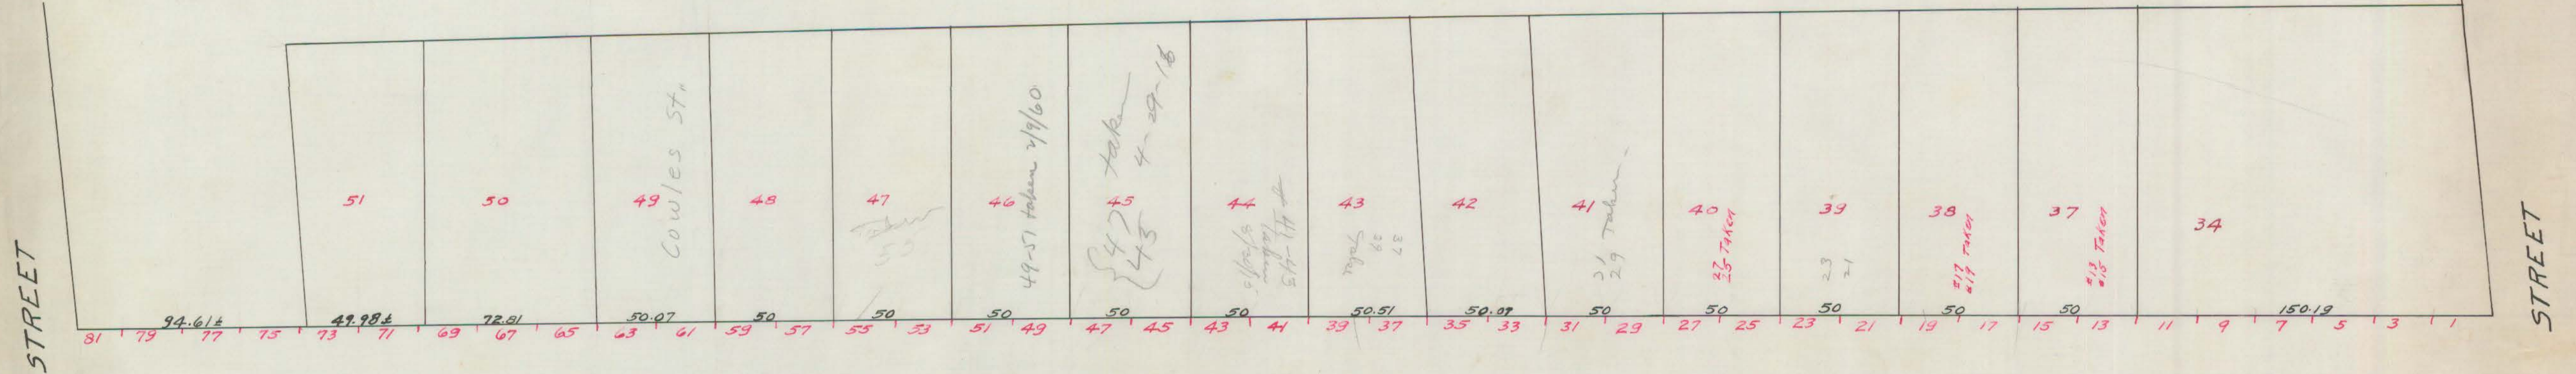

HANMER STREET

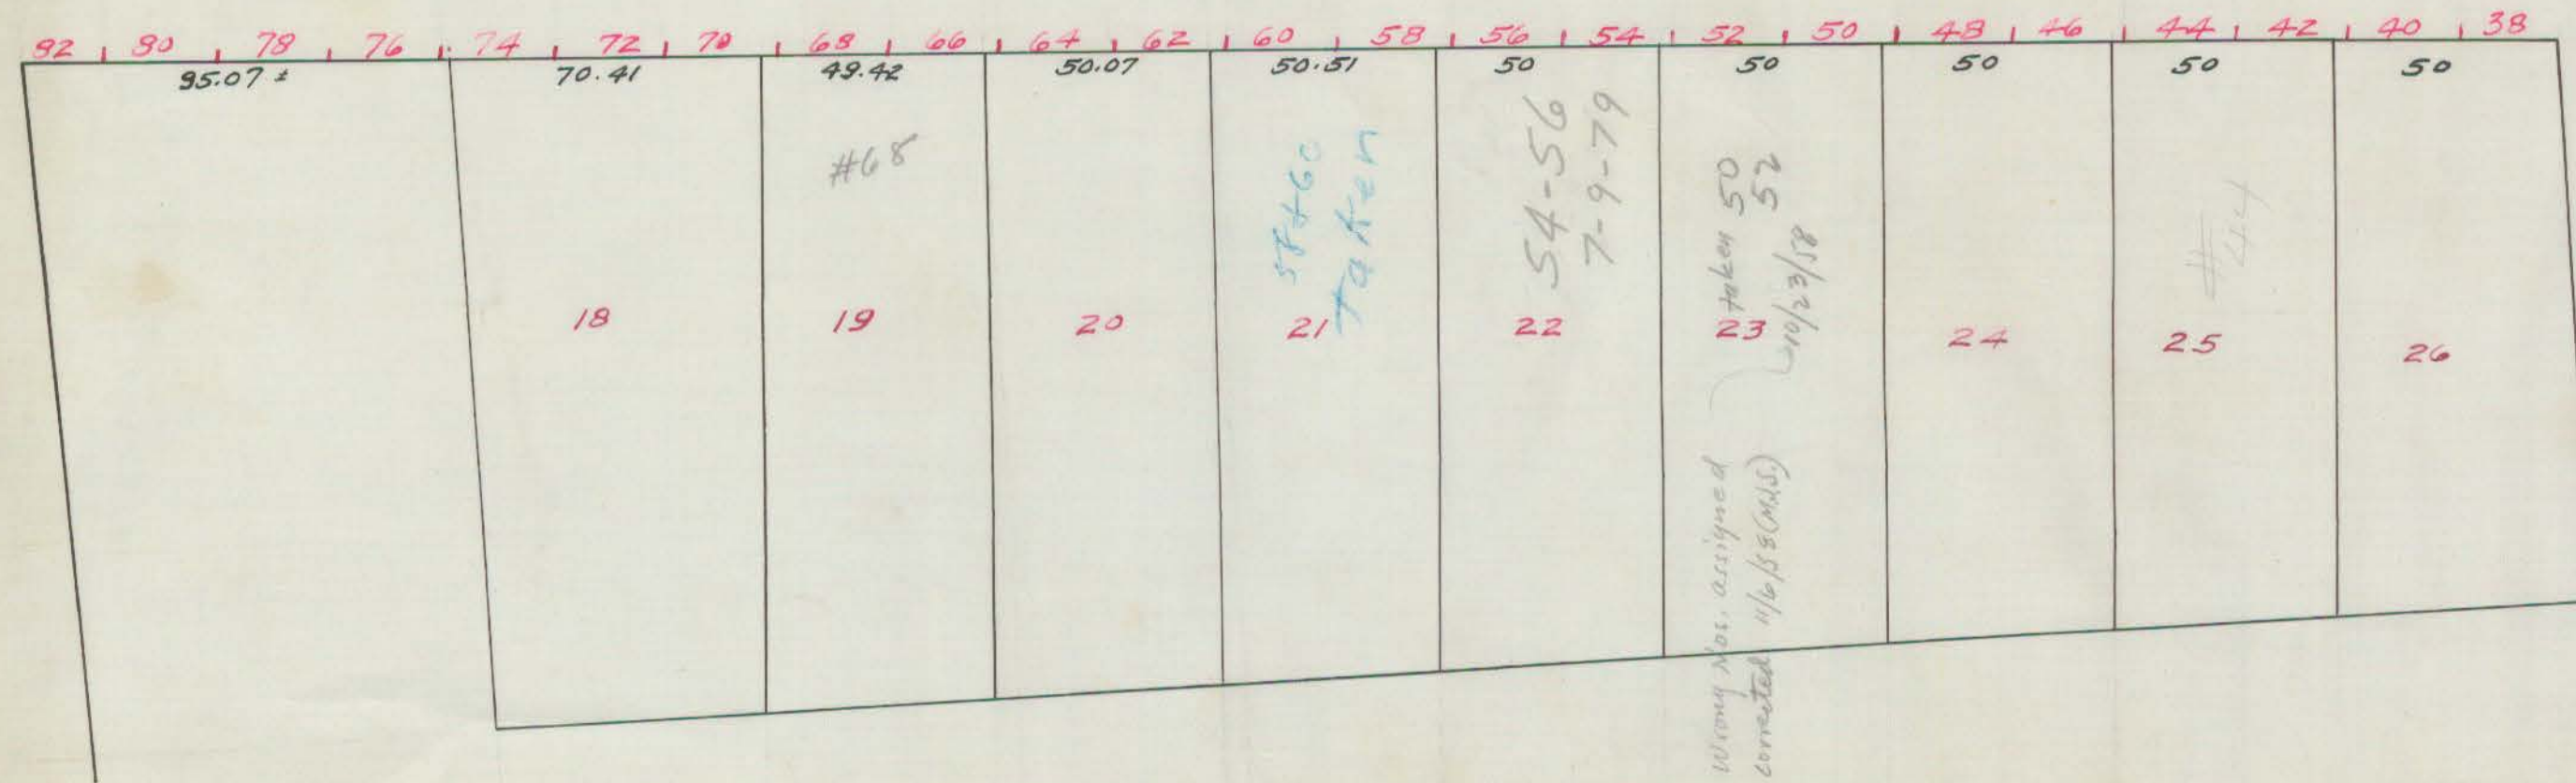

ROOSEVELT STREET

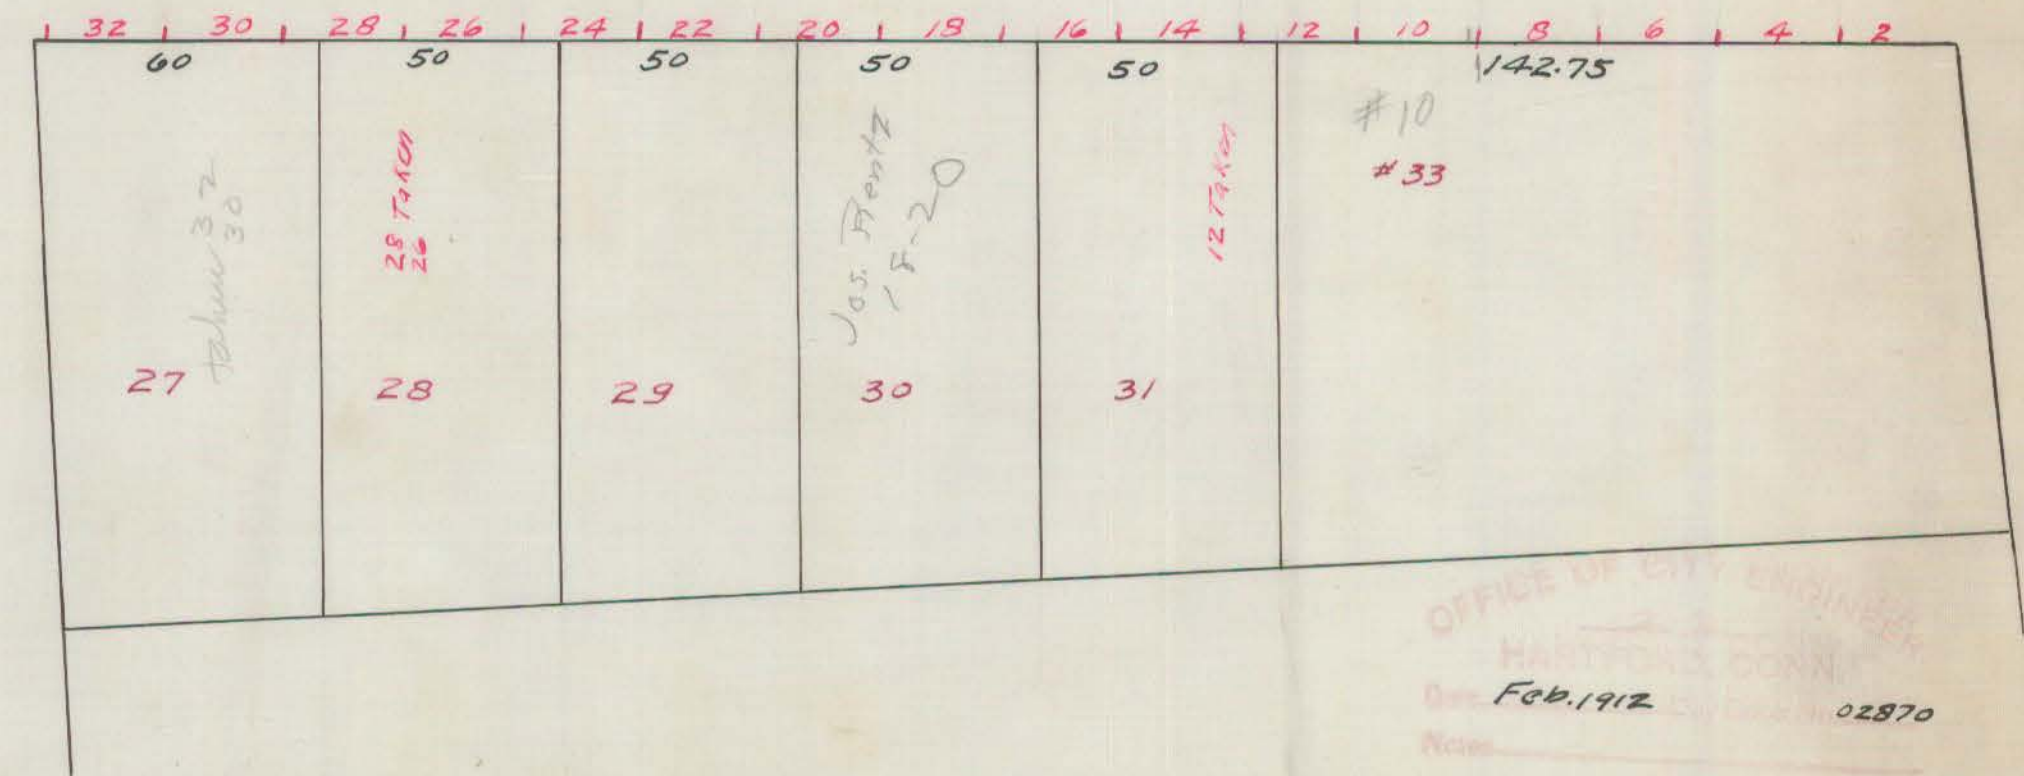

OFFICE OF CITY ENGINEER
HARTFORD, CONN.
Date Feb. 1912 City Engineer 02870
Name _____ City Engineer