


177
17~A

177
17A

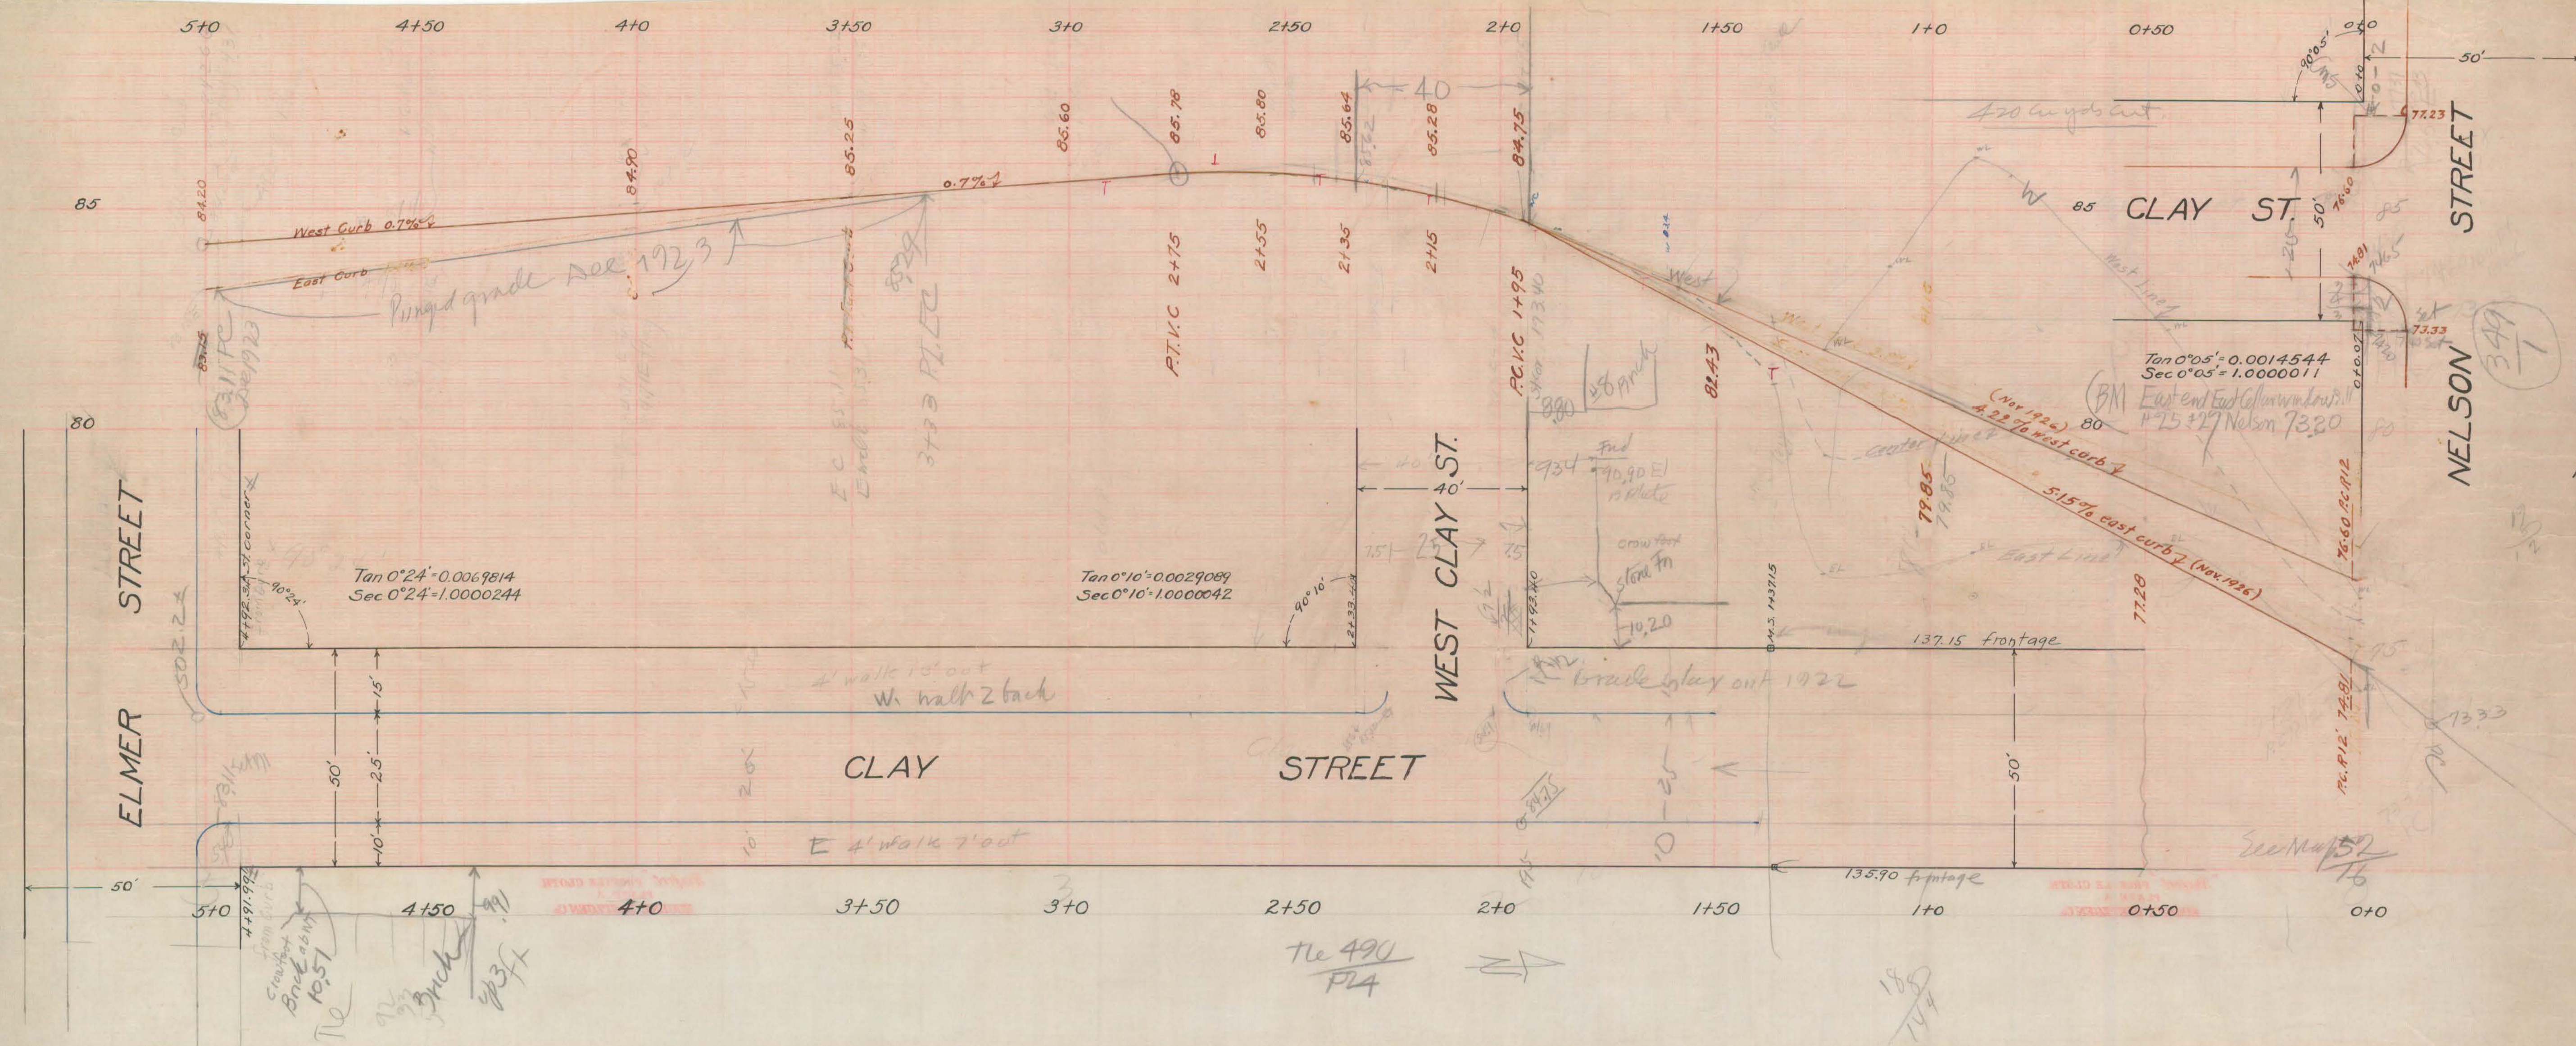

HILLYER ST.

349
1

177
17A