



DURHAM Street, Building and Veranda Lines of

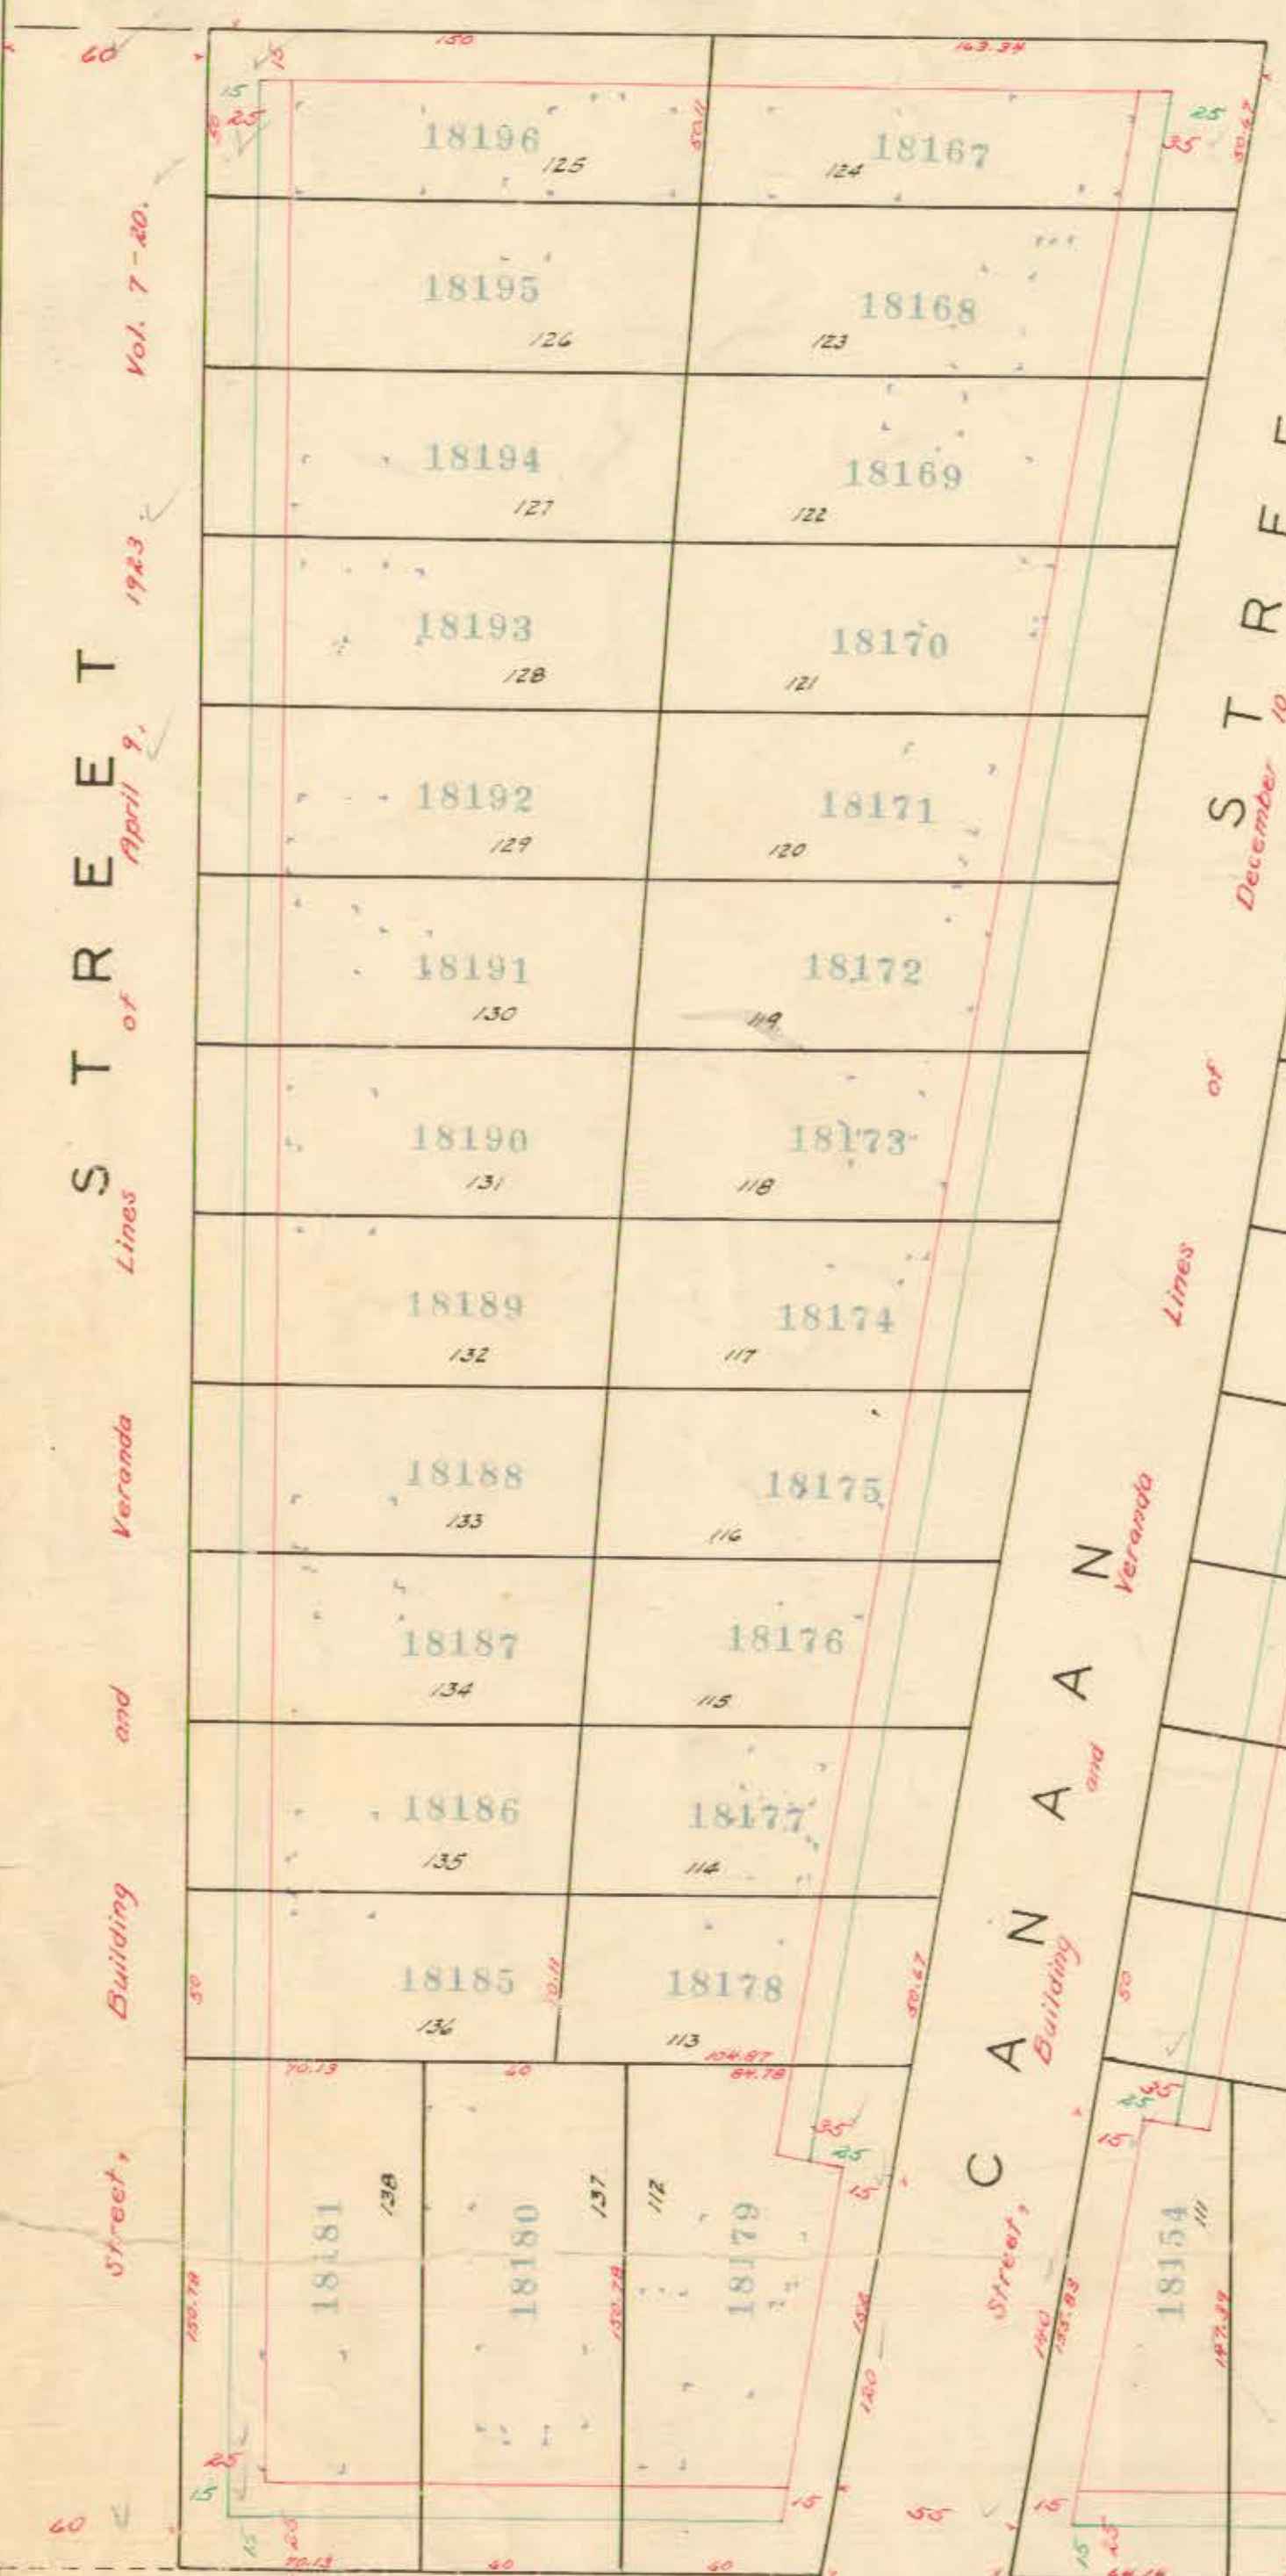

CANNAN STREET


See Sheet 182

TOWER Street, Building and Veranda Lines of

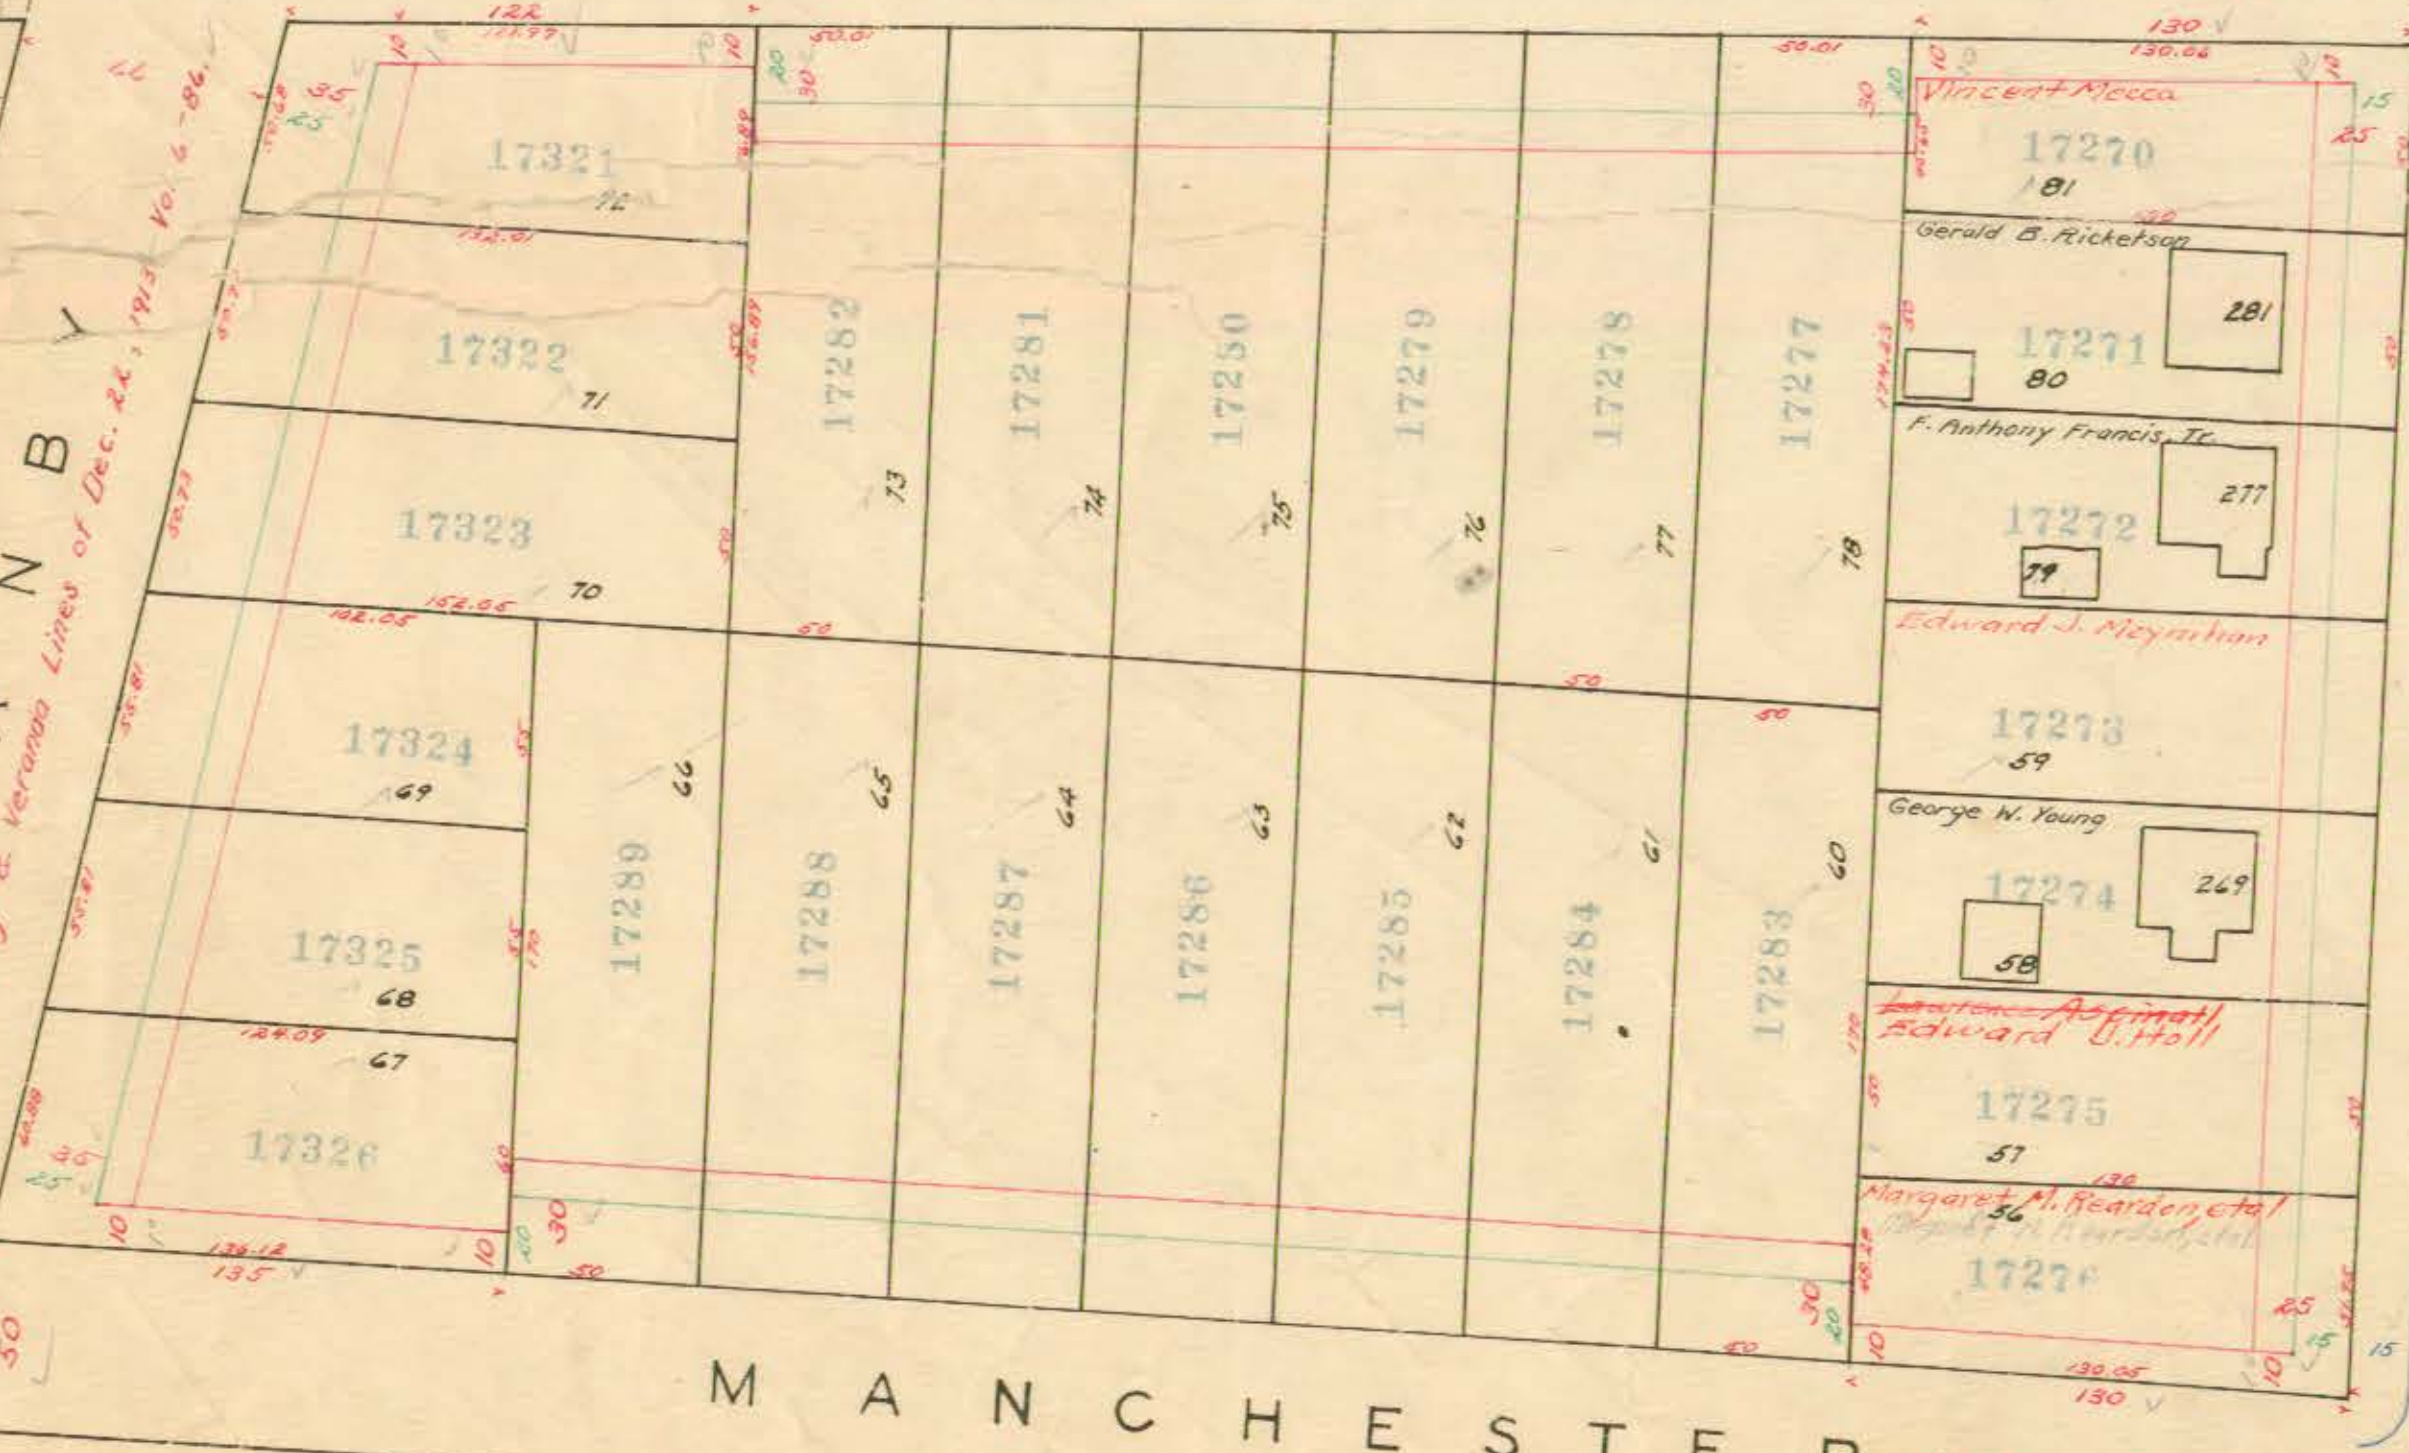


MANCHESTER Street, Building

See

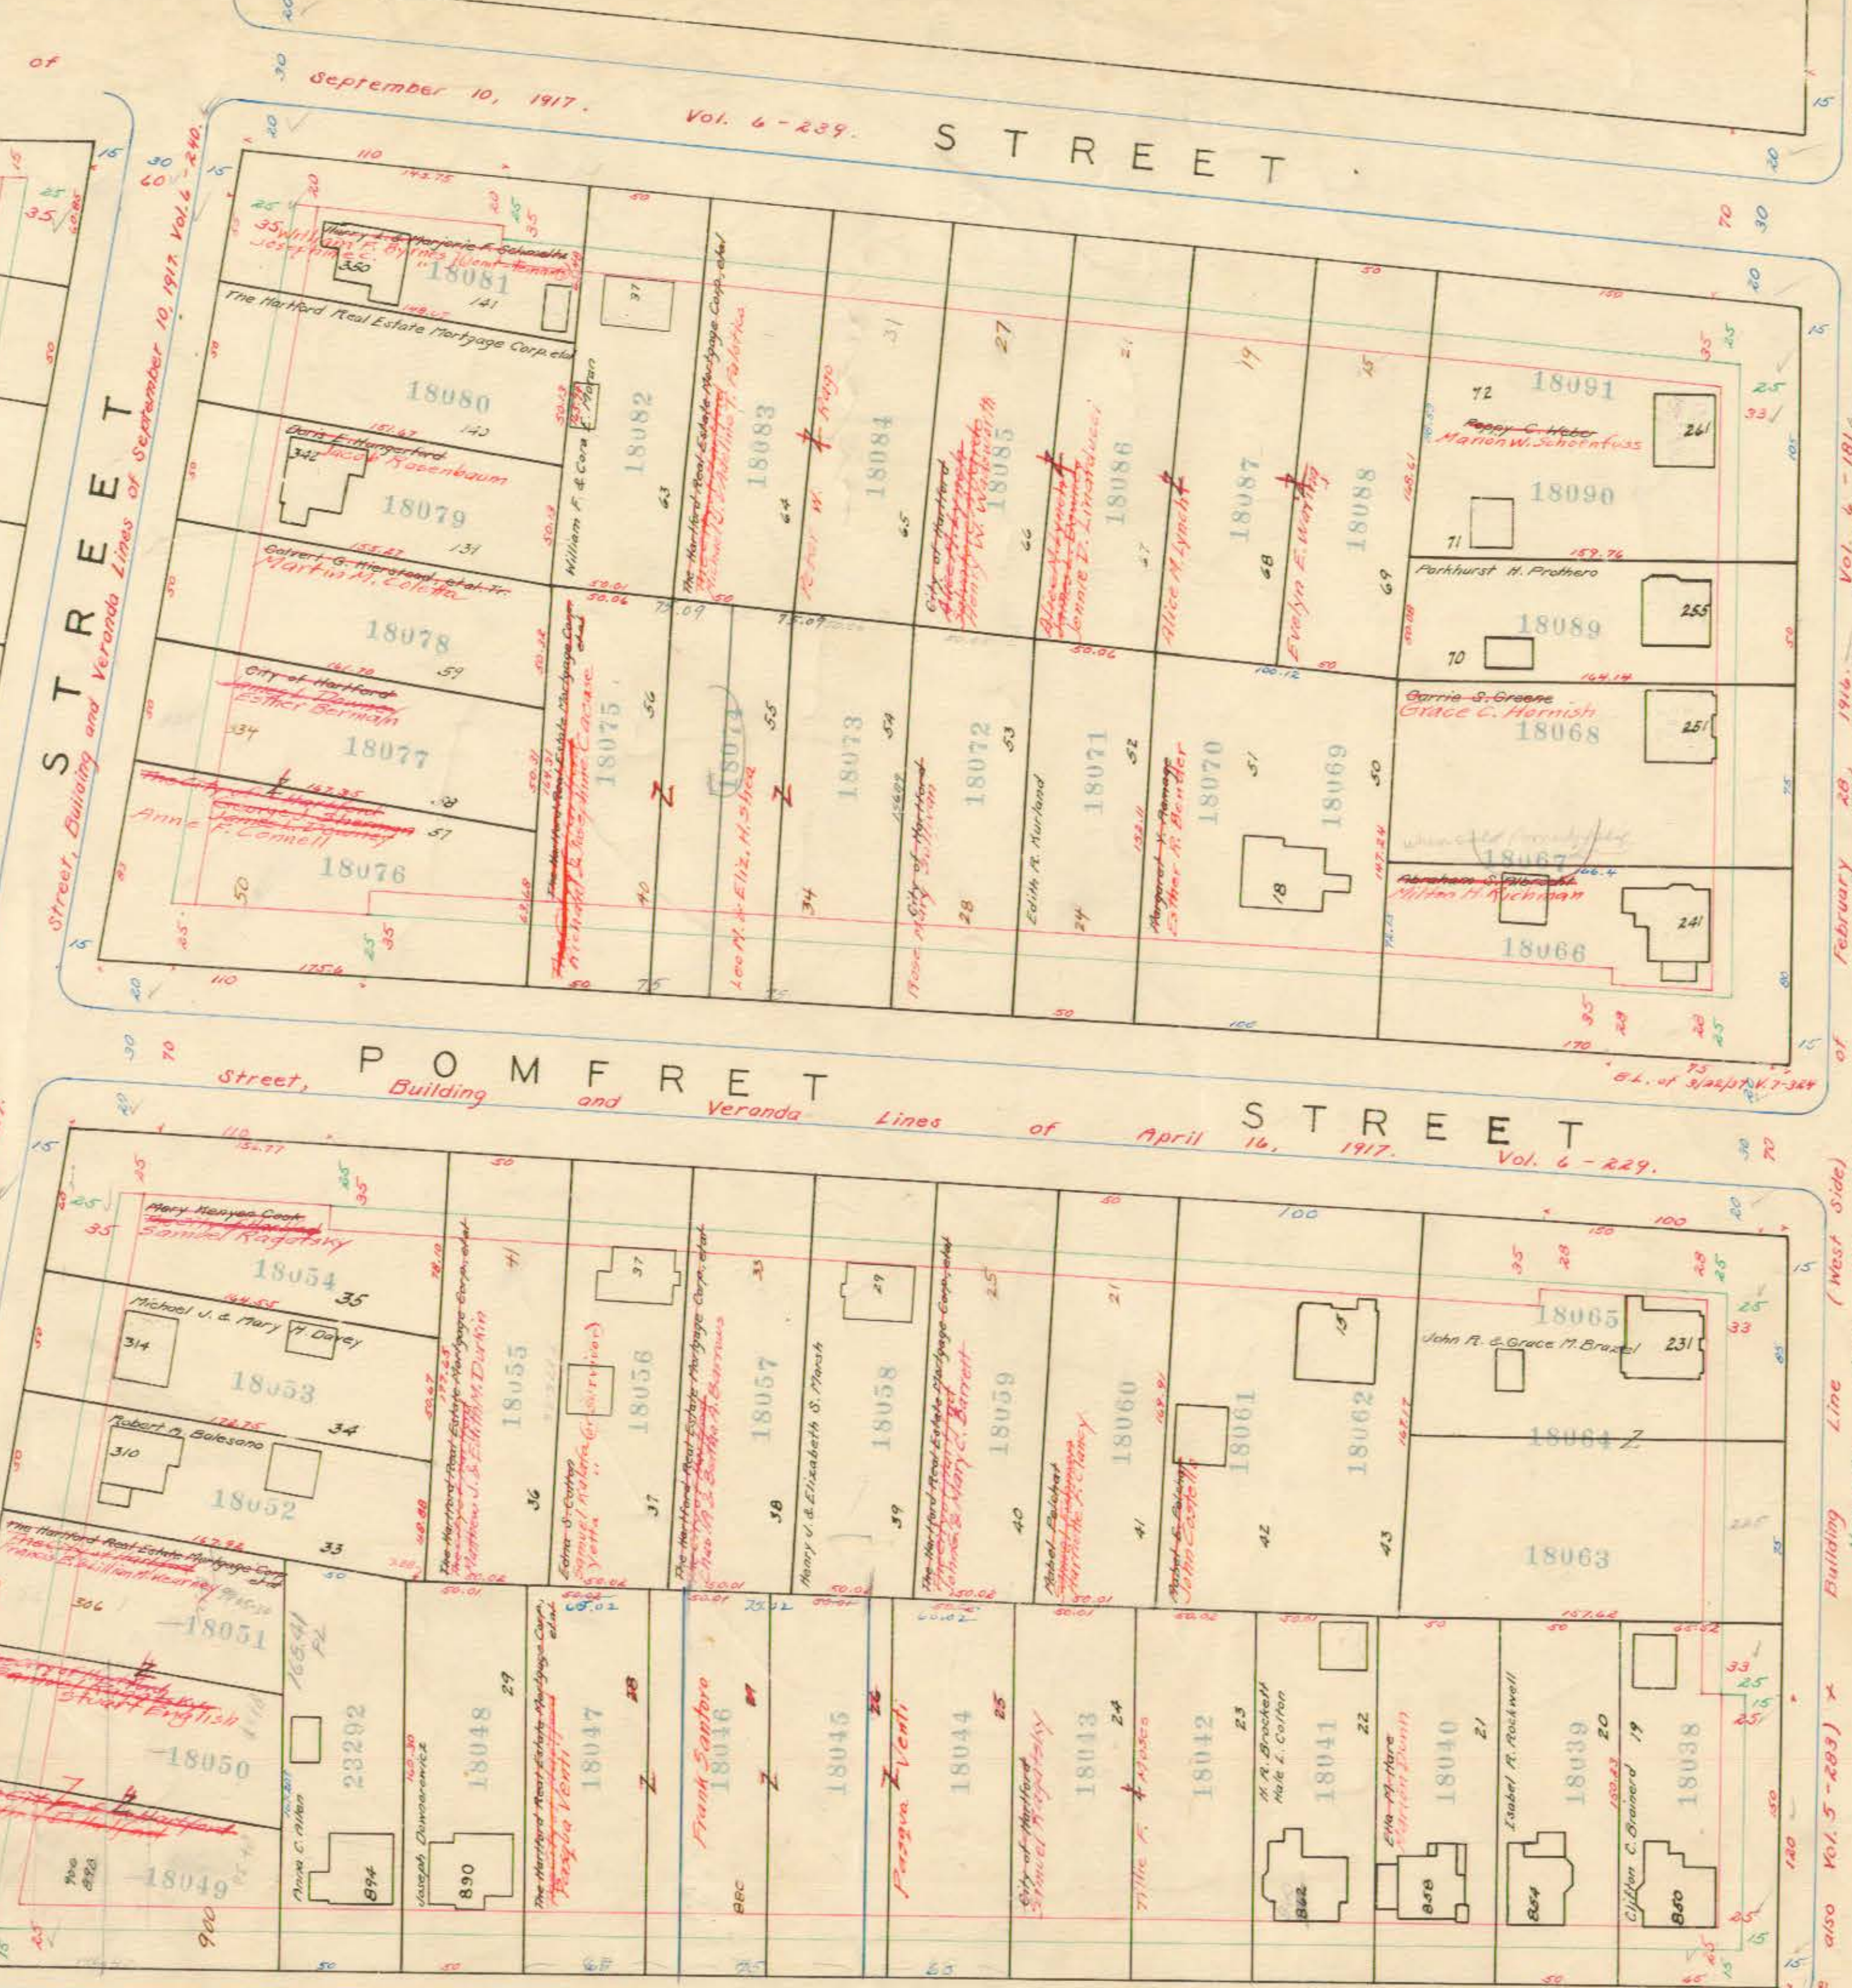

POMFRET Street, Building and Veranda Lines of

STREET

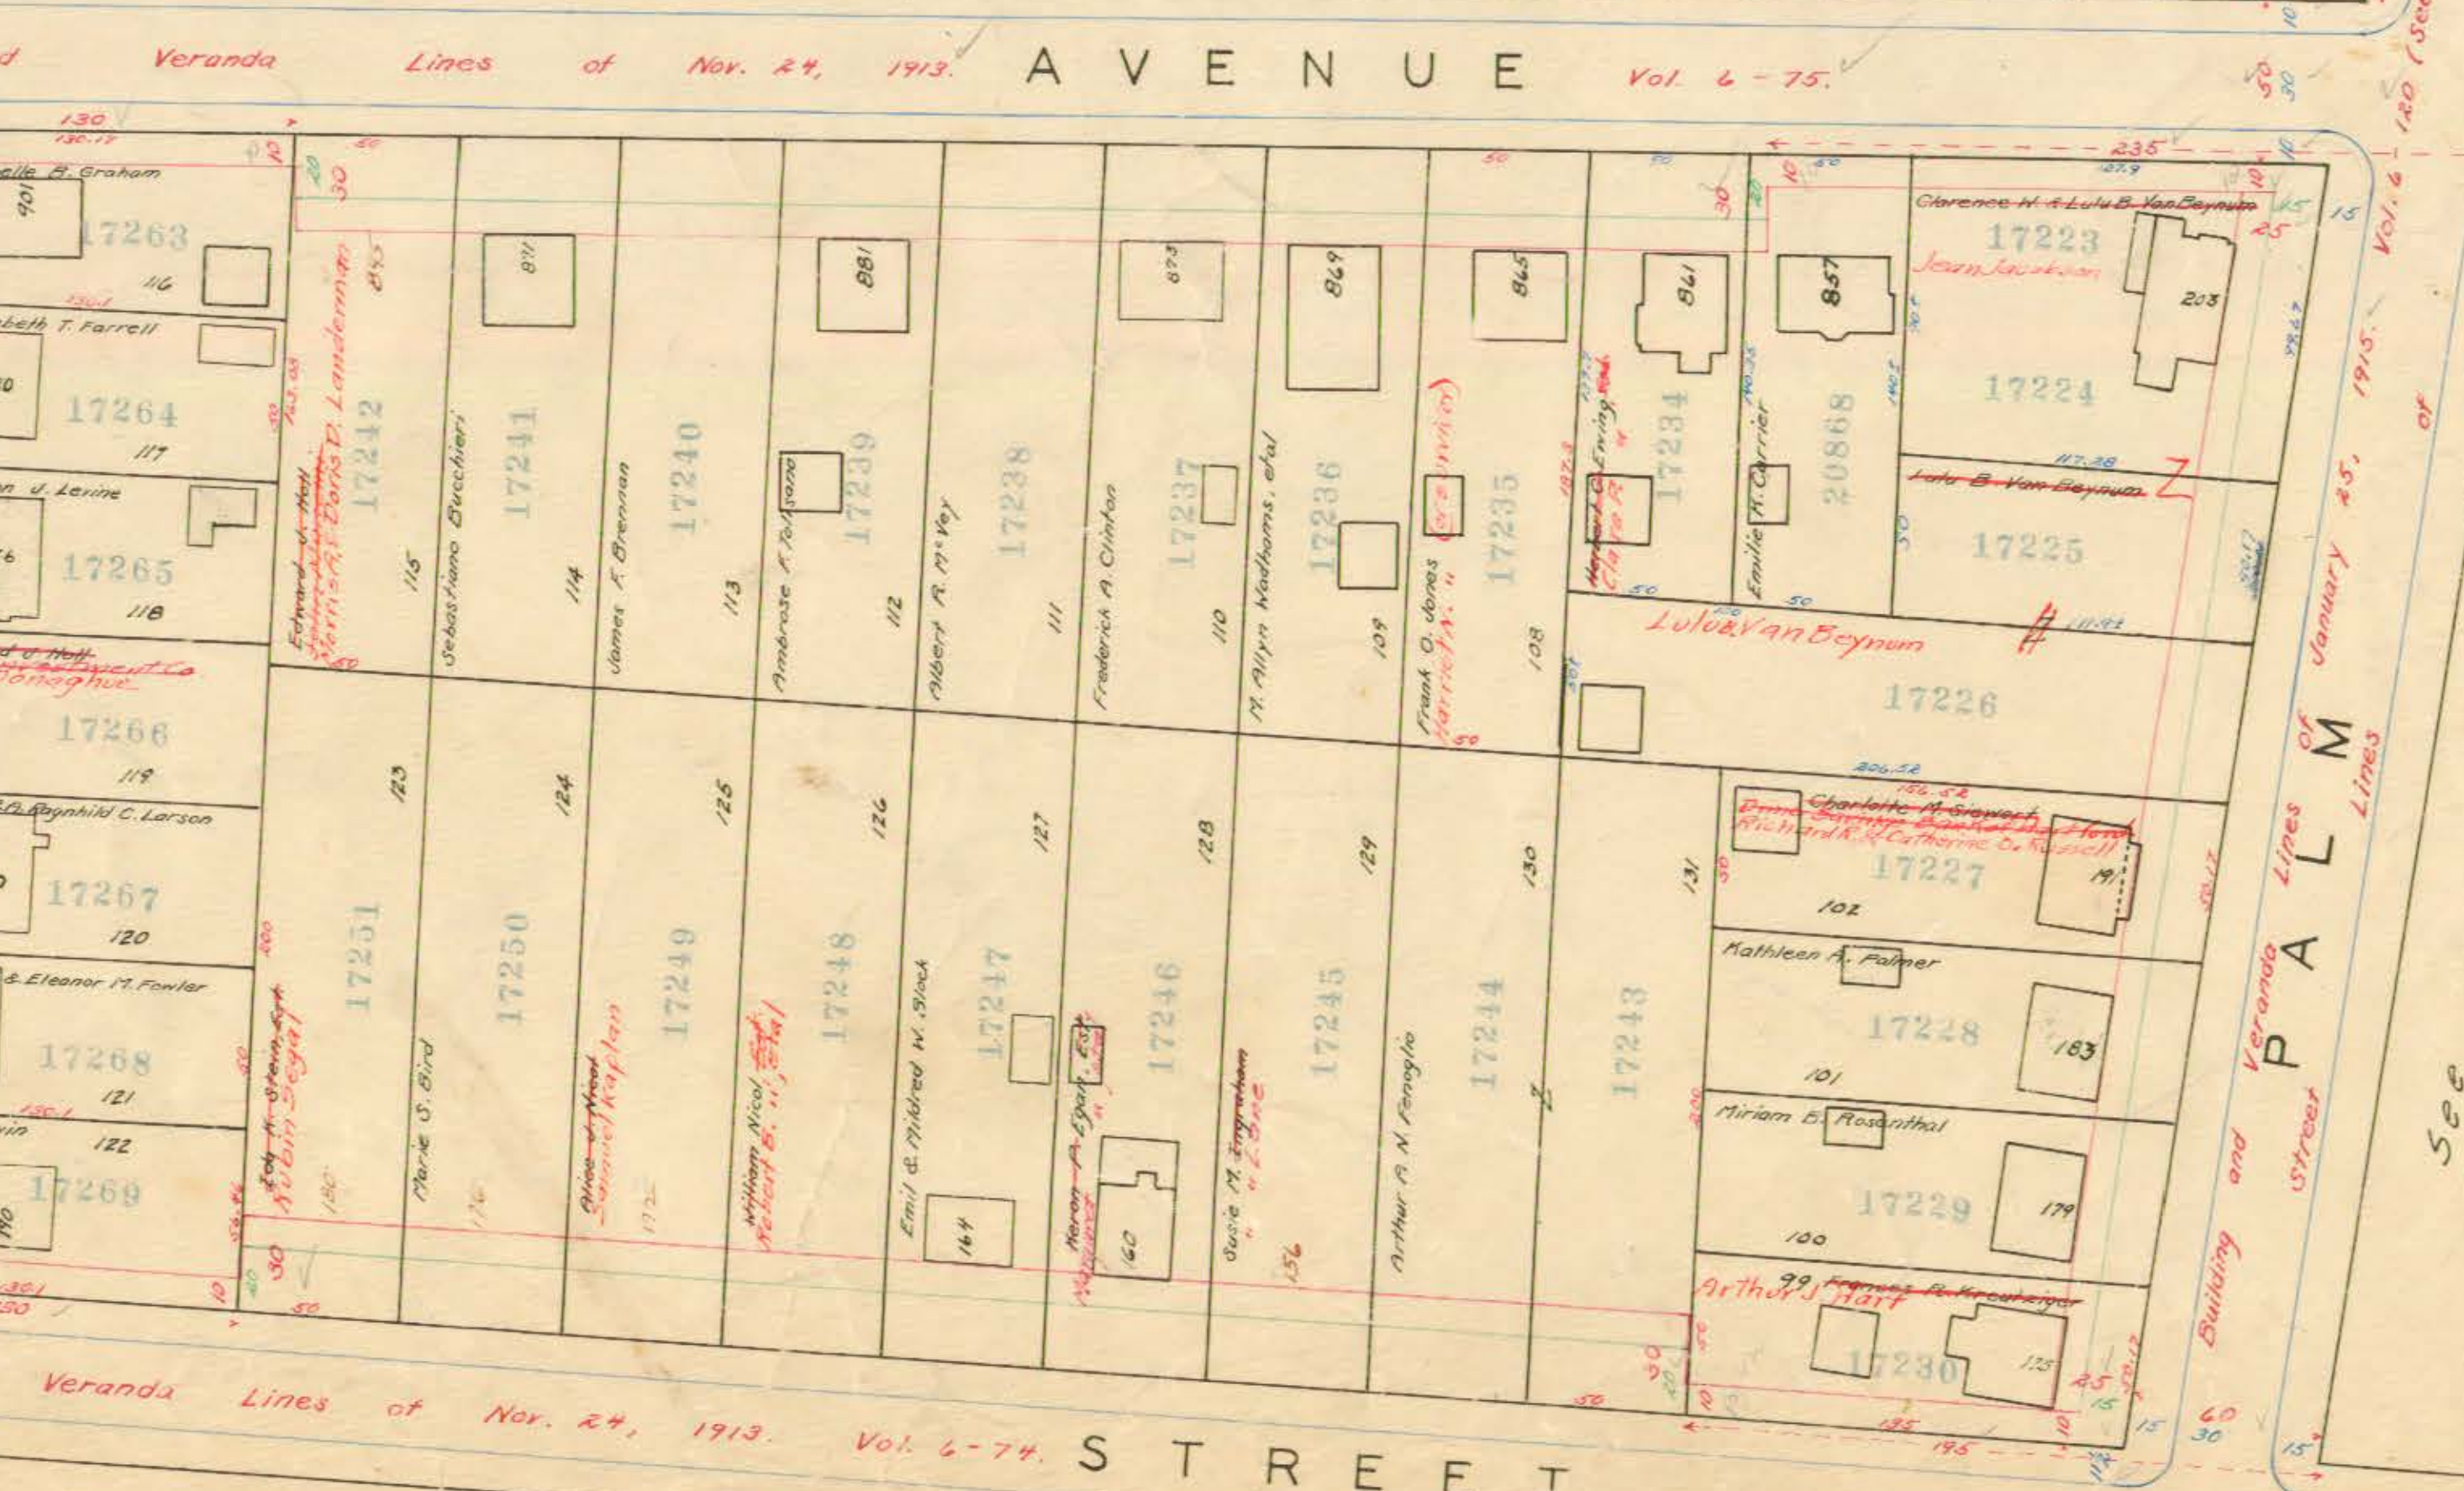

MANCHESTER Street, Building

See

See Sheet 176

See Sheet 175