
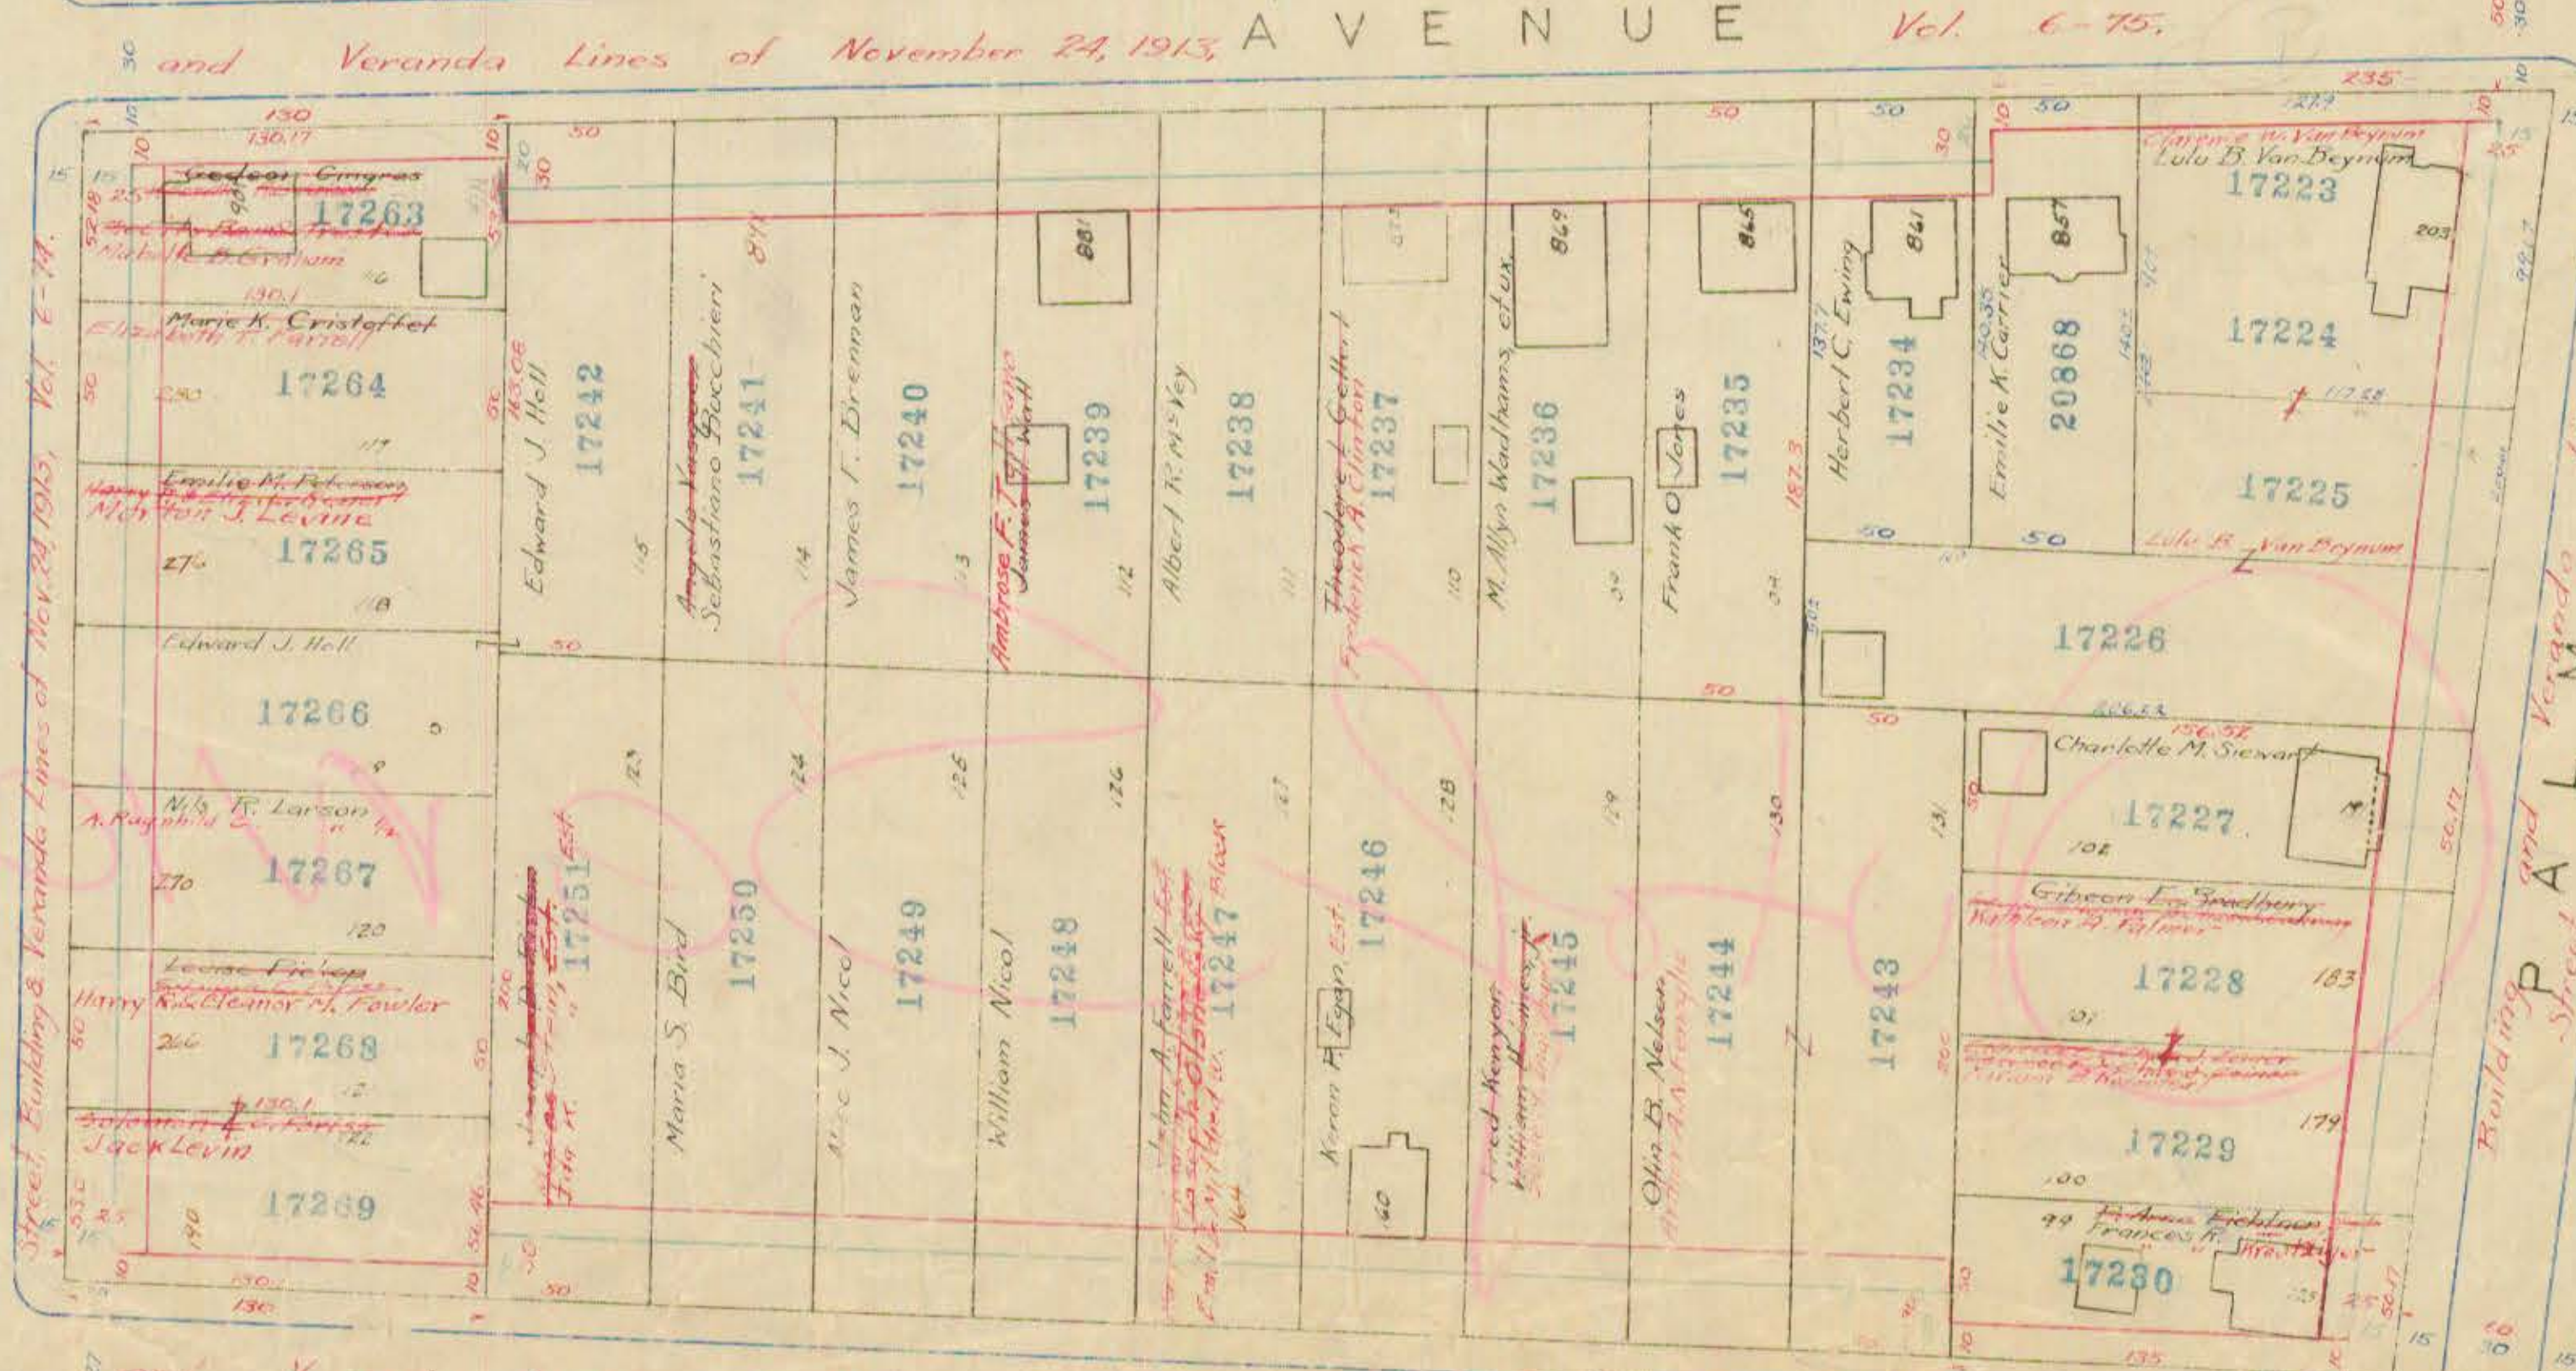
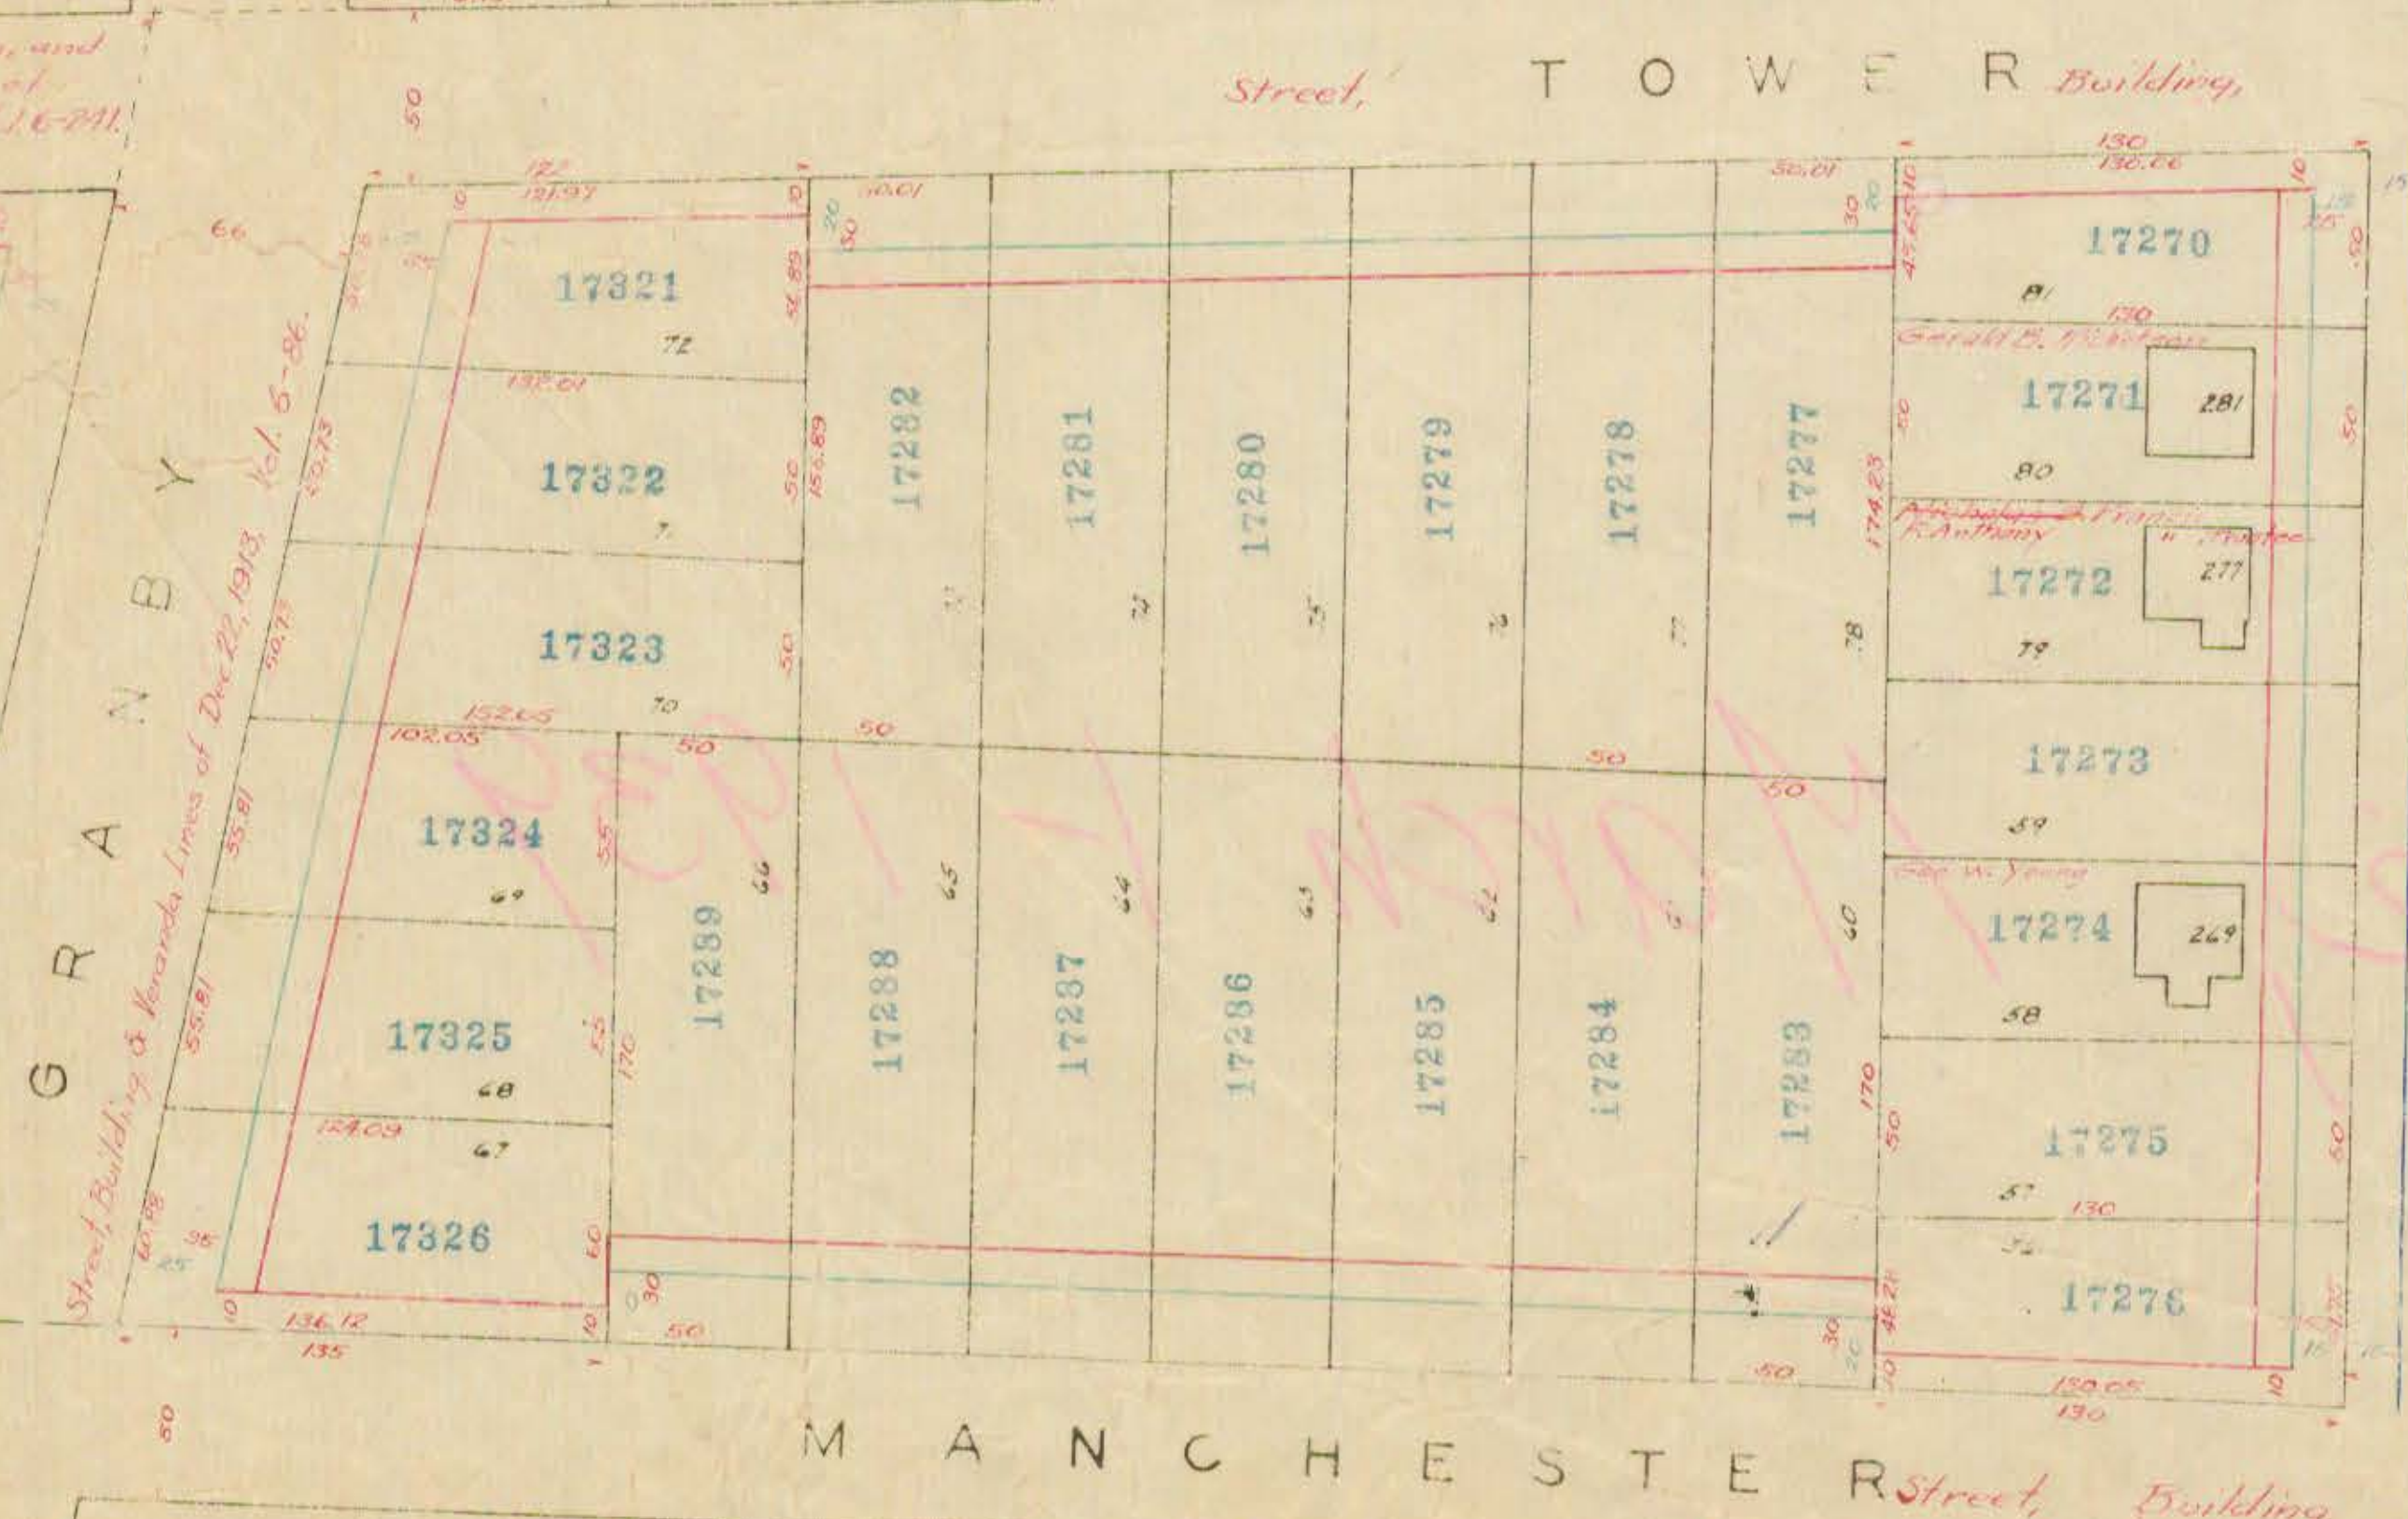
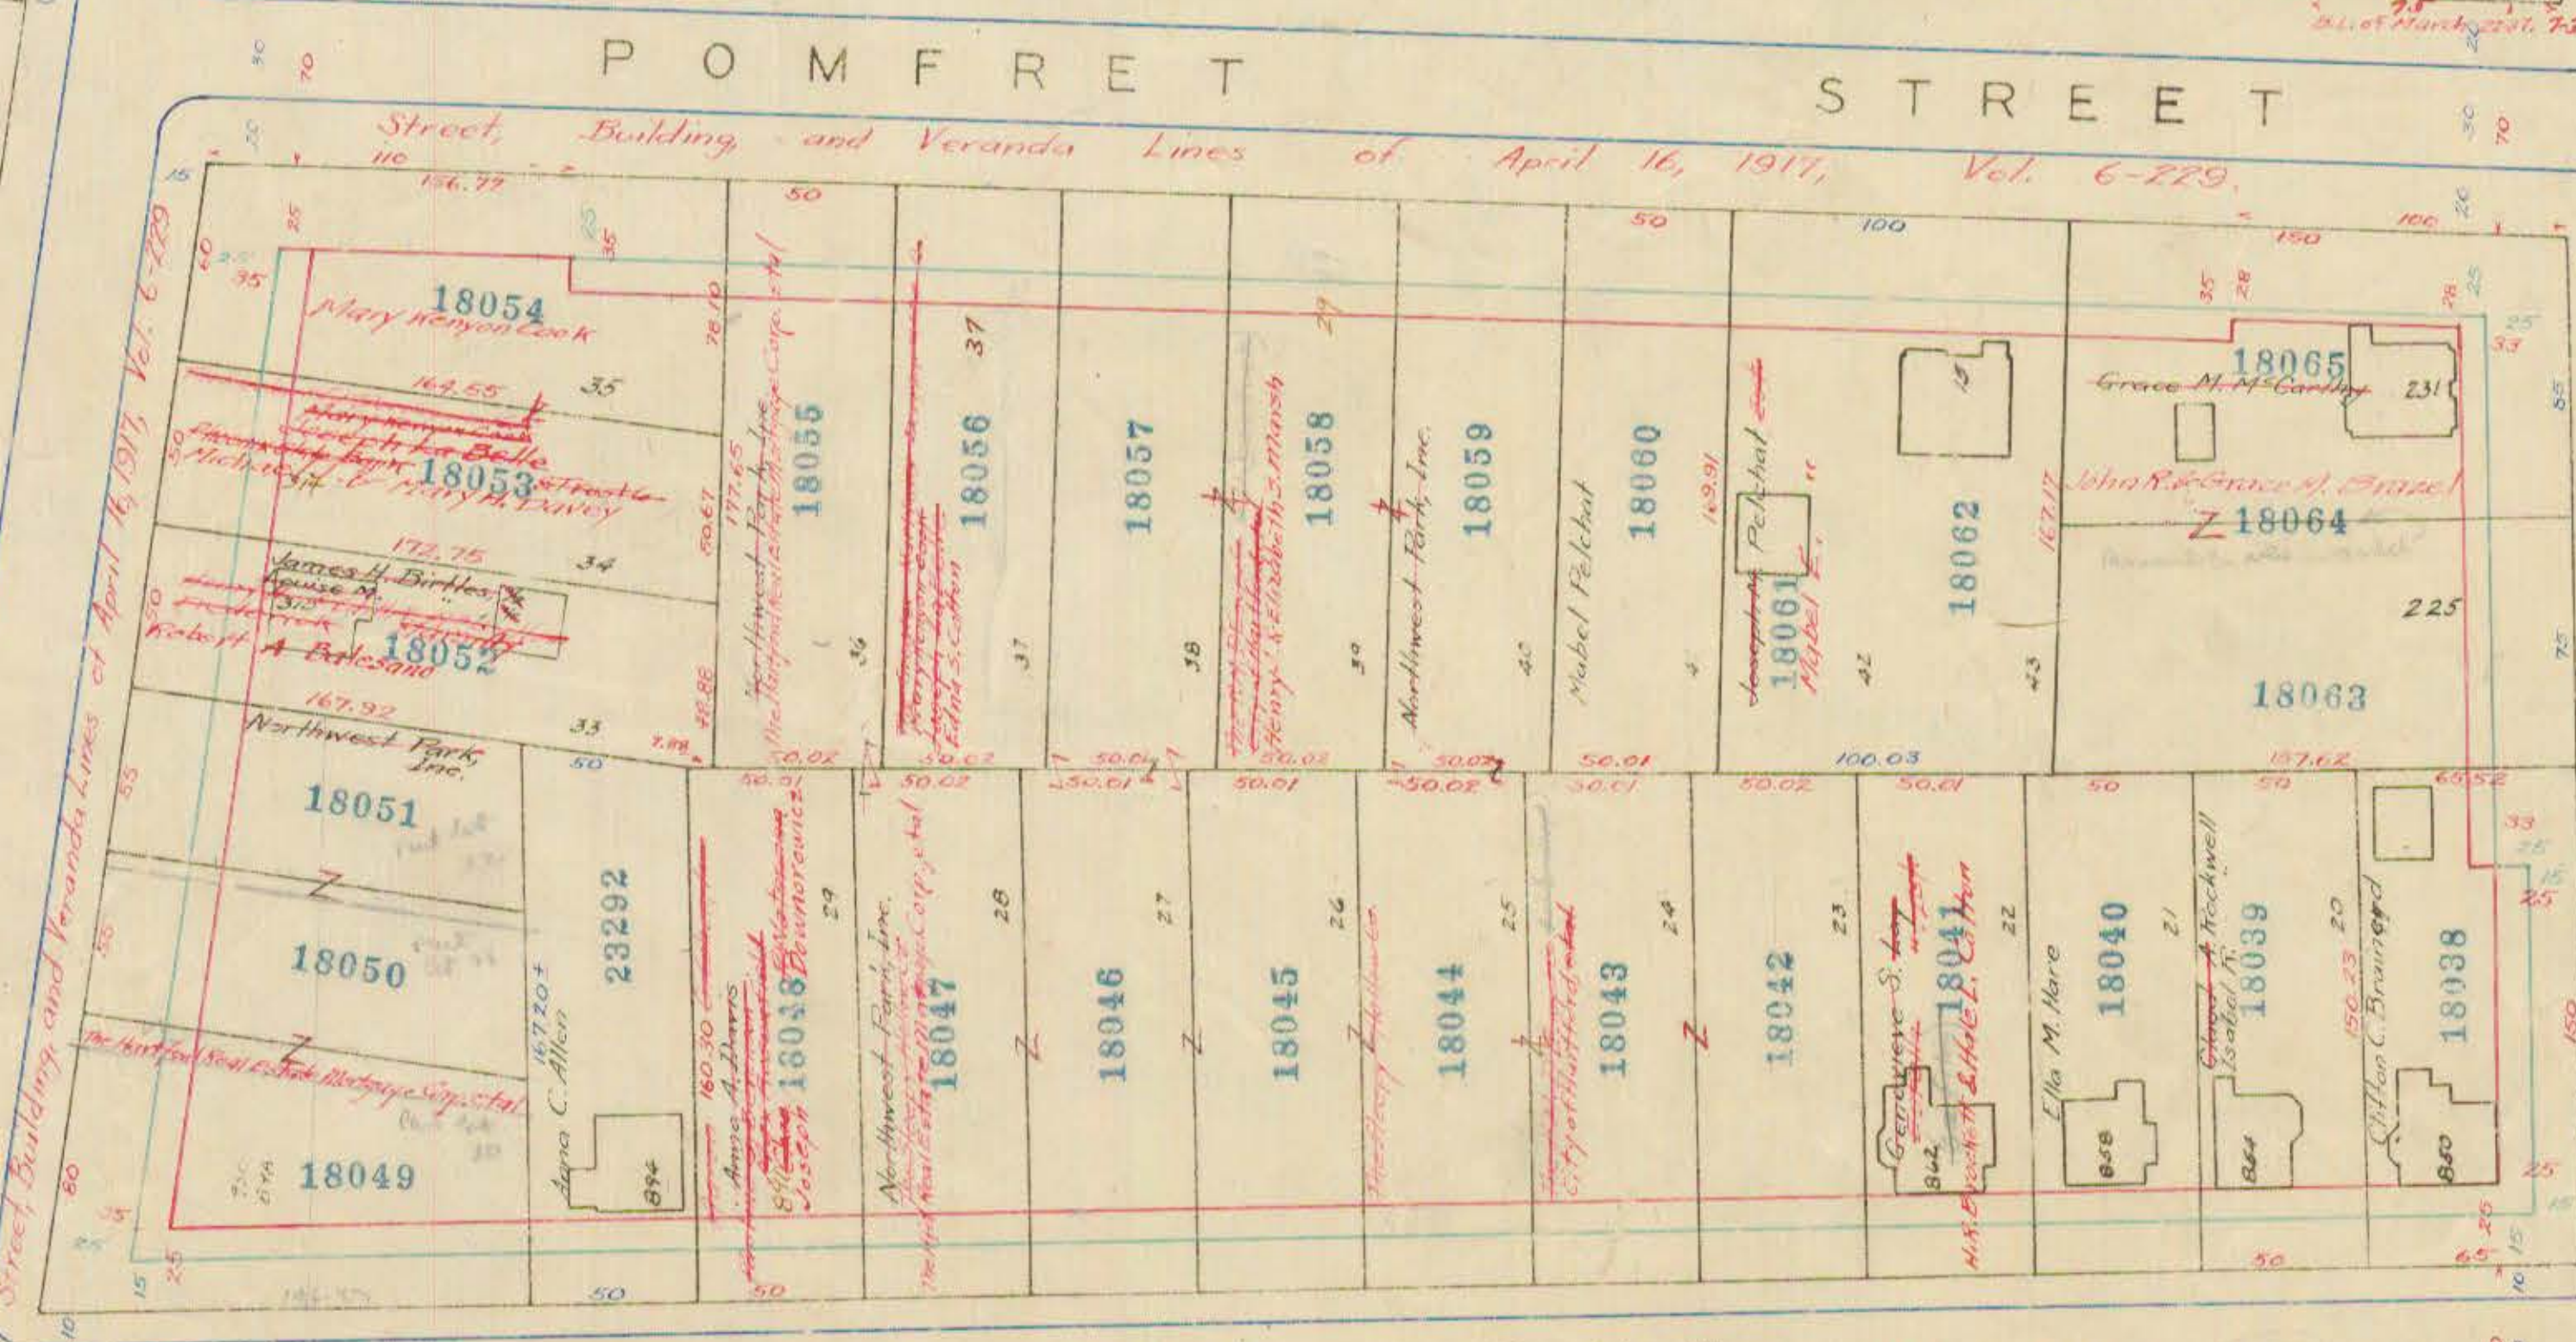
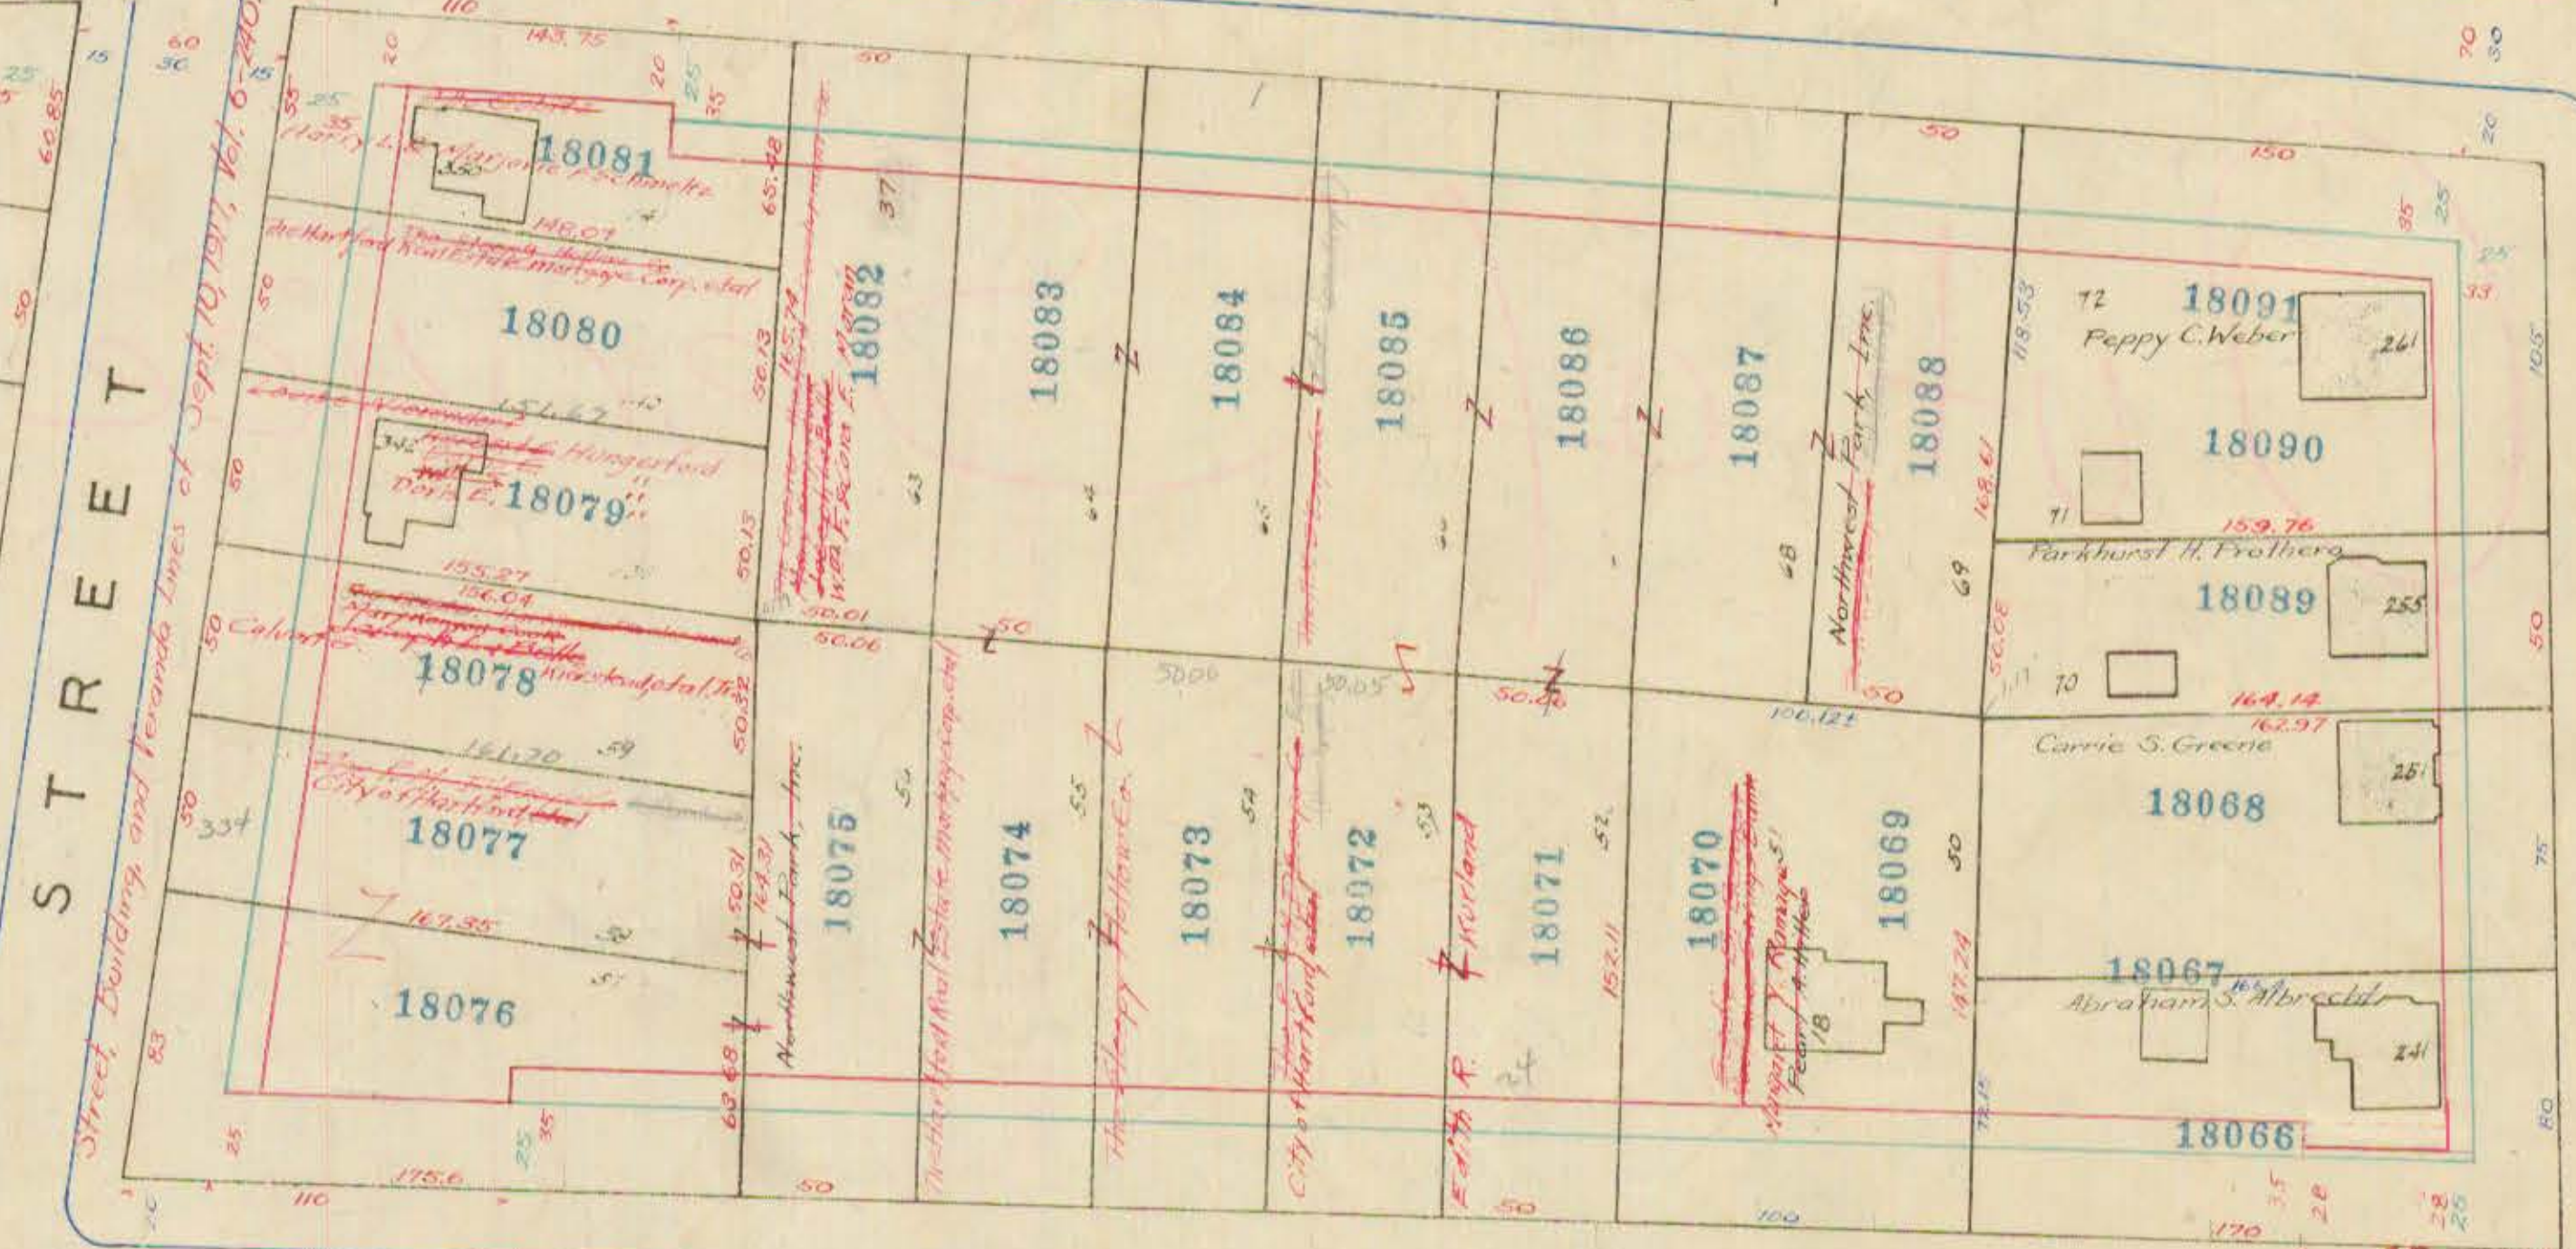



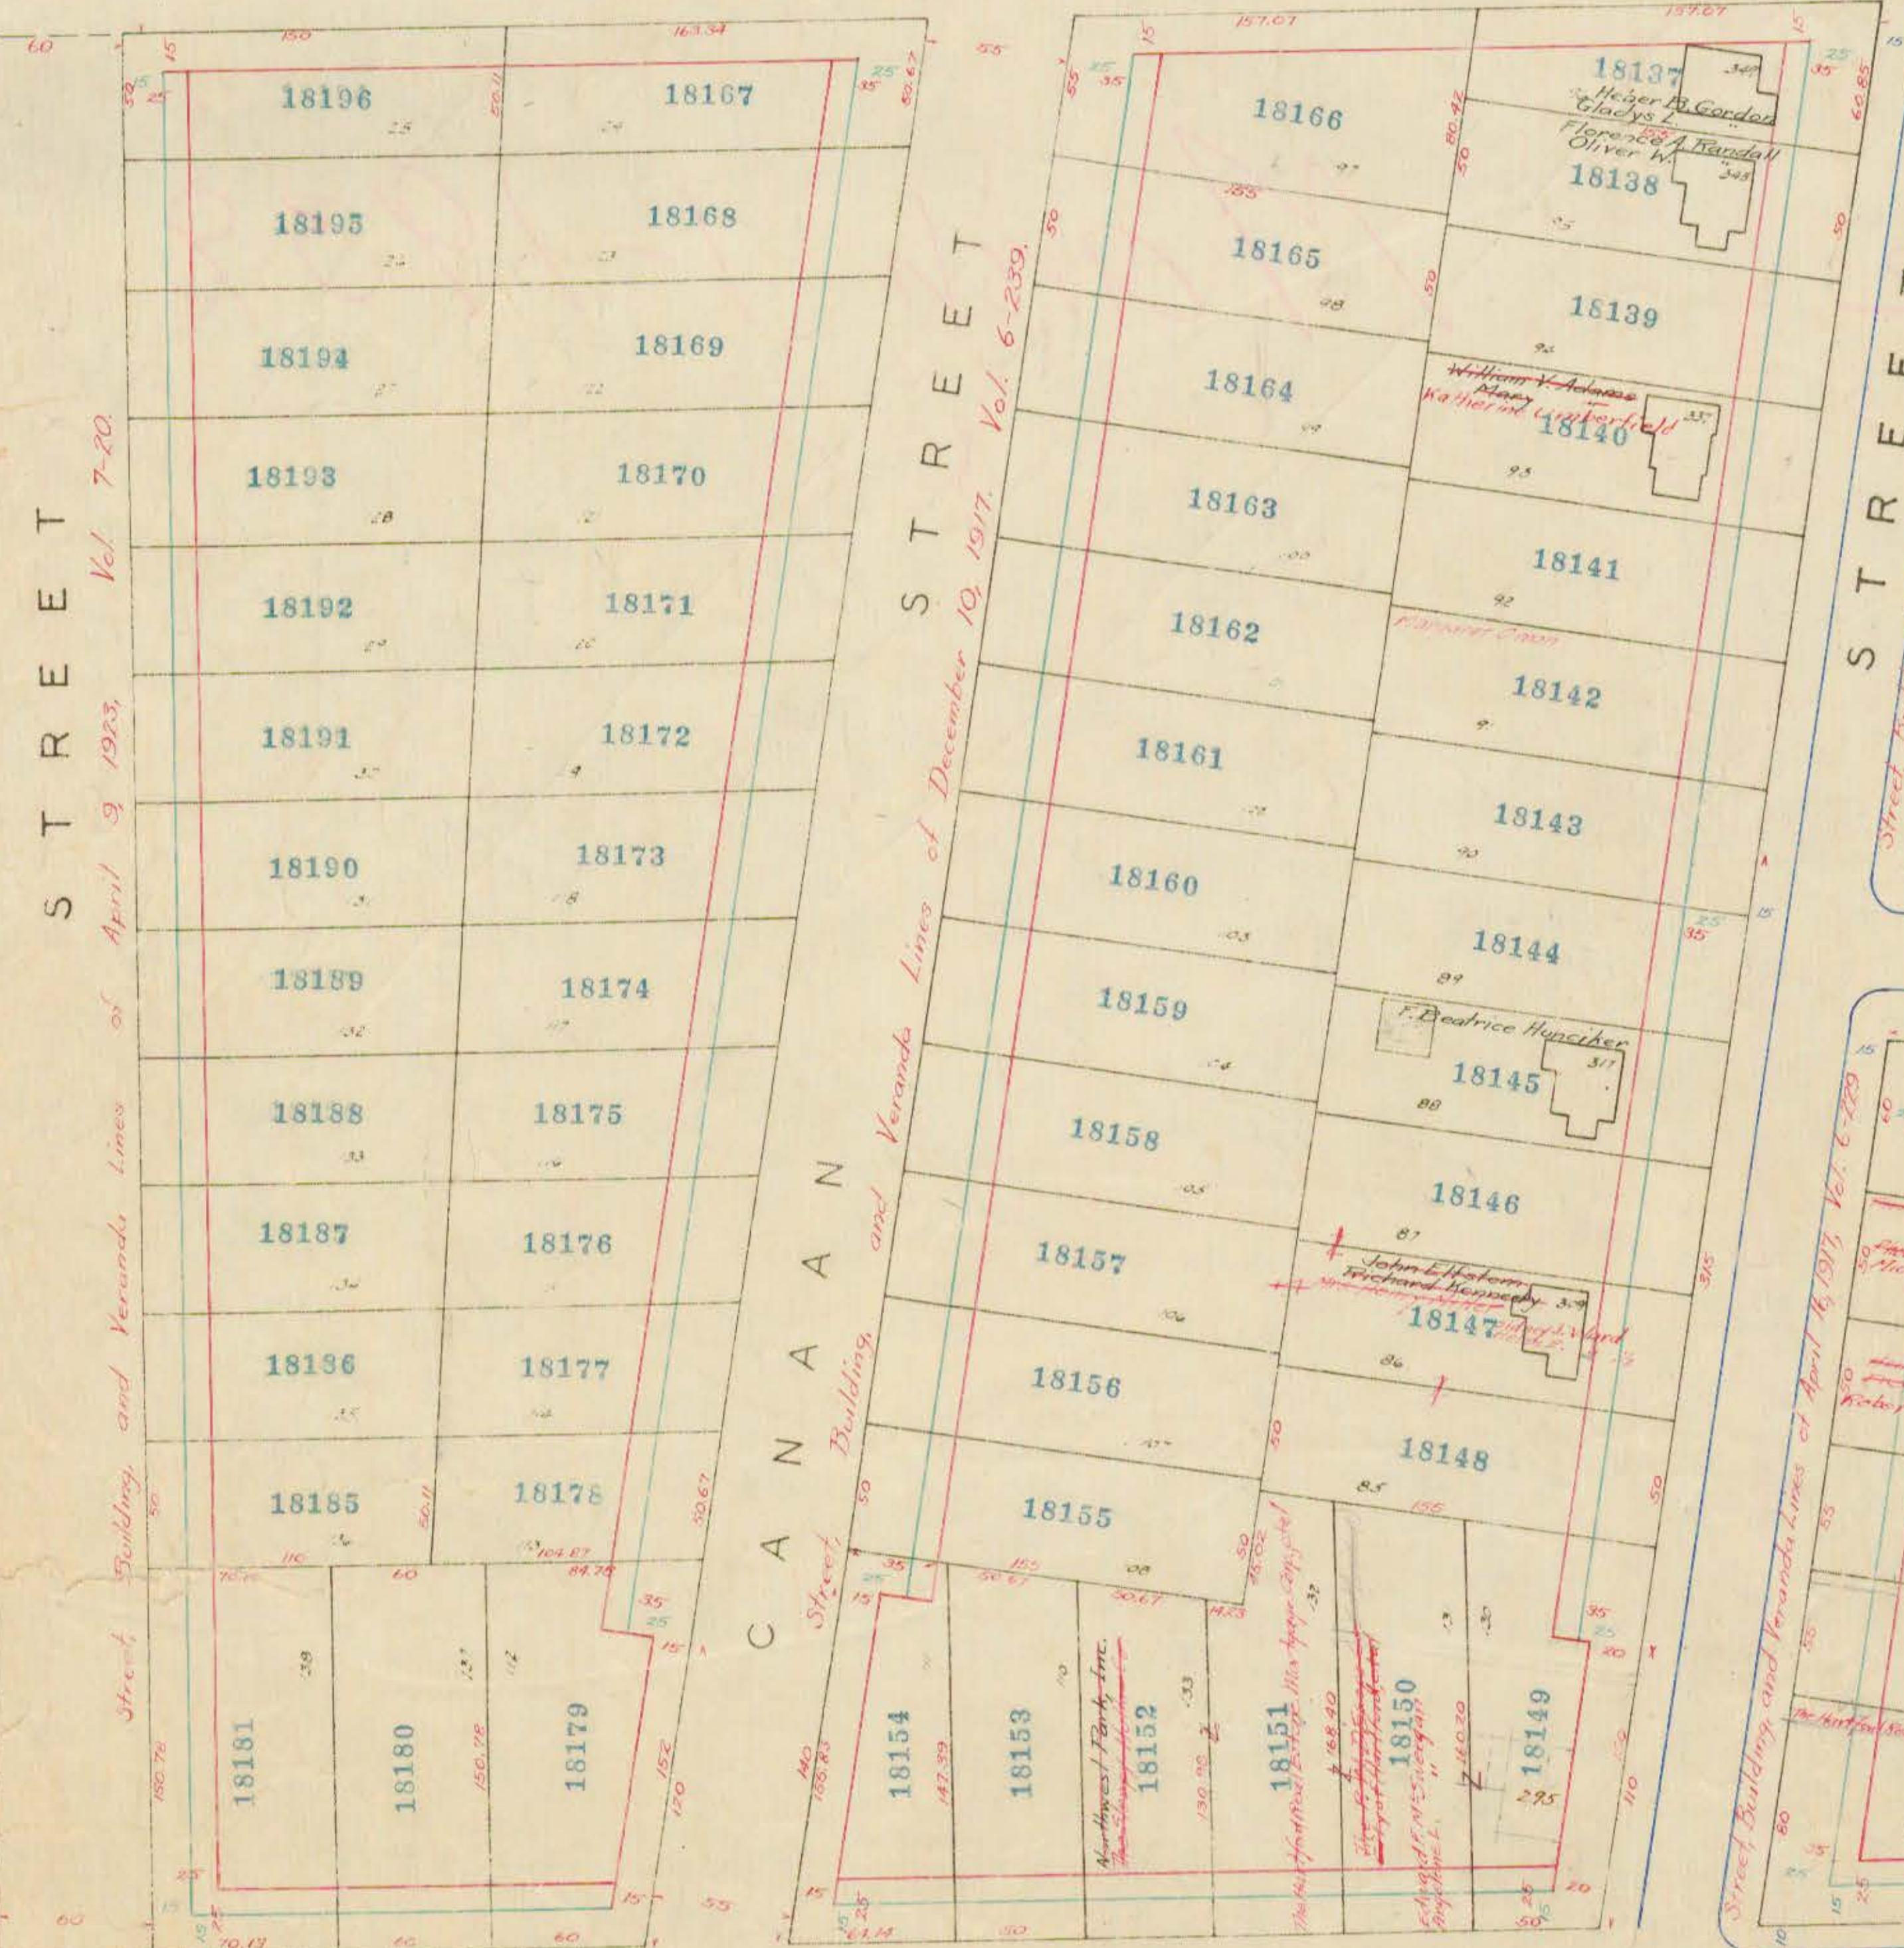

Building Line (was note) 1976, Vol. 6, 181.
 T R E S T Vol. 6, 157.
 (see also Vol. 5, 283.)

January	23	1913	15	Rev.	10

10

out of Service, March 1-1939


Supersedes part of 94

178 (