

1100 1000 900 800 700 600 500 400 300 200 100 0

HARBISON AVENUE V.M. 4 P. 326

Scale - 1" Horiz. = 50'
1" Vert. = 10'


B.M. 572 - S.E. Cor. of W.T. of Brick House
on N.W. Cor. of Harbison Ave. & Zion St.
Elev. 109.47

Cut 1 1/2 out
4 in 5 out

Rep 226
51

Note New Profile to be Made 1977

2-11-1977
Rep 226

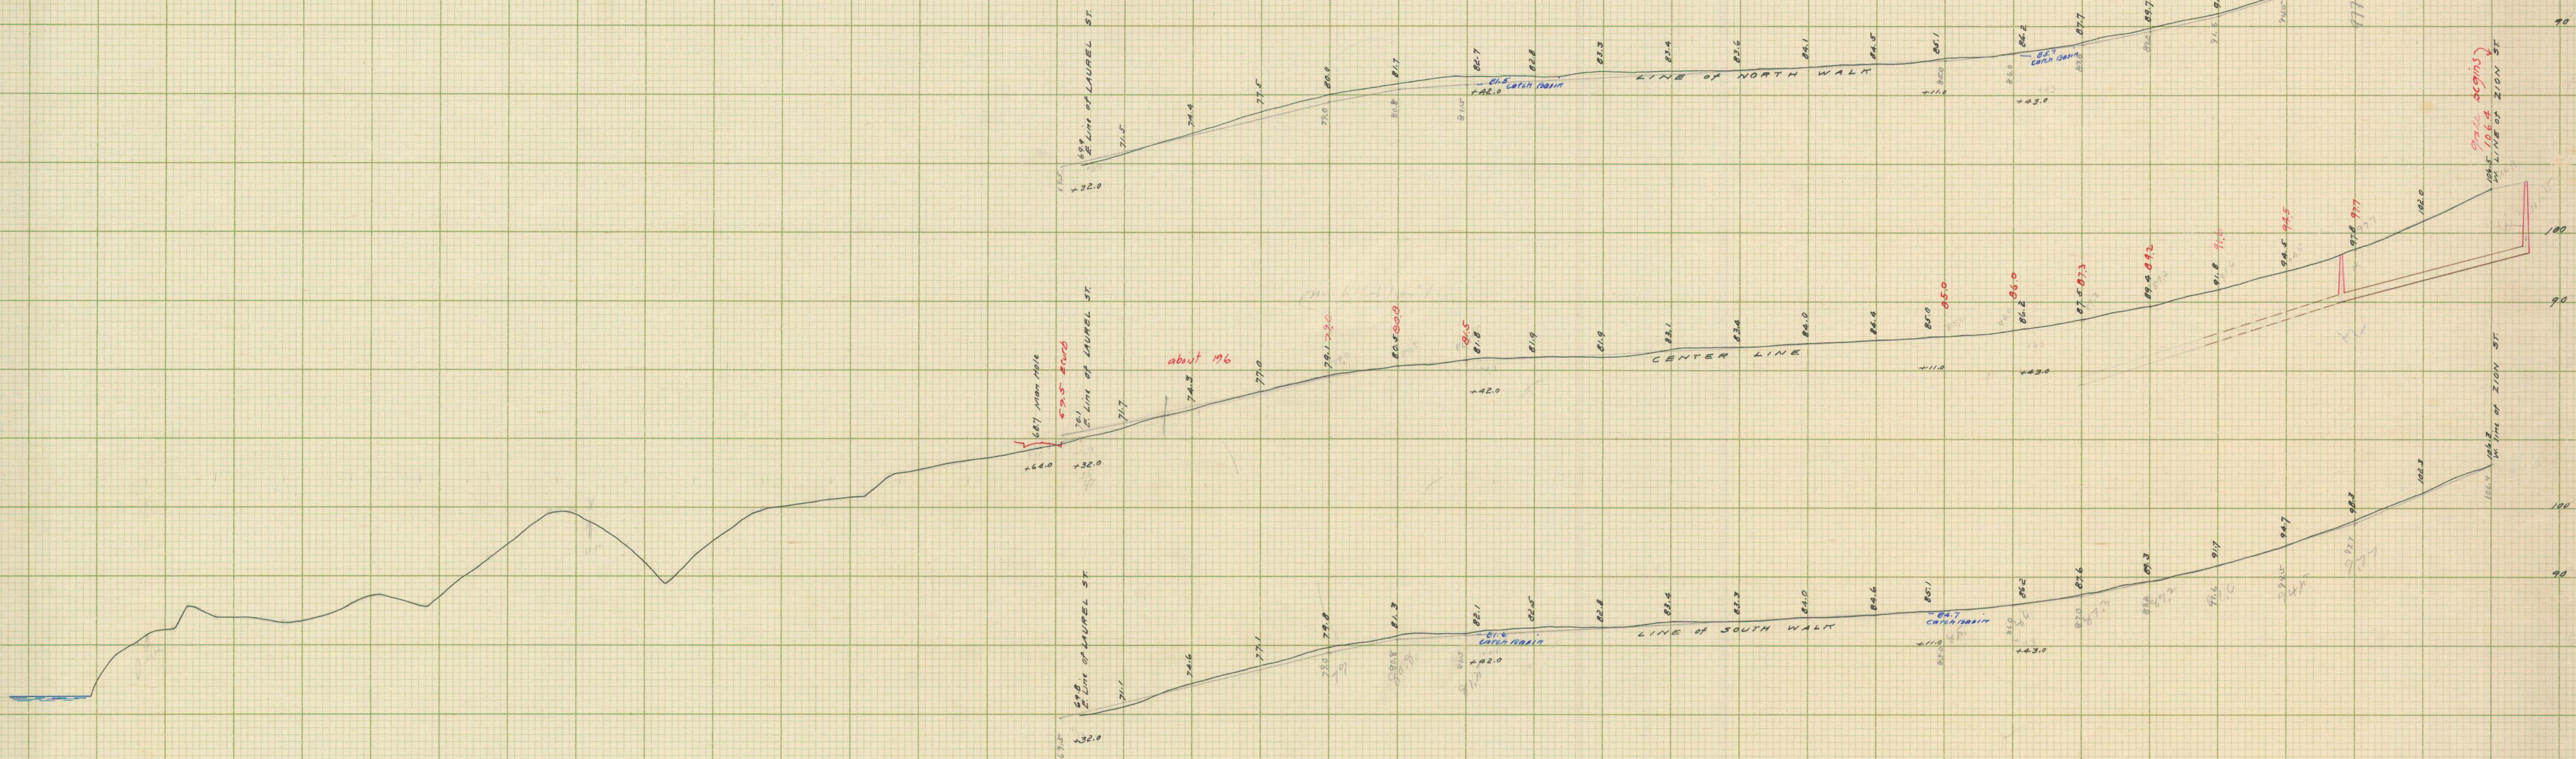

CITY ENGINEER'S OFFICE
HARTFORD, CONN.
MISCELLANEOUS DEPT.
Day Book No. 0785
77-77
City Engineer