


Out of Service on

TOWN OF BLOOMFIELD

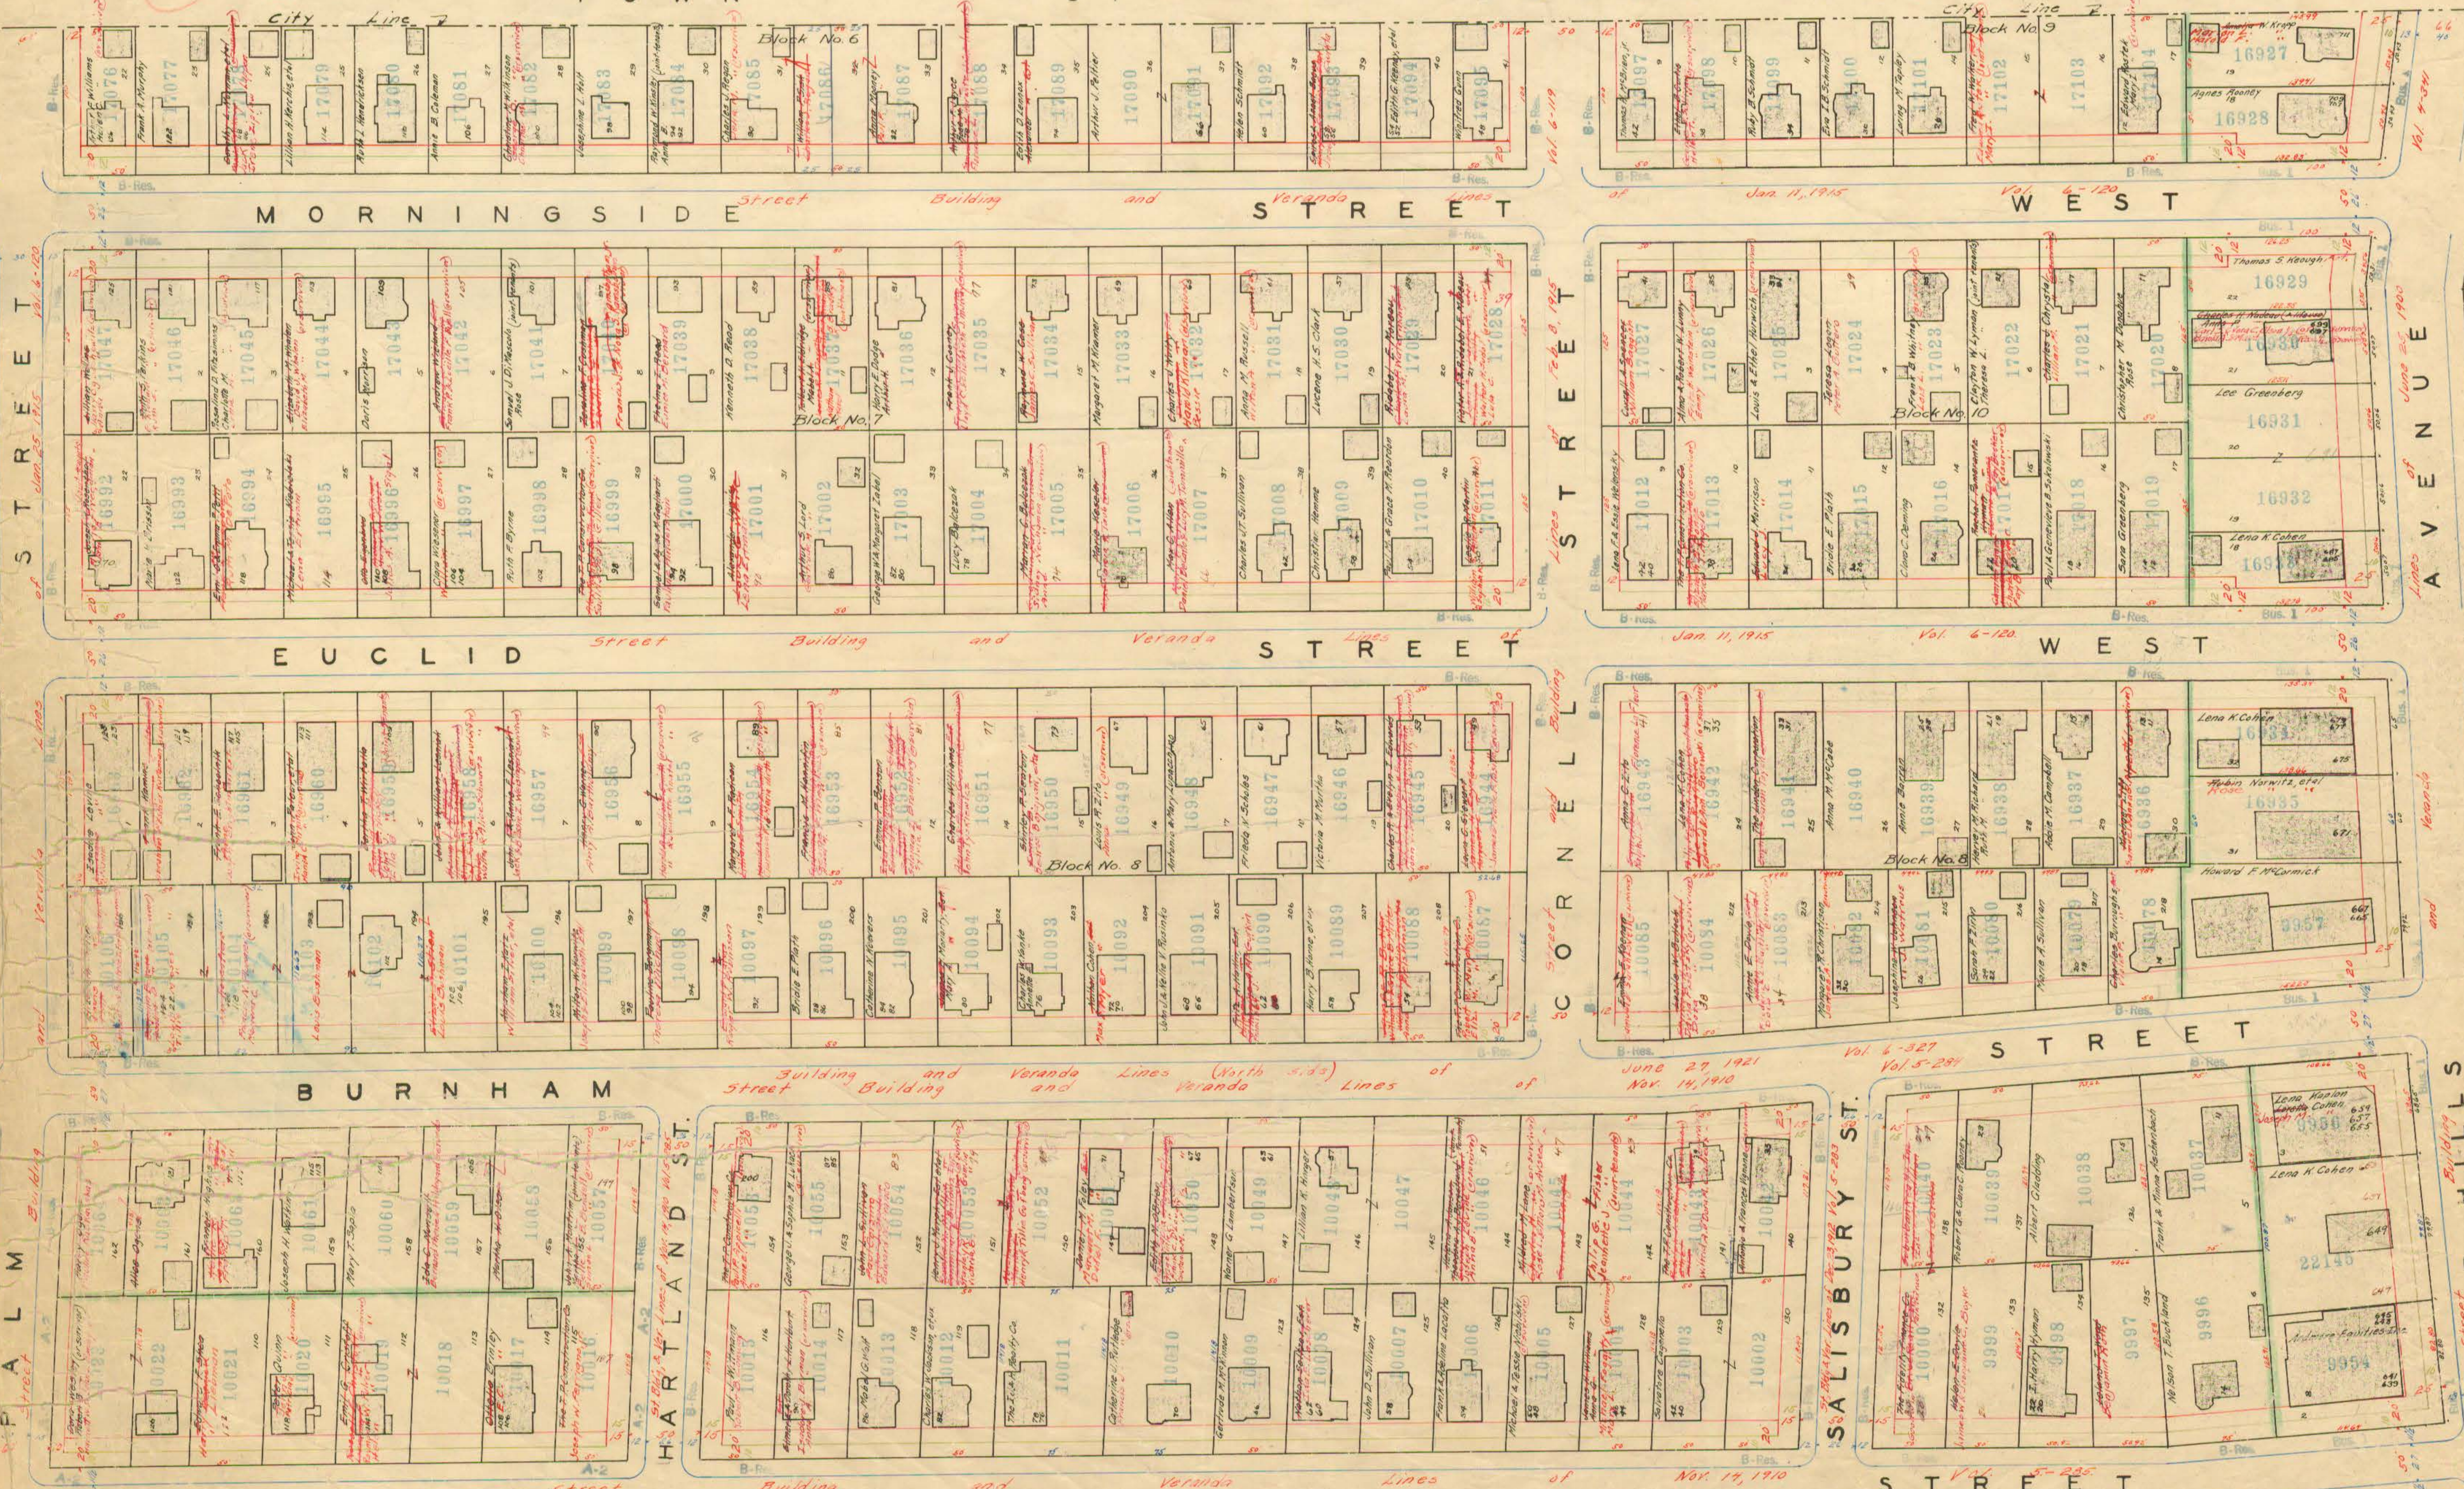

March

Sheet 176

10,

CORNWALL STREET

1954

Sheet 174