


TOWN OF BLOOMFIELD

Part of service May 18, 1944

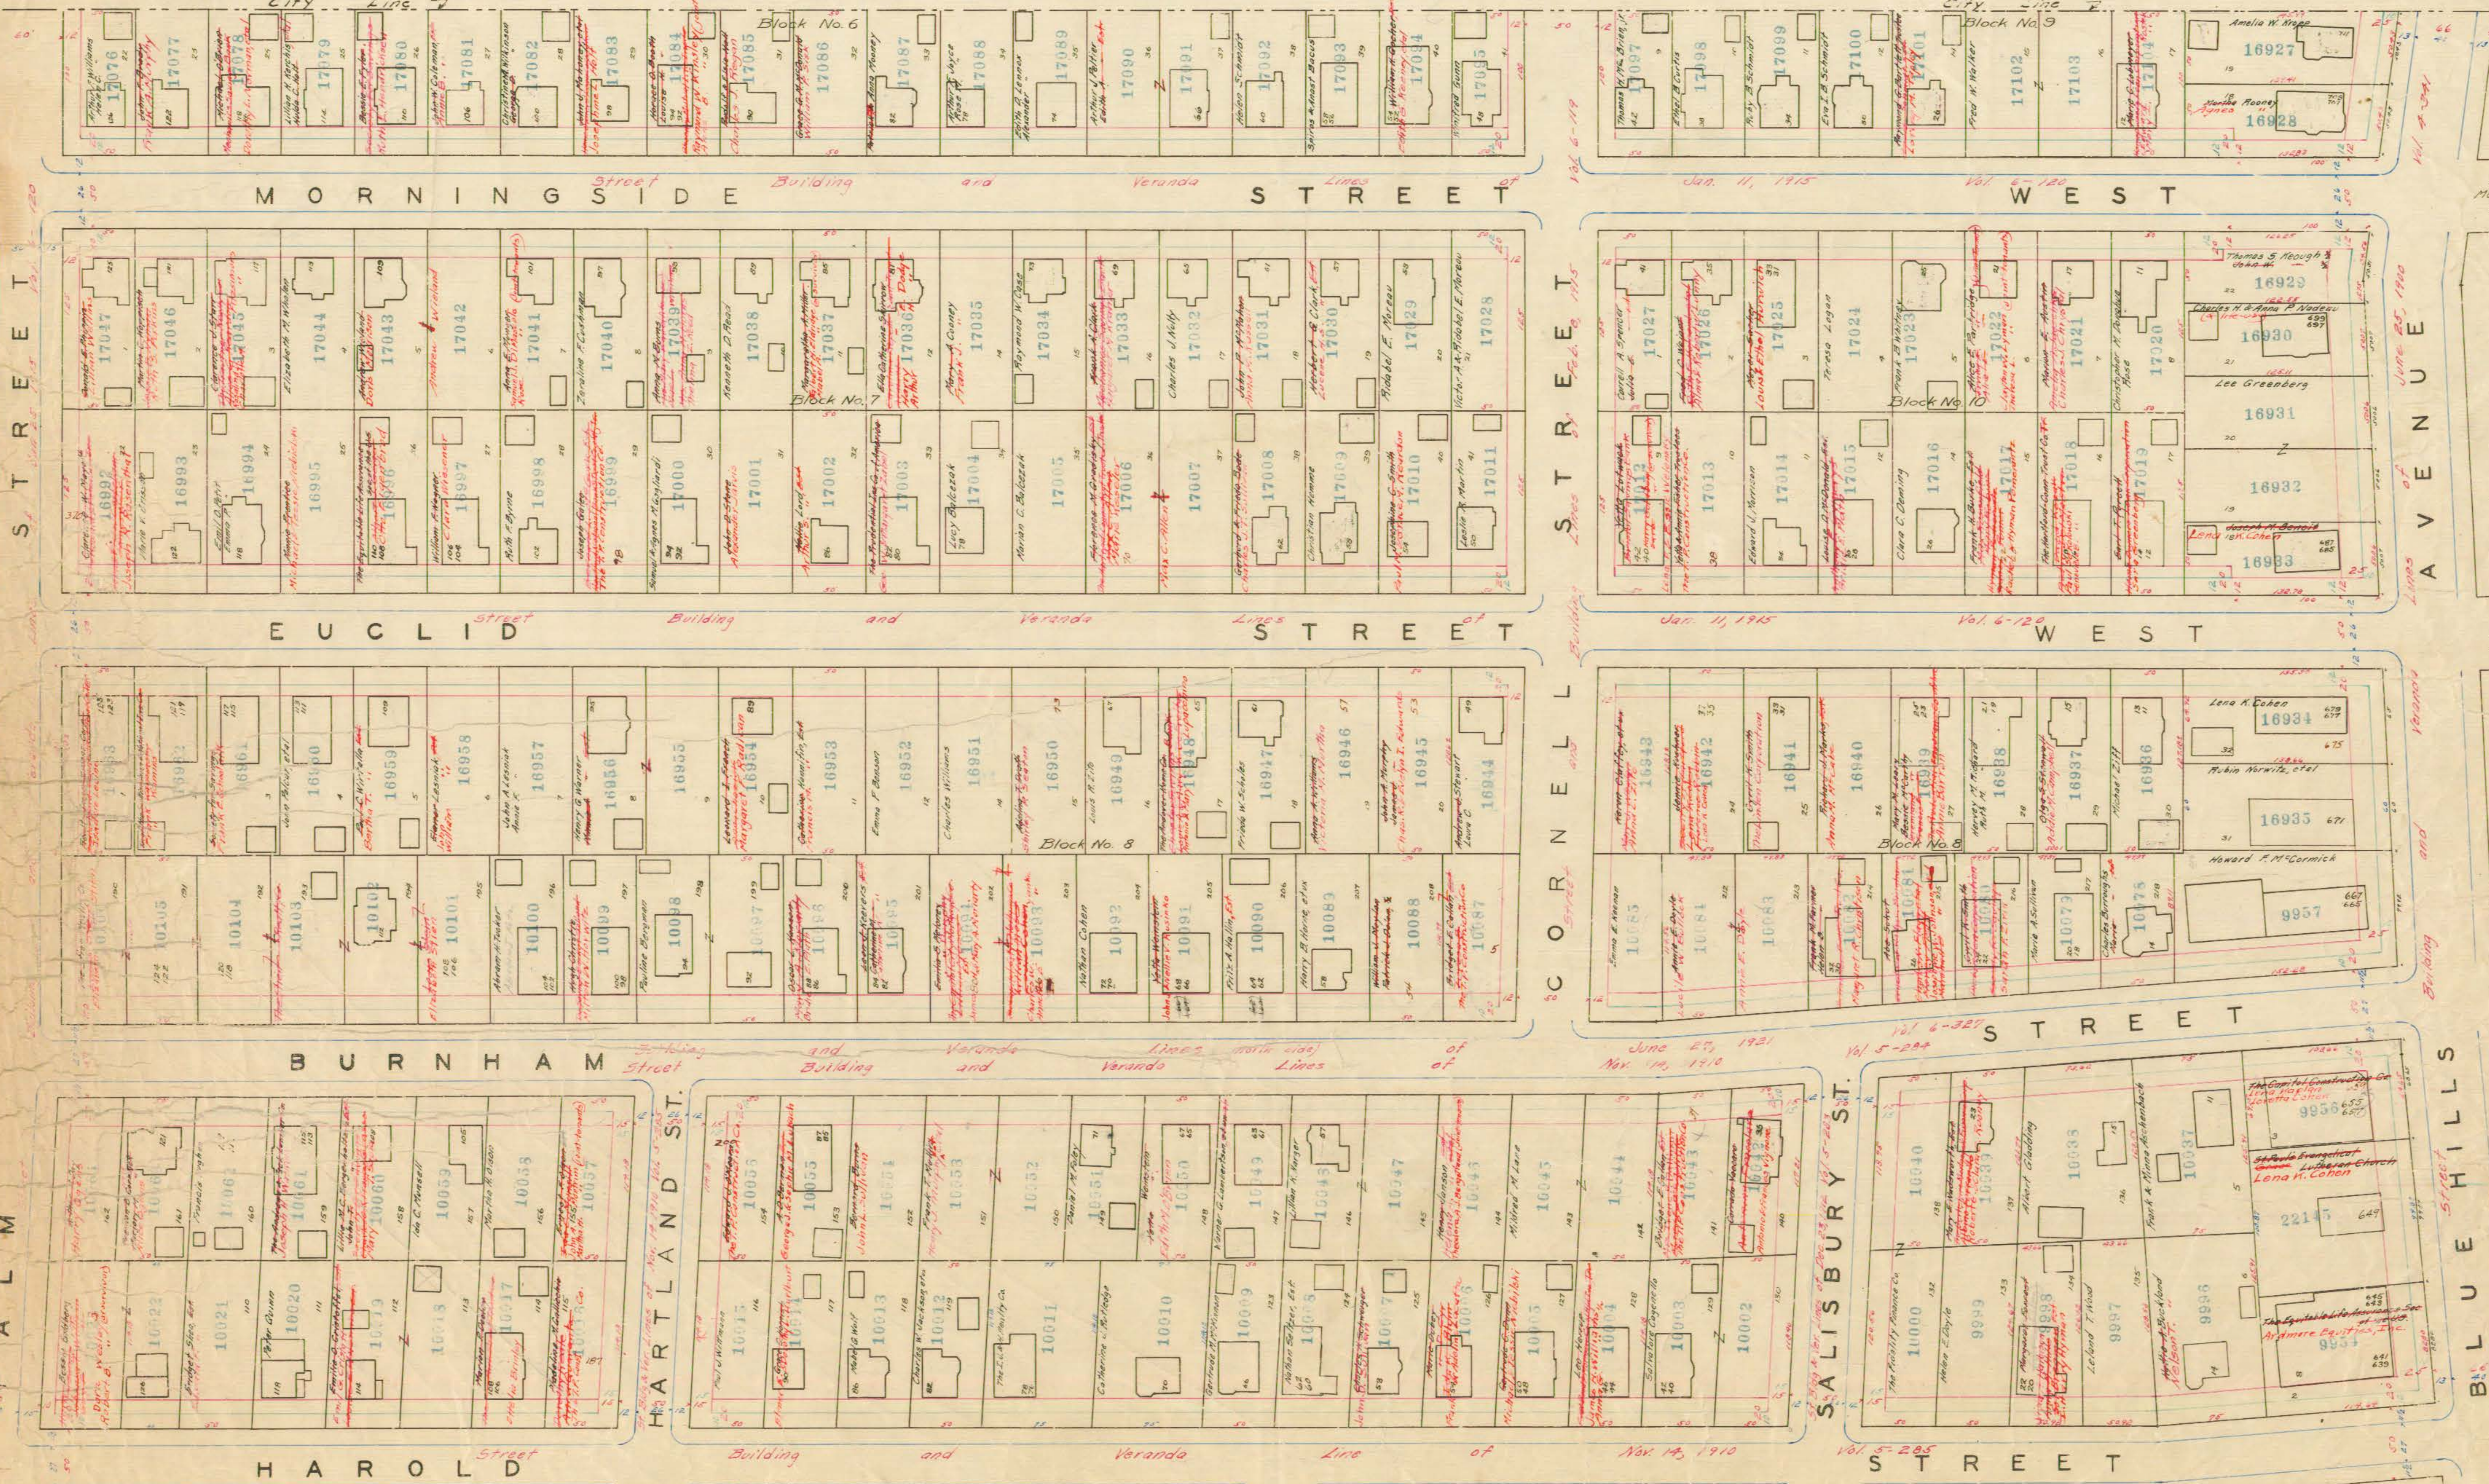

PALM

HAROLD

BURNHAM

EUCLID

MORNINGSIDE

WEST

SALISBURY

WEST

WEST

BLOOMFIELD

EAST MORNINGSIDE STREET

EAST EUCLID STREET

EAST BURNHAM STREET

See

See

See

See

See

See

See

See