


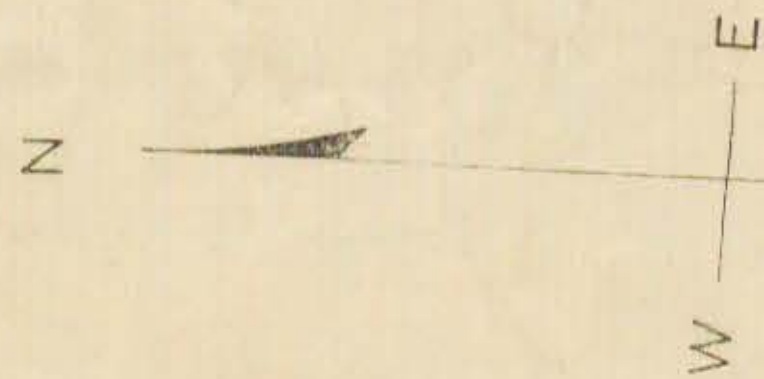

All unmarked lots owned by *Community Builders, Inc.*

All unmarked lots owned by *Frederick H. Morgan & Edward H. Malone*


PHILIPPEM BROKE STREET

LYME

Street, Building, and Veranda Lines

of November 24, 1913, Vol. 6-74.

STREET

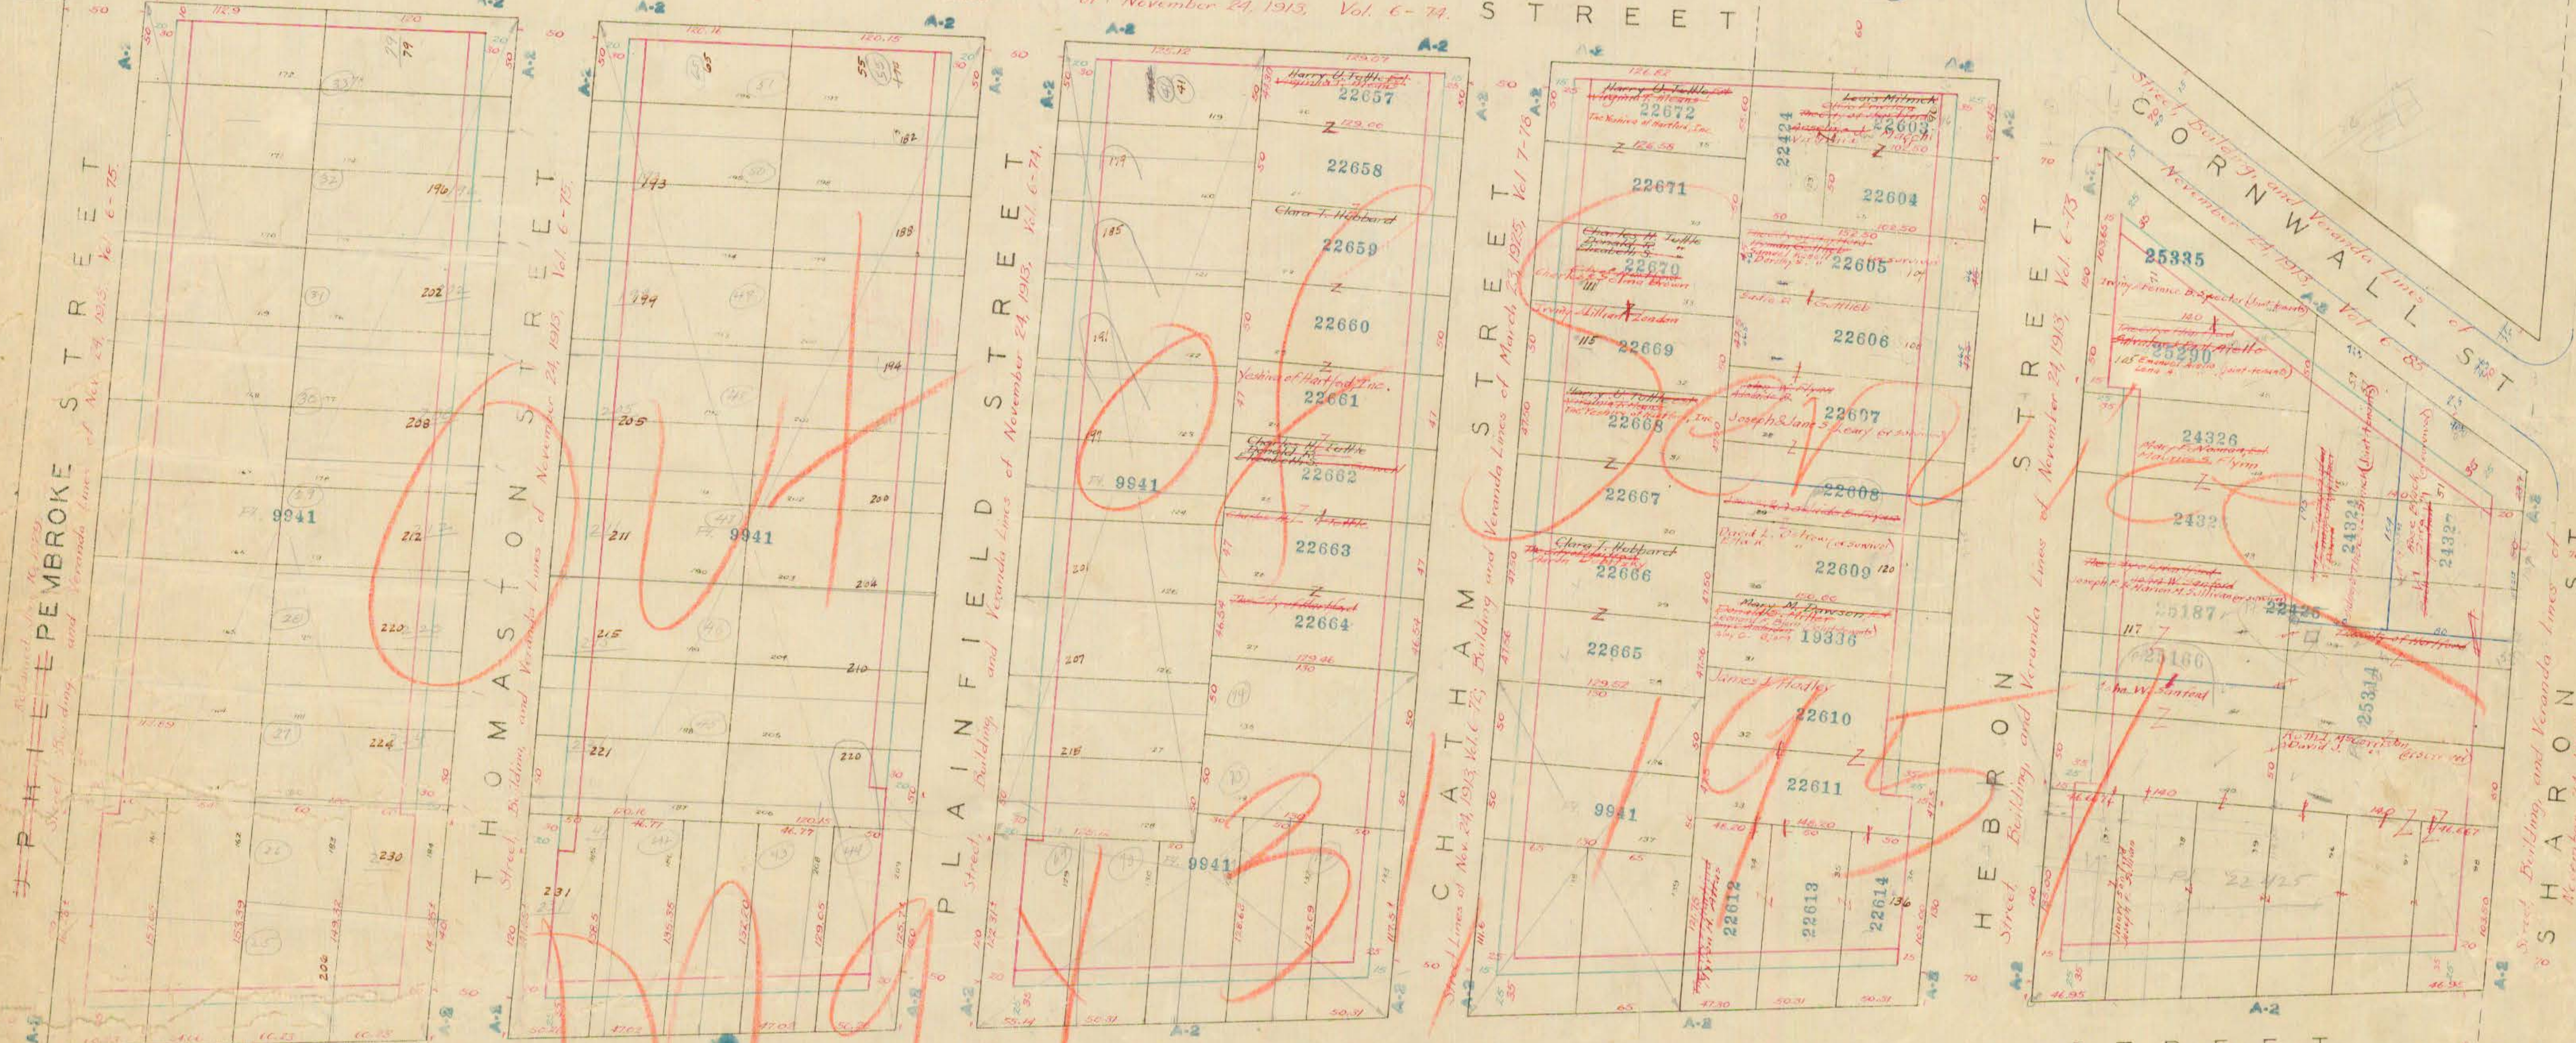


GRANBY

Street, Building, and Veranda Lines of December 22, 1913,

Vol. 6-86.

STREET

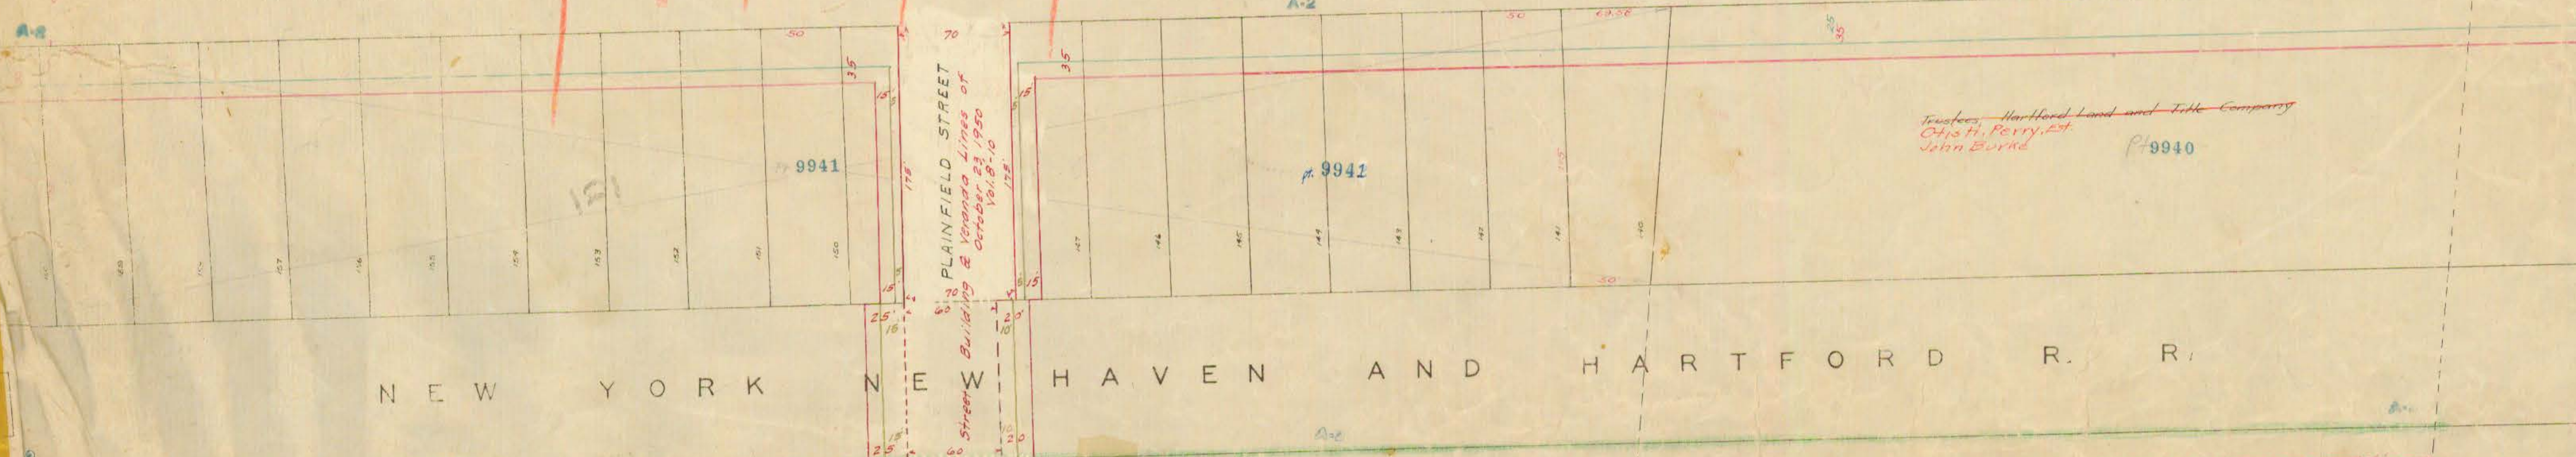

Community Builders, Inc.

All unmarked lots owned by *Dana & Mrs. Alfred*

All unmarked lots owned by *Frederick H. Morgan & Edward H. Malone*