

SANFORD ST. 40'-51'

Scale: 1" Hori. = 50'
1" Vert. = 10'


B.M. S.E. Cor. Water table of Alderman's store

N.E. Cor. MAIN & SANFORD STS. E. 57.465 - 57.40 Apr 1908

North Walk 7' out - Make self down curb
South Walk - Assume as 5 1/2' out - 1908 H.G. 46-47
Cuts - 7 1/2' out 25' between
40' Street

North line 1460 S of SE Cor. brick work of Store at N.E. Cor. Main St & Windsor Ave
1617 S of SE Cor. first brick house west of Windsor St

See New Profile 1914

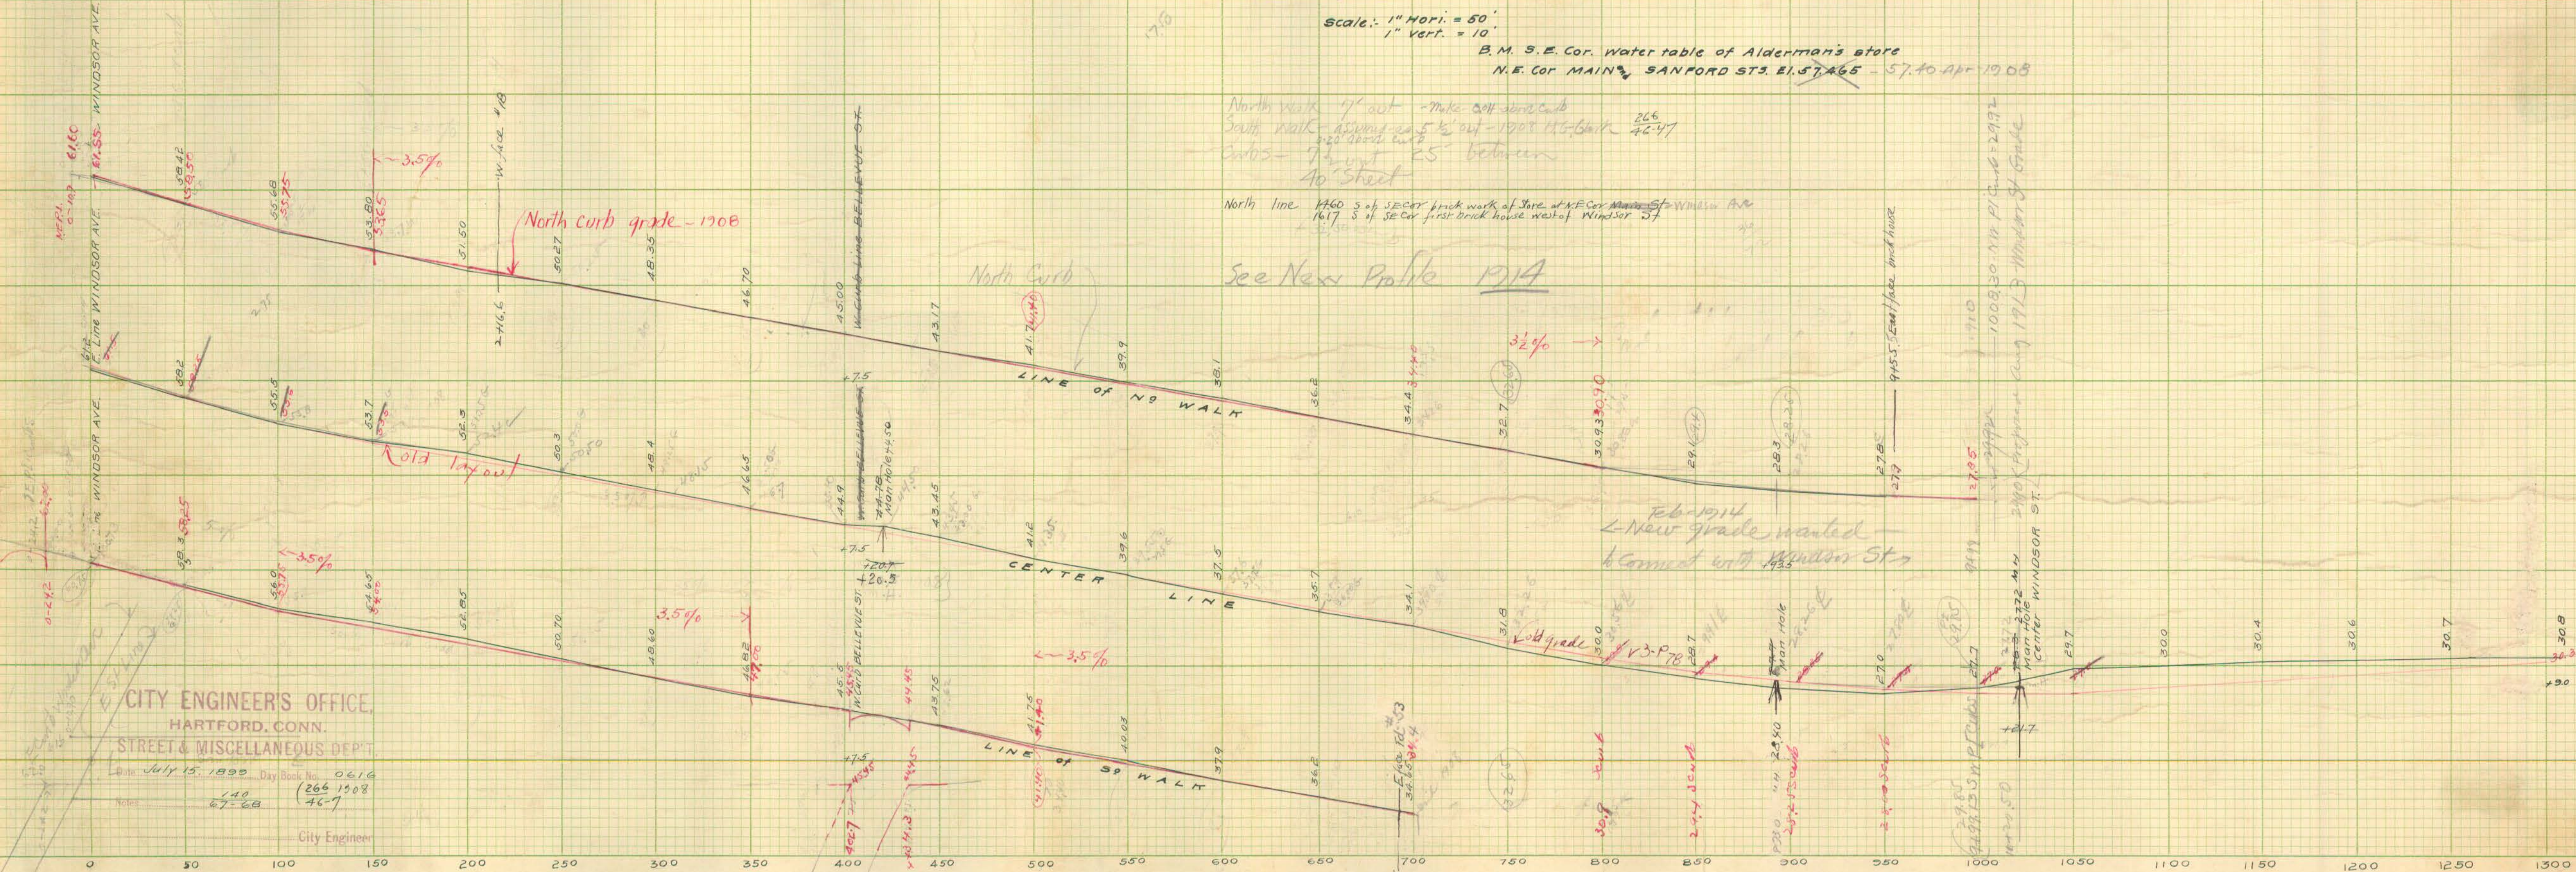

CITY ENGINEER'S OFFICE
HARTFORD, CONN.
STREET & MISCELLANEOUS DEPT.

Date July 15, 1898 Day Book No. 0616
Notes 140 (266 1508 46-7)
67-68

City Engineer

Feb 1914
New grade wanted
to connect with Windsor St

Man Hole

Man Hole

Man Hole

Man Hole

Man Hole

Man Hole

Man Hole

Man Hole

Man Hole