


Sec Sheet 95

N. Y. N. H. & H.F.D. R.R. CO.

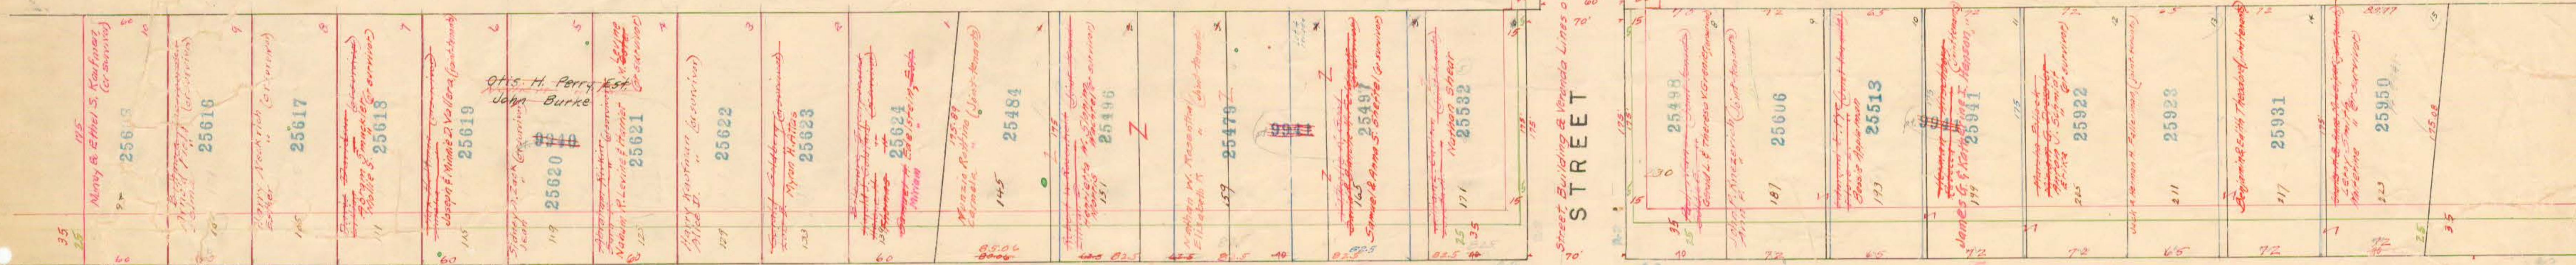


GRANBY Street

Building and Veranda Lines of December 22, 1913

Vol. 6-86

STREET

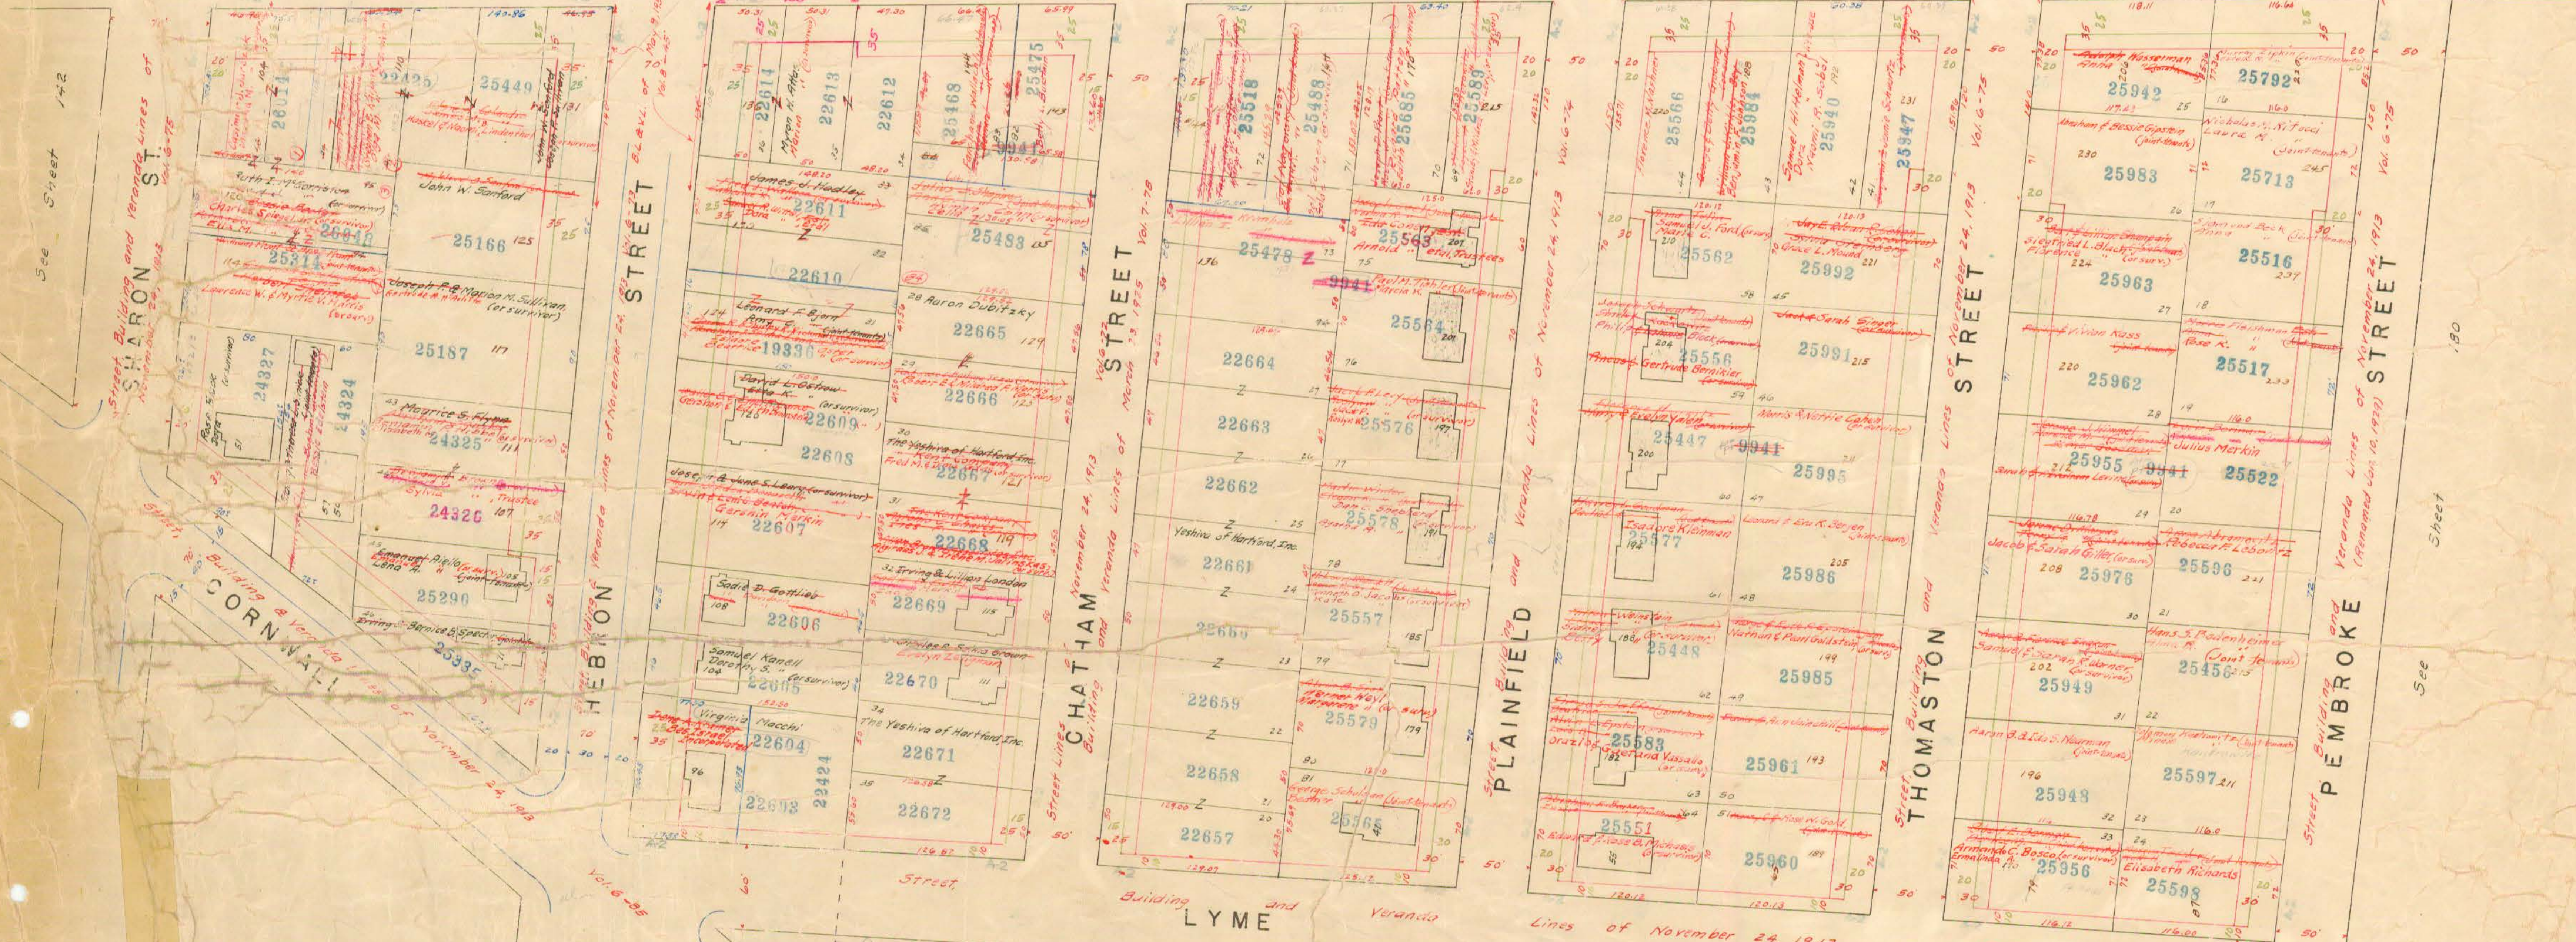

See Sheet 142

See Sheet 180

See Sheet 141

See Sheet 143

See Sheet 144

See Sheet 140














Out of Service April 21, 1967

DEPARTMENT OF ENGINEERING
CITY OF HARTFORD

PALM ST.