



datum Betts profile is 0 on Govt.
 Gauge - Hartford-East Hartford
 Highway Bridge

Profile on line of Proposed Outlet

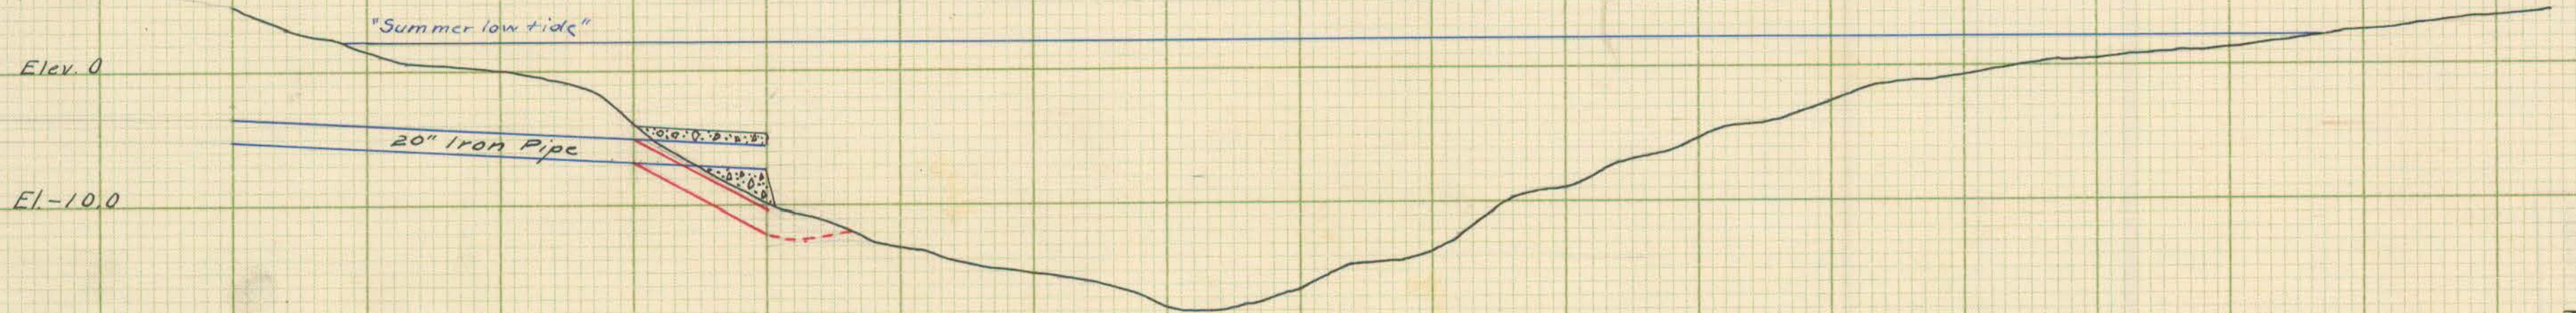

Datum is 0
 "Summer low tide"

Profile on line 300 ft. South of and parallel to above

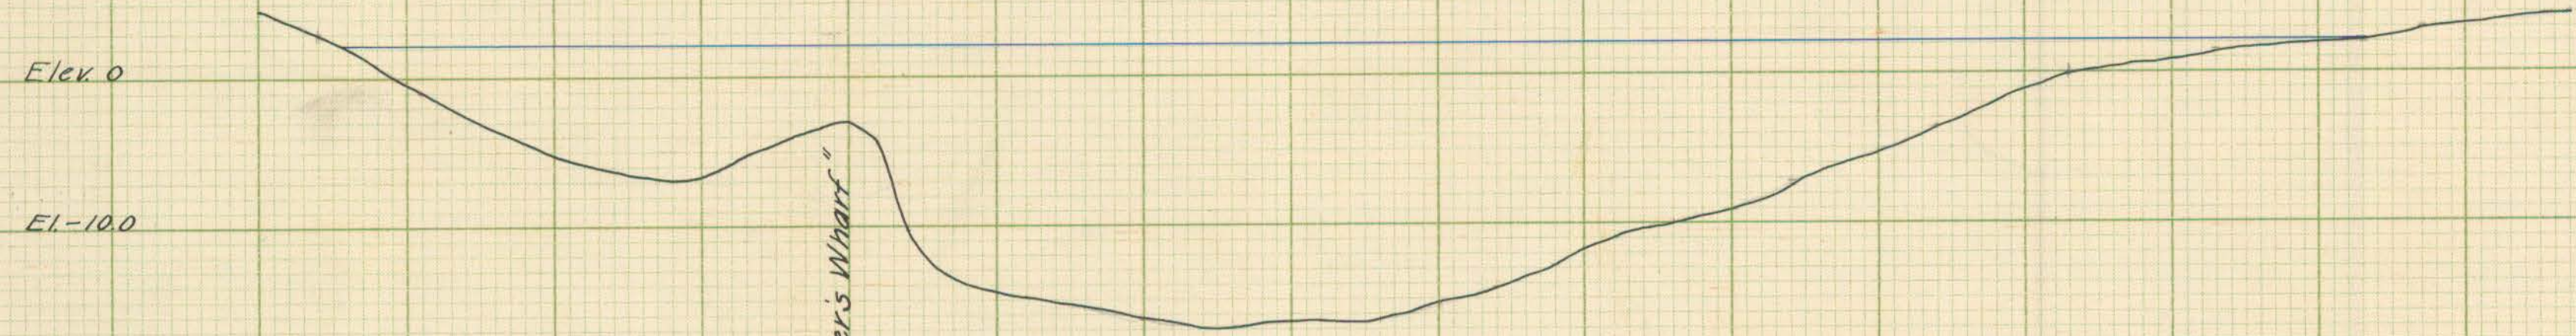

"Latimer's Wharf"

20 yds. Channel @ 10' = 200
 45 ft. pipe @ 4.50 = 202.5
 472.5