



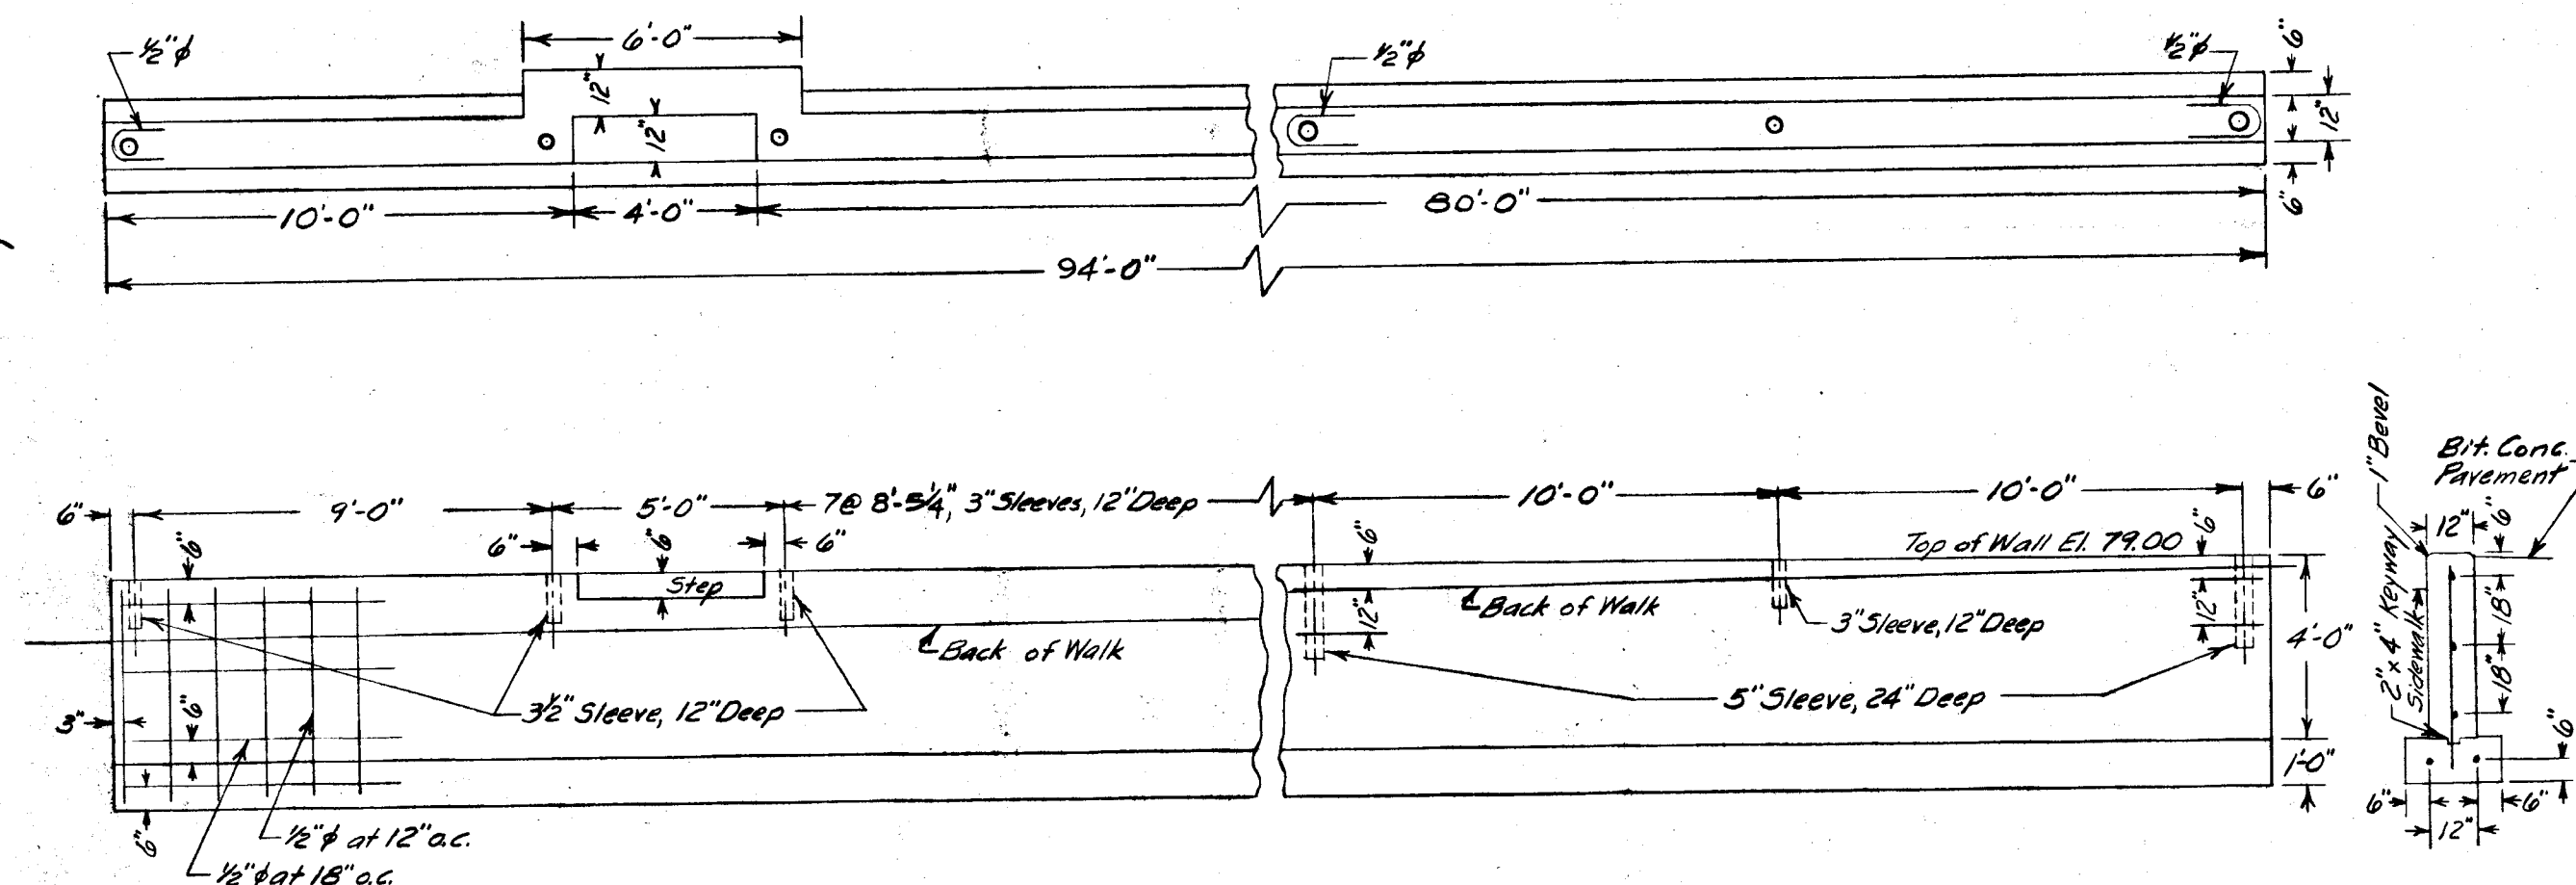

DETAIL OF RETAINING WALL
SCALE: 1/4" = 1'-0"

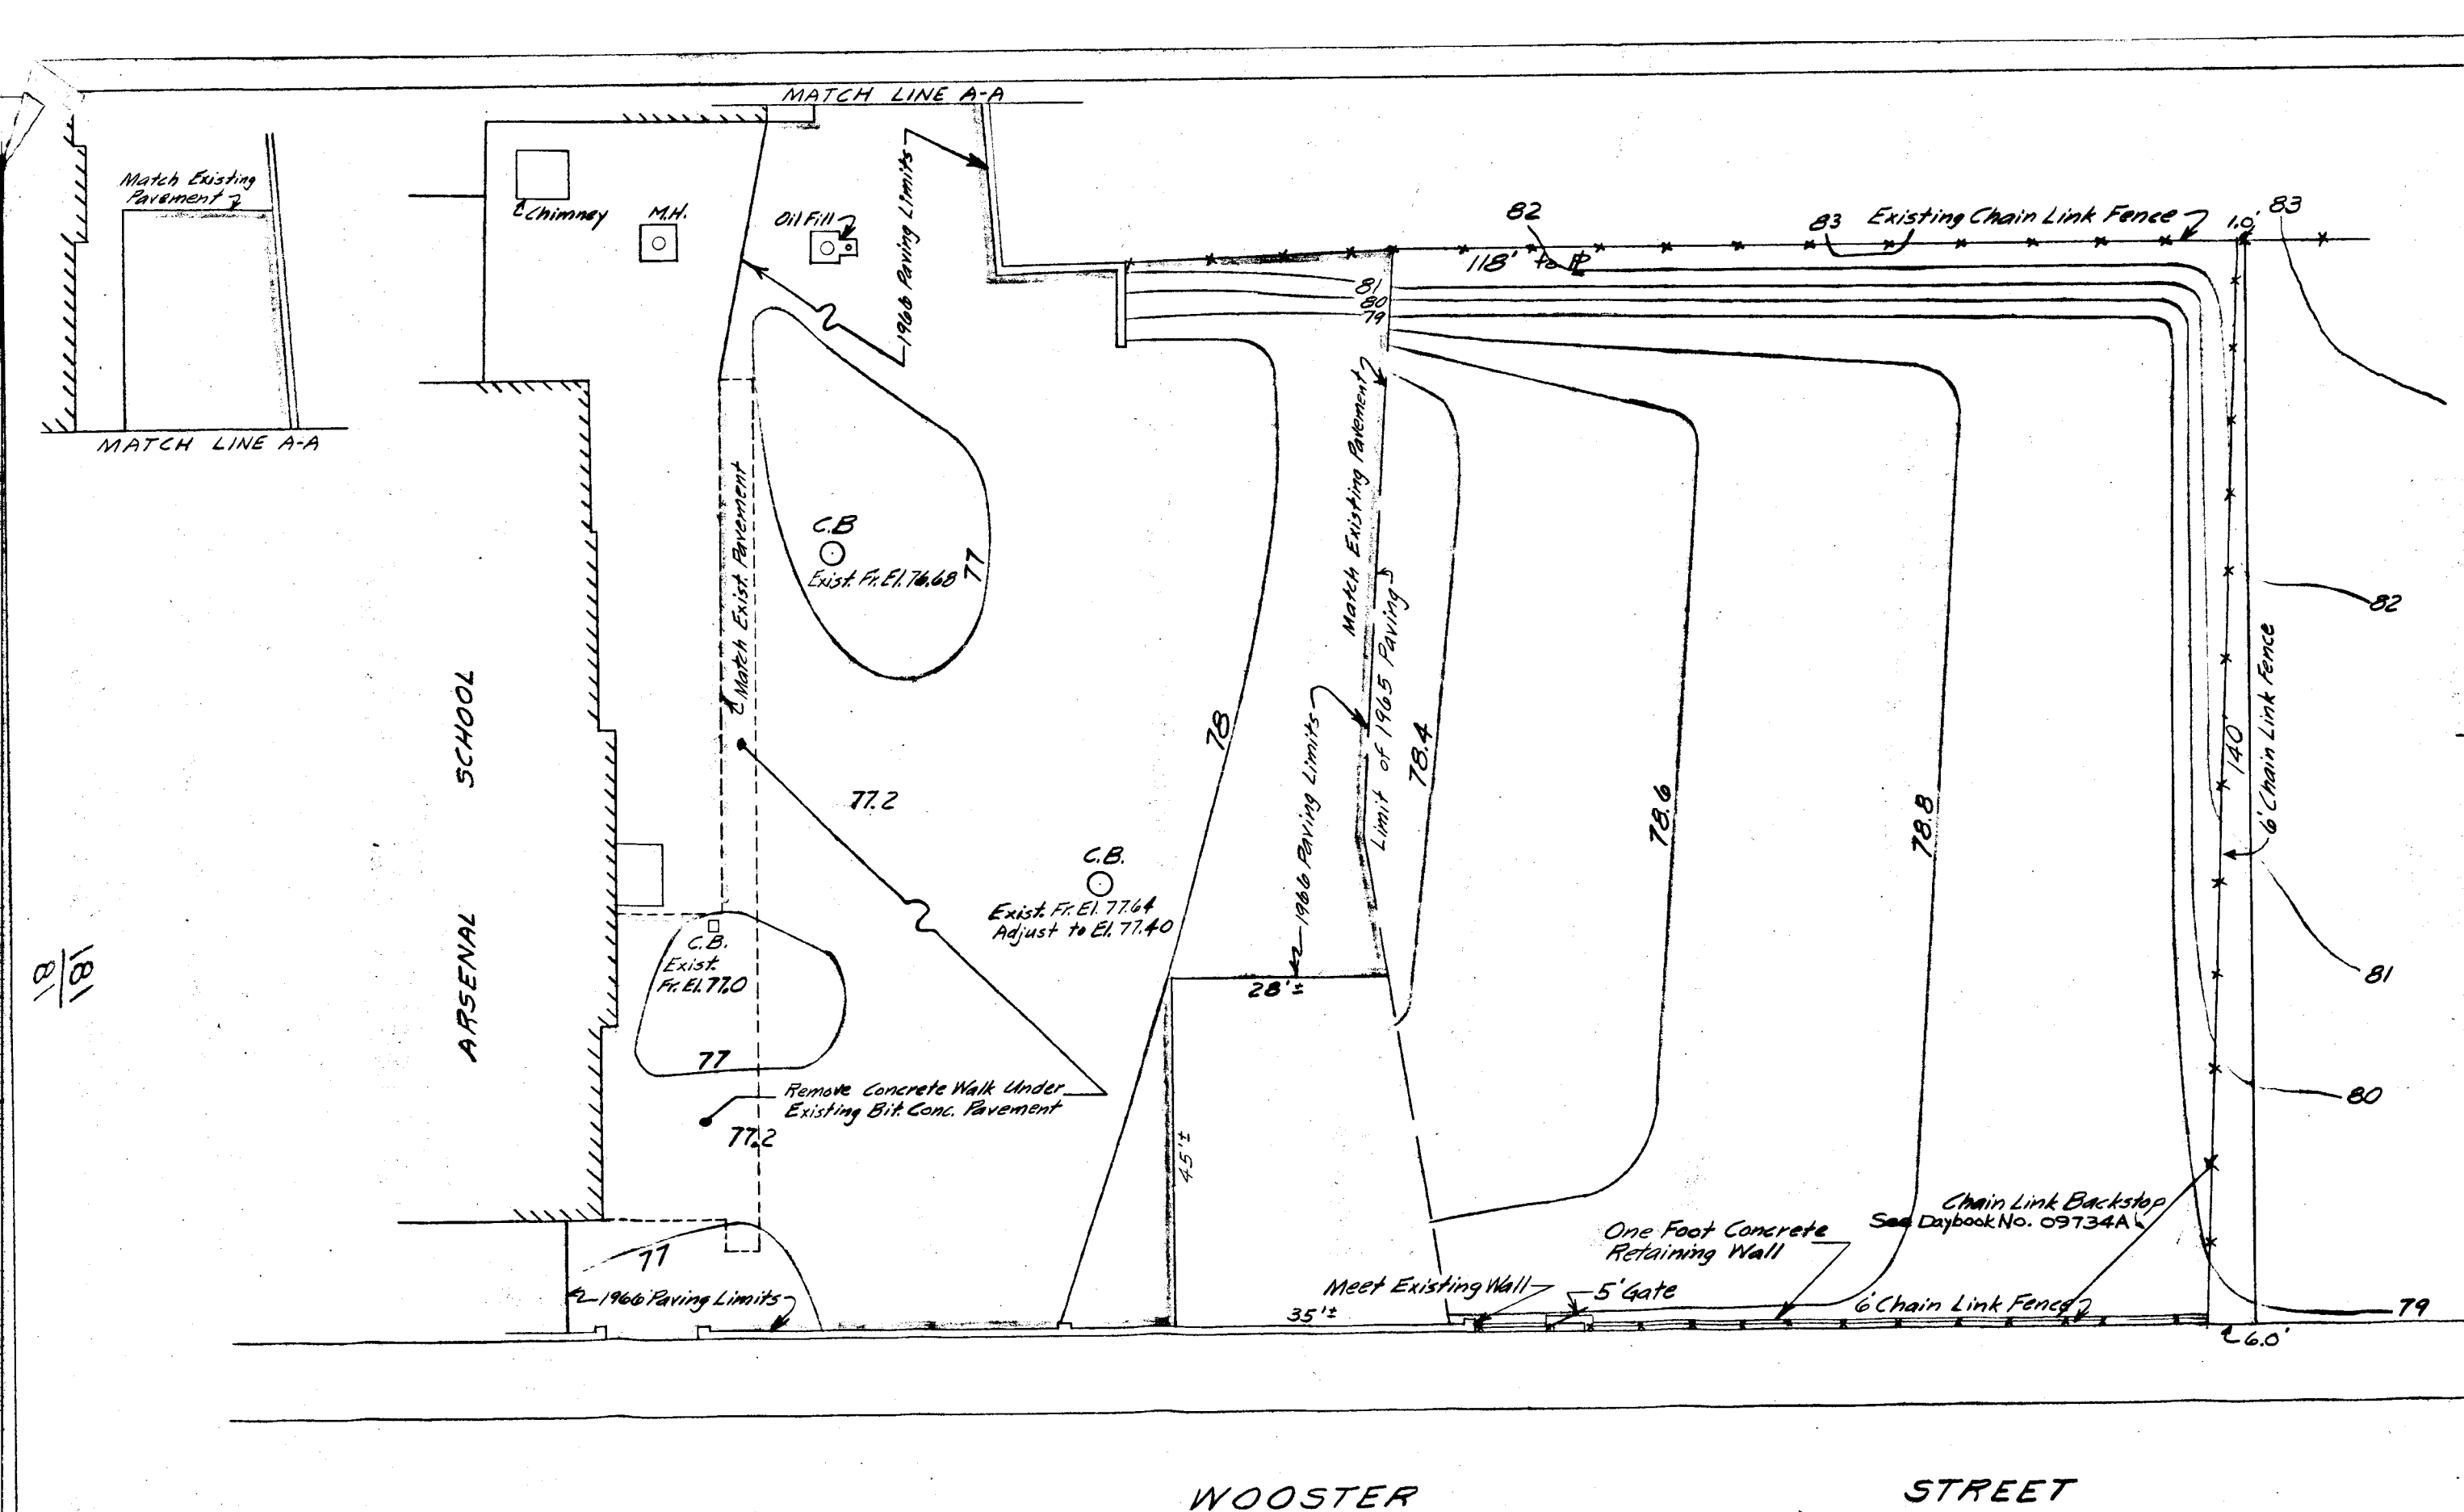

NOTE: 1966 Paving Added June 6, 1966

SITE IMPROVEMENTS
ARSENAL SCHOOL

AUG. 1965 - REVISED CONTOURS, ADJUSTED NORTH FENCE LINE AND CHANGED LENGTH OF WALL AND SLEEVE SPACING.

CITY OF HARTFORD
DEPT. OF ENGINEERING
SCALE: 1" = 20' MAY 1965
DAYBOOK NO. 09888