


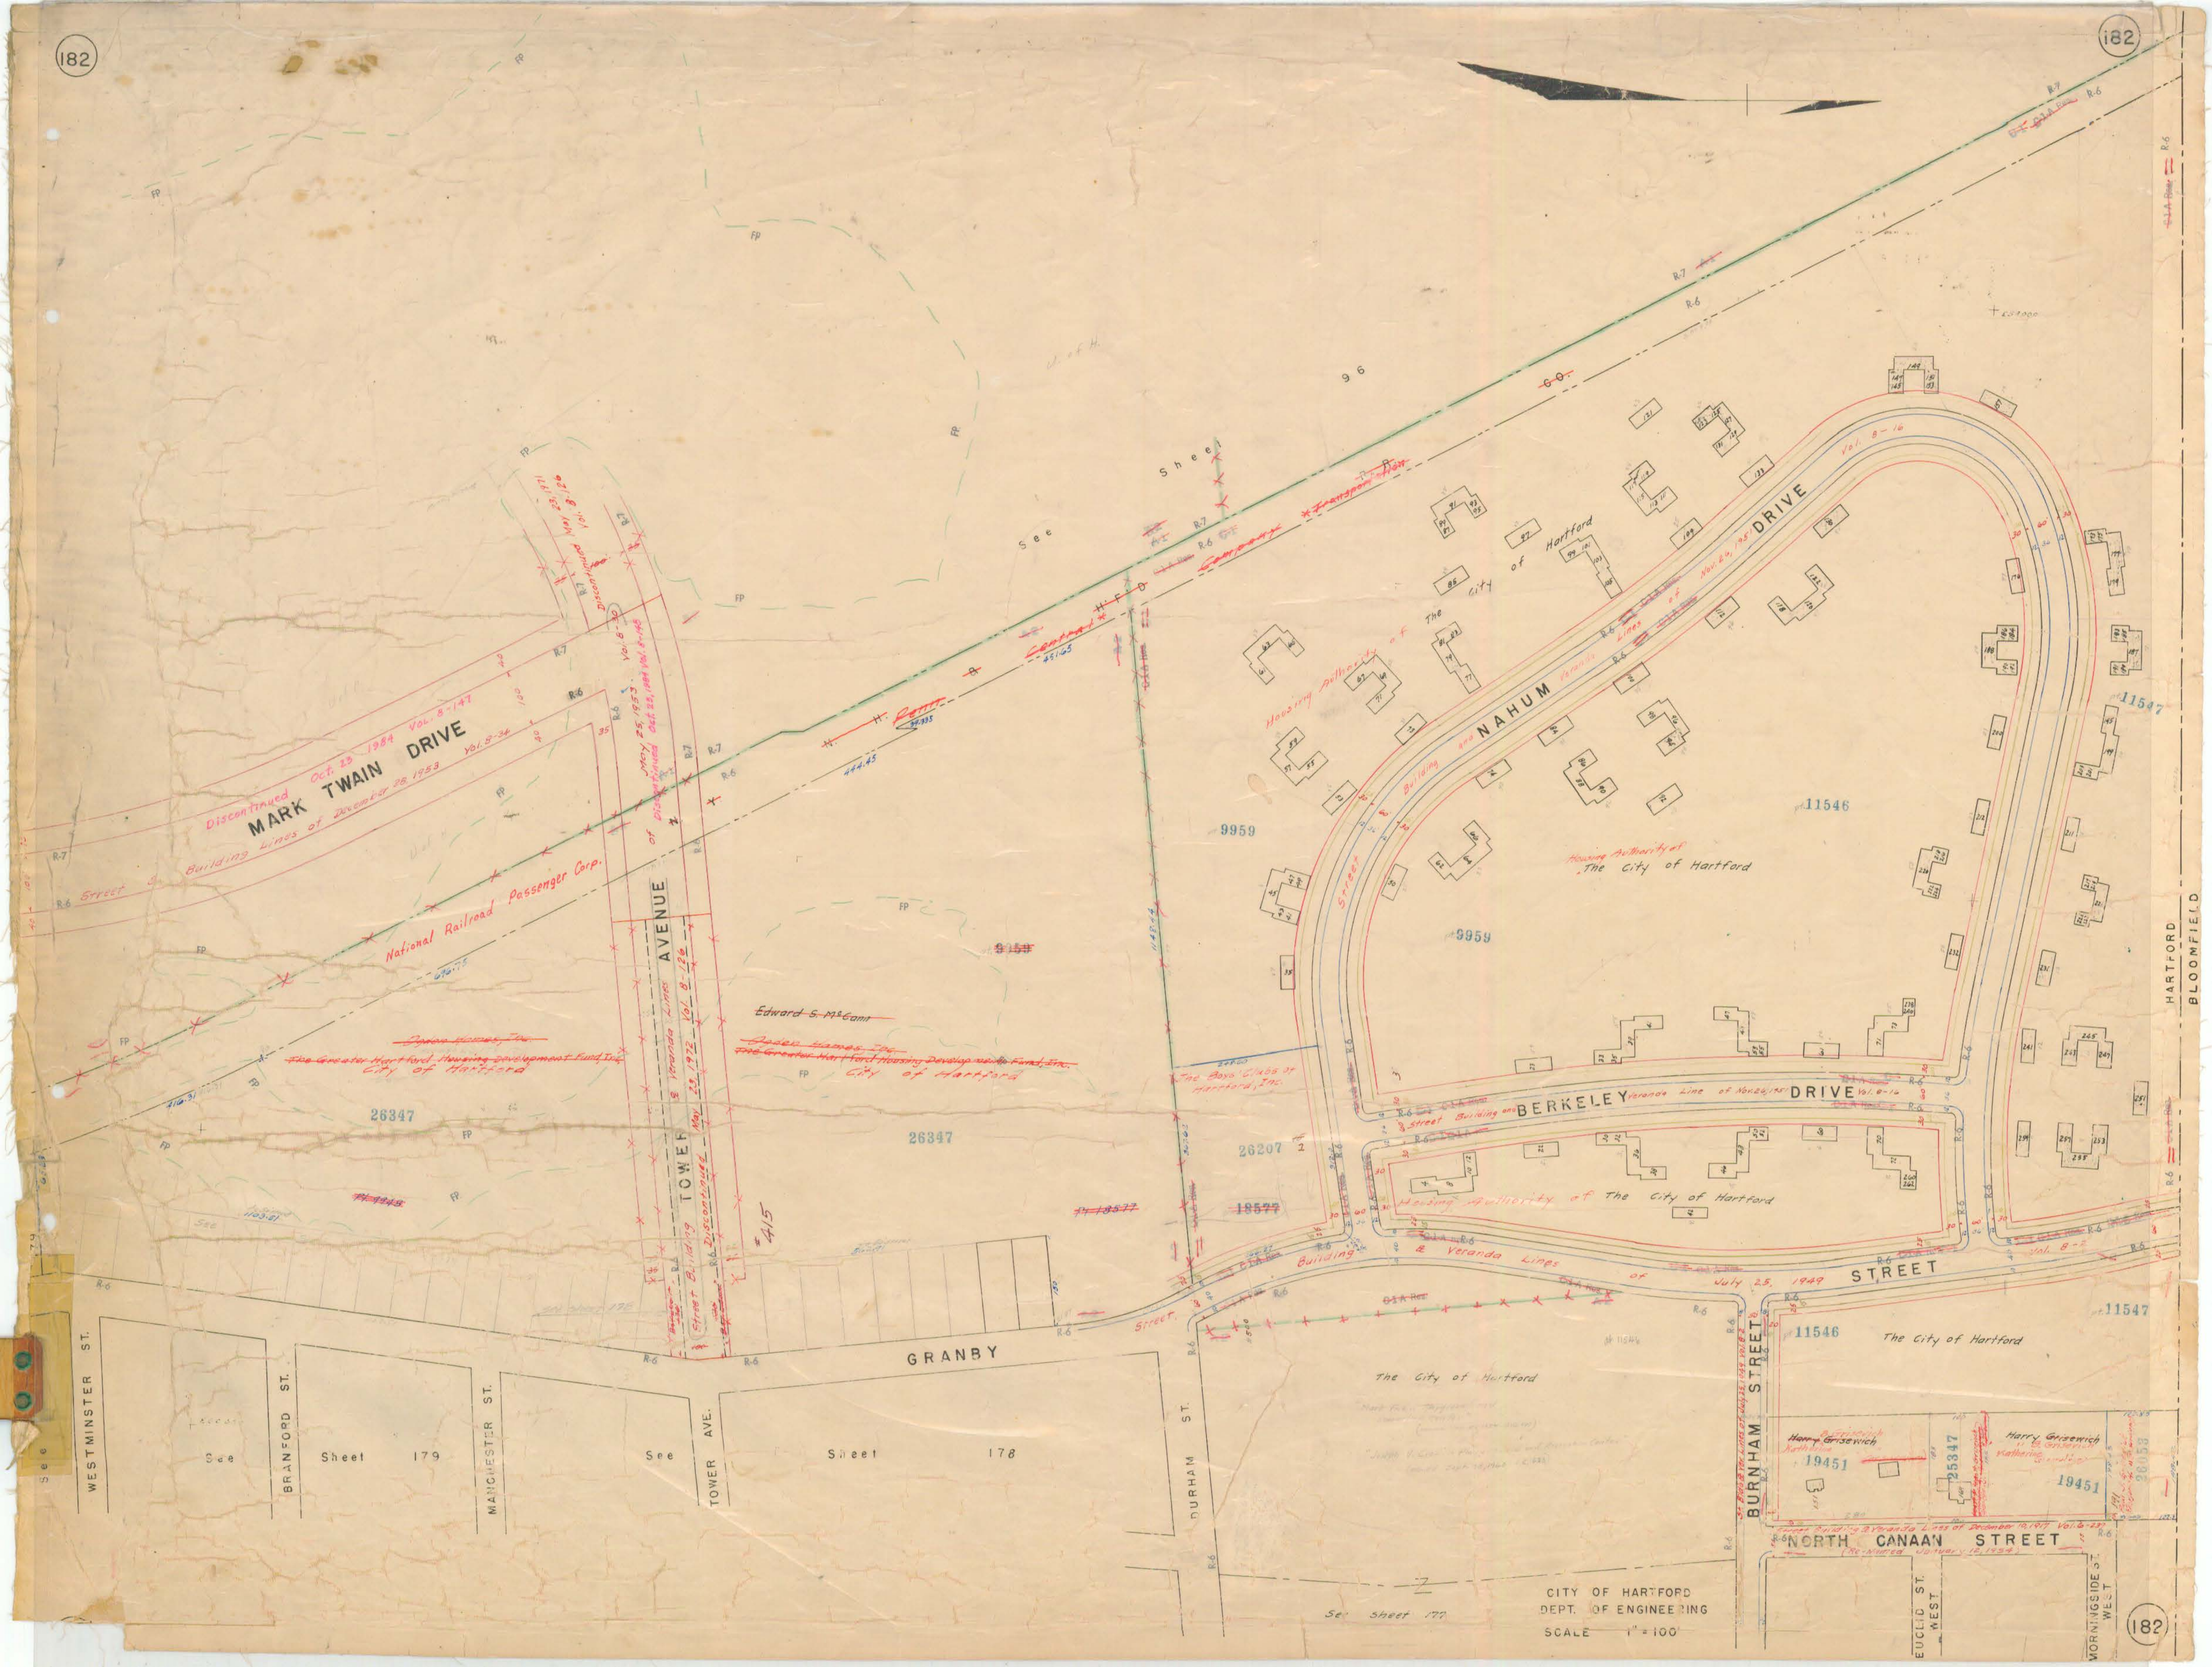

CITY OF HARTFORD
DEPT. OF ENGINEERING
SCALE 1" = 100'