


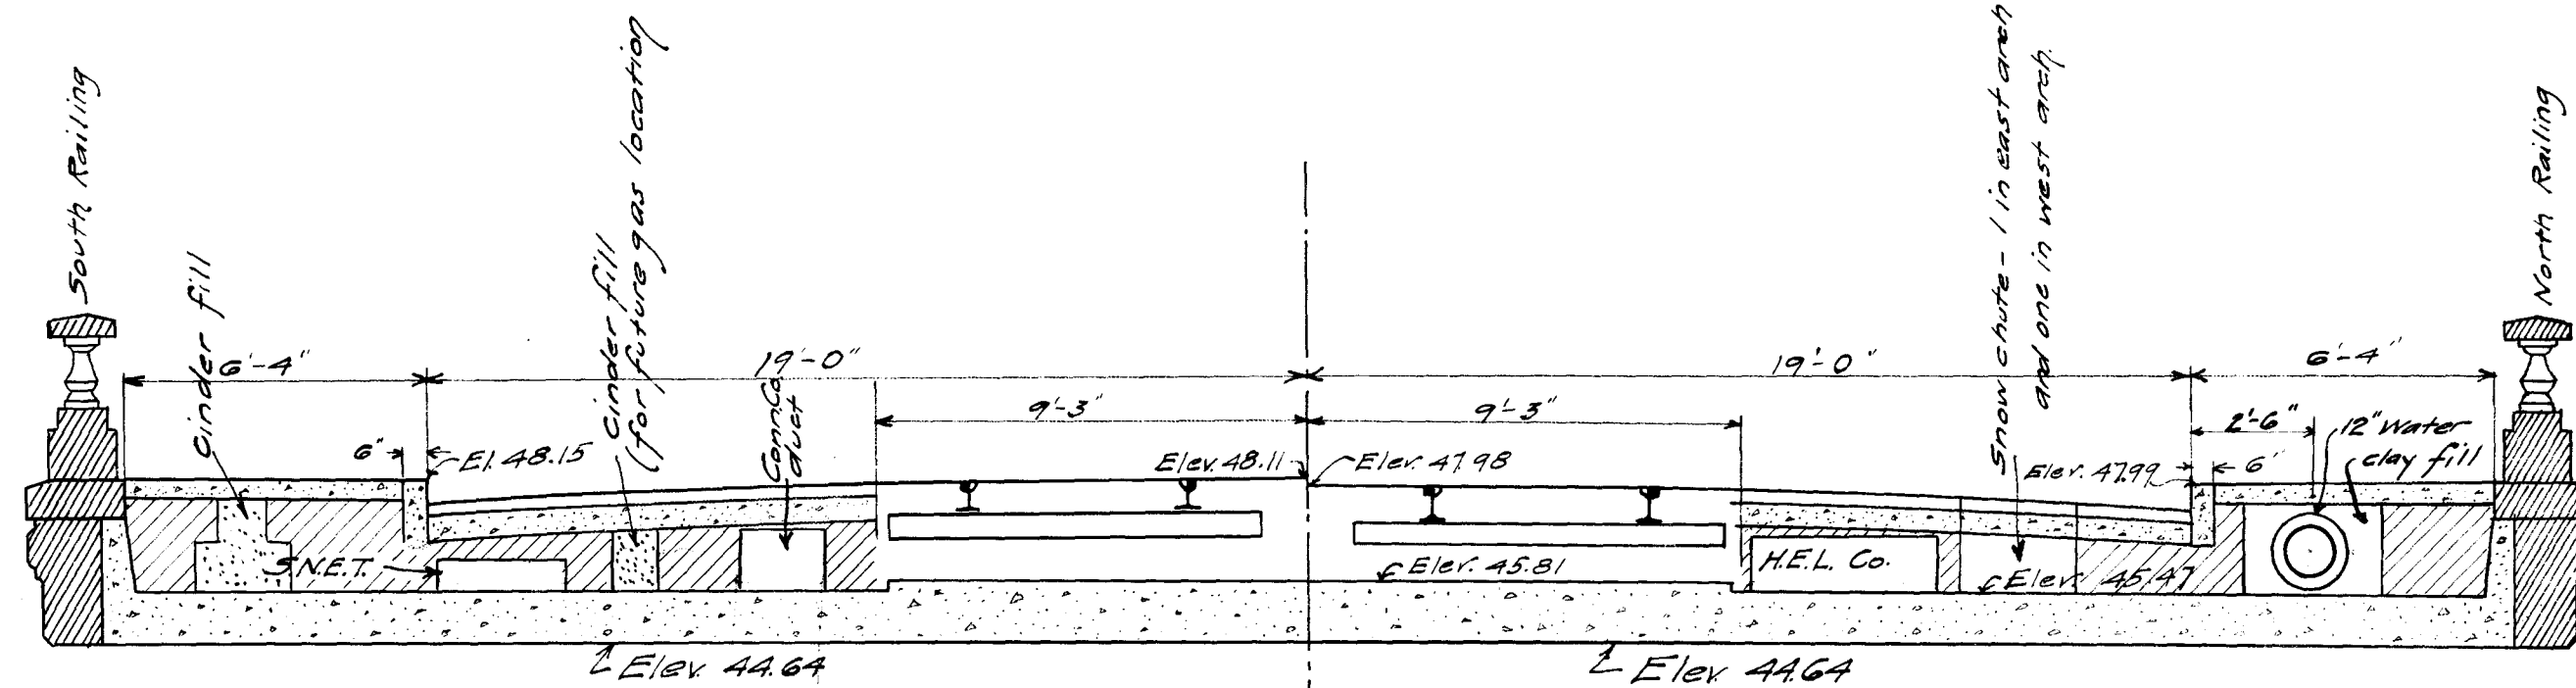

Half Cross Section at Crown of West Arch
Projected on a plane perpendicular to $\pm$ of Roadway

Half Cross Section at Crown of East Arch
Projected on a plane perpendicular to $\pm$ of Roadway

Note: These sections are taken looking west and show the minimum clearance from arch to roadway.

City of Hartford
 Department of Engineering
 Bridge over Park River at Capitol Ave.
 Scale $\frac{1}{4}" = 1\text{ft}$
 Feb. 1916 Day Book No. 03912