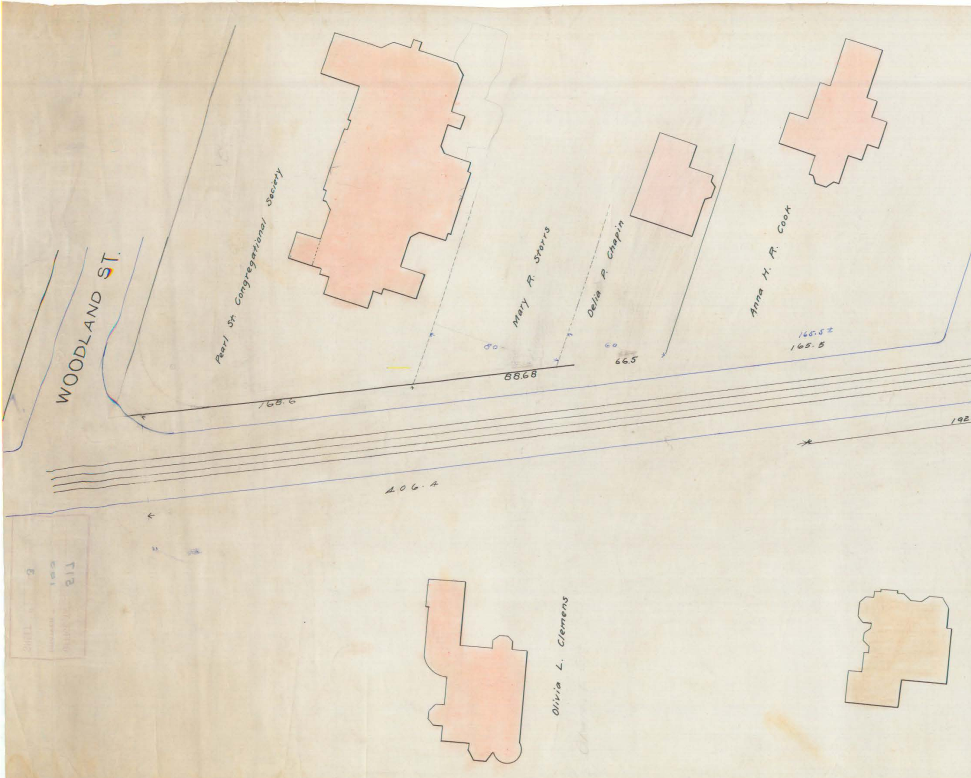
WOODLAND ST.
Pearl St. Congregational Society
Mary R. Storrs
Delia P. Chapin
Anna H. R. Cook
80
60
88.68
66.5
165.5±
165.5
168.6
192
406.4
Olivia L. Clemens

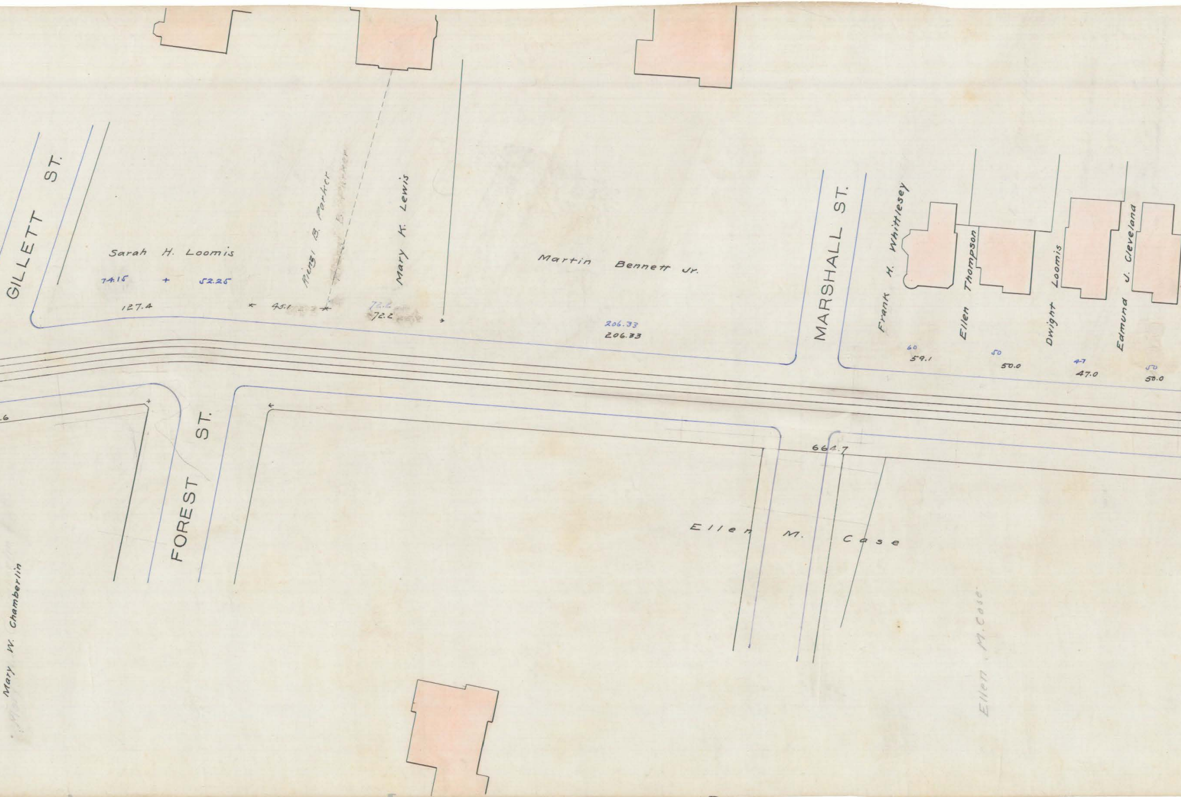
GILLETT ST.
Sarah H. Loomis
74.15
+
52.25
127.4
45.1
Rienzi B. Parker
Mary K. Lewis
72.2
72.2
Martin Bennett Jr.
206.33
206.33
MARSHALL ST.
Frank H. Whittlesey
Ellen Thompson
Dwight Loomis
Edmund J. Cleveland
60
59.1
50
50.0
47
47.0
50
50.0
FOREST ST.
Ellen M. Case
664.7
Mary W. Chamberlin
Ellen M. Case

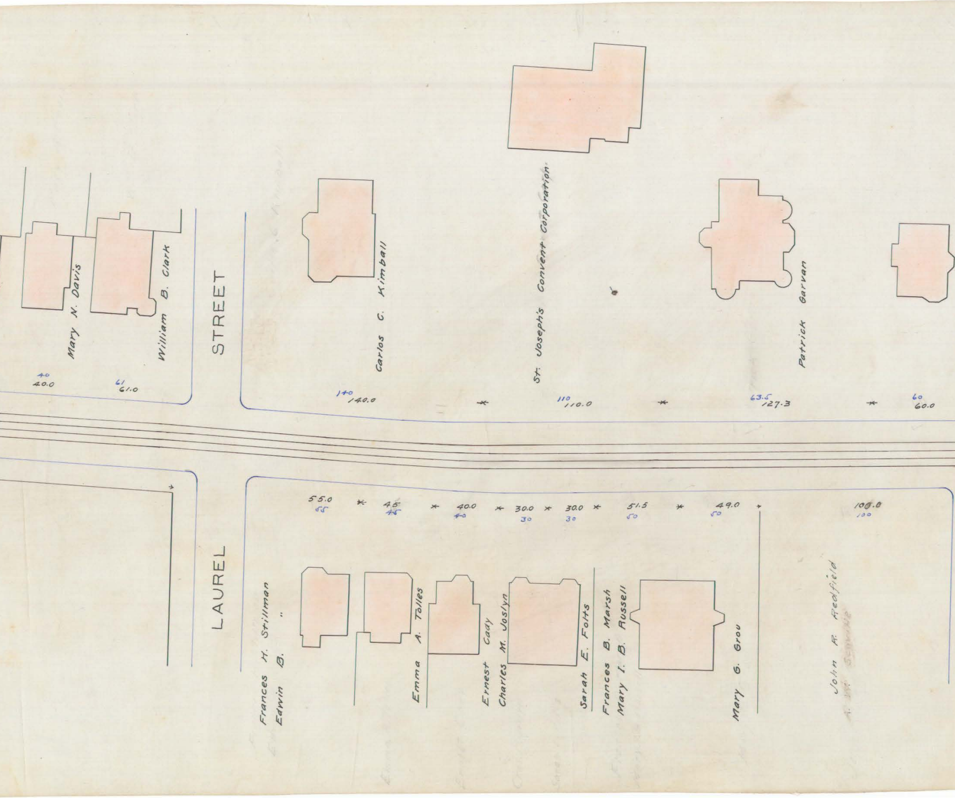
Mary N. Davis
William B. Clark
40
40.0
61
61.0
STREET
LAUREL
Carlos C. Kimball
St. Joseph's Convent Corporation
Patrick Garvan
140
140.0
110
110.0
63.5
127.3
60
60.0
55.0
55
45
45
40.0
40
30.0
30
30.0
30
51.5
50
49.0
50
100.0
100
Frances H. Stillman
Edwin B. "
Emma A. Tolles
Ernest Cady
Charles M. Joslyn
Sarah E. Folts
Frances B. Marsh
Mary I. B. Russell
Mary G. Grou
John R. Redfield

FARMINGTON AVENUE
ASYLUM ST. TO WOODLAND ST.
SCALE-1"=40'

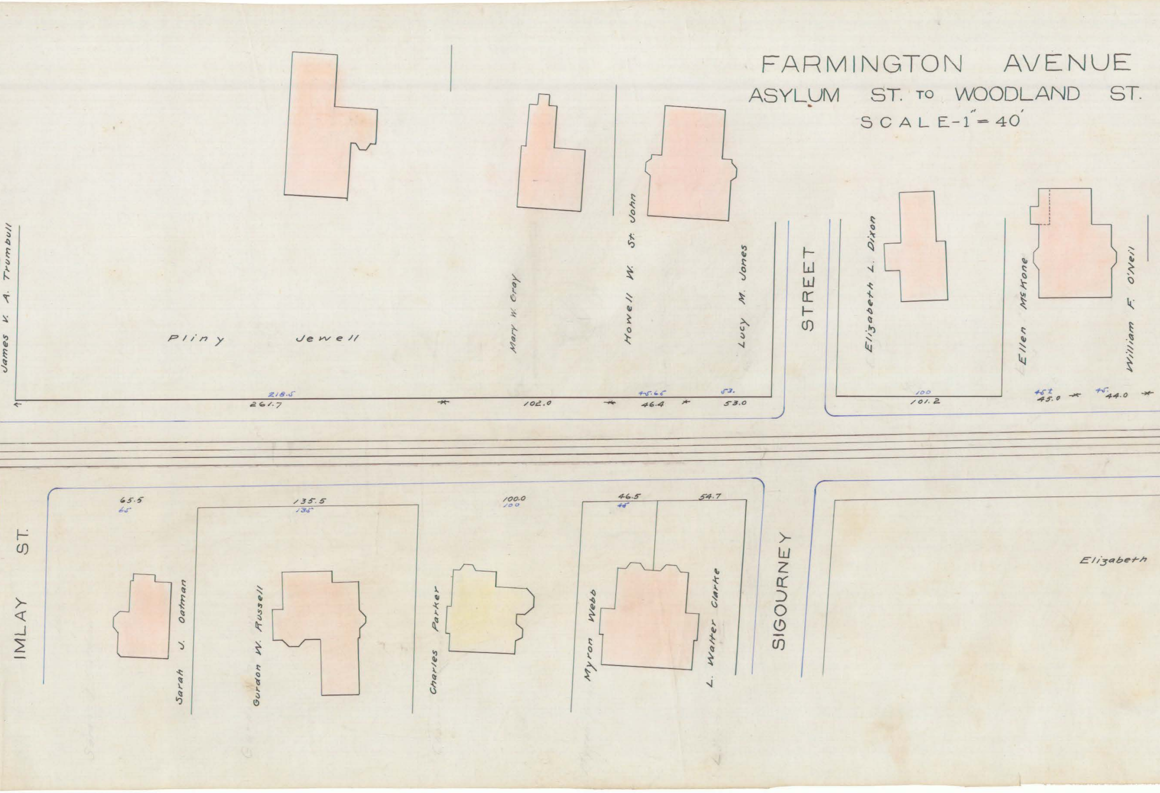
James V. A. Trumbull
Pliny Jewell
218.5
261.7
Mary W. Gray
102.0
Howell W. St. John
45.65
46.4
Lucy M. Jones
53.
53.0
STREET
Elizabeth L. Dixon
100
101.2
Ellen McKone
45±
45.0
William F. O'Neil
45.
44.0
IMLAY ST.
65.5
65
Sarah J. Oatman
135.5
135
Gurdon W. Russell
100.0
100
Charles Parker
46.5
45
Myron Webb
54.7
L. Walter Clarke
SIGOURNEY
Elizabeth

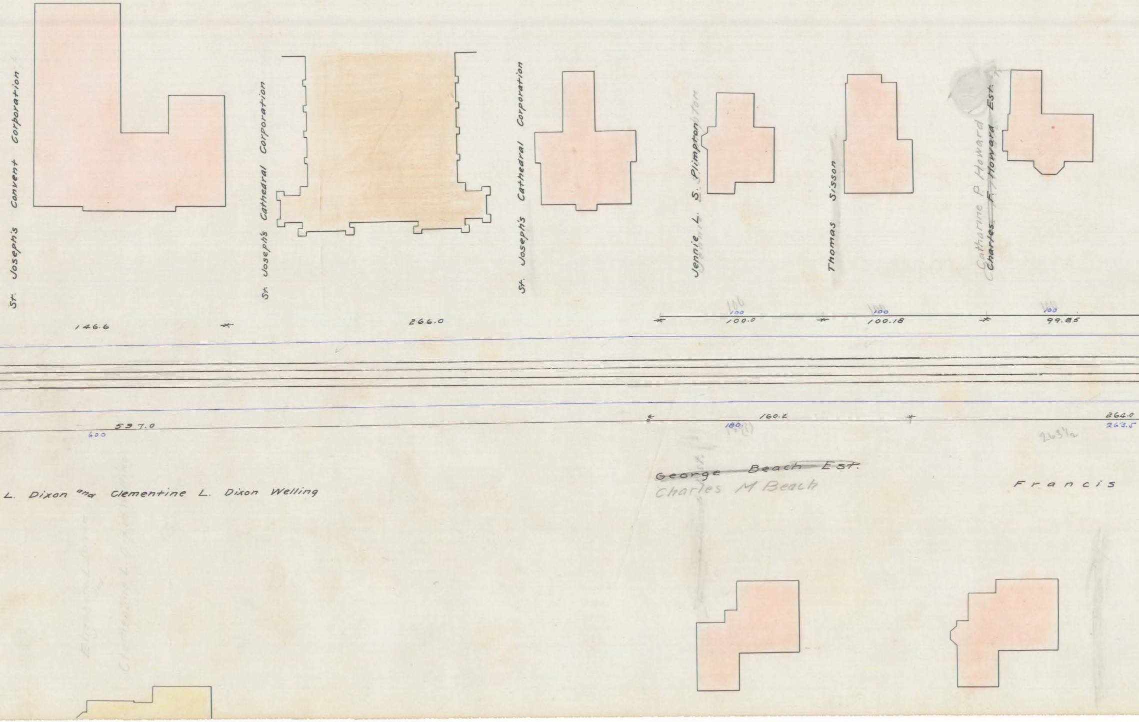
St. Joseph's Convent Corporation
St. Joseph's Cathedral Corporation
St. Joseph's Cathedral Corporation
Jennie L. S. Plimpton
Thomas Sisson
Catharine P. Howard
~~Charles F. Howard Est.~~
146.6
266.0
100
100.0
100
100.18
100
99.85
537.0
600
160.2
180.
264.0
263.5
263½
L. Dixon and Clementine L. Dixon Welling
~~George Beach Est.~~
Charles M Beach
Francis

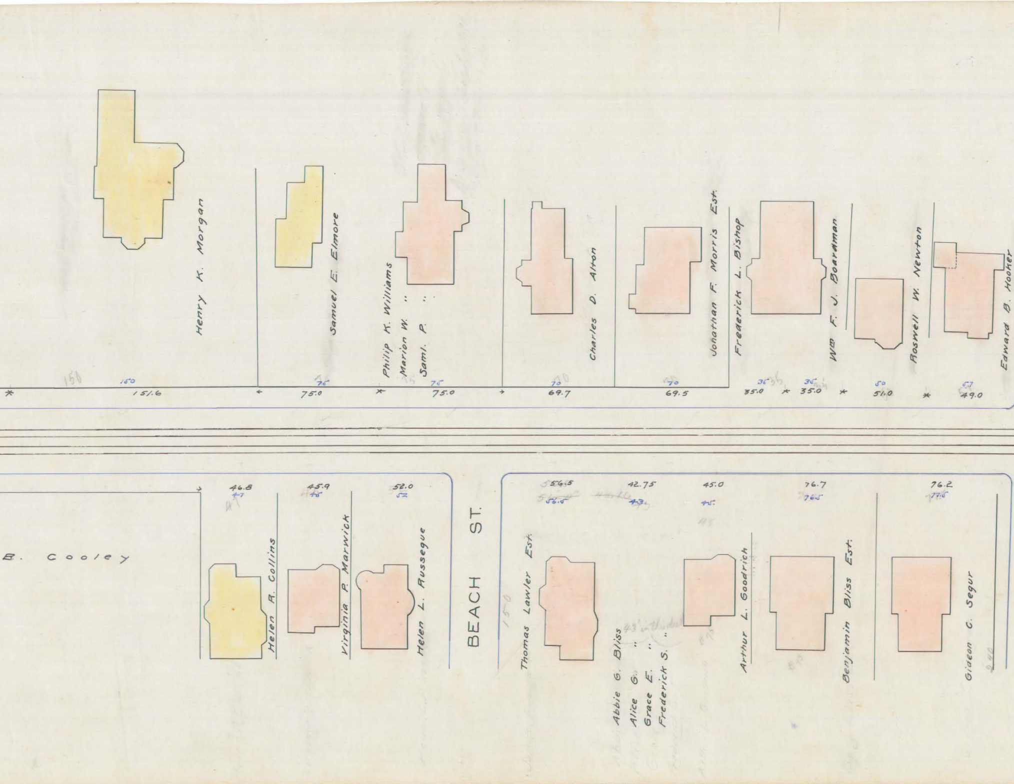
Henry K. Morgan
150
151.6
Samuel E. Elmore
75
75.0
Philip K. Williams
Marion W. "
Saml. P. "
75
75.0
Charles D. Alton
70
69.7
Jonathan F. Morris Est.
70
69.5
Frederick L. Bishop
35
35.0
Wm F. J. Boardman
35
35.0
Roswell W. Newton
50
51.0
Edward B. Hooker
57
49.0
B. Cooley
Helen R. Collins
46.8
47
Virginia P. Marwick
45.9
45
Helen L. Russegue
52.0
52
BEACH ST.
Thomas Lawler Est.
56.5
56.5
Abbie G. Bliss
Alice G. "
Grace E. "
Frederick S. "
42.75
43
Arthur L. Goodrich
45.0
45
Benjamin Bliss Est.
76.7
76.5
Gideon C. Segur
76.2
77.6

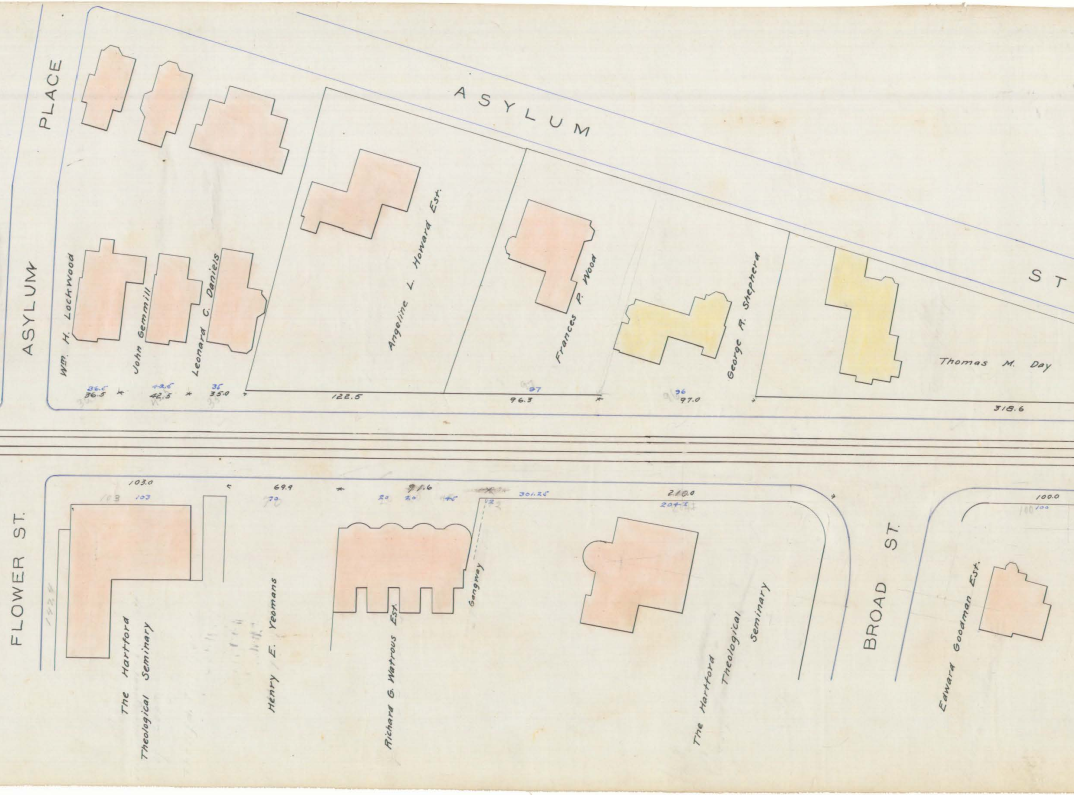
ASYLUM PLACE
ASYLUM ST
Wm. H. Lockwood
John Gemmill
Leonard C. Daniels
Angeline L. Howard Est.
Frances P. Wood
George R. Shepherd
Thomas M. Day
36.6
36.5
42.6
42.5
35
35.0
122.5
97
96.3
96
97.0
318.6
FLOWER ST.
BROAD ST.
103.0
103
69.9
70
91.6
20
20
45
12
301.25
210.0
204.1
100.0
100
The Hartford Theological Seminary
Henry E. Yeomans
Richard G. Watrous Est.
Gangway
The Hartford Theological Seminary
Edward Goodman Est.

CITY ENGINEER'S OFFICE
HARTFORD, CONN.
MISCELLANEOUS DEPT.
Aug 26, 1899 Day Book No. 0643

Correct Aug 29 1899
" Nov 11 1899

Farmington Ave. and Asylum Hill.

Daily run of Asphalt 1913
Scale 1" = 40'

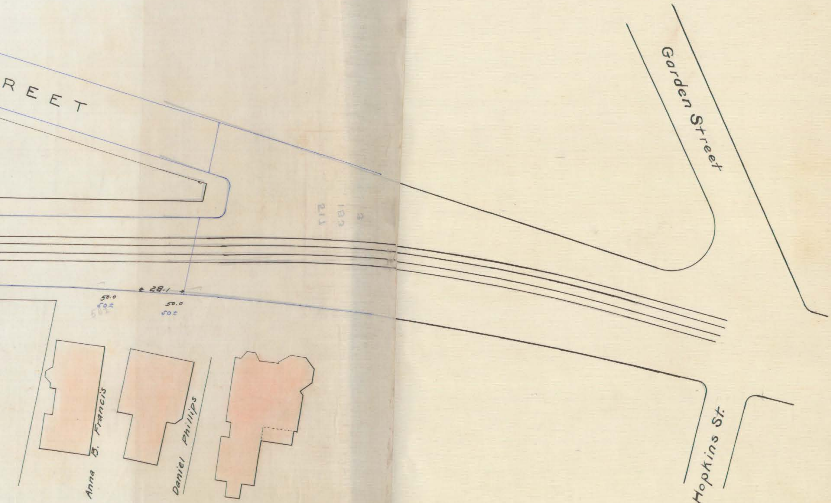
REET
Garden Street
Hopkins St.
28.1
50.0
50±
50.0
50±
Anna B. Francis
Daniel Phillips
3
183