
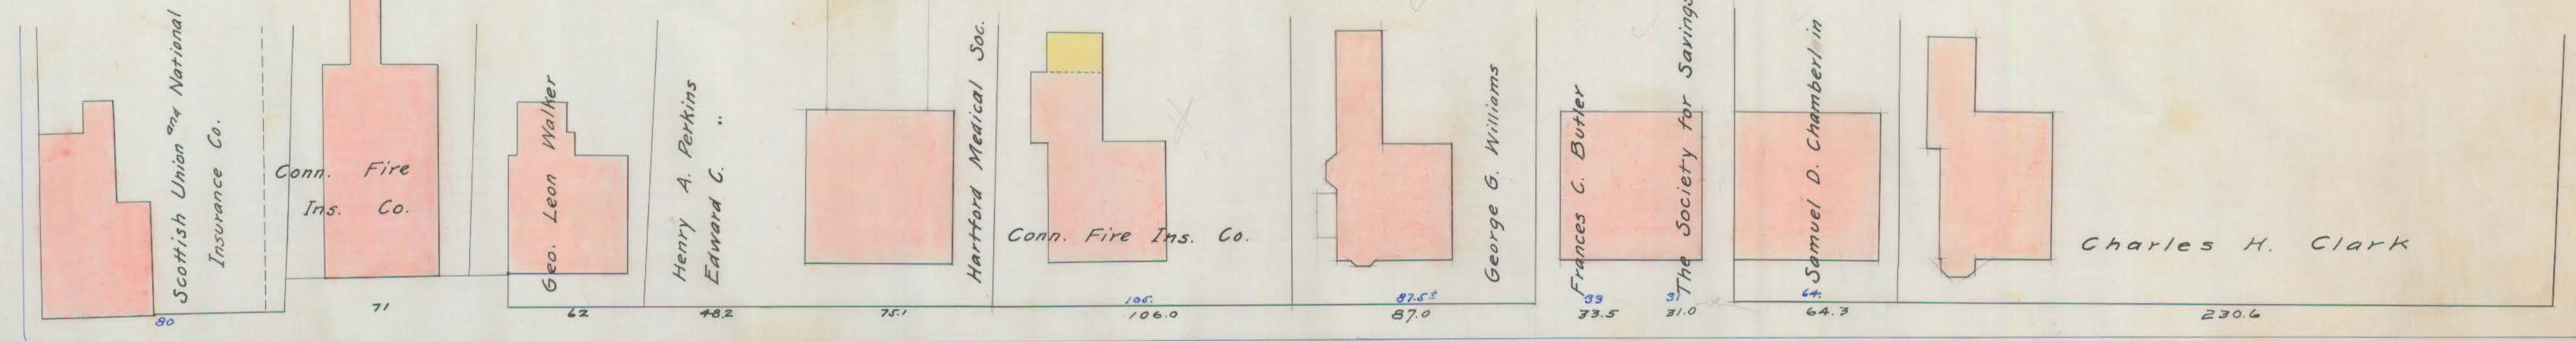


1893
255


1893
255

PROSPECT STREET
Scale 1" = 40'


ROW

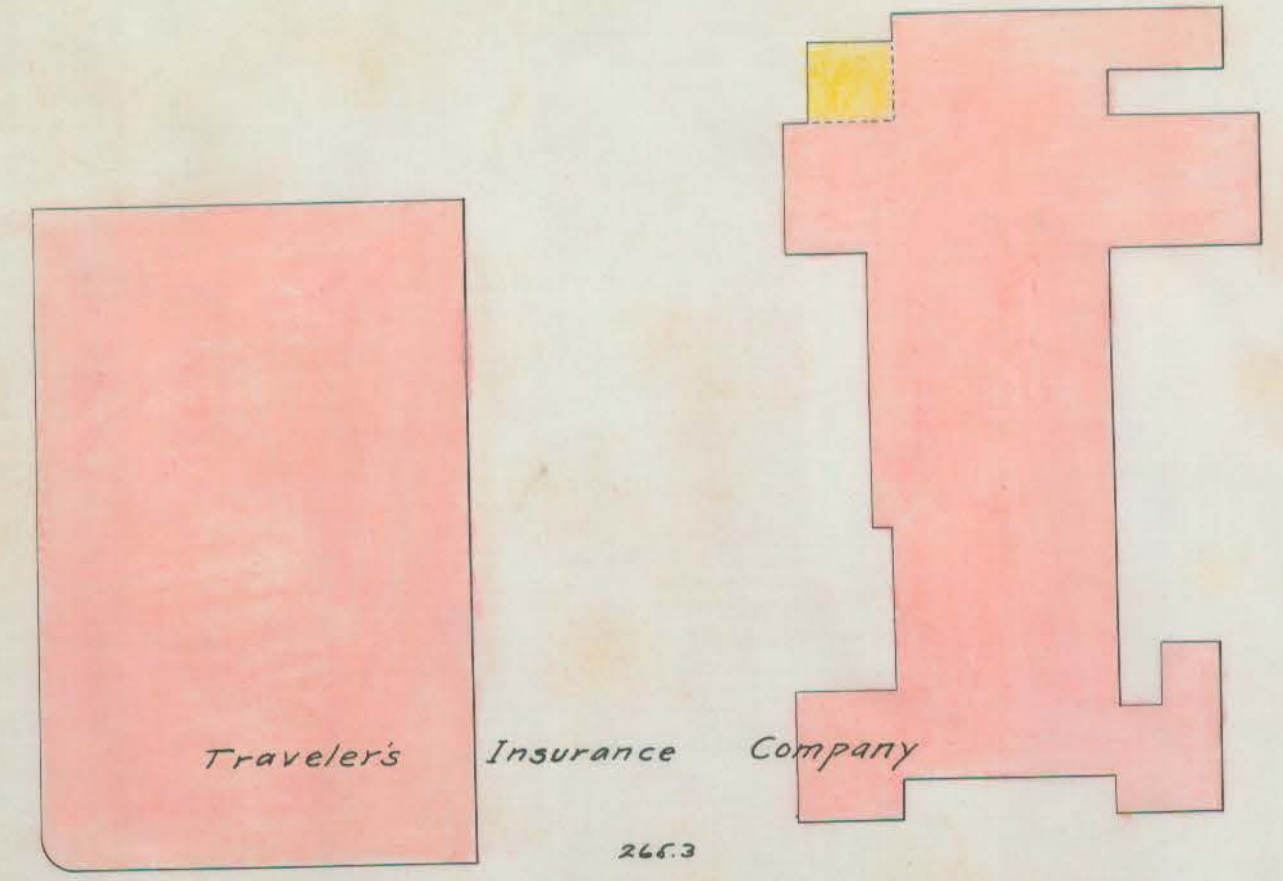


CENTRAL

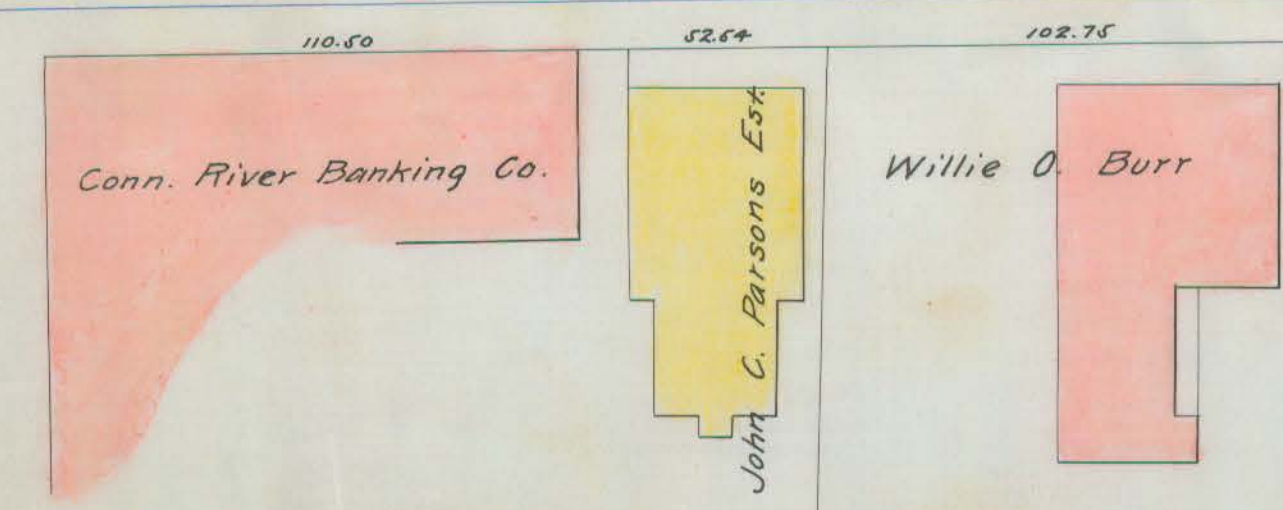

GROVE ST.

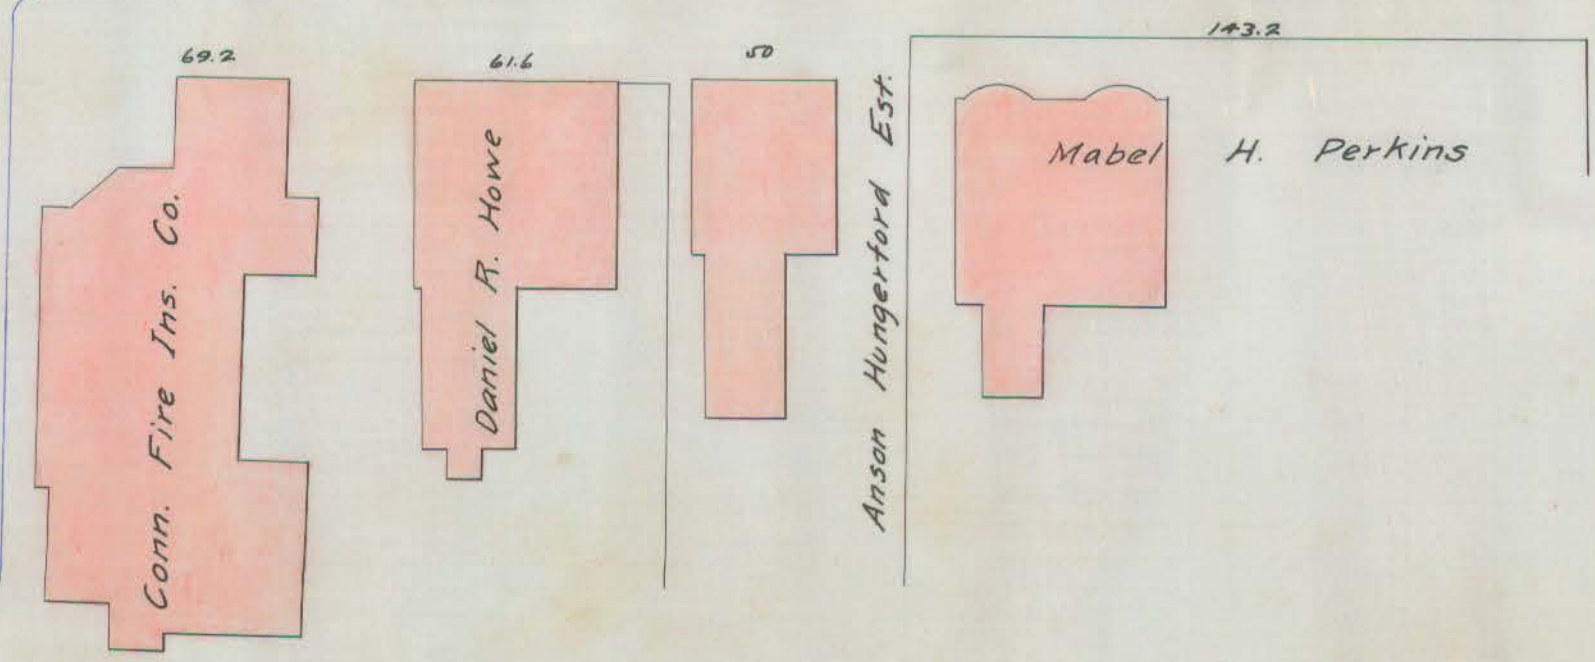

ATHENEUM ST.

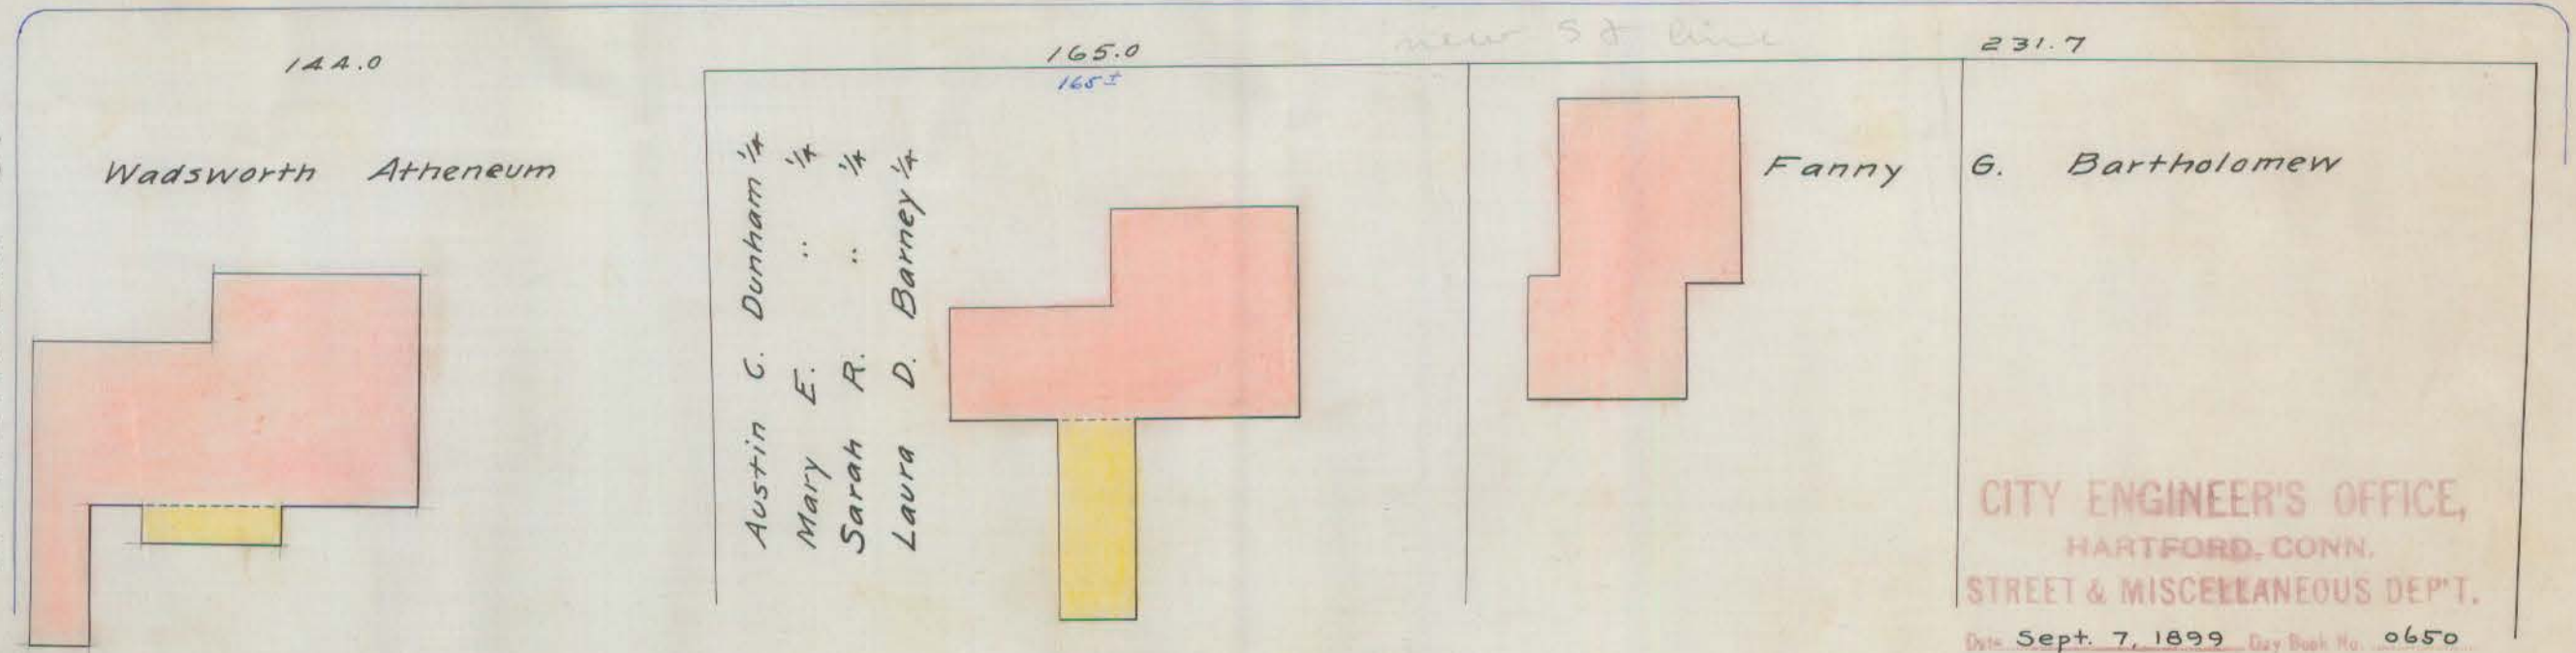

ARCH

CITY ENGINEER'S OFFICE,
HARTFORD, CONN.
STREET & MISCELLANEOUS DEPT.
Date Sept. 7, 1899 Day Book No. 0650

Ownership Corrected to Sep 7 1899