


North

TEMPLE ST.

FRONT ST.

CHARLES ST.

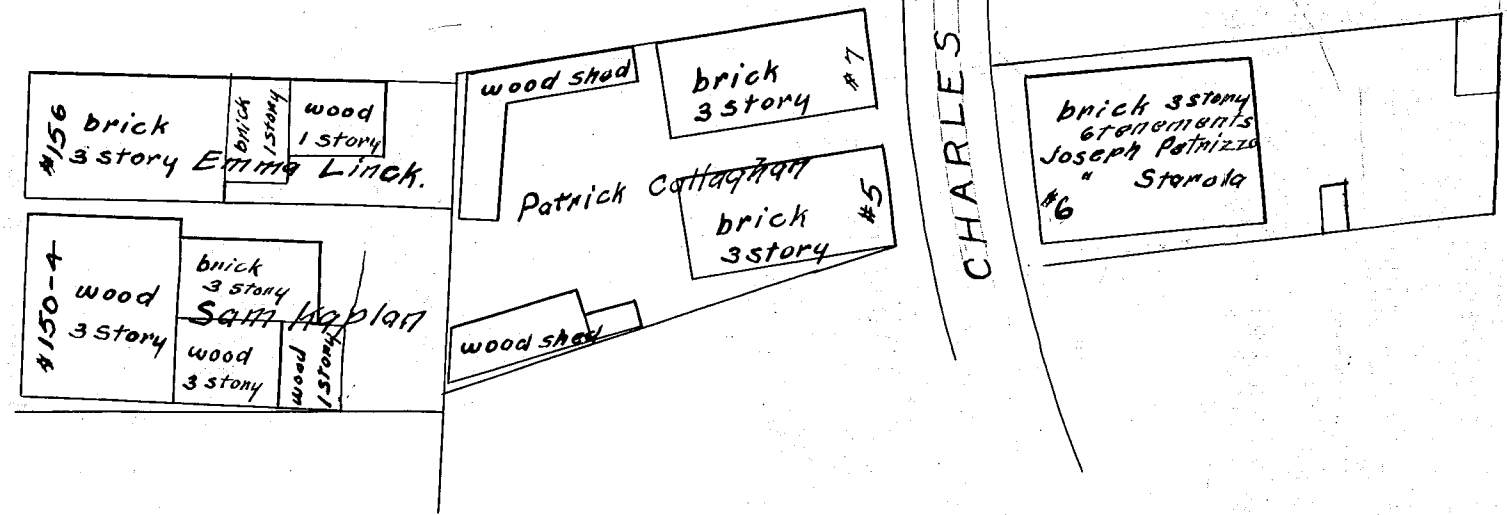

- Front St.
 #156 2 Tenements 1 baker shop + store
 #150 Meat market #154 5 tenements.
 Charles St.
 #5 + 7 4 tenements and 1 store each.
 #6 6 tenements.

02134