



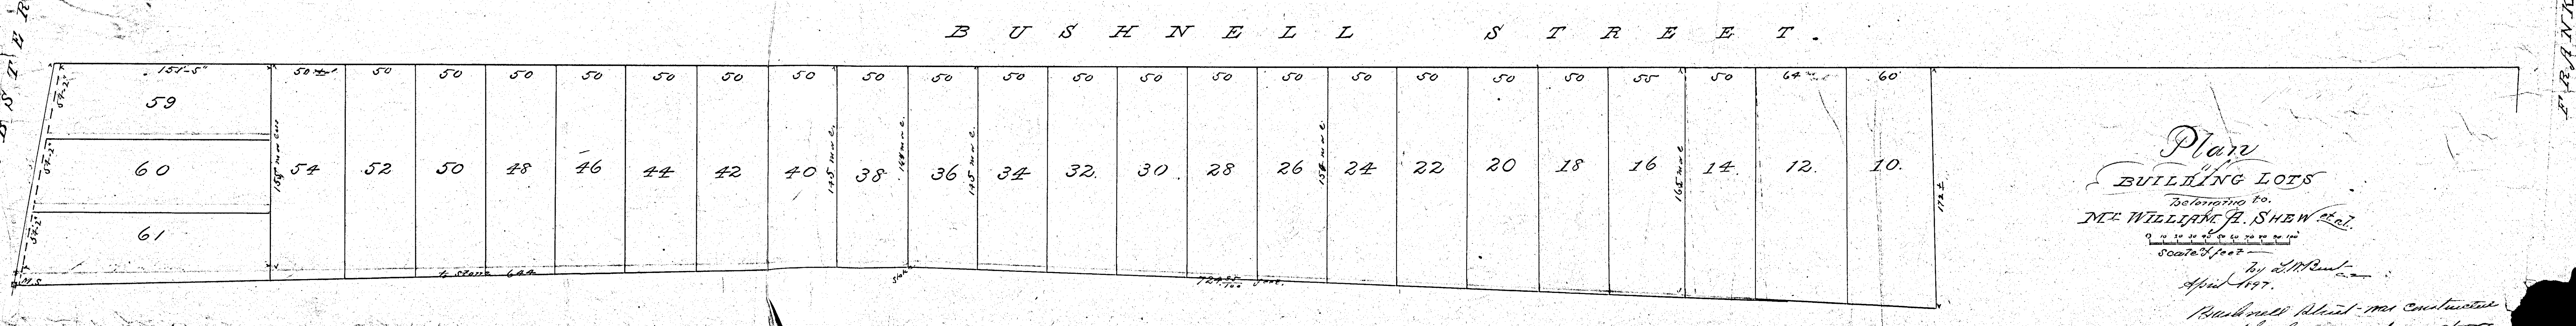

belonging to.
 MR WILLIAM A. SHEW & c^o.
 0 10 20 30 40 50 60 70 80 90 100
 Scale of feet —

By A. M. Bent
April 1897.

Bushnell Street - was constructed
on the lines as shown above.