


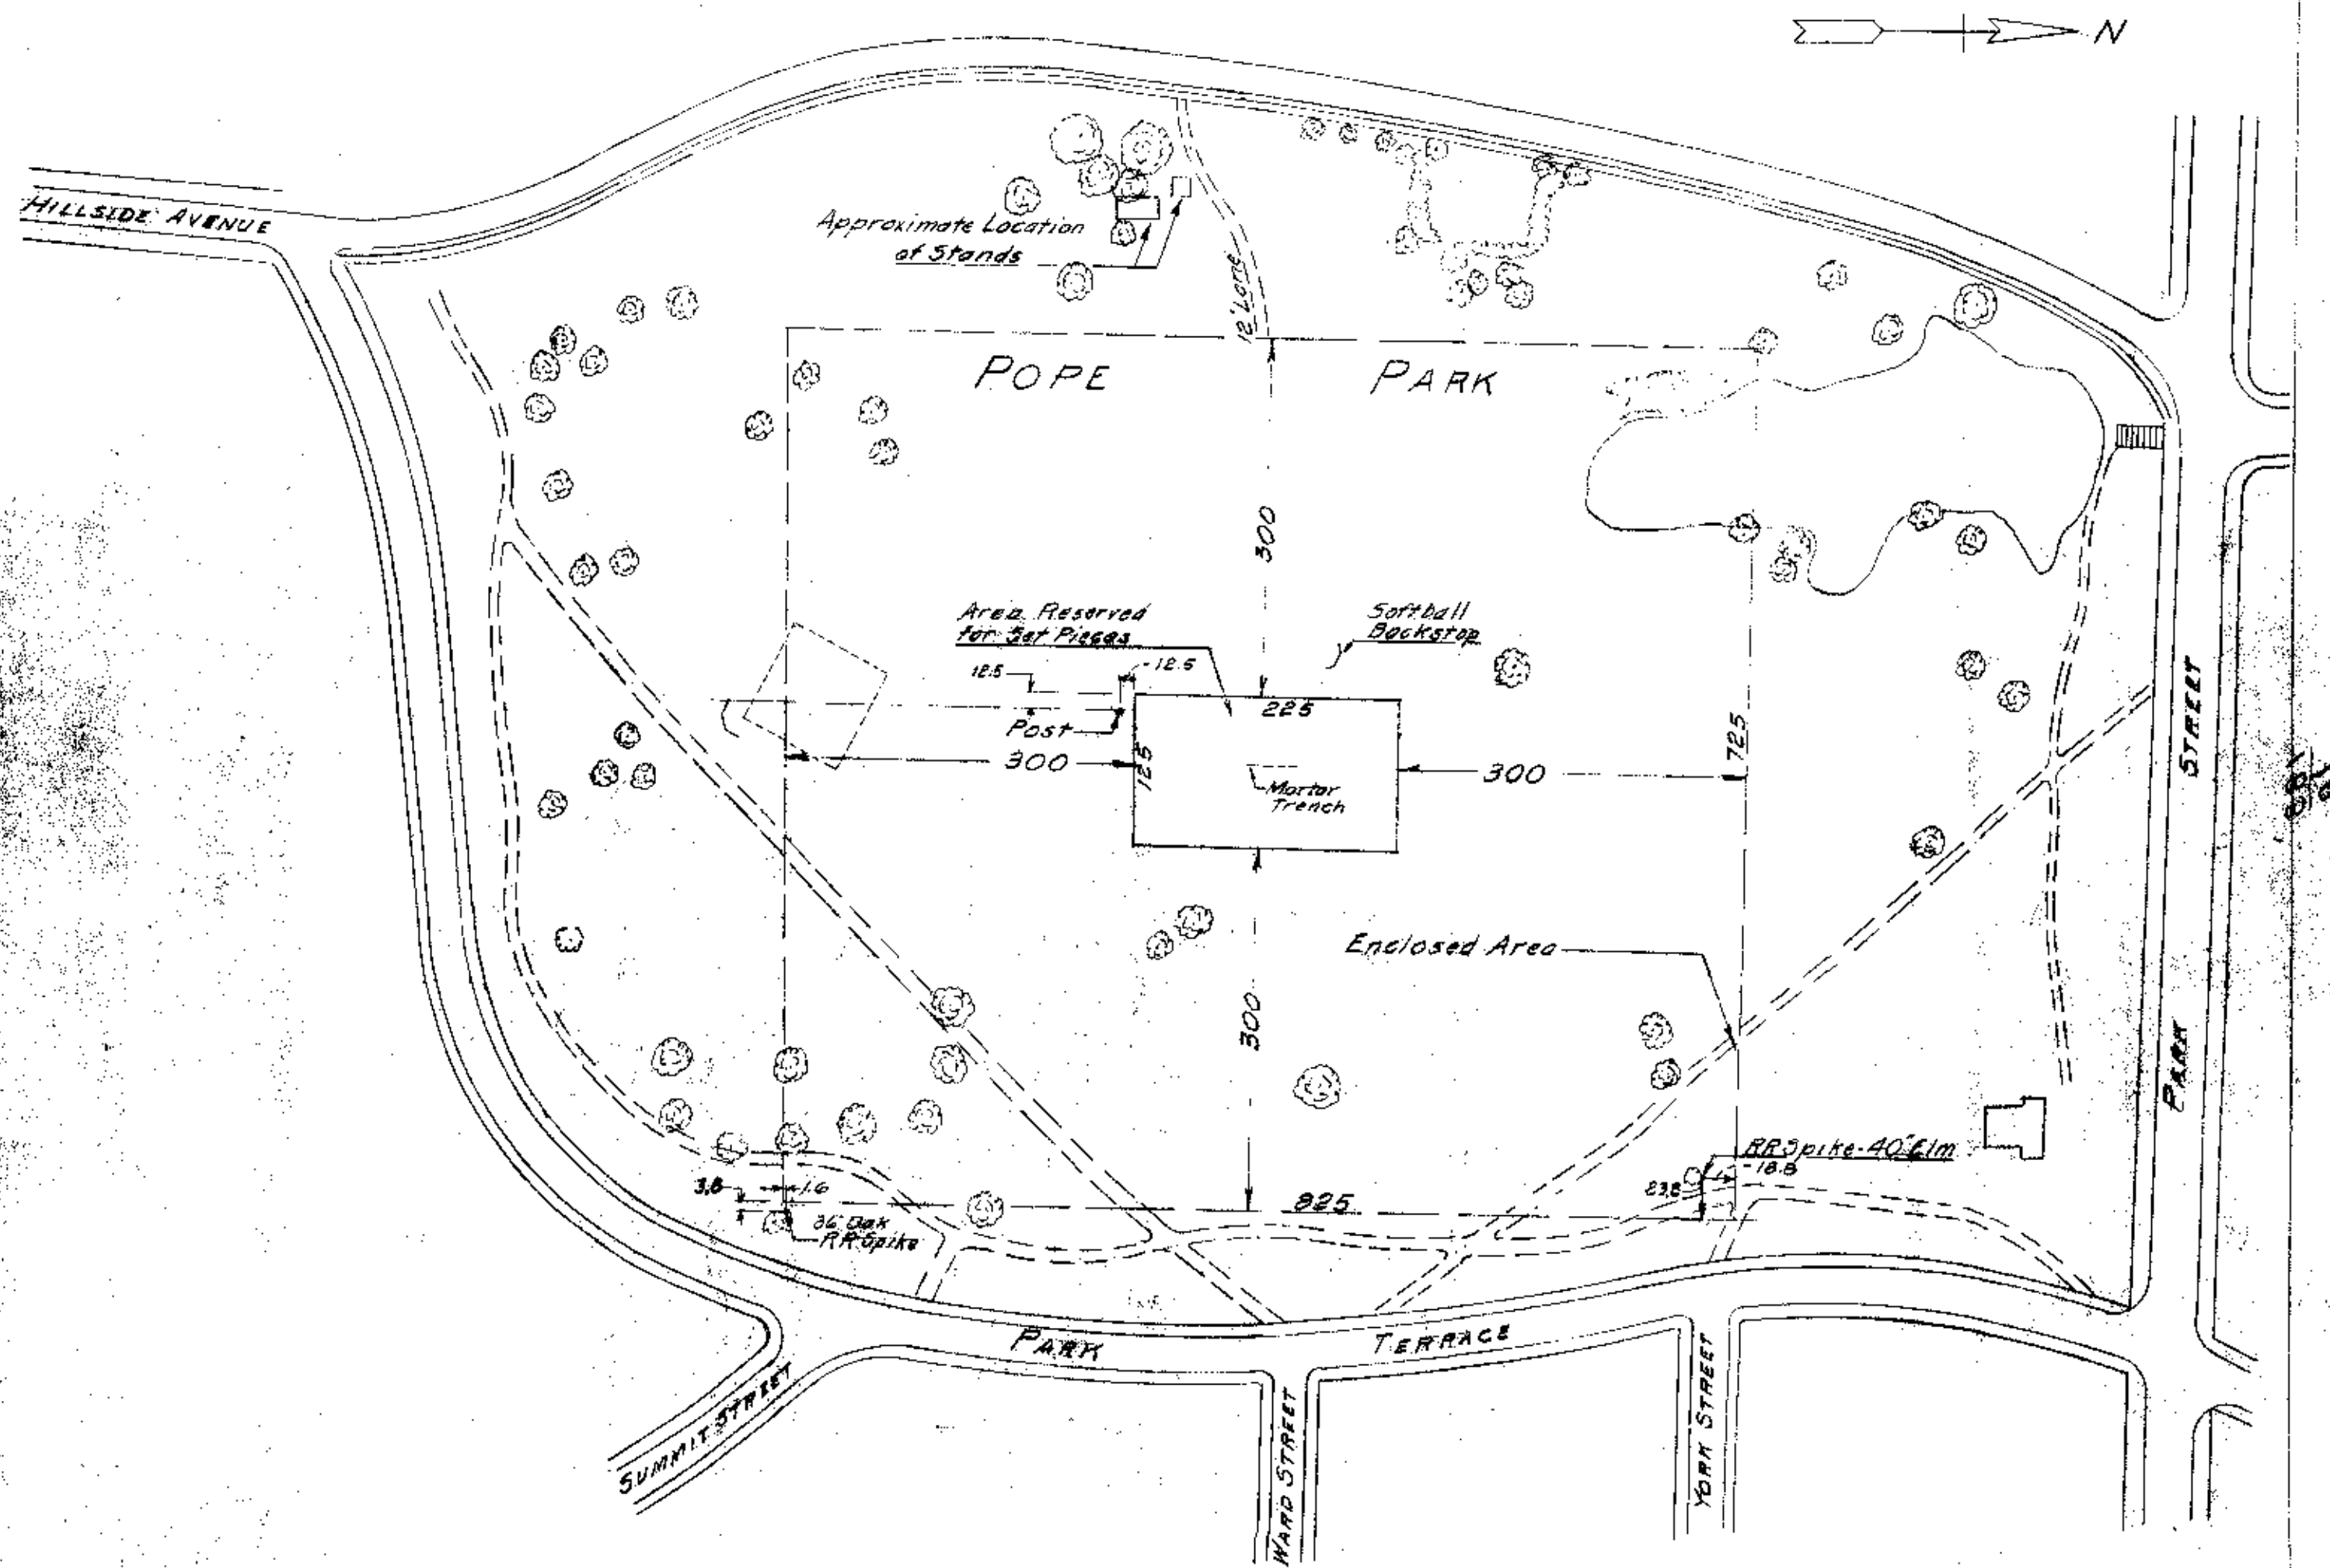

Revision of May 3, 1960
 Lengths of areas increased 25 feet
 Revision of June 12, 1956
 Lengths of areas increased 50 feet

CITY OF HARTFORD
 DEPARTMENT OF ENGINEERING
 MAY 1954