


Out of Service

Dec. 22-1937

Street and H I L L S I D E Veranda Lines of April 18, 1910 Vol. 5-254. A V E N U E Jan. 8, 1912 Vol. 5-317

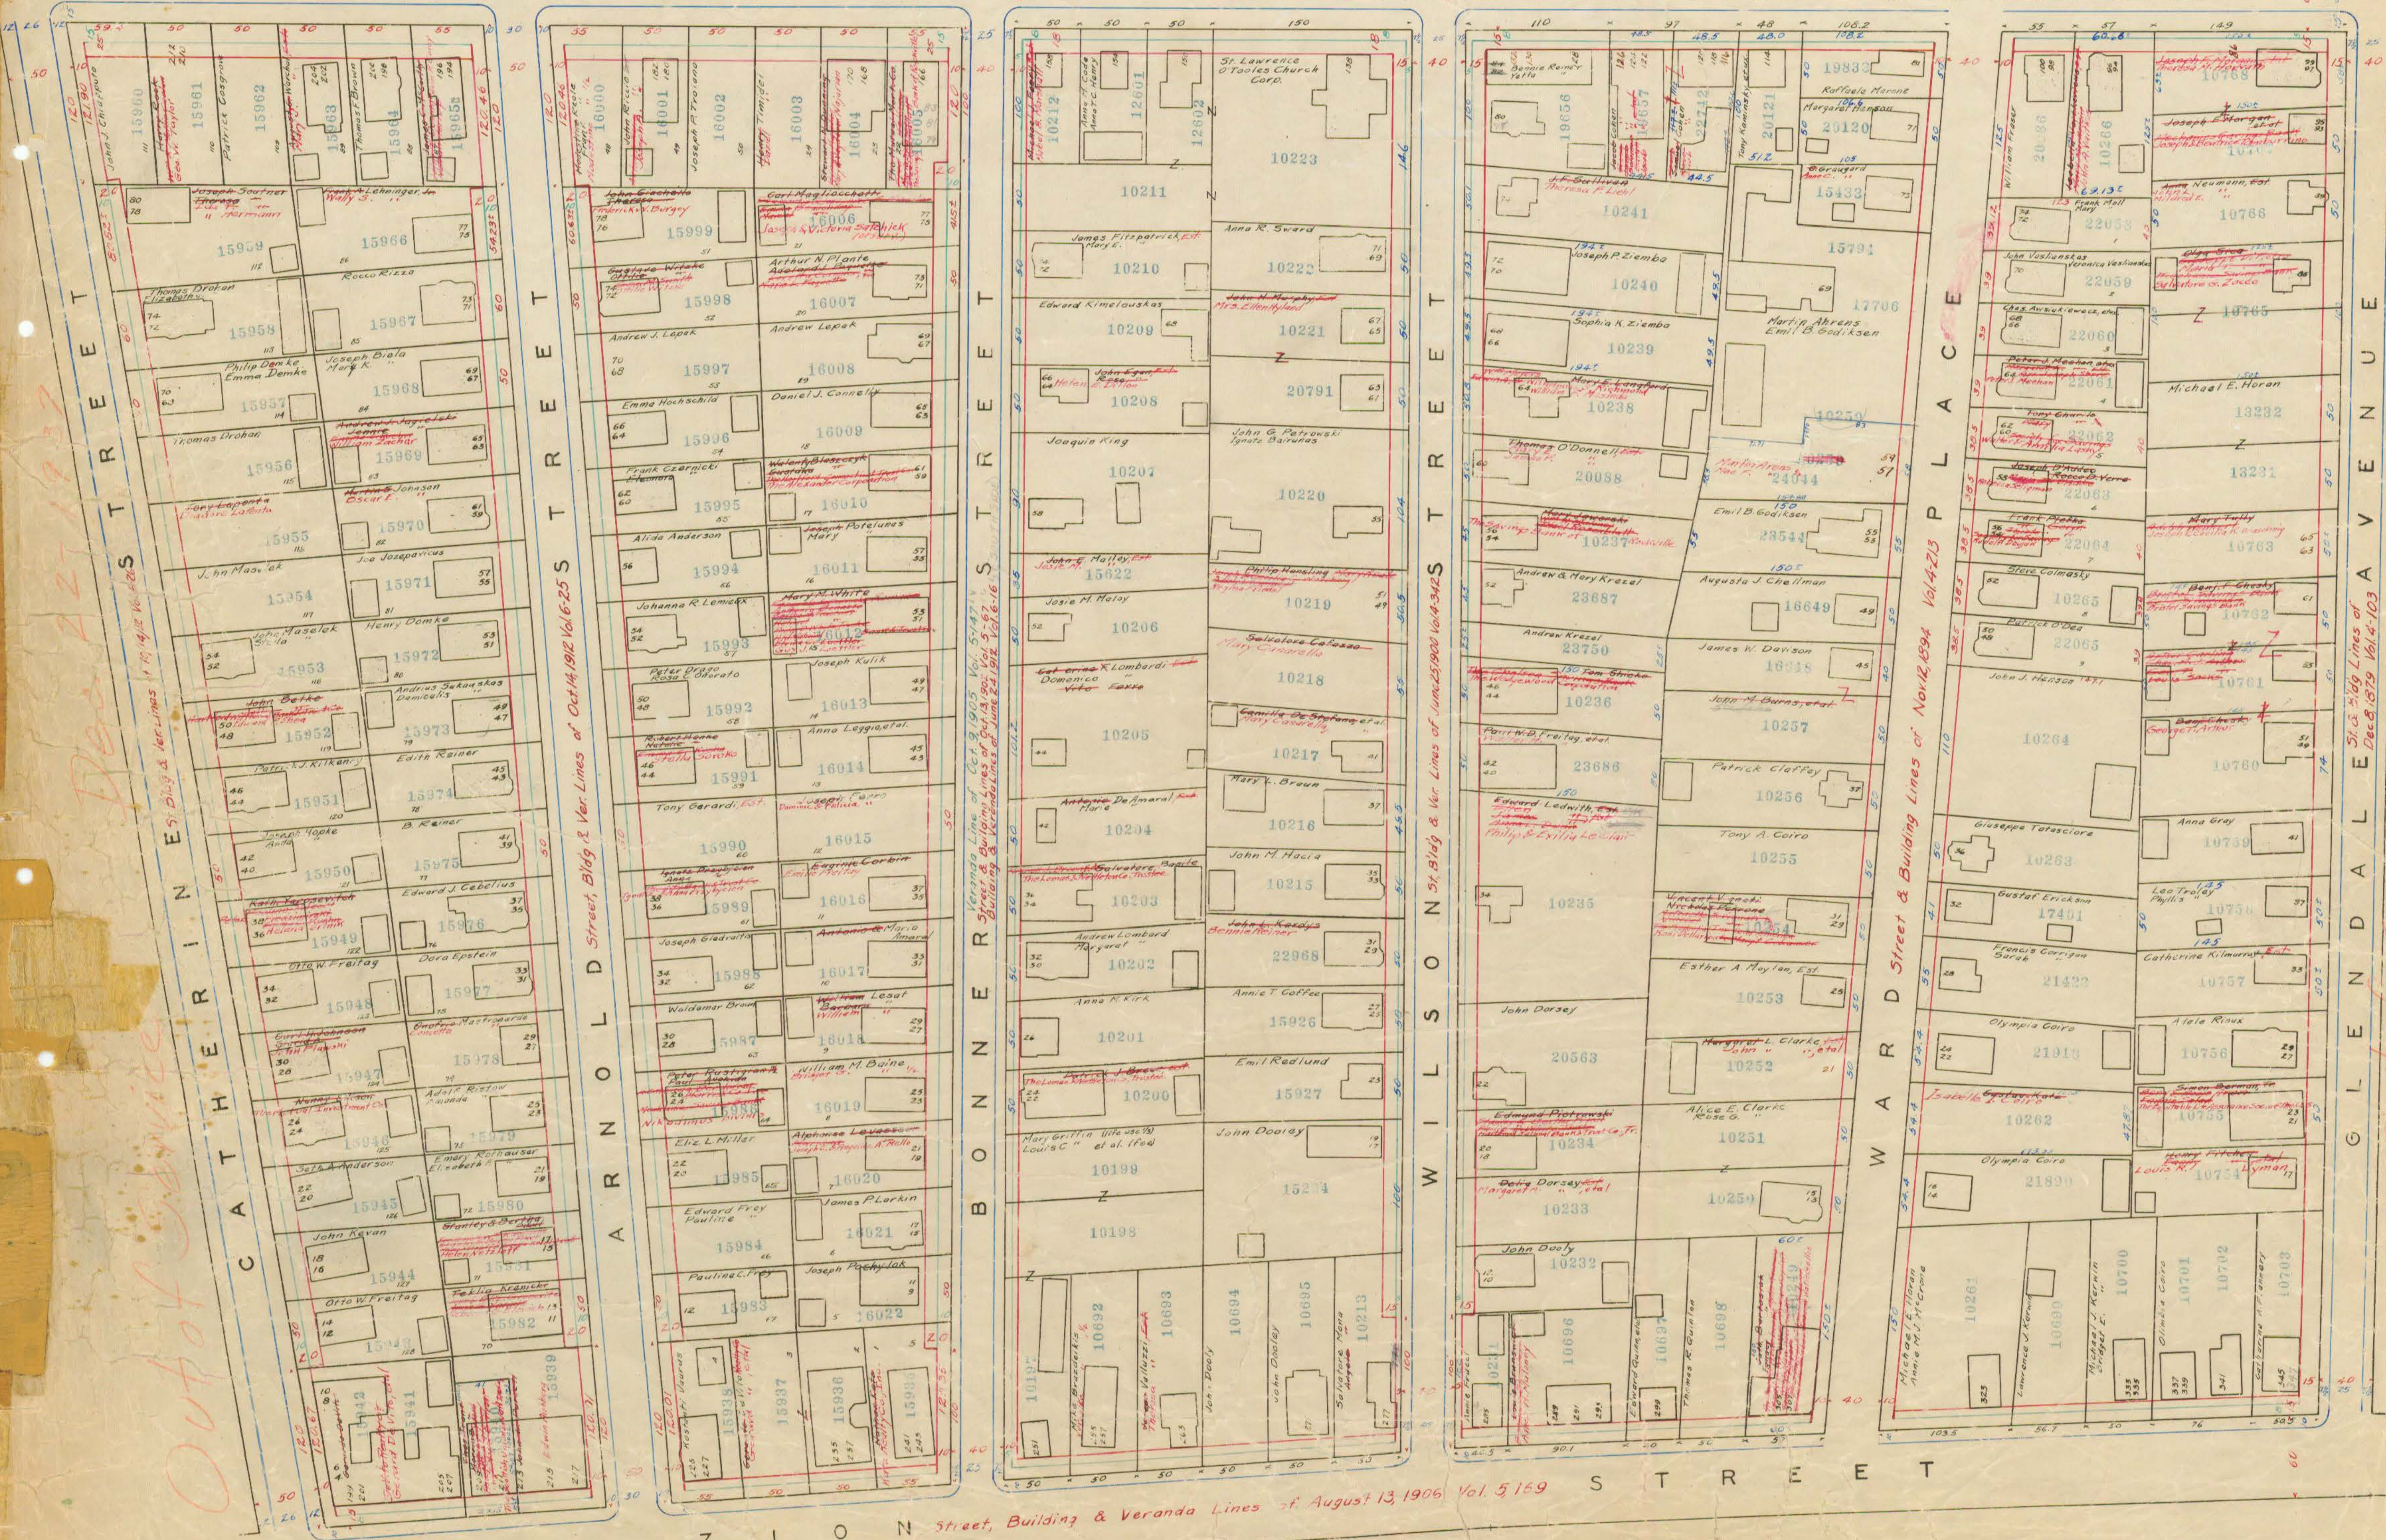

Out of Service Dec. 22-1937