


54005

196
125196
125

Street and H I L L S I D E Veranda Lines of April 18, 1910 Vol. 5 - 259
Building Lines of Sept. 26, 1898 - Volume 7 - page 230

Jan. 6, 1912 - A V E N U E Volume 5 - page 31

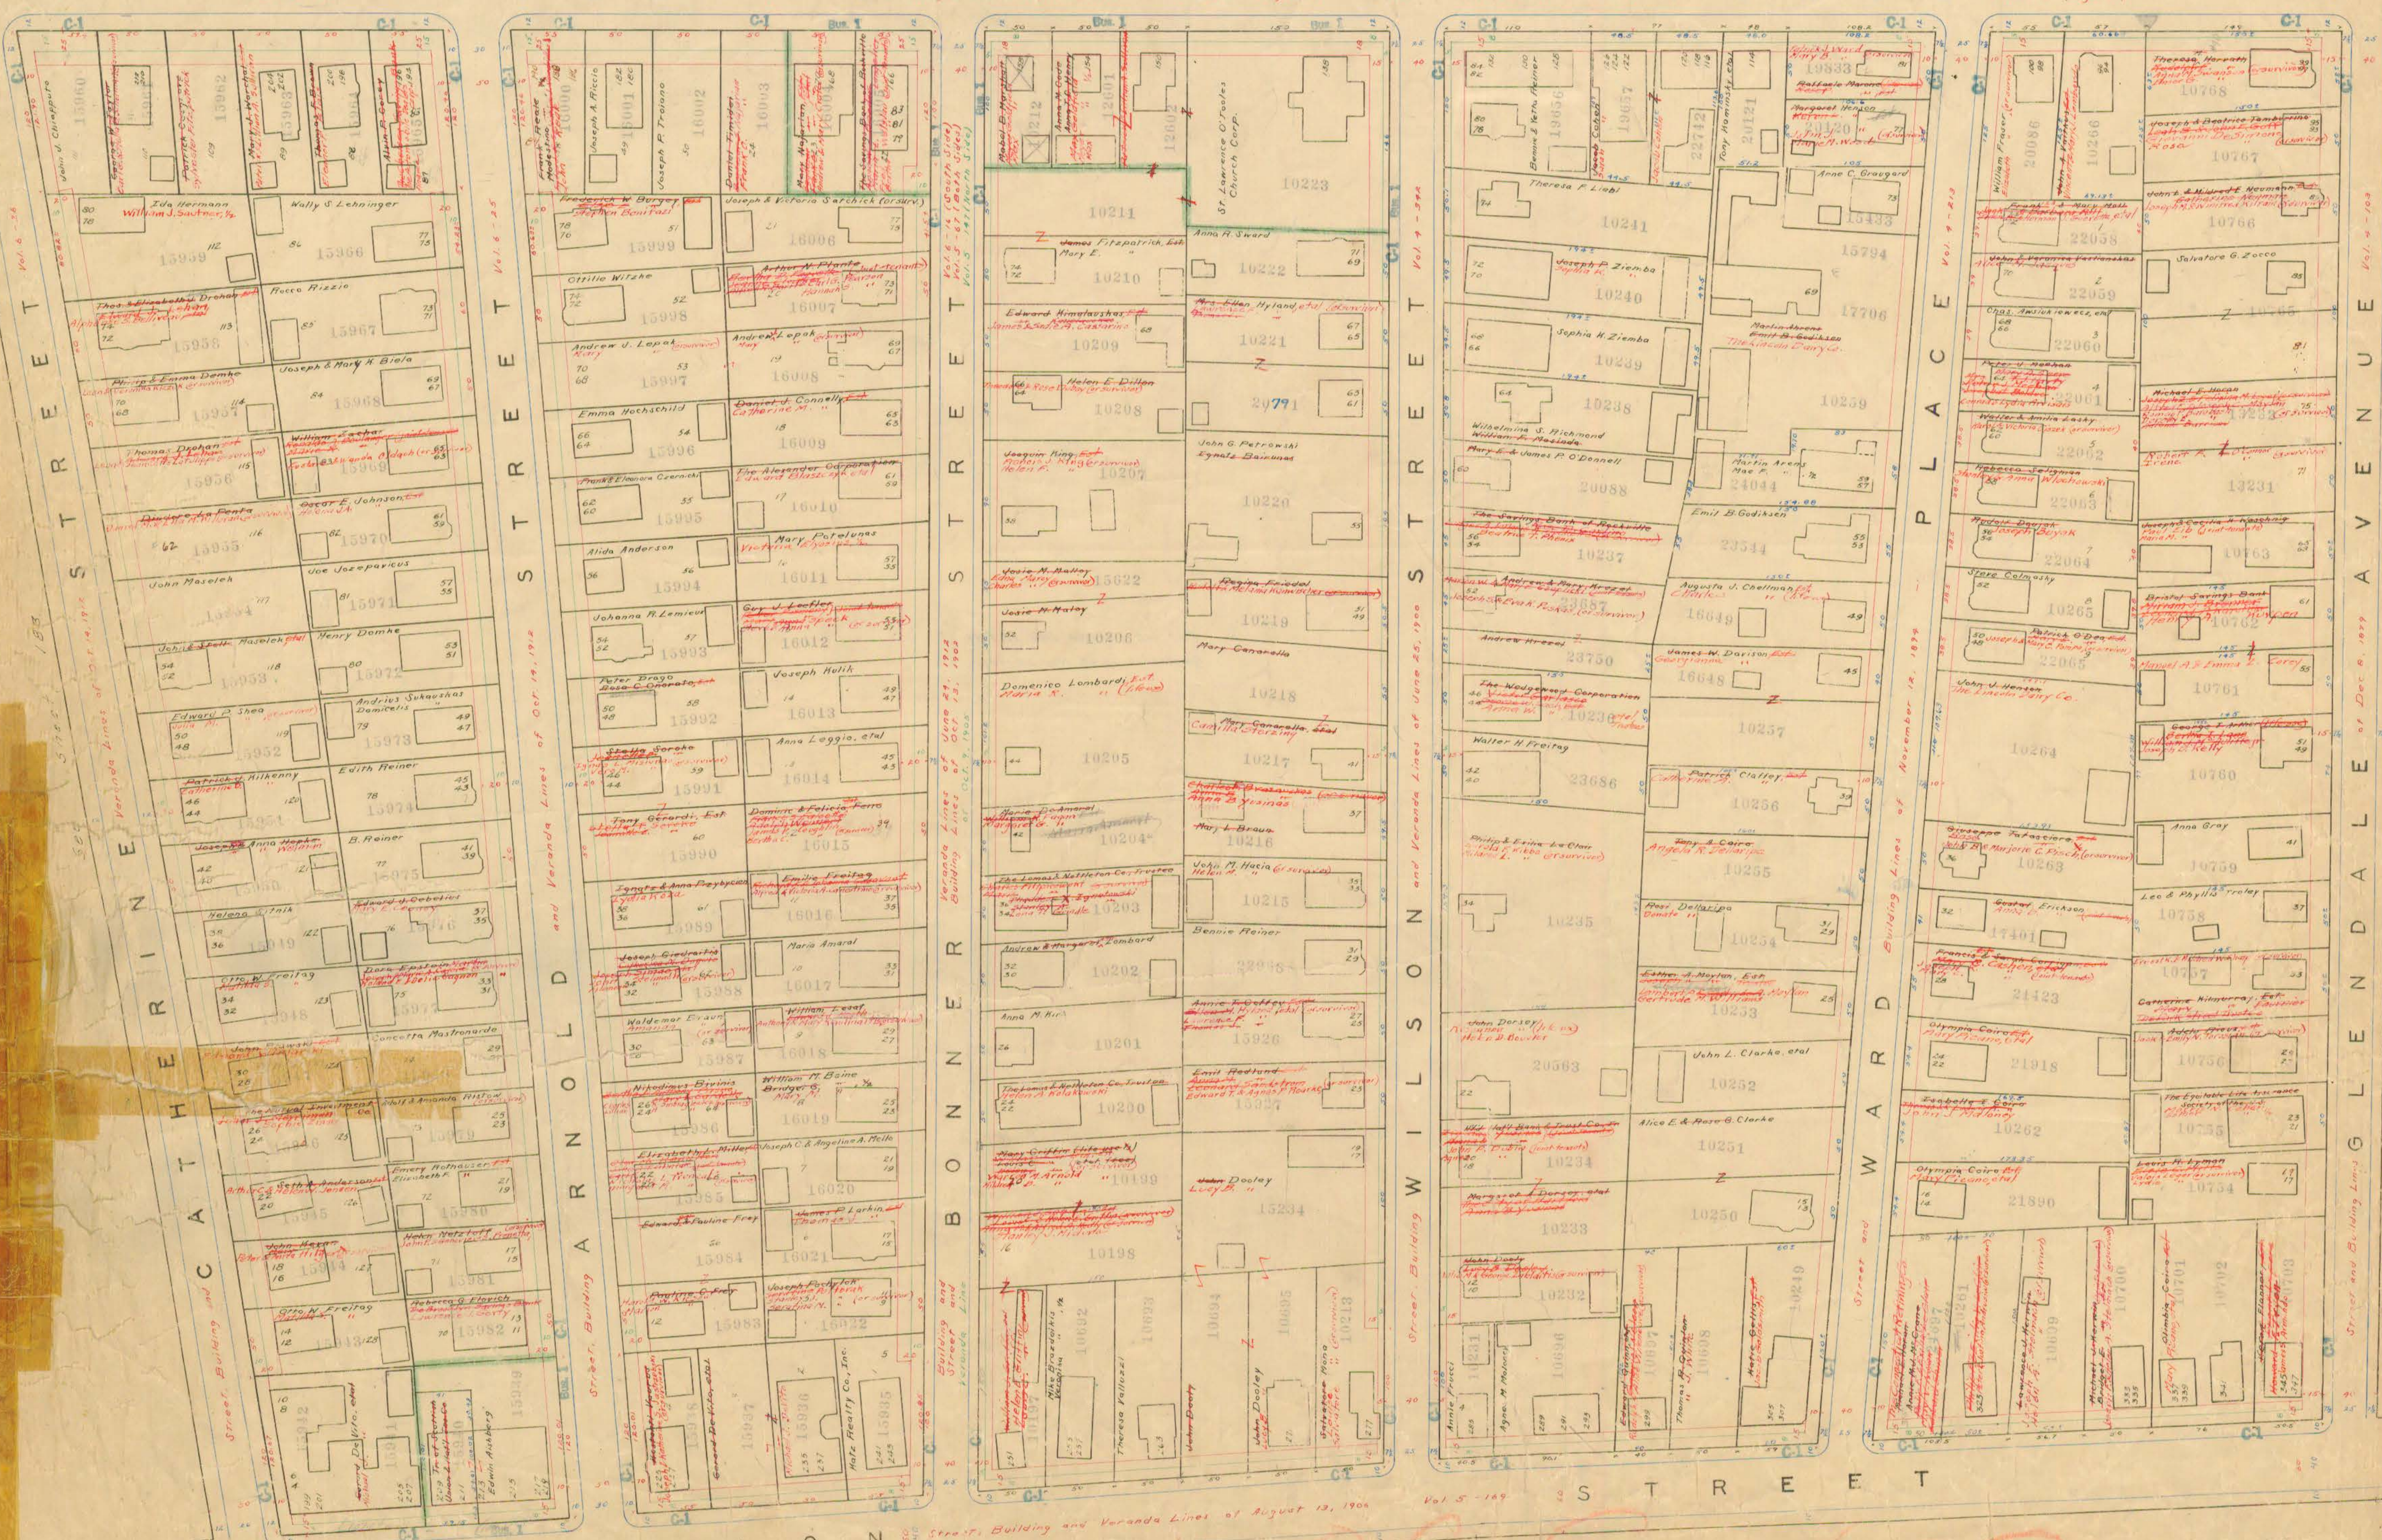

City of Hartford
Dept. of Engineering
Feb. 1928

Area on this sheet formerly
part of Sheet 105, 100 Scale

(184)