


FRANKLIN AVENUE

SCALE — $\begin{cases} \text{VERT. } 1" = 10' \\ \text{HORI. } 1" = 100' \end{cases}$

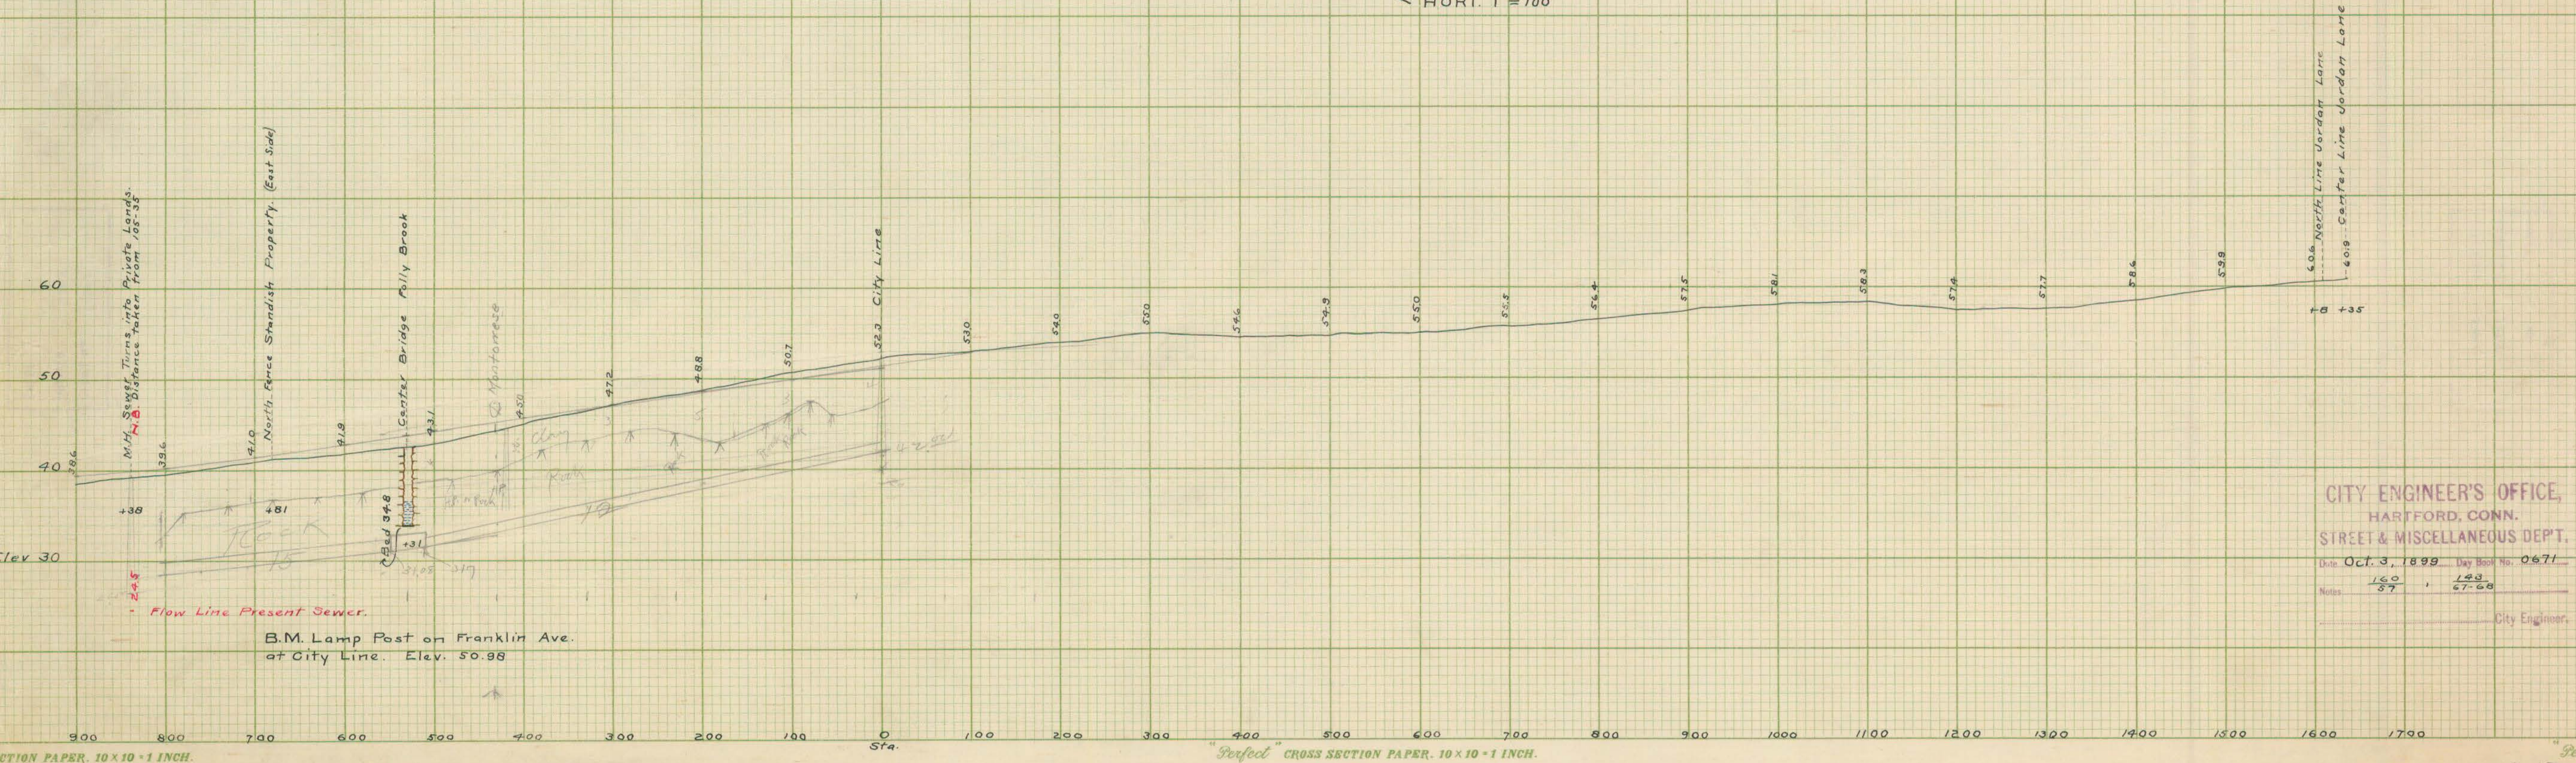

CITY ENGINEER'S OFFICE,
HARTFORD, CONN.
STREET & MISCELLANEOUS DEPT.

Date Oct. 3, 1899 Day Book No. 0671

Notes $\frac{160}{57}$, $\frac{143}{67-68}$

City Engineer.