


LORRAINE STREET

SCALE VERT 1" = 10'
HORI. 1" = 50'

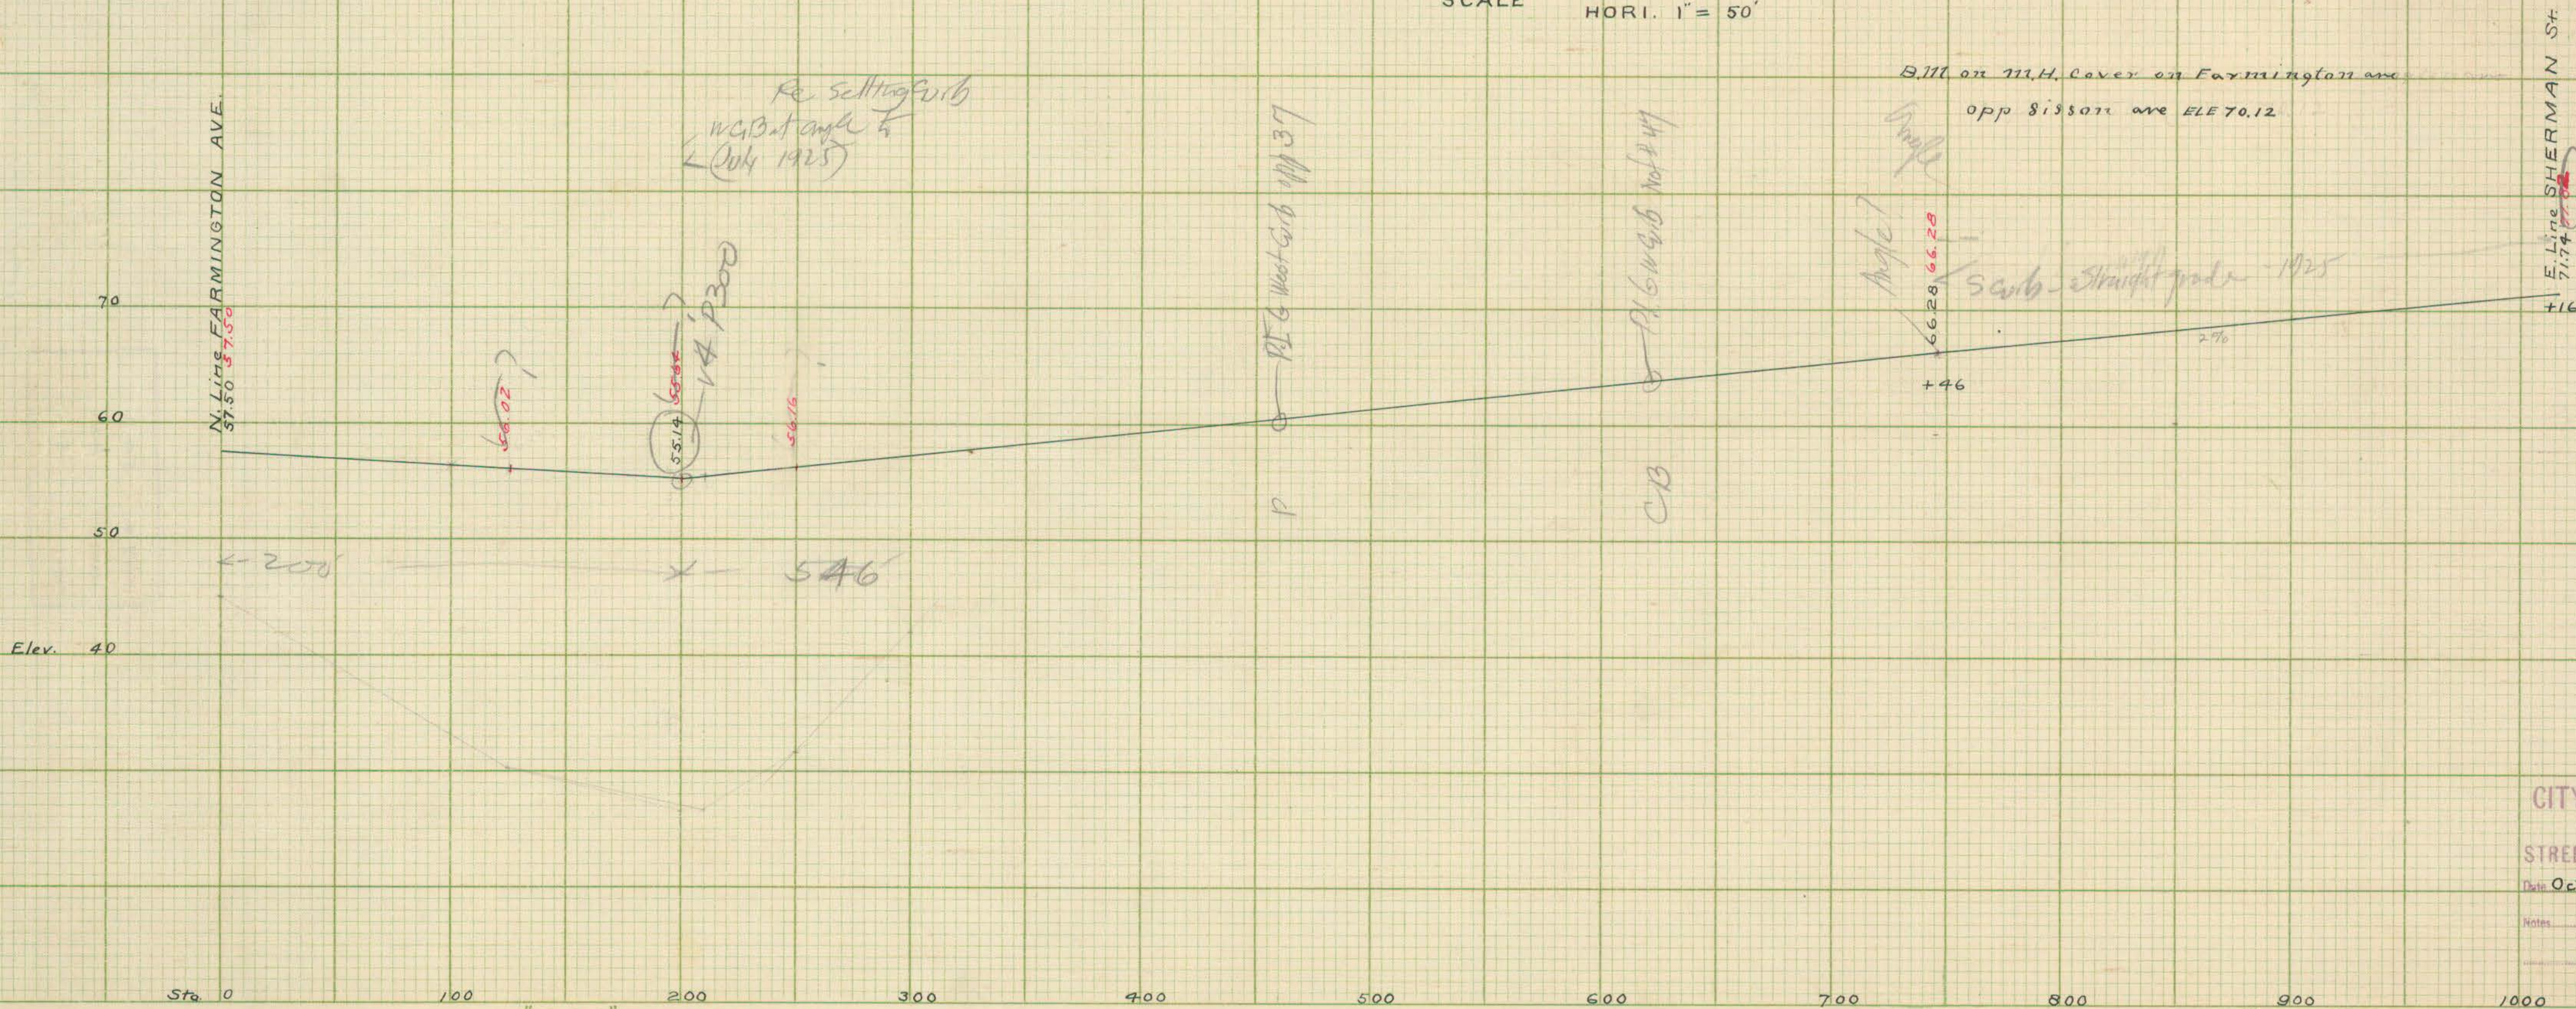

CITY ENGINEER'S OFFICE,
HARTFORD, CONN.
STREET & MISCELLANEOUS DEPT.
Date Oct. 6, 1899 Day Book No. 0673

Notes _____
City Engineer _____