


DEVVEY AVENUE

Scale — 1" Hori. = 50'
1" Vert. = 10'

B. M. # 178 - Stone Water Table N. E. Cor.
House on S. cor. Bellevue and Pavilion Sts.
Elev. 76.97

Grade Changed From Red Line to Blue

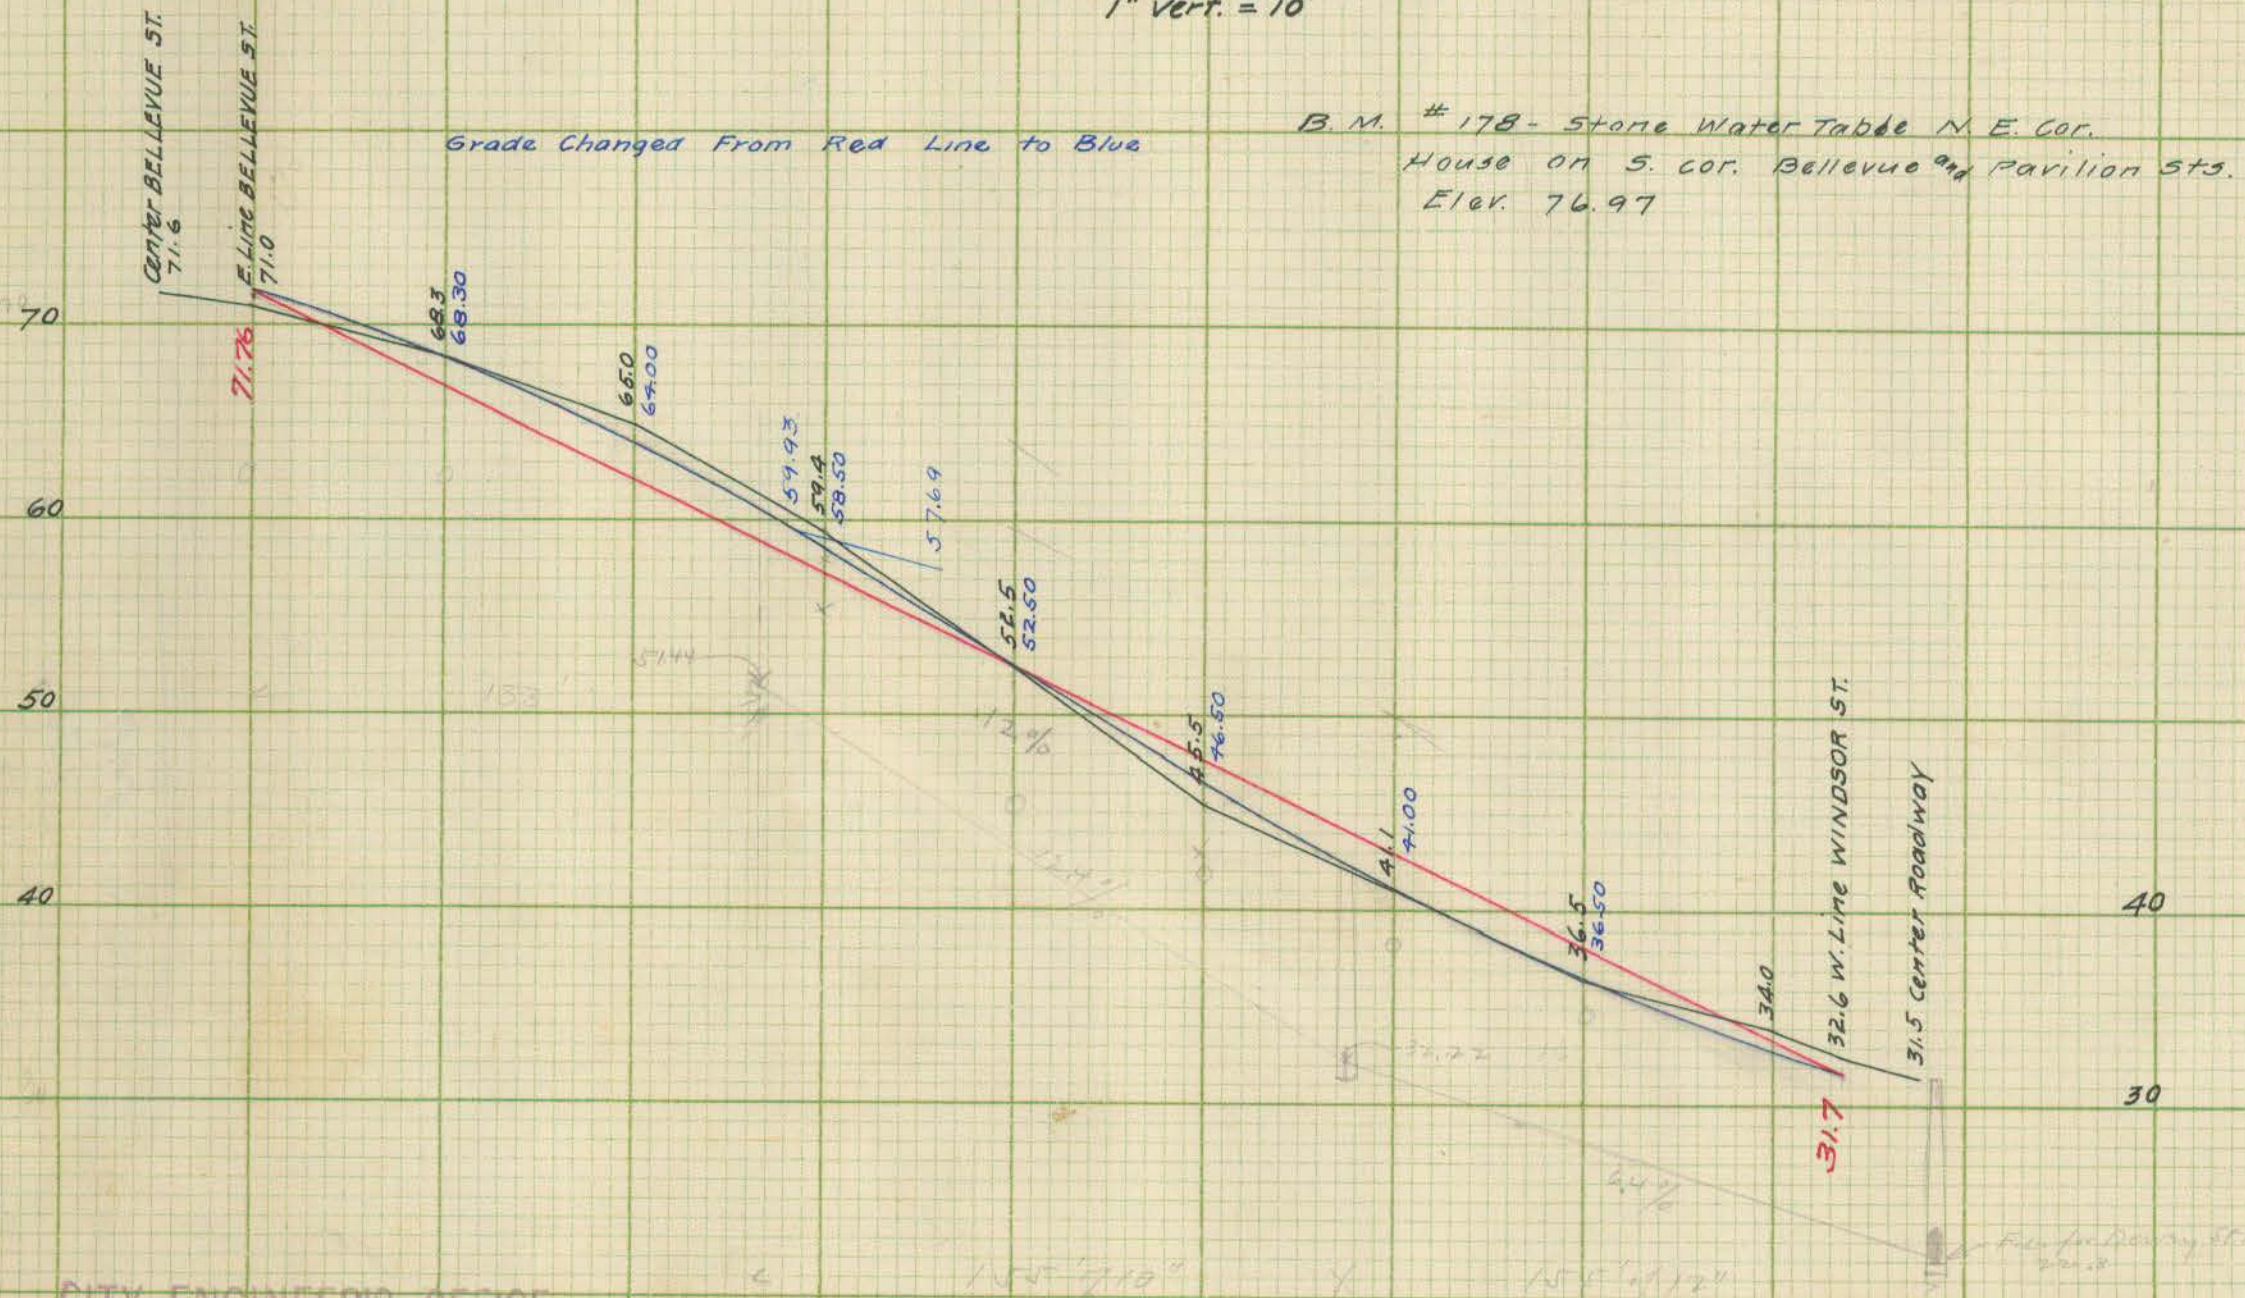

CITY ENGINEER'S OFFICE,
HARTFORD, CONN.
STREET & MISCELLANEOUS DEPT.

Date Oct. 17, 1899 Day Book No. 0678

Notes Vol. 160 Pg. 59

City Engineer.

"Perfect" CROSS SECTION PAPER. 10 x 10 = 1 ¹⁰⁰ INCH.

"Perfect" CROSS S