


300

200

100

Park St. Profile of Track Under R. R. Bridge

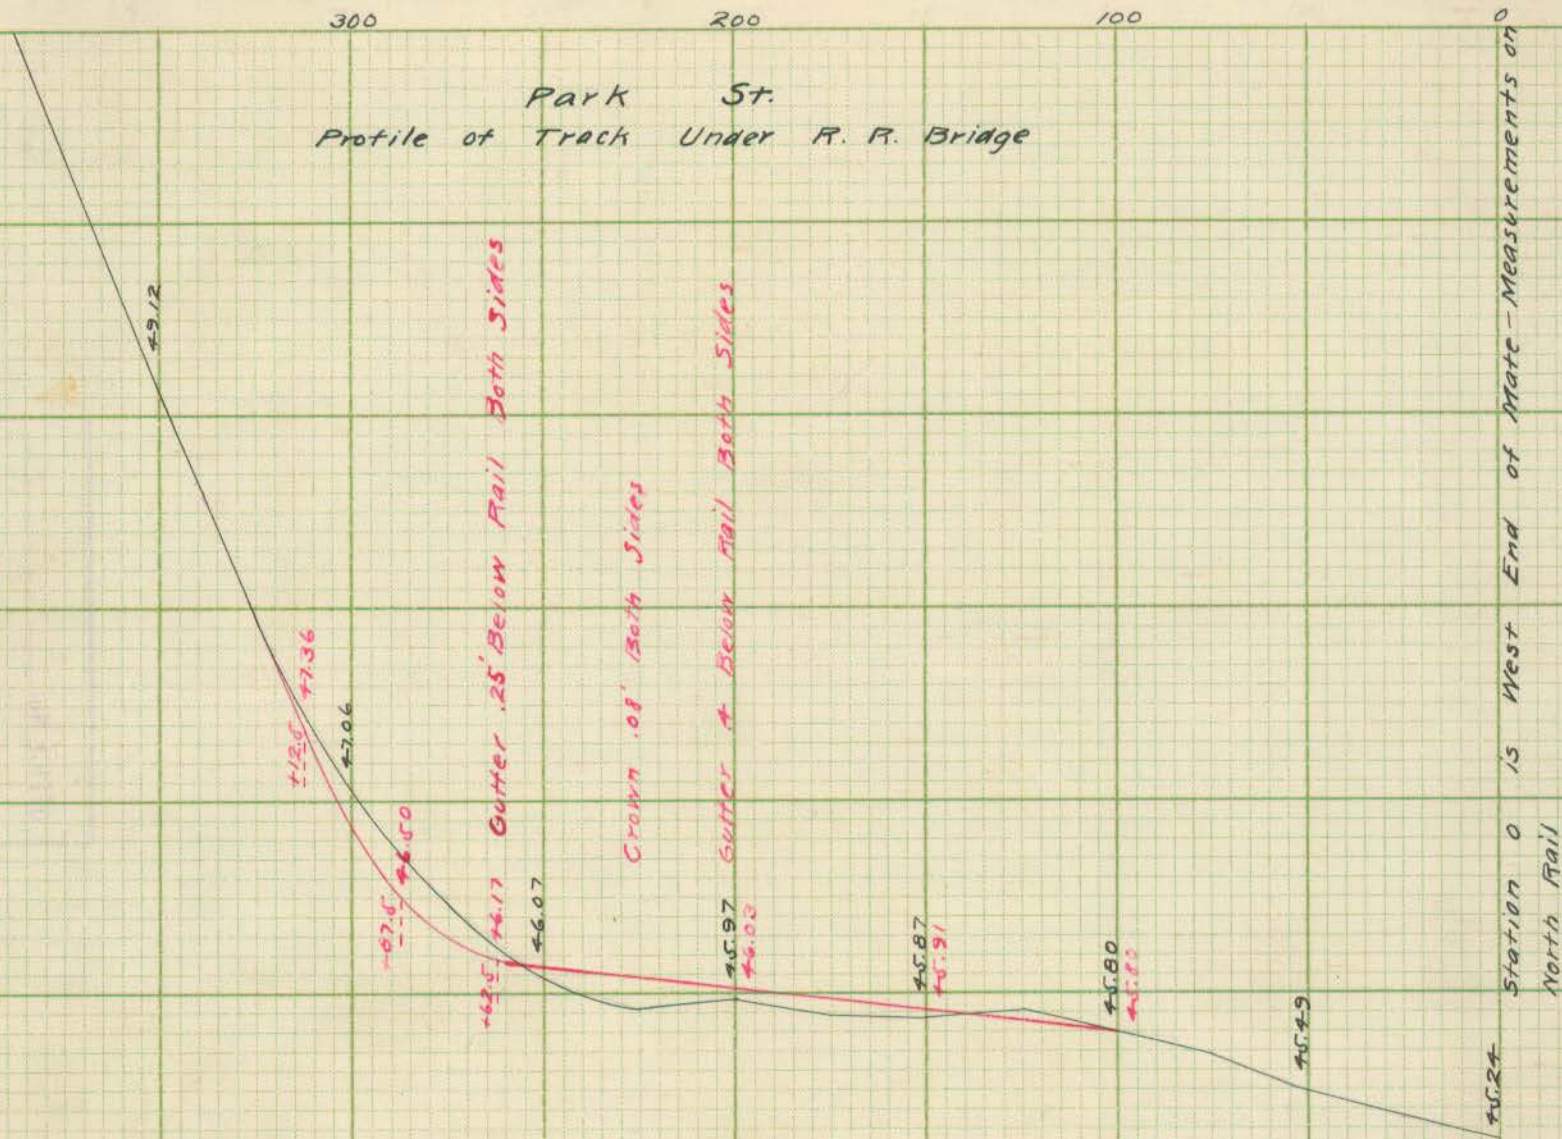

B.M. Elev 50.00 (Assumed)
Hydrant on South Side at East
End of R.R. Bridge

B.M. 40.73
S.E. Nut in Base of East Post
on North Side