

HAWTHORNE STREET

SCALE $\left\{ \begin{array}{l} \text{VERT. } 1" = 10' \\ \text{HORI. } 1" = 50' \end{array} \right.$


CITY ENGINEER'S OFFICE,
HARTFORD, CONN.
STREET & MISCELLANEOUS DEPT.

Dec. 11, 1899 Day Book No. 0704

$\frac{142}{63}$

City Engineer

Hydrazet B.M. 157.897
N. Side Hawthorn st

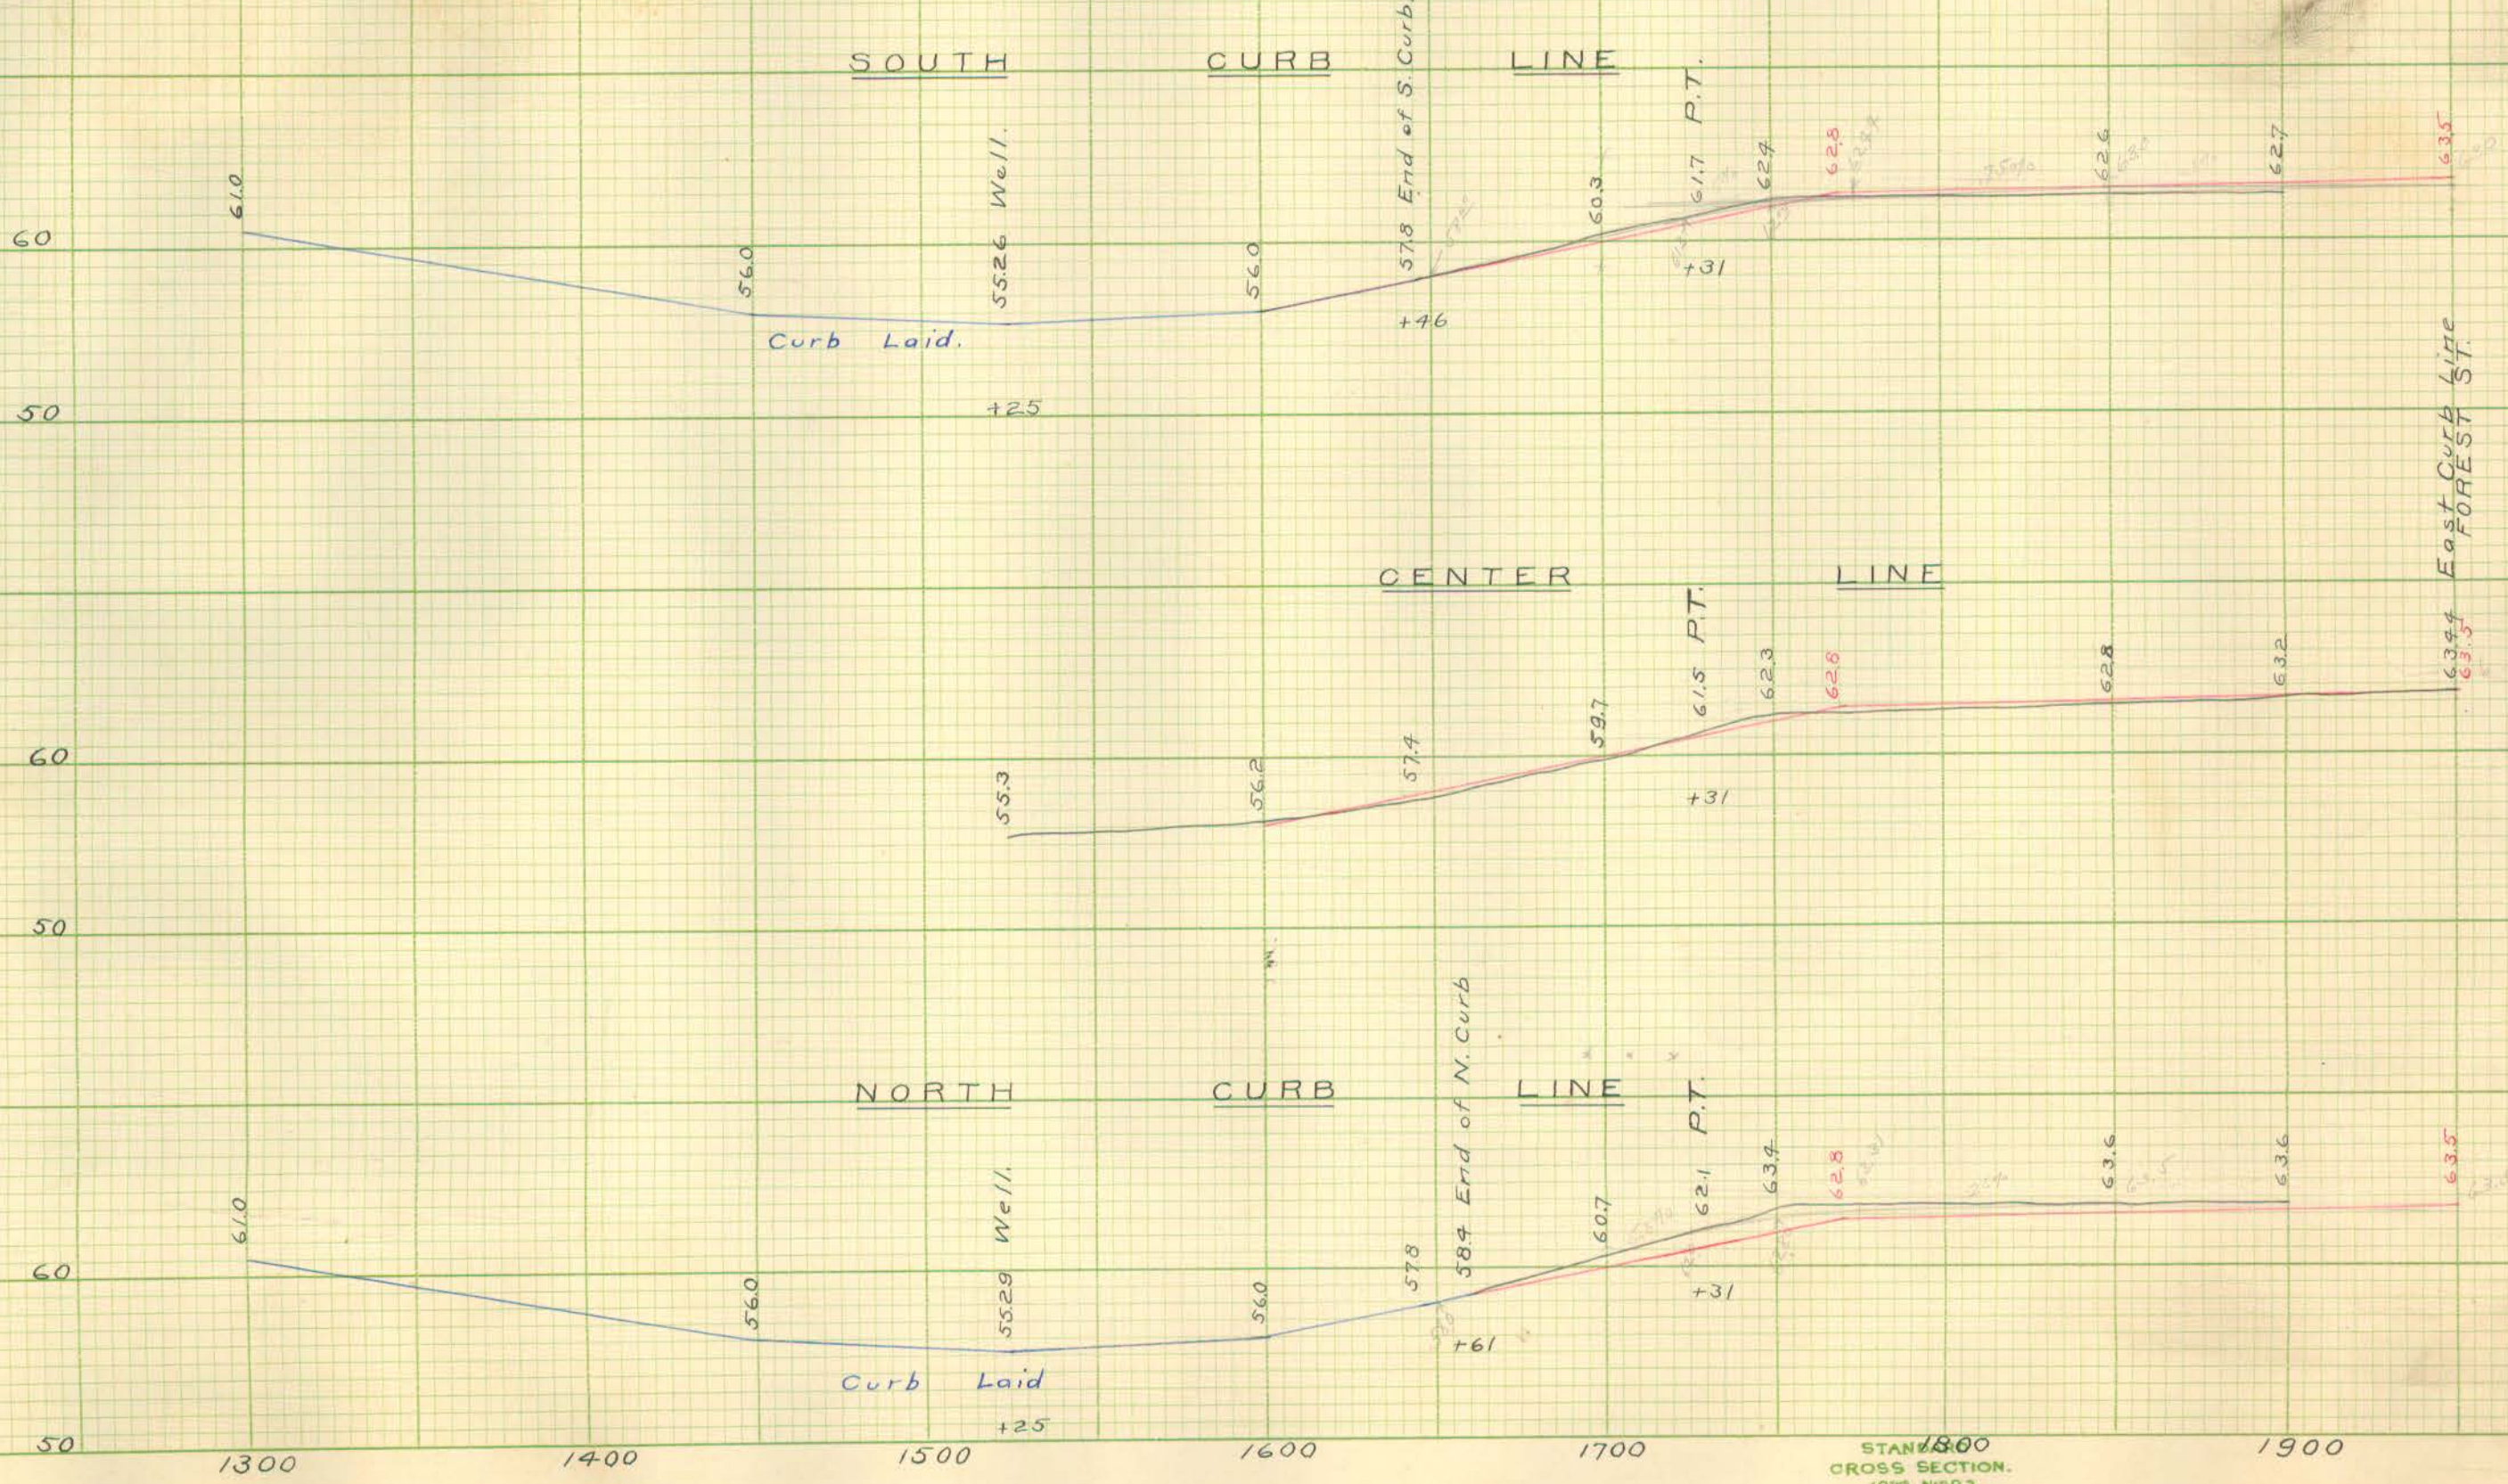

STANDARD CROSS SECTION.
10" N°283.