



Out of Service, April 26-1939

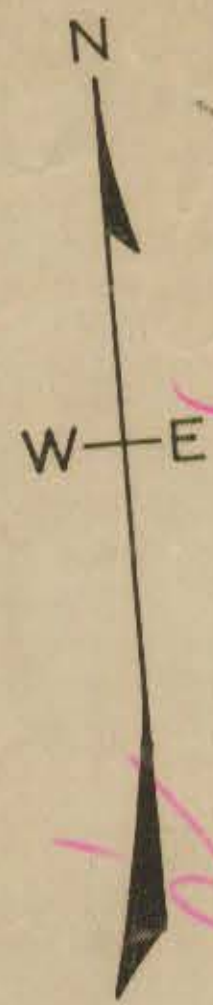


TOWN OF WEST HARTFORD


HOLLYWOOD AVENUE

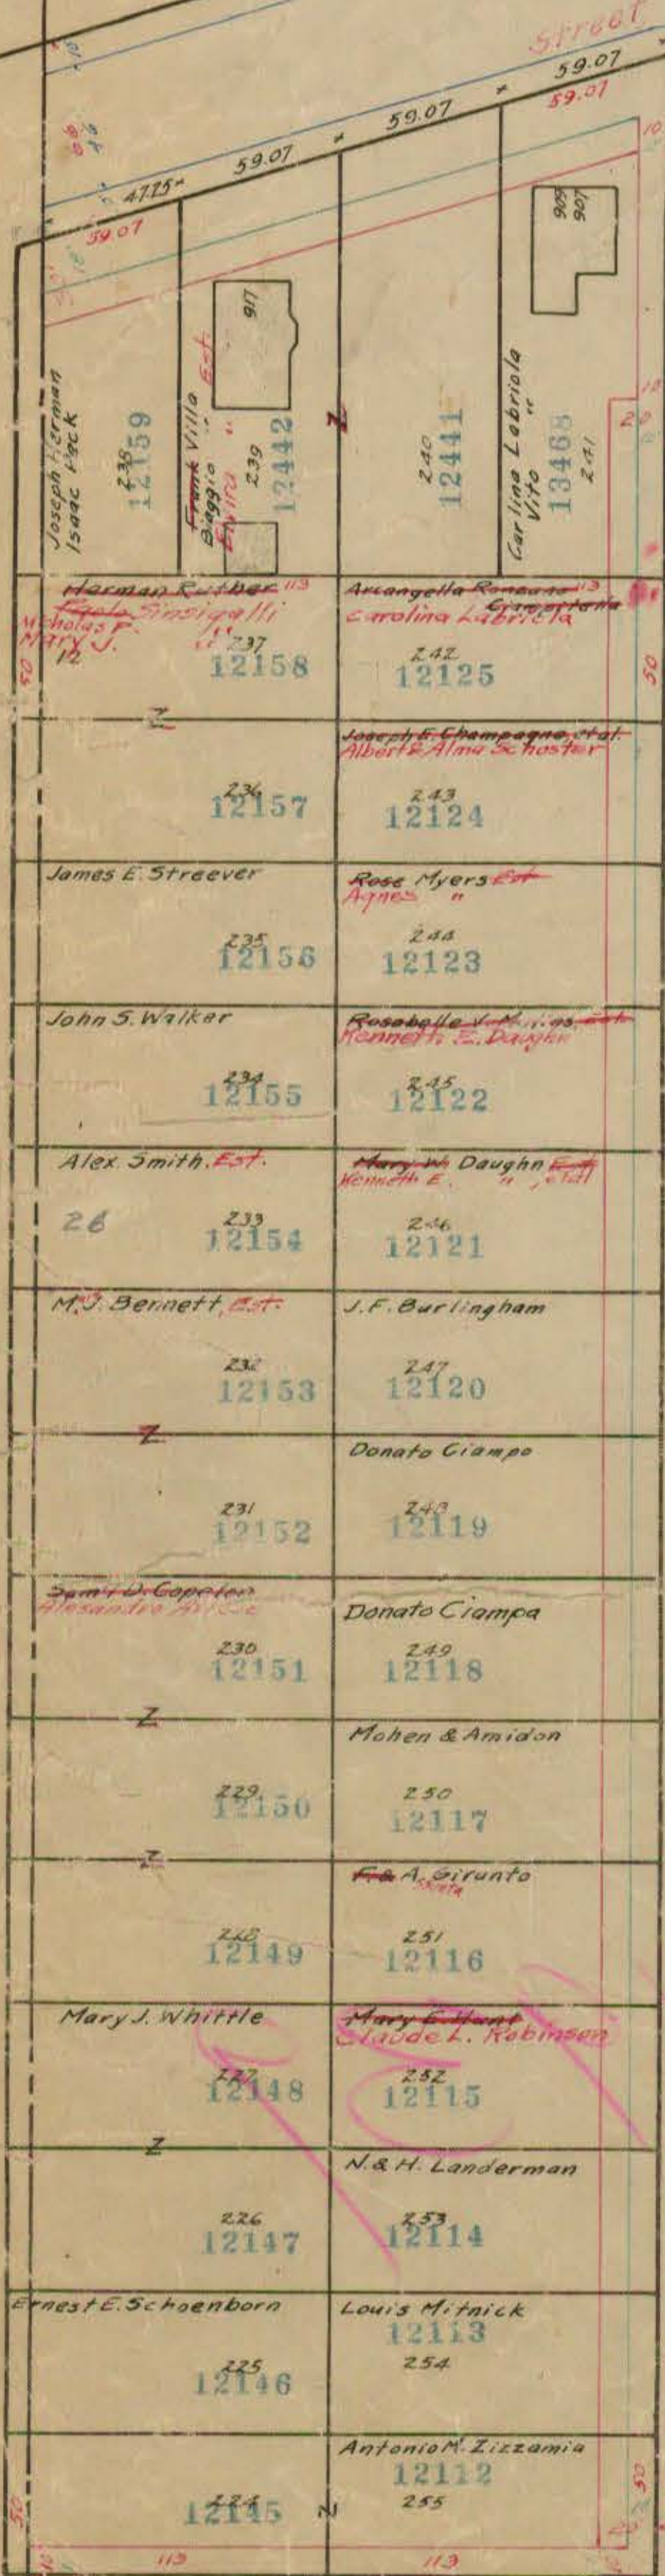


ROSSLYN STREET

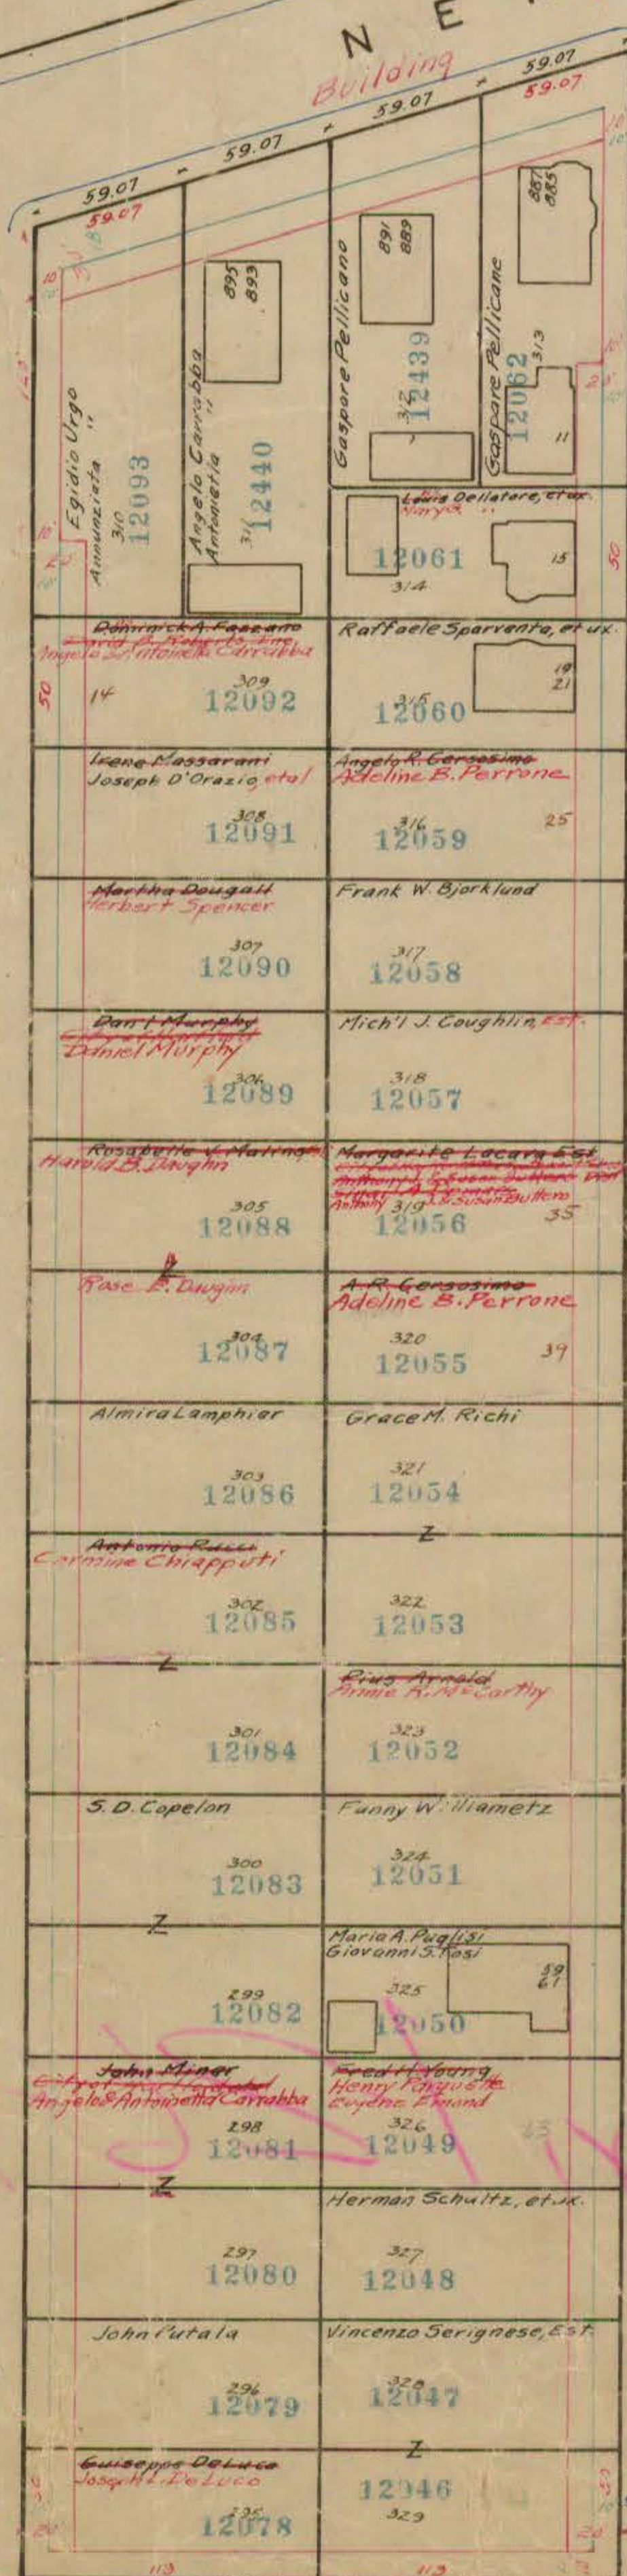


GRANIT STREET

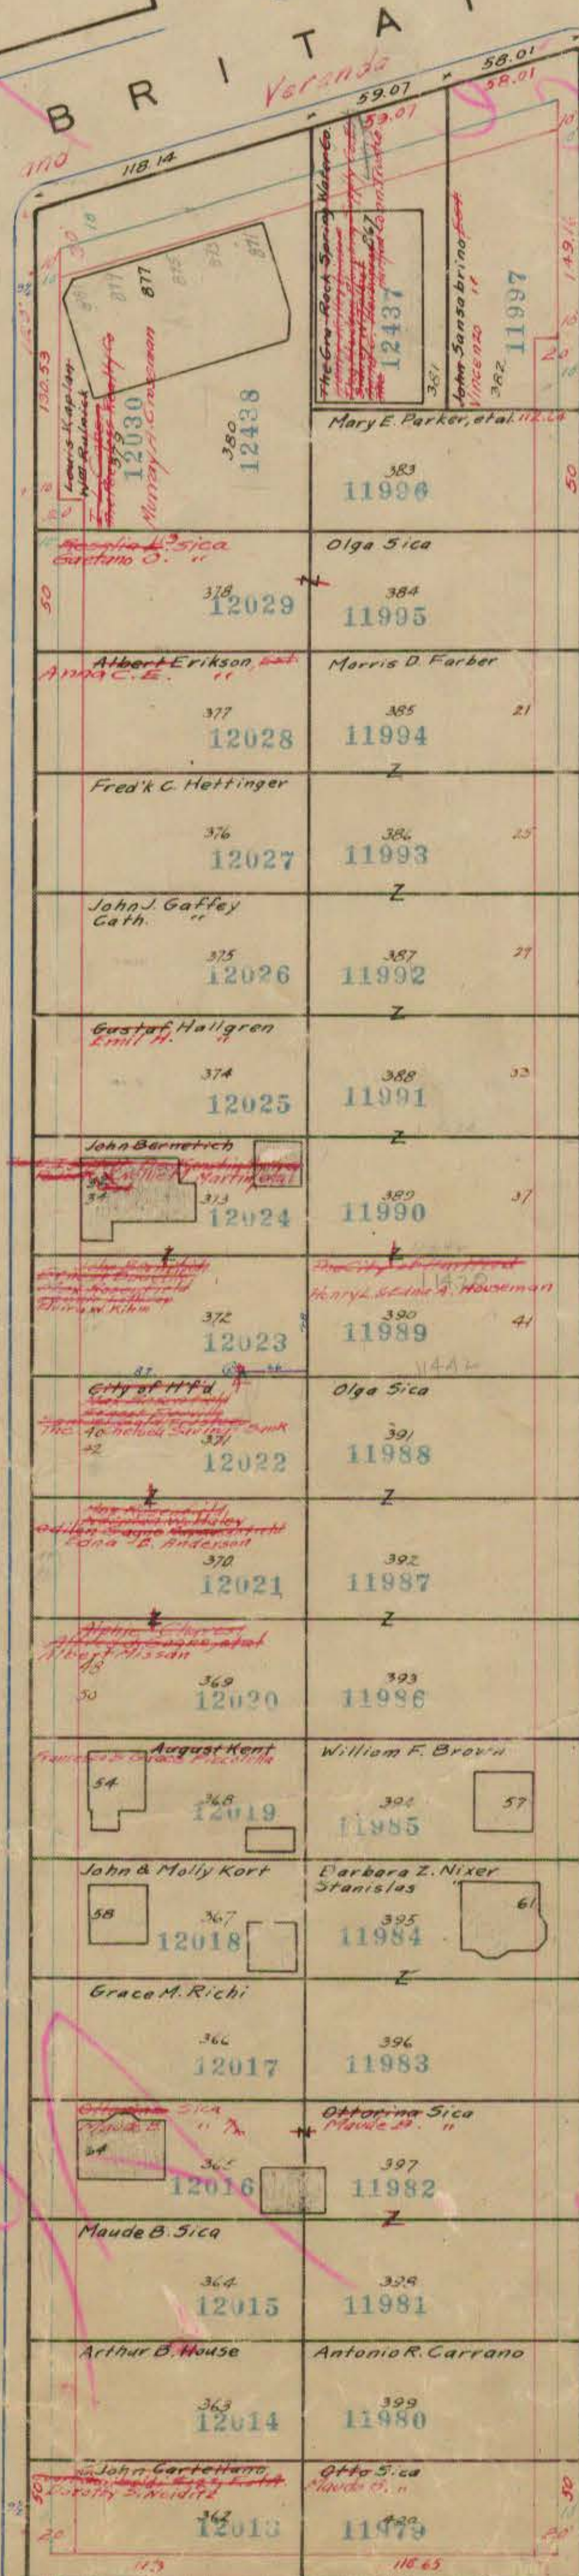



MOONTROROSE STREET

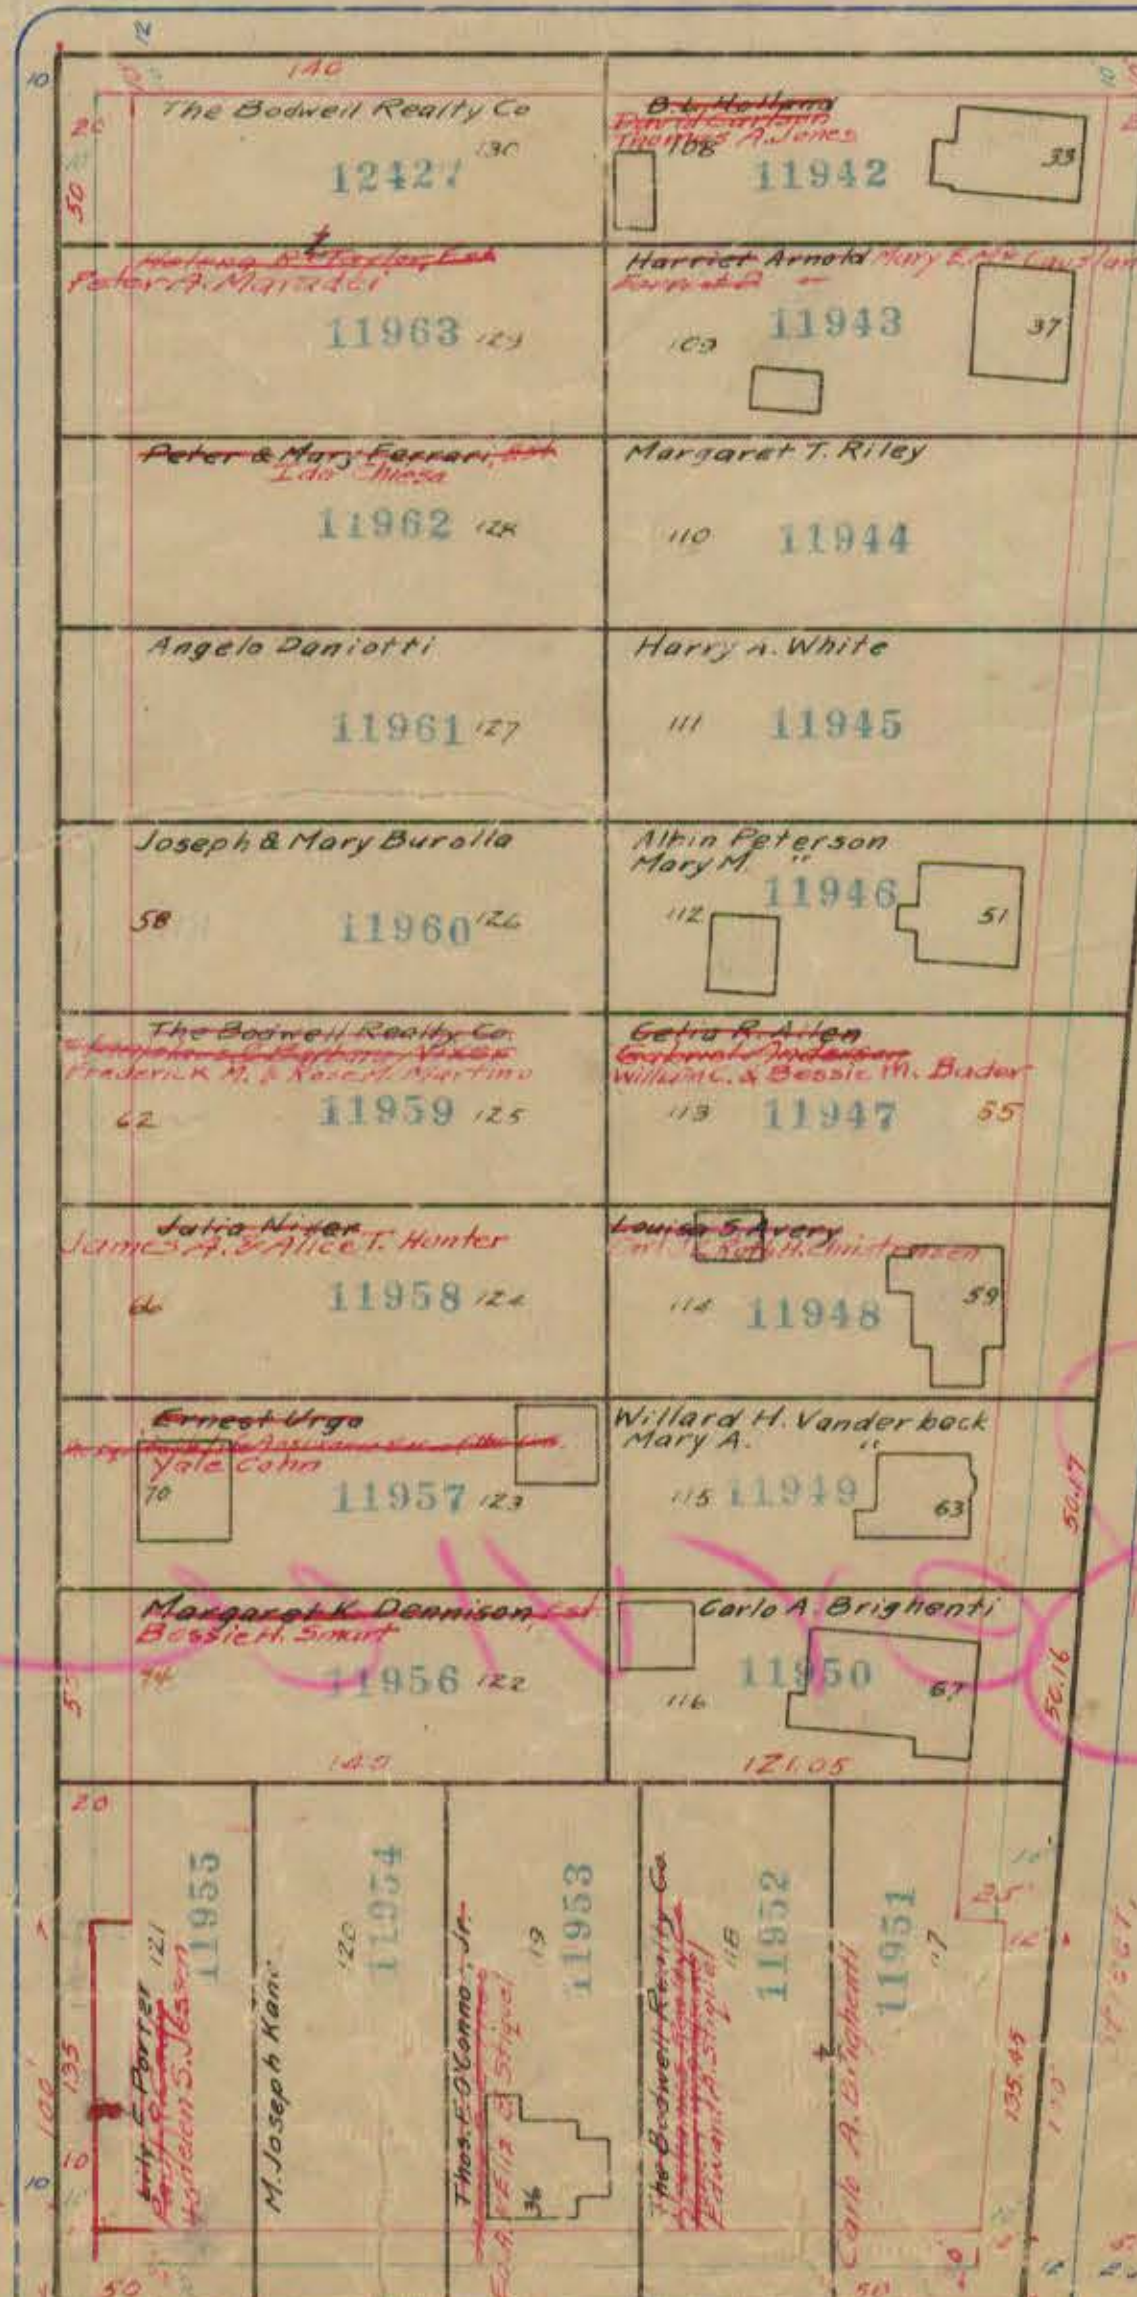

GOSSHE N AVENUE

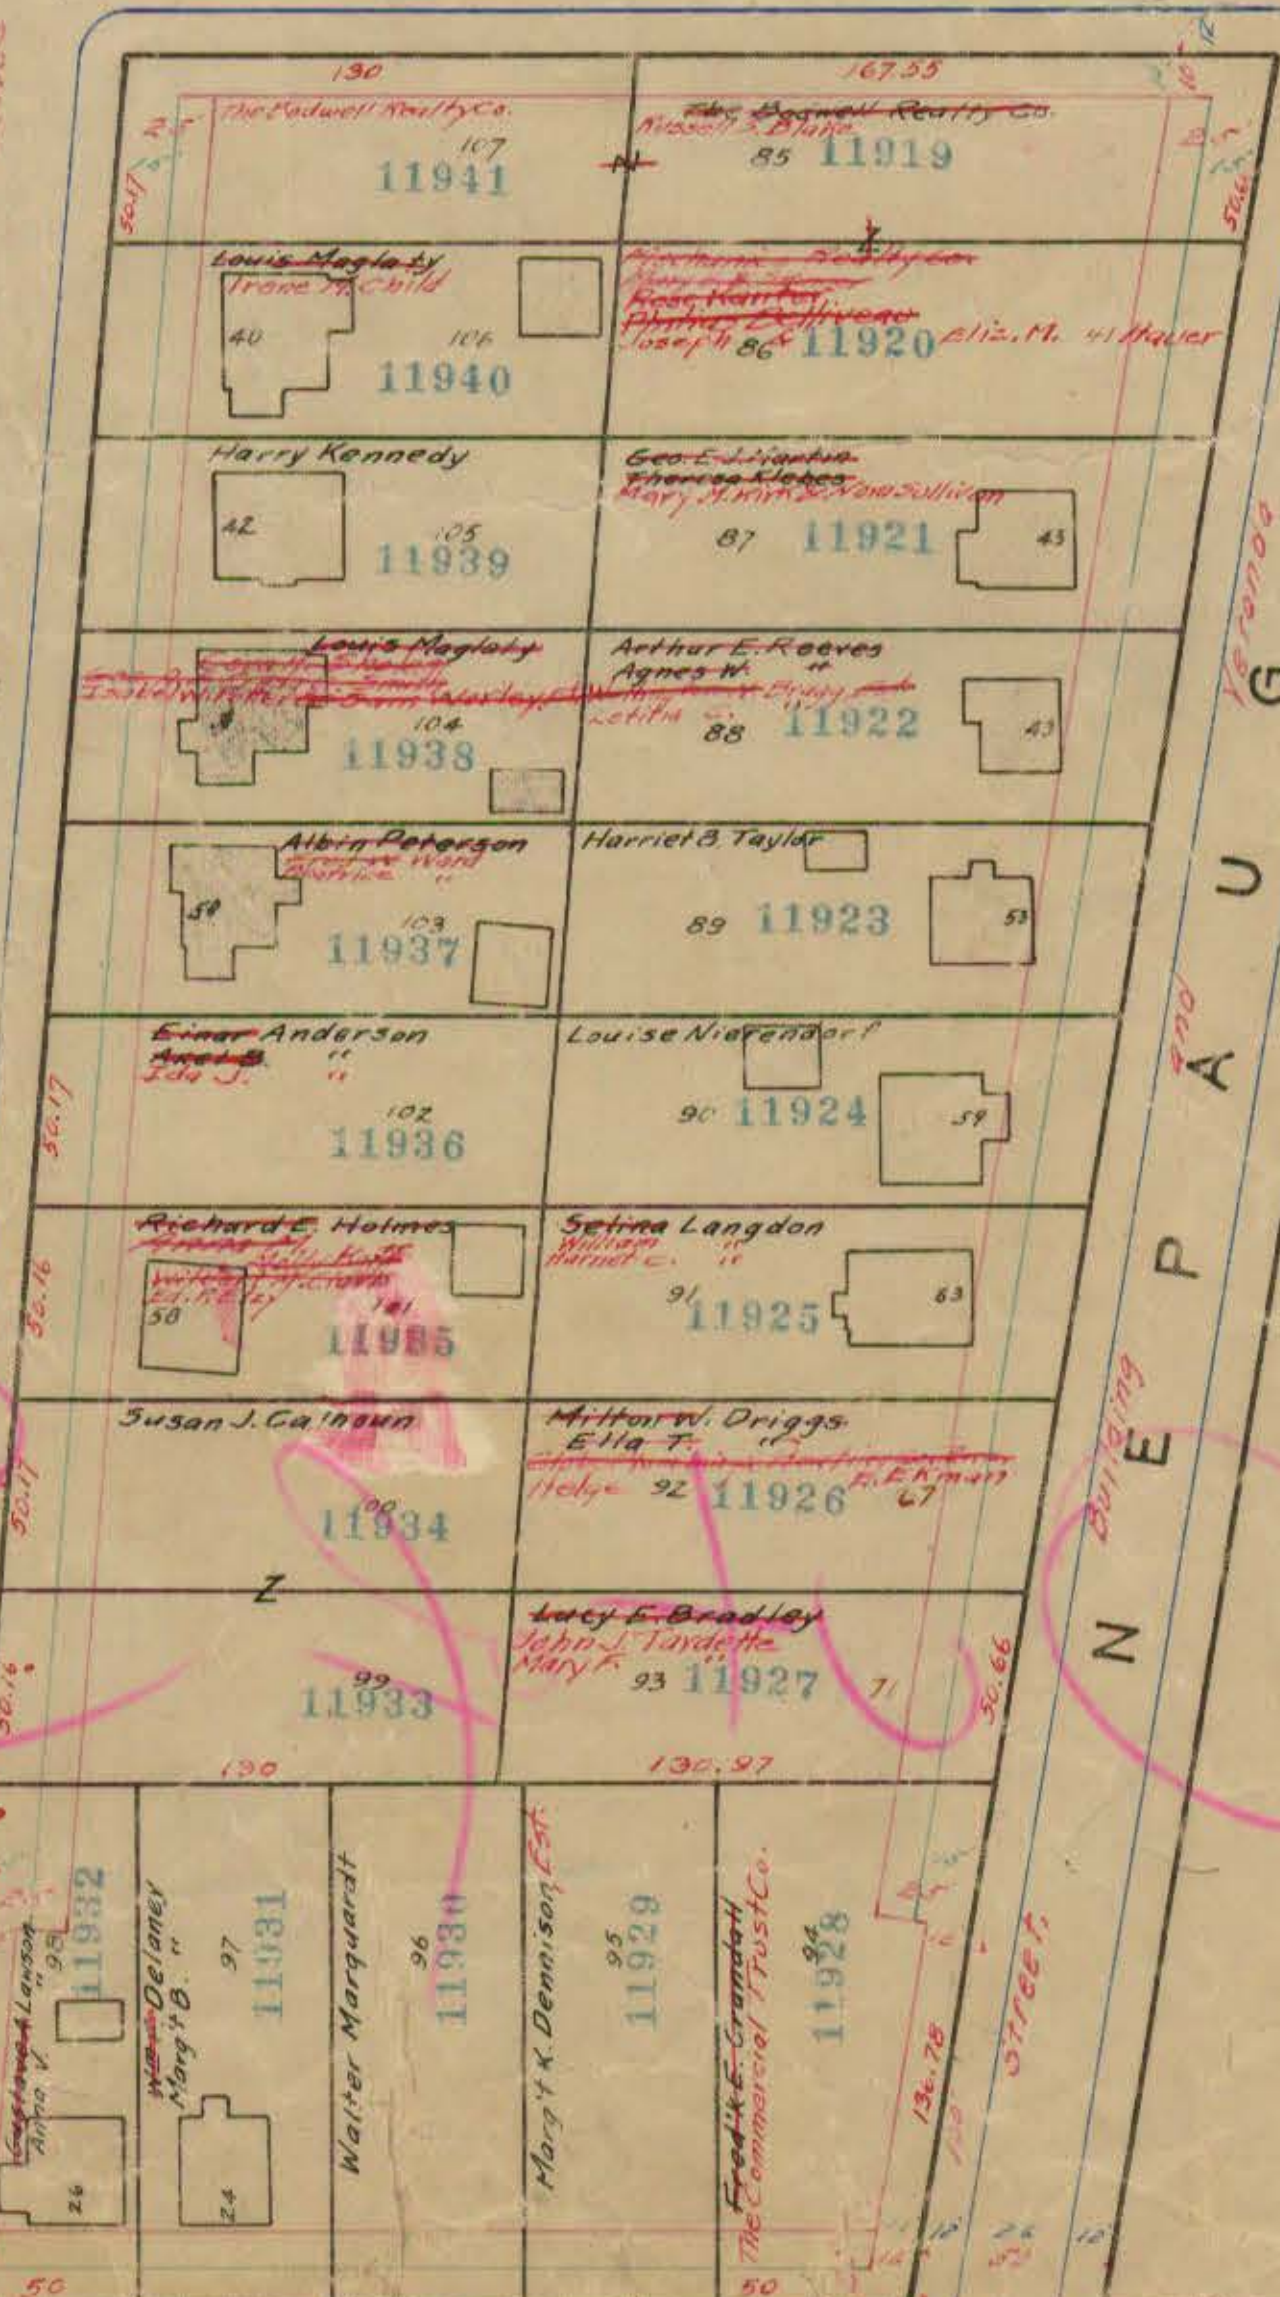

NEPAU AVENUE

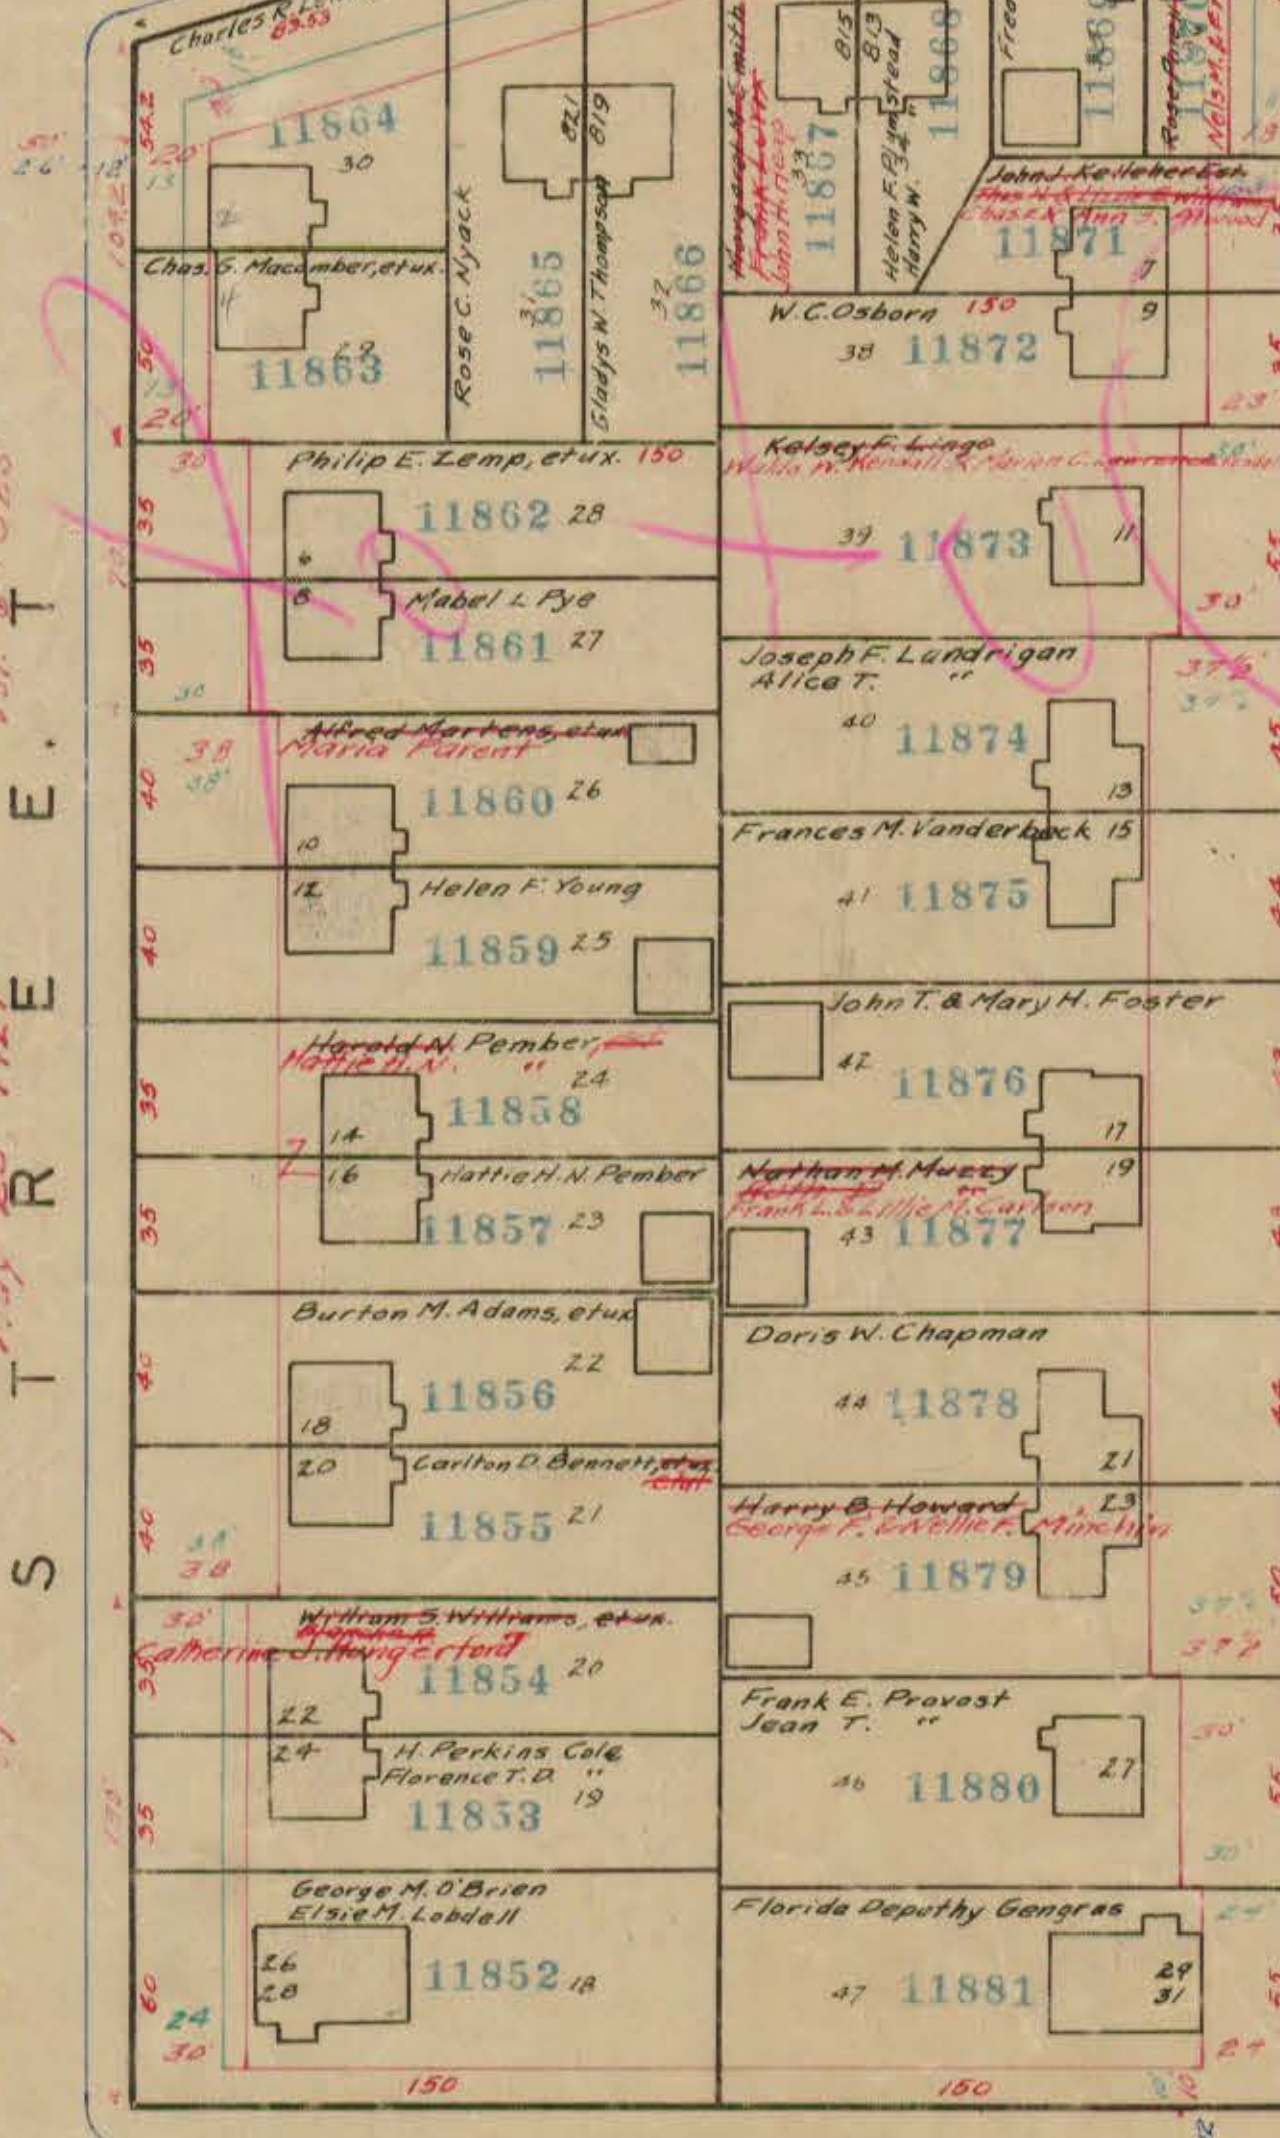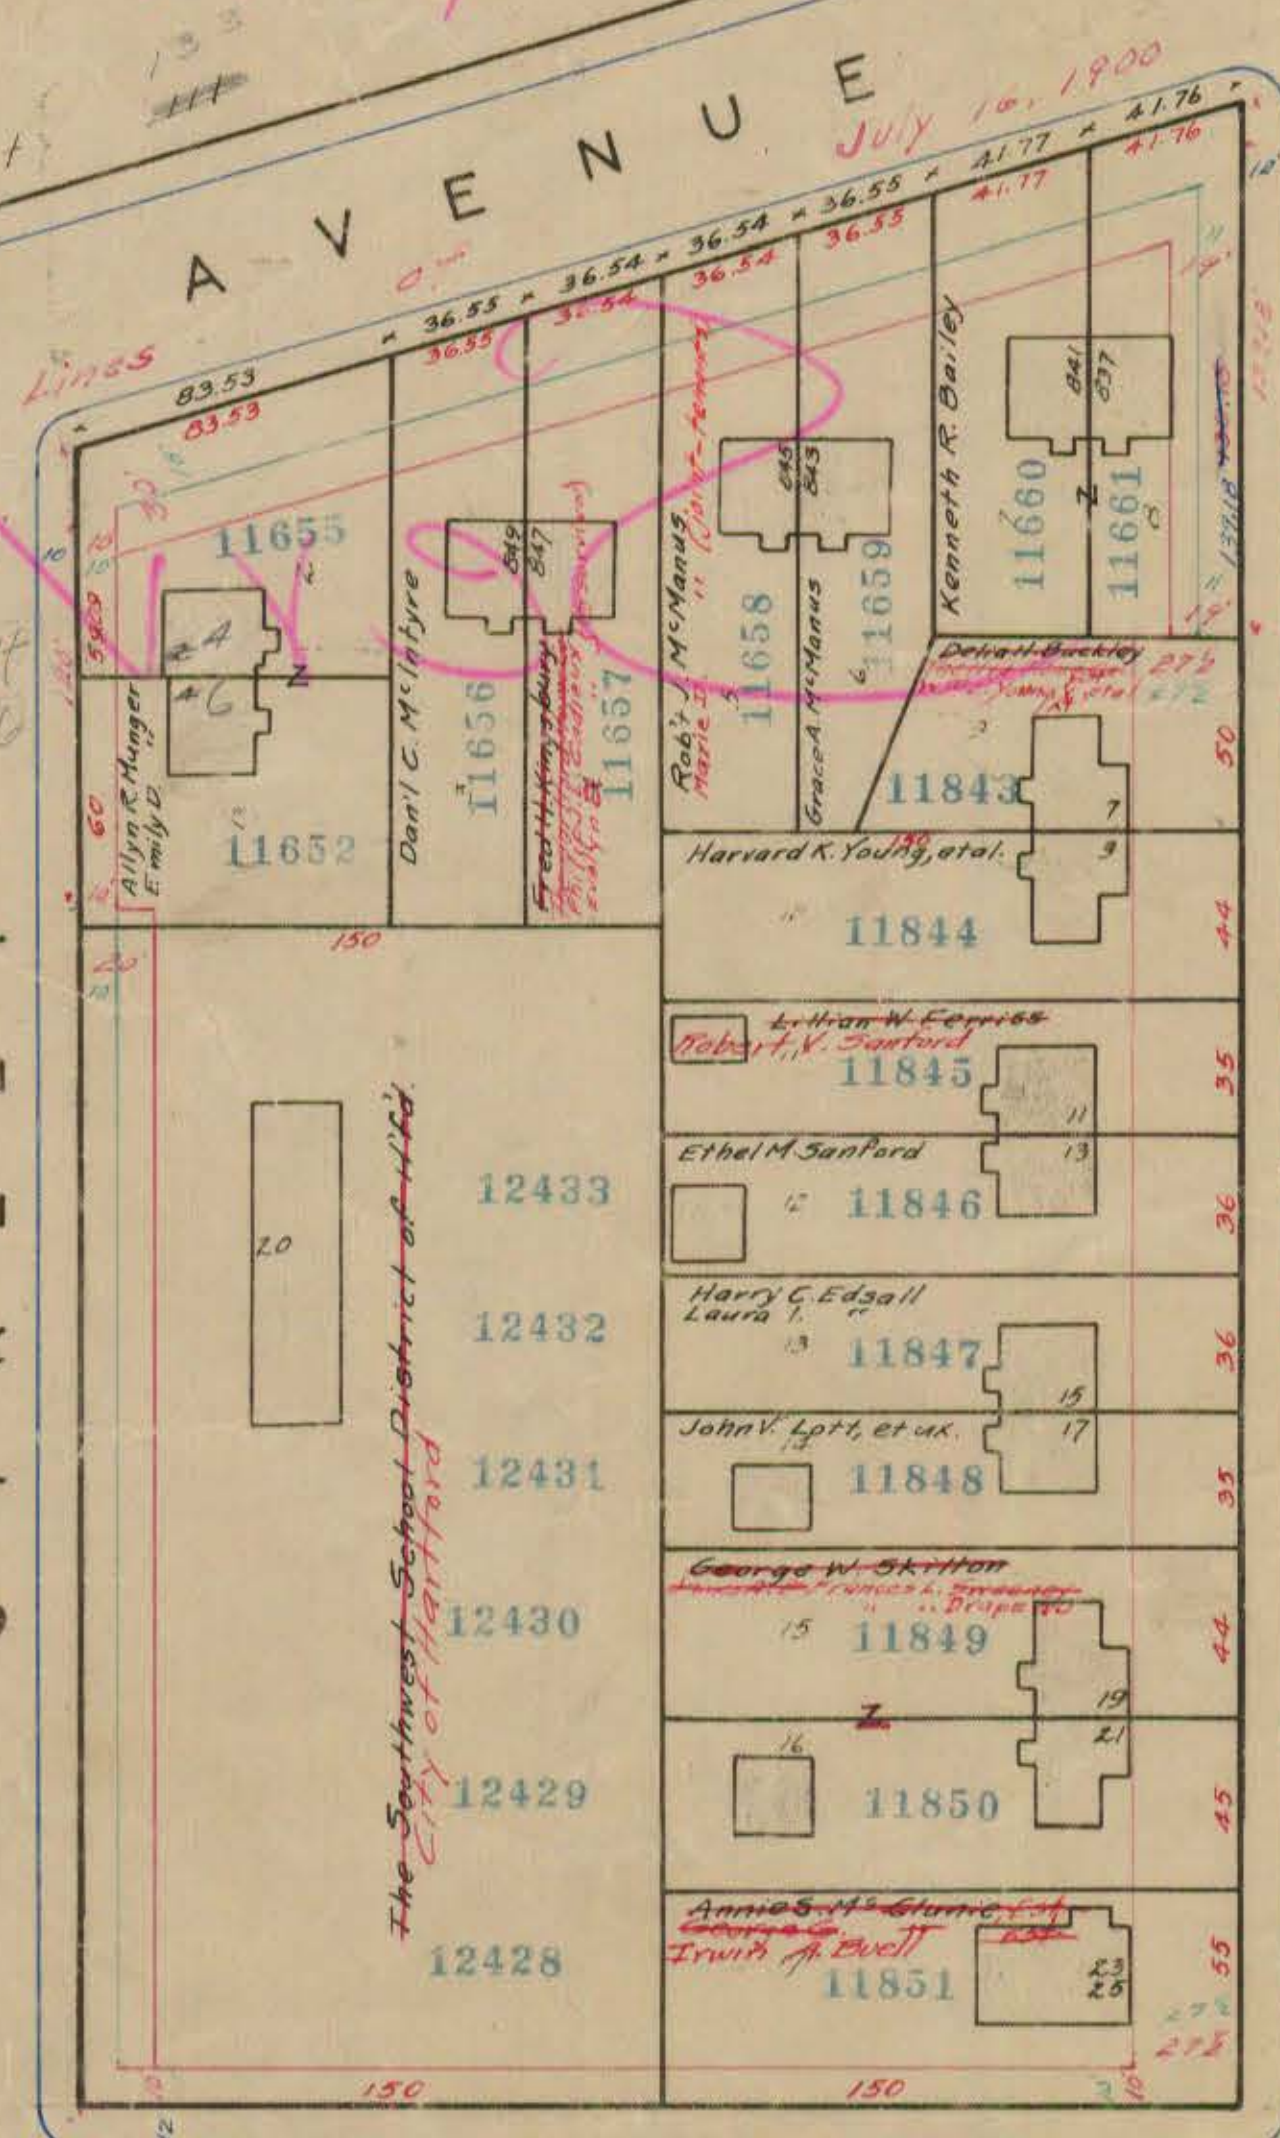

STREET

