


THE METROPOLITAN DISTRICT  
GEODETIC AND TOPOGRAPHICAL SURVEY

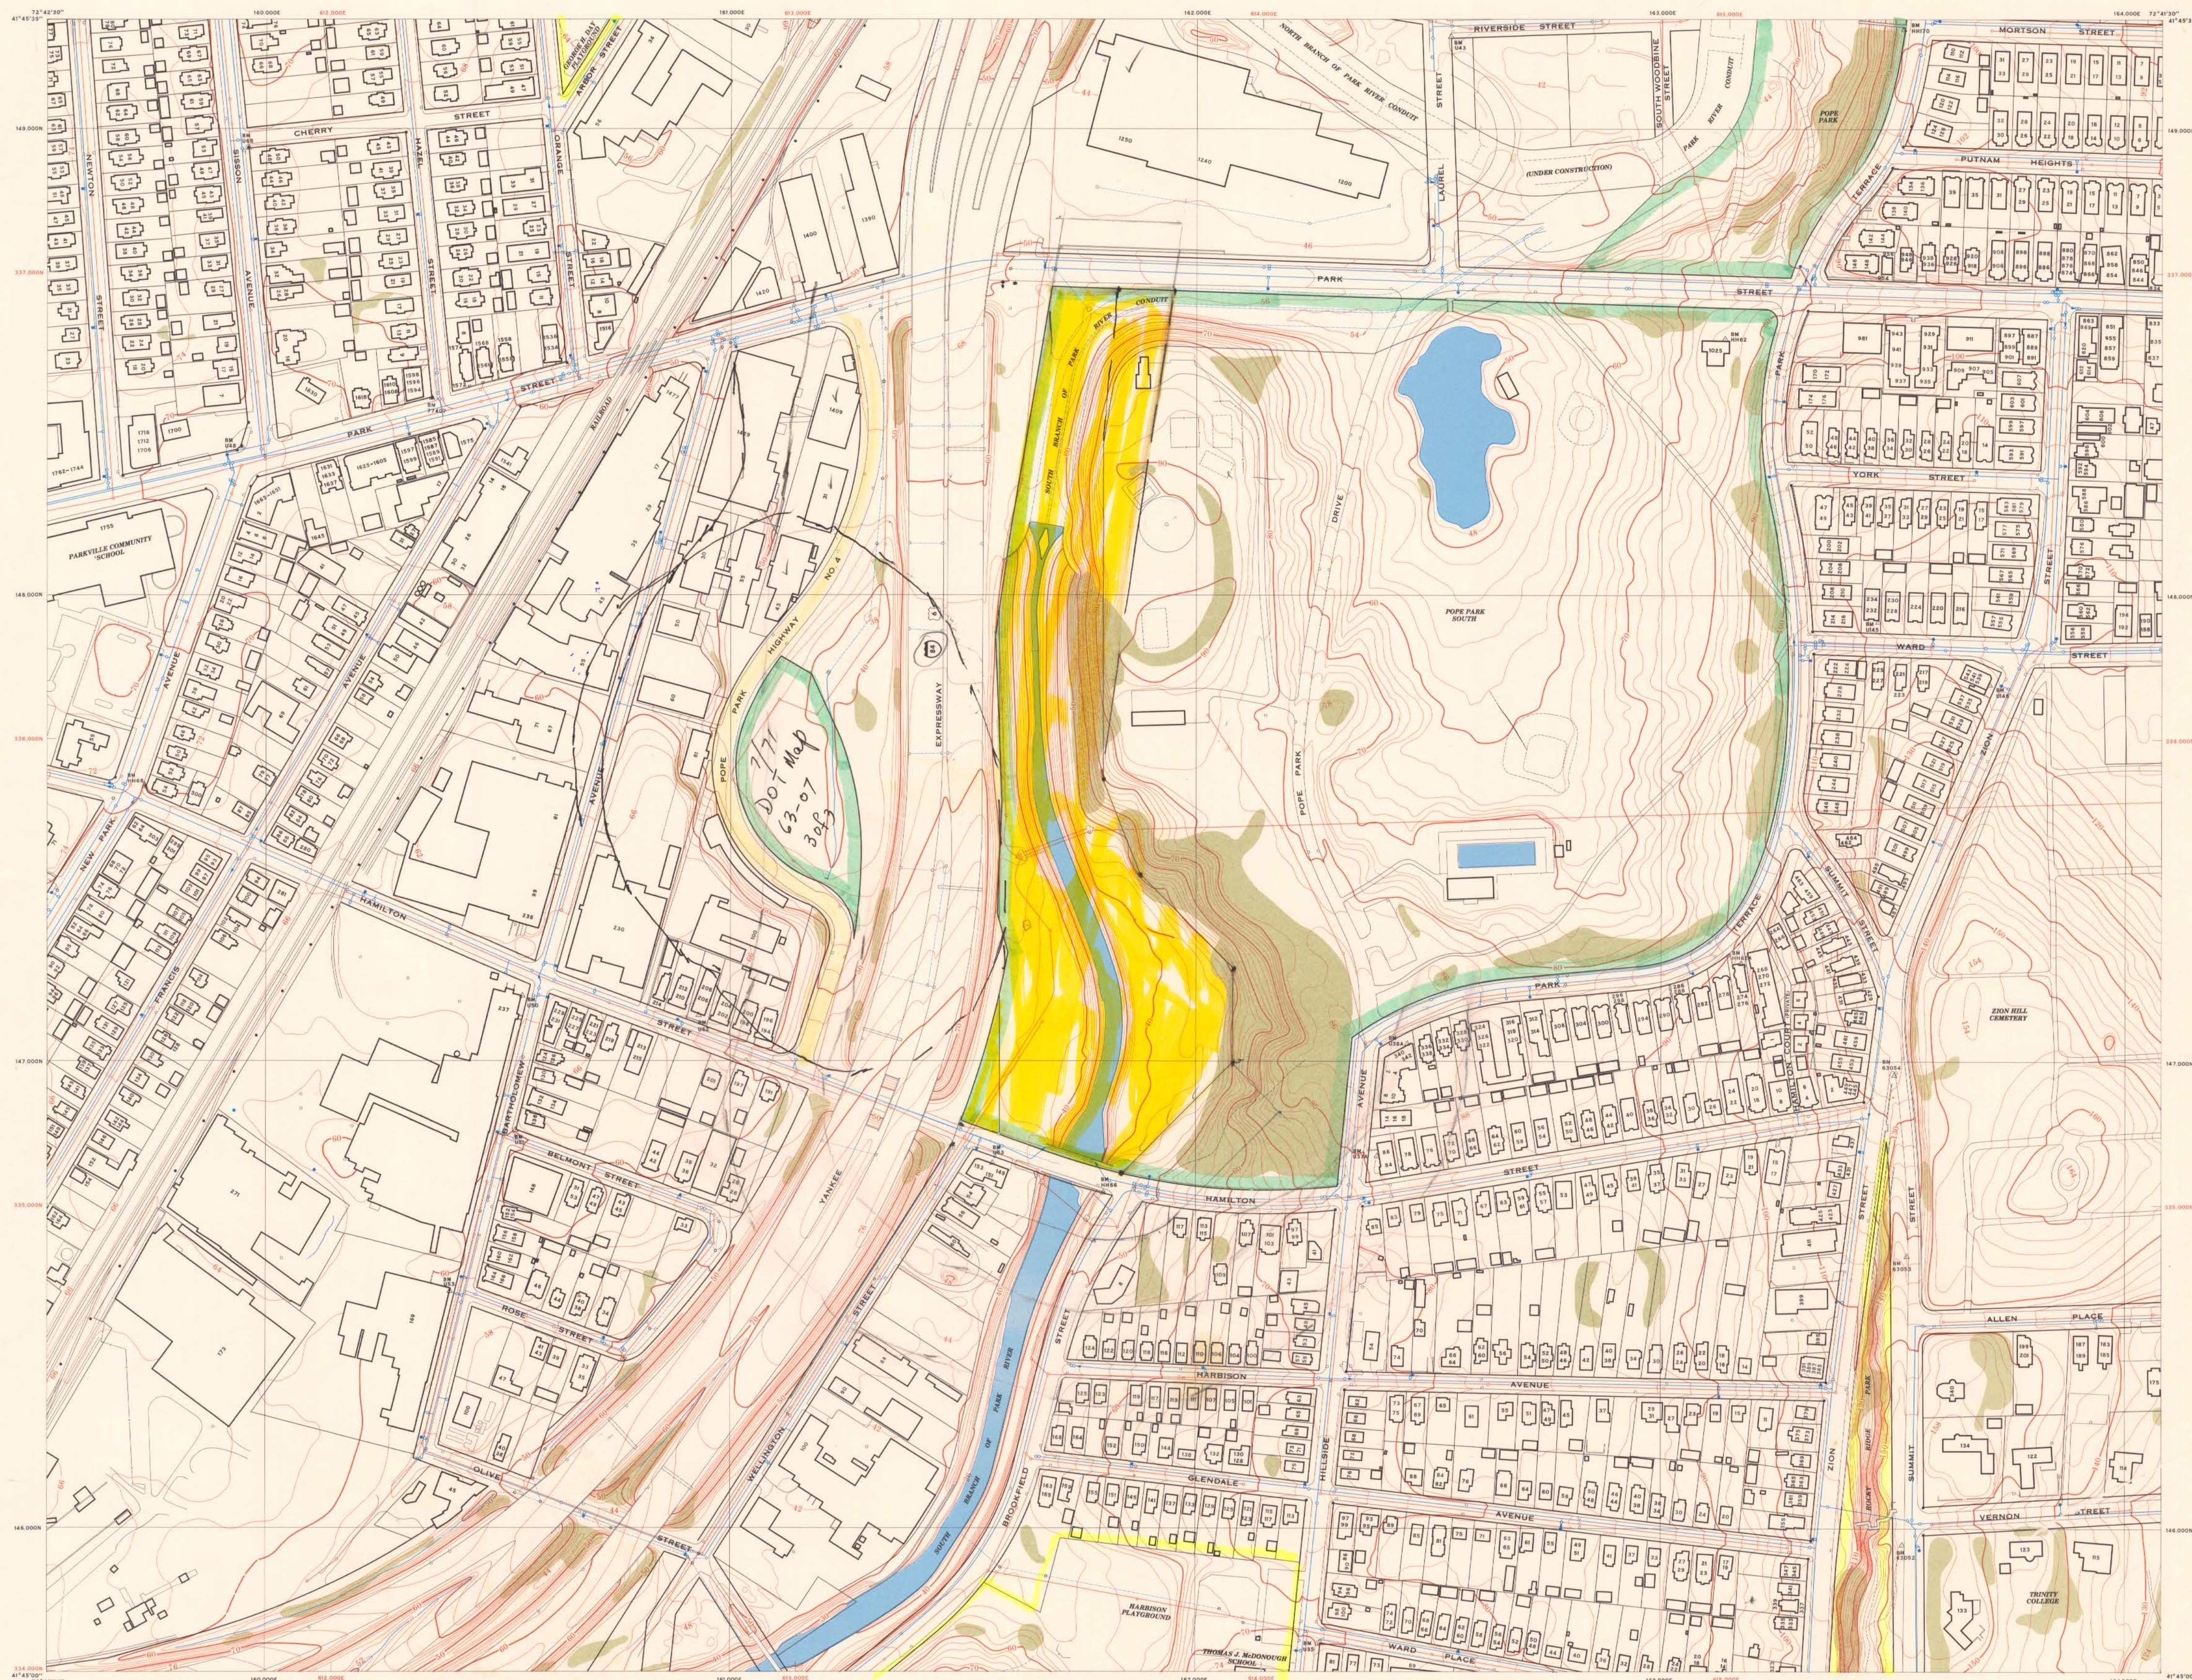

-LEGEND-

- SANITARY SEWER
- STORM SEWER
- CATCH BASIN
- WATER MAIN
- HYDRANT
- BENCH MARK
- HOUSE NUMBER
- MERESTONE

SCALE 1:2400  
(1 INCH = 200 FEET)

CONTOUR INTERVAL 2 FEET  
METROPOLITAN DISTRICT DATUM

1000-FOOT GRID BASED ON THE  
METROPOLITAN DISTRICT PLANE RECTANGULAR COORDINATE SYSTEM  
CONNECTICUT COORDINATE GRID SHOWN IN BRG 47-1  
THIS MAP COMPLIES WITH THE NATIONAL STANDARD MAP ACCURACY REQUIREMENTS

TOPOGRAPHY BY PHOTOGRAMMETRIC METHODS  
FROM AERIAL PHOTOGRAPHS TAKEN  
MARCH 23, 1979

|          |          |          |
|----------|----------|----------|
| SHEET 34 | SHEET 35 | SHEET 36 |
| SHEET 37 | SHEET 38 | SHEET 39 |
| SHEET 40 | SHEET 41 | SHEET 42 |

THE METROPOLITAN DISTRICT  
COMMISSION ON REGIONAL PLANNING  
HARTFORD COUNTY, CONNECTICUT

SHEET 35