


THE METROPOLITAN DISTRICT
GEODETIC AND TOPOGRAPHICAL SURVEY

72-40-30
72-40-38

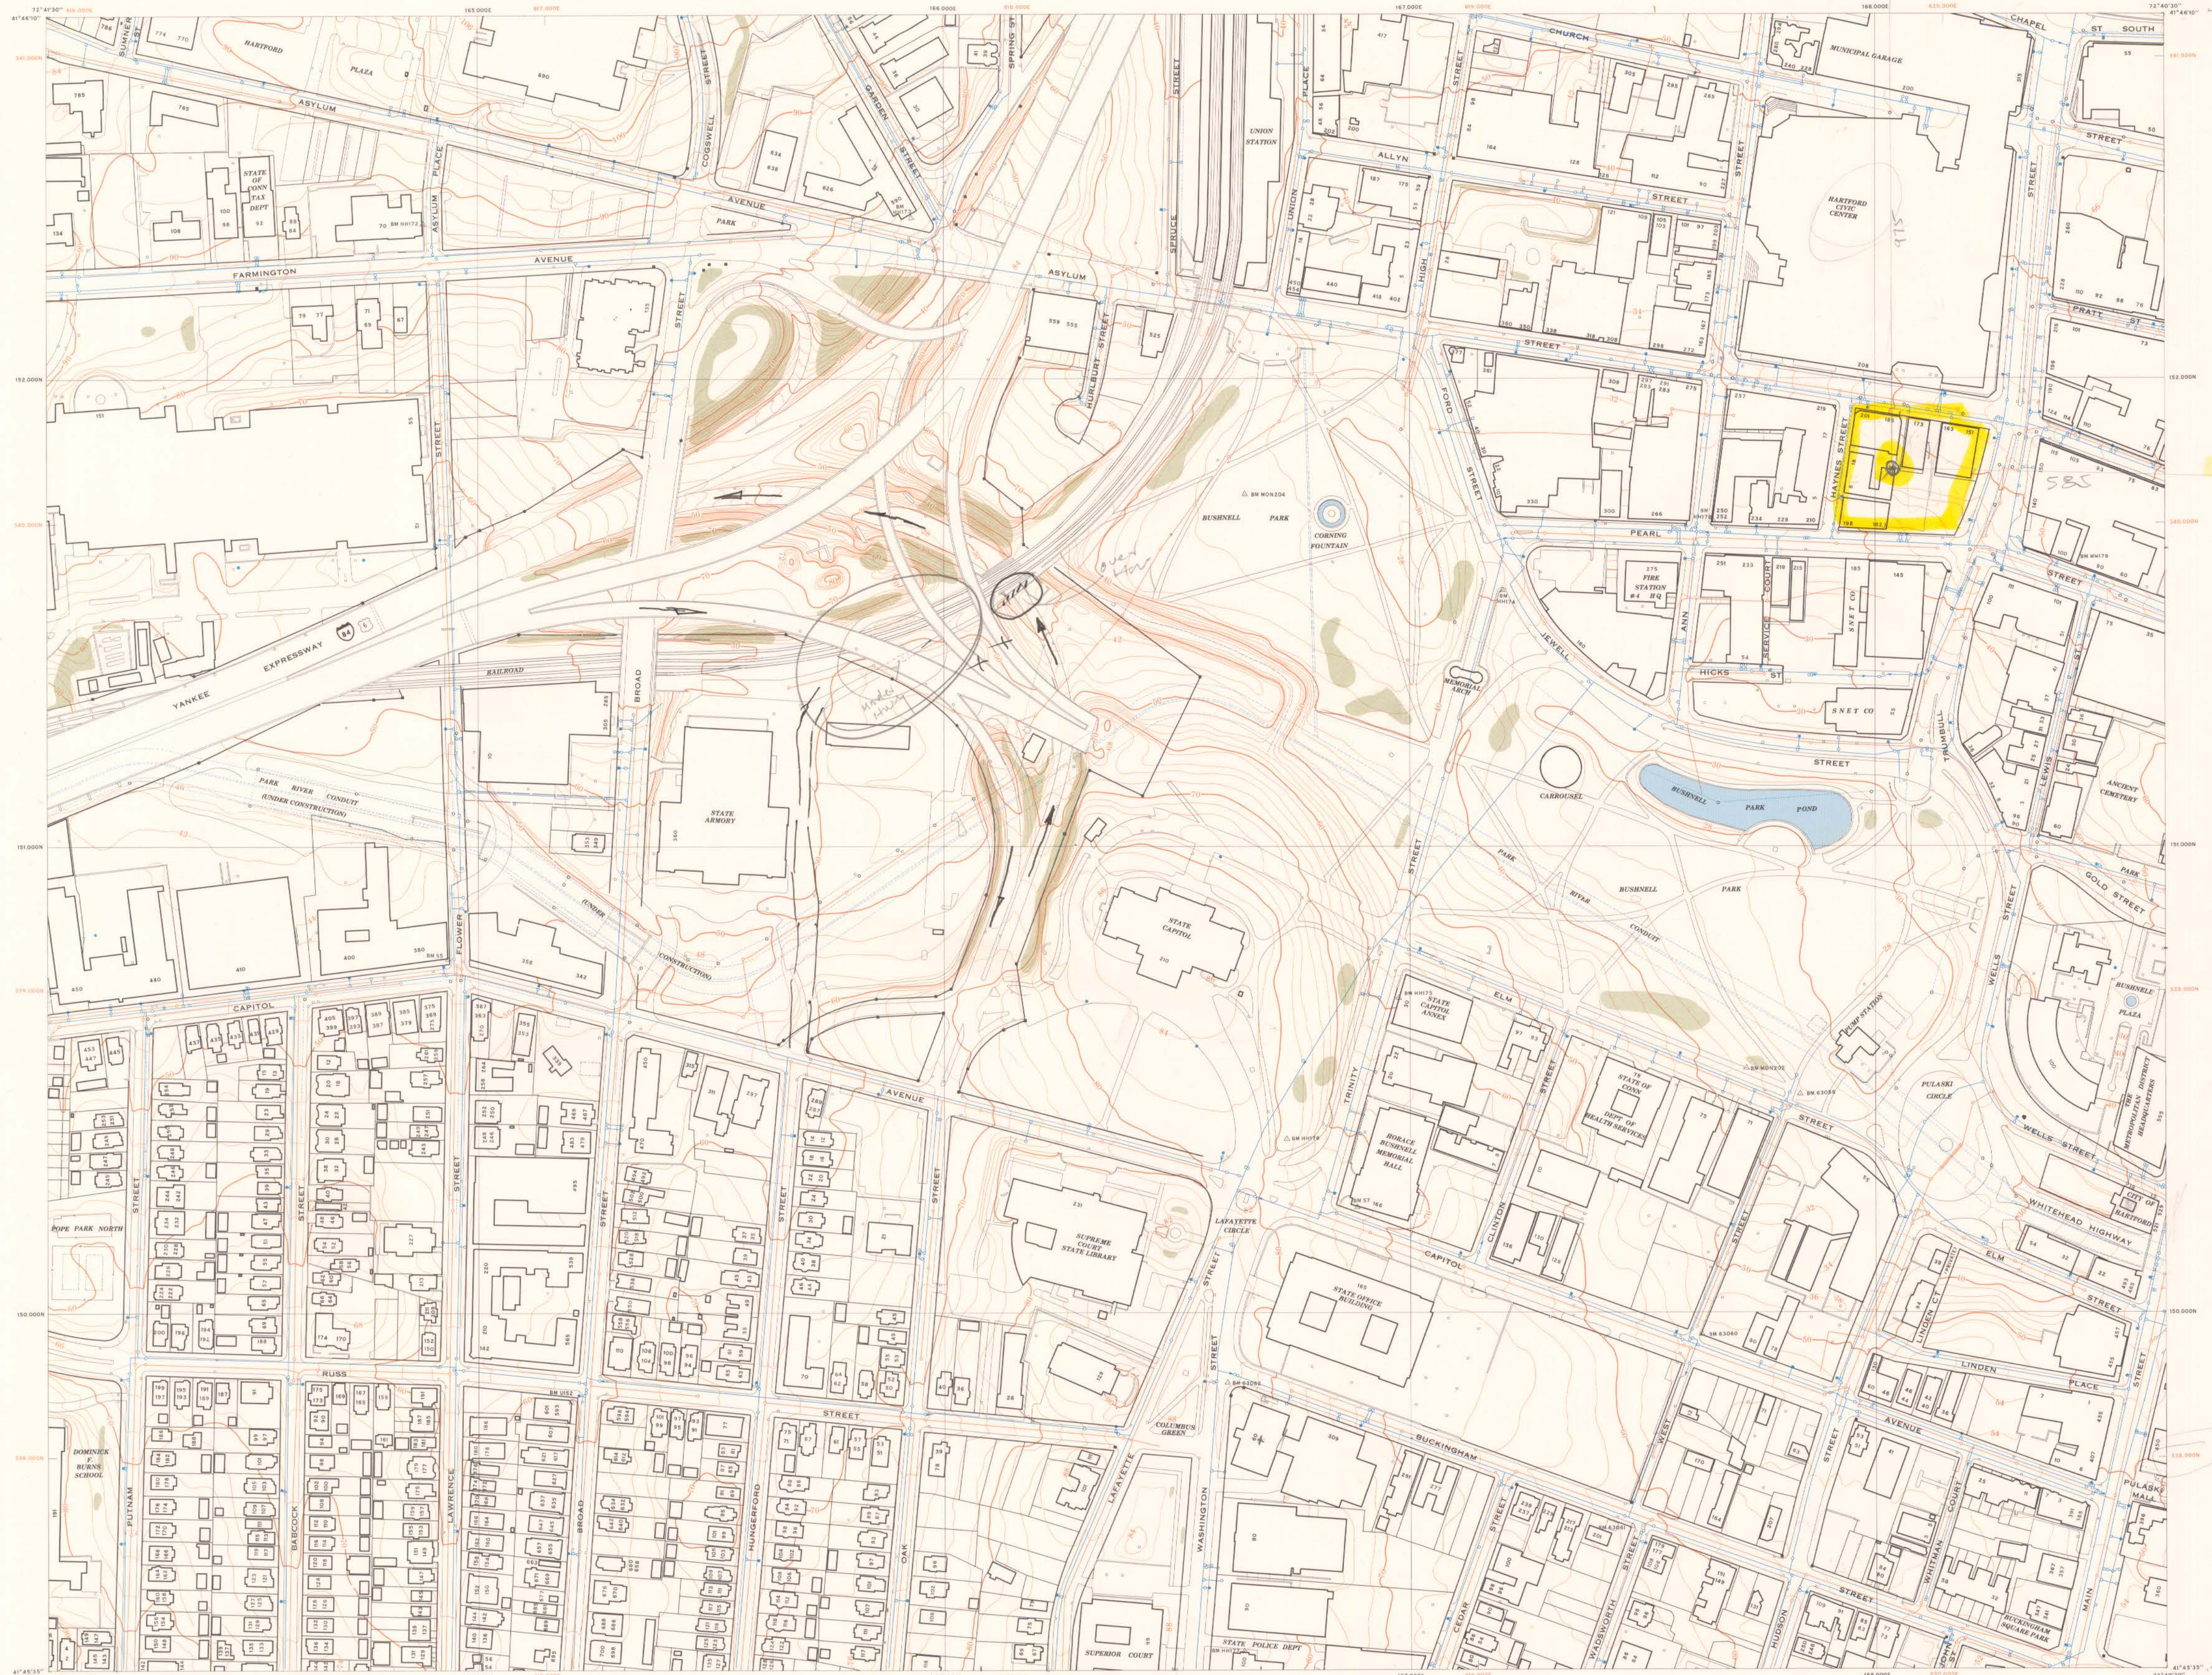

41°-46-00
41-46-10
41-45-30
00-00-35

72-41-30
72-40-30
00-01-00

4070
476
15 46 (4545)

1500
1540
3540

TOPOGRAPHY BY PHOTOGRAMMETRIC METHODS
FROM AERIAL PHOTOGRAPHS TAKEN
MARCH 23, 1979

- LEGEND-
- SANITARY SEWER
 - STORM SEWER
 - CATCH BASIN
 - WATER MAIN
 - HYDRANT
 - BENCH MARK
 - HOUSE NUMBER
 - MERESTONE

SCALE 1:2400
(1 INCH = 200 FEET)

CONTOUR INTERVAL 2 FEET
METROPOLITAN DISTRICT DATUM
1000-FOOT GRID BASED ON THE
METROPOLITAN DISTRICT PLANE RECTANGULAR COORDINATE SYSTEM
CONNECTICUT COORDINATE GRID SHOWN IN BROWN
THIS MAP COMPLIES WITH THE NATIONAL STANDARD MAP ACCURACY REQUIREMENTS

SHEET 53	SHEET 60	SHEET 66
SHEET 54	SHEET 61	SHEET 66
SHEET 55	SHEET 62	SHEET 67

THE METROPOLITAN DISTRICT
COMMISSION ON REGIONAL PLANNING
HARTFORD COUNTY, CONNECTICUT